

Appendix II-E
Form 2 Packages

CU-01

Form 2

CU Certification of Completion

CU BACKFILL/ENGINEERED CAP COMPLETION APPROVAL - FORM 2						
Reporting Date	11/24/2009	Placement Start Date			10/28/2009	
CU Number	1	Placement End Date			11/20/2009	
Approximate CU Centroid	Northing	1616824.789	Easting	735165.184	NY State NAD 83	
CU Size	3.39	Acres				
Backfill Area	0	Acres				
Cap Area	3.39	Acres				
Backfill Surface Mean Tri+ PCBs Concentration (when required)		NA		mg/kg		
Number of nodes sampled		NA		mg/kg		
Backfill NA	Type of Backfill NONE	Reference to appropriate drawings attached to Approval Form 1				
Cap X	Type of Cap Type "B" Medium Velocity Cap Type "B" High Velocity Cap	Reference to appropriate drawings attached to Approval Form 1 CU1 Backfill and Cap Plan, 11/4/09				
CU Checklist		Indicate one of the following			Reviewer Initial Acceptance	
Item	Attached	Not Applicable	GE	EPA		
Drawing of Installed Backfill/Cap (with record details, thickness and sample locations [when backfill/cap are placed])	X					
Where applicable in backfill areas provide the following: Sample locations (coordinates), depths, Aroclor and Tri+ PCB concentrations collected including analytical data, field observations, (hard copy and electronic copies [in database format or equivalent])		X				
Comments						
Refer to attached CU1 Narrative Summary of Backfill and Capping and CU1 Cap Placement Drawings.						
Upon signing this document, GE certifies that the backfill/cap has been installed satisfactorily and that no further backfill placement or capping is required for this CU. These remedial activities exclude long term operation, monitoring, maintenance and adaptive management at the CU. EPA accepts this certification.						
Signature of GE Representative			Signature of EPA Representative			
Signature			Signature			
Name			Name			
Date			Date			

Narrative

CU 1

Narrative Summary of Backfill and Capping and EPA Backfill and Capping Agreements

1.0 Cap Placement

A Type "B" Medium Velocity Cap, and a Type "B" High Velocity Cap was placed in accordance with the CU 1 Backfill and Cap Plan drawing, dated November 4, 2009, which was provided to EPA as part of the CU 1 Form 1 package. Final multi-beam bathymetric surveys of the Type B isolation layers were performed on November 11 and 12, 2009, as shown on the attached CU 1 Type "B" Cap Isolation Layer Acceptance Survey map, dated November 21, 2009. The surveyed isolation layer thickness on a 10' x 10' grid is shown for all cap areas. A multi-beam survey of the armor stone layer was completed on November 19, 2009, as shown on the attached CU 1 Type "B" Cap Armor Layer Acceptance Survey maps, dated November 21, 2009. The surveyed armor layer thickness on a 5' x 5' grid is shown for all cap areas.

2.0 Backfill Placement

In accordance with the CU 1 Backfill and Cap Plan drawing, dated November 4, 2009, which was provided to EPA as part of the CU 1 Form 1 package, backfill materials were not placed as the entire CU was capped.

3.0 EPA Field Agreements Specific to CU 1 Backfill and Capping

1. During the 4:00 PM meeting with EPA on October 12, 2009, EPA agreed that acceptance surveys of partial areas of a CU may be performed and used for acceptance once placement of backfill or cap in those areas is complete.
2. During a meeting with EPA on November 9, 2009, GE presented surveys of the CU 1 cap isolation layer. It was agreed that in Subunit CU1-1, GE would remove excess isolation layer material so that armor stone can be placed below the 105.2' elevation. The excess isolation layer material would be placed in areas of Subunits CU1-3 and CU1-4. In Subunits CU1-3 and CU1-4, GE would place additional isolation layer material to raise the isolation layer to be as close to 9" thick as possible while also providing room to place the armor layer below 105.2'. Lastly, it was agreed that the isolation layer placement in Subunits CU1-2, as shown, was acceptable. (See attached email dated, November 10, 2009.)
3. During a meeting with EPA on November 13, 2009, GE presented final surveys of the CU 1 cap isolation layer. It was agreed that sufficient thickness of isolation layer material had been placed while providing enough room to place armor stone below the 105.2' elevation

in the navigation channel, and that placement of armor stone can begin. (See attached email dated, November 14, 2009.) The CU 1 Type "B" Cap Isolation Layer Acceptance Survey drawing, dated November 21, 2009 is included in this package.

4. On November 20, 2009, GE provided final armor layer placement surveys to EPA via email. EPA informed GE on November 21, 2009, via email, that the armor layer thicknesses were acceptable. (See attached e-mail dated November 21, 2009.) The CU 1 Type "B" Cap Armor Layer Acceptance Survey drawing, dated November 21, 2009 is included in this package.
5. After placing Type O cobble armor in the high velocity Type "B" cap in the navigation channel areas it was observed that the required thickness of armor stone had not been obtained in some locations. In addition, there was not sufficient depth to place additional Type O material, given the diameter of the stone, and remain below the required 105.2' elevation. Similarly to the solution used in CU2, GE placed Type N material on top of the Type O armor stone to increase the thickness of high velocity Type "B" caps in areas of the Navigation Channel with depth restrictions.

Figures

LEGEND

- 0.58 5x5 GRID WITHIN DESIGN GUIDELINES (FT.)
- 0.21 5x5 GRID LESS THAN DESIGN GUIDELINES (FT.)
- 1.11 5x5 GRID ABOVE DESIGN GUIDELINES (FT.)
- ROCK/REFUSAL ENCOUNTERED VIA DREDGING
- CU BOUNDARY
- CU SUBUNIT BOUNDARY
- MUD - RIP RAP INTERFACE
- 5' INTERFACE OFFSET
- - - NAVIGATION CHANNEL
- - - TOE OF FINAL DREDGE PRISM SLOPE



**CU1-1 & CU1-2 TYPE "B" CAP
ARMOR STONE PLACEMENT**

NOTES:

1. OSI MULTIBEAM SURVEY ON NOVEMBER 19, 2009.
2. ARMOR STONE THICKNESS IS LISTED IN 5'x5' GRIDS.
3. A REDUCED ARMOR LAYER (TYPE "O" AND TYPE "N" STONE) WAS PLACED IN CERTAIN LOCATIONS DUE TO RESTRICTIONS OF FINAL CAP ELEVATION IN NAVIGATION CHANNEL.

DWG 1 OF 2

PARSONS <small>CONSULTING ENGINEERS</small>		DRAWING TITLE	
GE COMPANY - PARSONS PROJECT OFFICE BUILDING 40-1, 381 BROADWAY FORT EDWARD, N.Y. 12828 (518) 746-5311		CU1 TYPE "B" CAP ARMOR LAYER ACCEPTANCE SURVEY	
DRAWN BY JHC	CHECKED BY MG	DRAWING NO. CU1-1	SCALE AS SHOWN
DATE 11/21/09	APPROVED BY MG		JOB 442209.01401

LEGEND

- 0.58 5x5 GRID WITHIN DESIGN GUIDELINES (FT.)
- 0.21 5x5 GRID LESS THAN DESIGN GUIDELINES (FT.)
- 1.11 5x5 GRID ABOVE DESIGN GUIDELINES (FT.)
- ROCK/REFUSAL ENCOUNTERED VIA DREDGING
- CU BOUNDARY
- CU SUBUNIT BOUNDARY
- MUD - RIP RAP INTERFACE
- 5' INTERFACE OFFSET
- NAVIGATION CHANNEL
- TOE OF FINAL DREDGE PRISM SLOPE




NOTES:

1. OSI MULTIBEAM SURVEY ON NOVEMBER 19, 2009.
2. ARMOR STONE THICKNESS IS LISTED IN 5'x5' GRIDS.
3. A REDUCED ARMOR LAYER (TYPE "O" AND TYPE "N" STONE) WAS PLACED IN CERTAIN LOCATIONS DUE TO RESTRICTIONS OF FINAL CAP ELEVATION IN NAVIGATION CHANNEL.

CU1-3 & CU1-4 TYPE "B" CAP ARMOR STONE PLACEMENT

DWG 2 OF 2

PARSONS <small>CONSULTING ENGINEERS</small>		DRAWING TITLE	
GE COMPANY - PARSONS PROJECT OFFICE BUILDING 40-1, 381 BROADWAY FORT EDWARD, N.Y. 12828 (518) 746-5311		CU1 TYPE "B" CAP ARMOR LAYER ACCEPTANCE SURVEY	
DRAWN BY JHC	CHECKED BY MG	DRAWING NO. CU1-2	SCALE AS SHOWN
DATE 11/21/09	APPROVED BY MG	JOB 442209.01401	

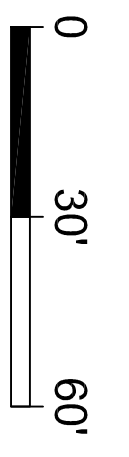

LEGEND









- 0.80 10x10' GRID WITHIN DESIGN GUIDELINES
- 0.65 10x10' GRID LESS THAN DESIGN GUIDELINES
- 0.50 10x10' GRID ABOVE DESIGN GUIDELINES
- BUCKET REFUSAL ENCOUNTERED VIA DREDGING
- CU BOUNDARY
- CU SUBUNIT BOUNDARY
- NEARSHORE BORDER (117.5 FEET)
- MUD - RIP RAP INTERFACE
- 5 FOOT INTERFACE OFFSET
- TOE OF FINAL DREDGE PRISM SLOPE


NOTES:

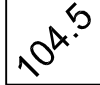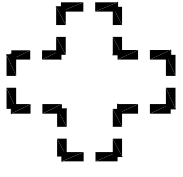1. OSI MULTIBEAM SURVEY ON NOVEMBER 11 AND 12, 2009.
2. CAP THICKNESS OF ISOLATION LAYER IS LISTED IN 10X10' GRIDS.
3. A REDUCED ISOLATION LAYER (TYPE 2 BACKFILL WITH TOC) WAS INTENTIONALLY PLACED IN CERTAIN LOCATIONS, DUE TO RESTRICTIONS OF FINAL CAP ELEVATION IN NAVIGATION CHANNEL.

PARSONS		DRAWING TITLE
GEORGE W. PARSONS PROJECT OFFICE BUILDING 40-1, 381 BROADWAY FORT EDWARD, N.Y. 12828 (518) 746-5311		CUI
DRAWN BY: JHG CHECKED BY: JHC DATE: 11/21/09	APPROVED BY: JHC SCALE: AS SHOWN	TYPE "B" CAP ISOLATION LAYER ACCEPTANCE SURVEY DRAWING NO. CUI-6

LEGEND

-  5'x5' GRID ELEVATION (FT)
-  BUCKET REFUSAL ENCOUNTERED VIA DREDGING
-  CU BOUNDARY
-  CU SUBUNIT BOUNDARY
-  MUD - RIP RAP INTERFACE
-  5 FOOT INTERFACE OFFSET
-  NAVIGATION CHANNEL
-  TOE OF FINAL DREDGE PRISM SLOPE

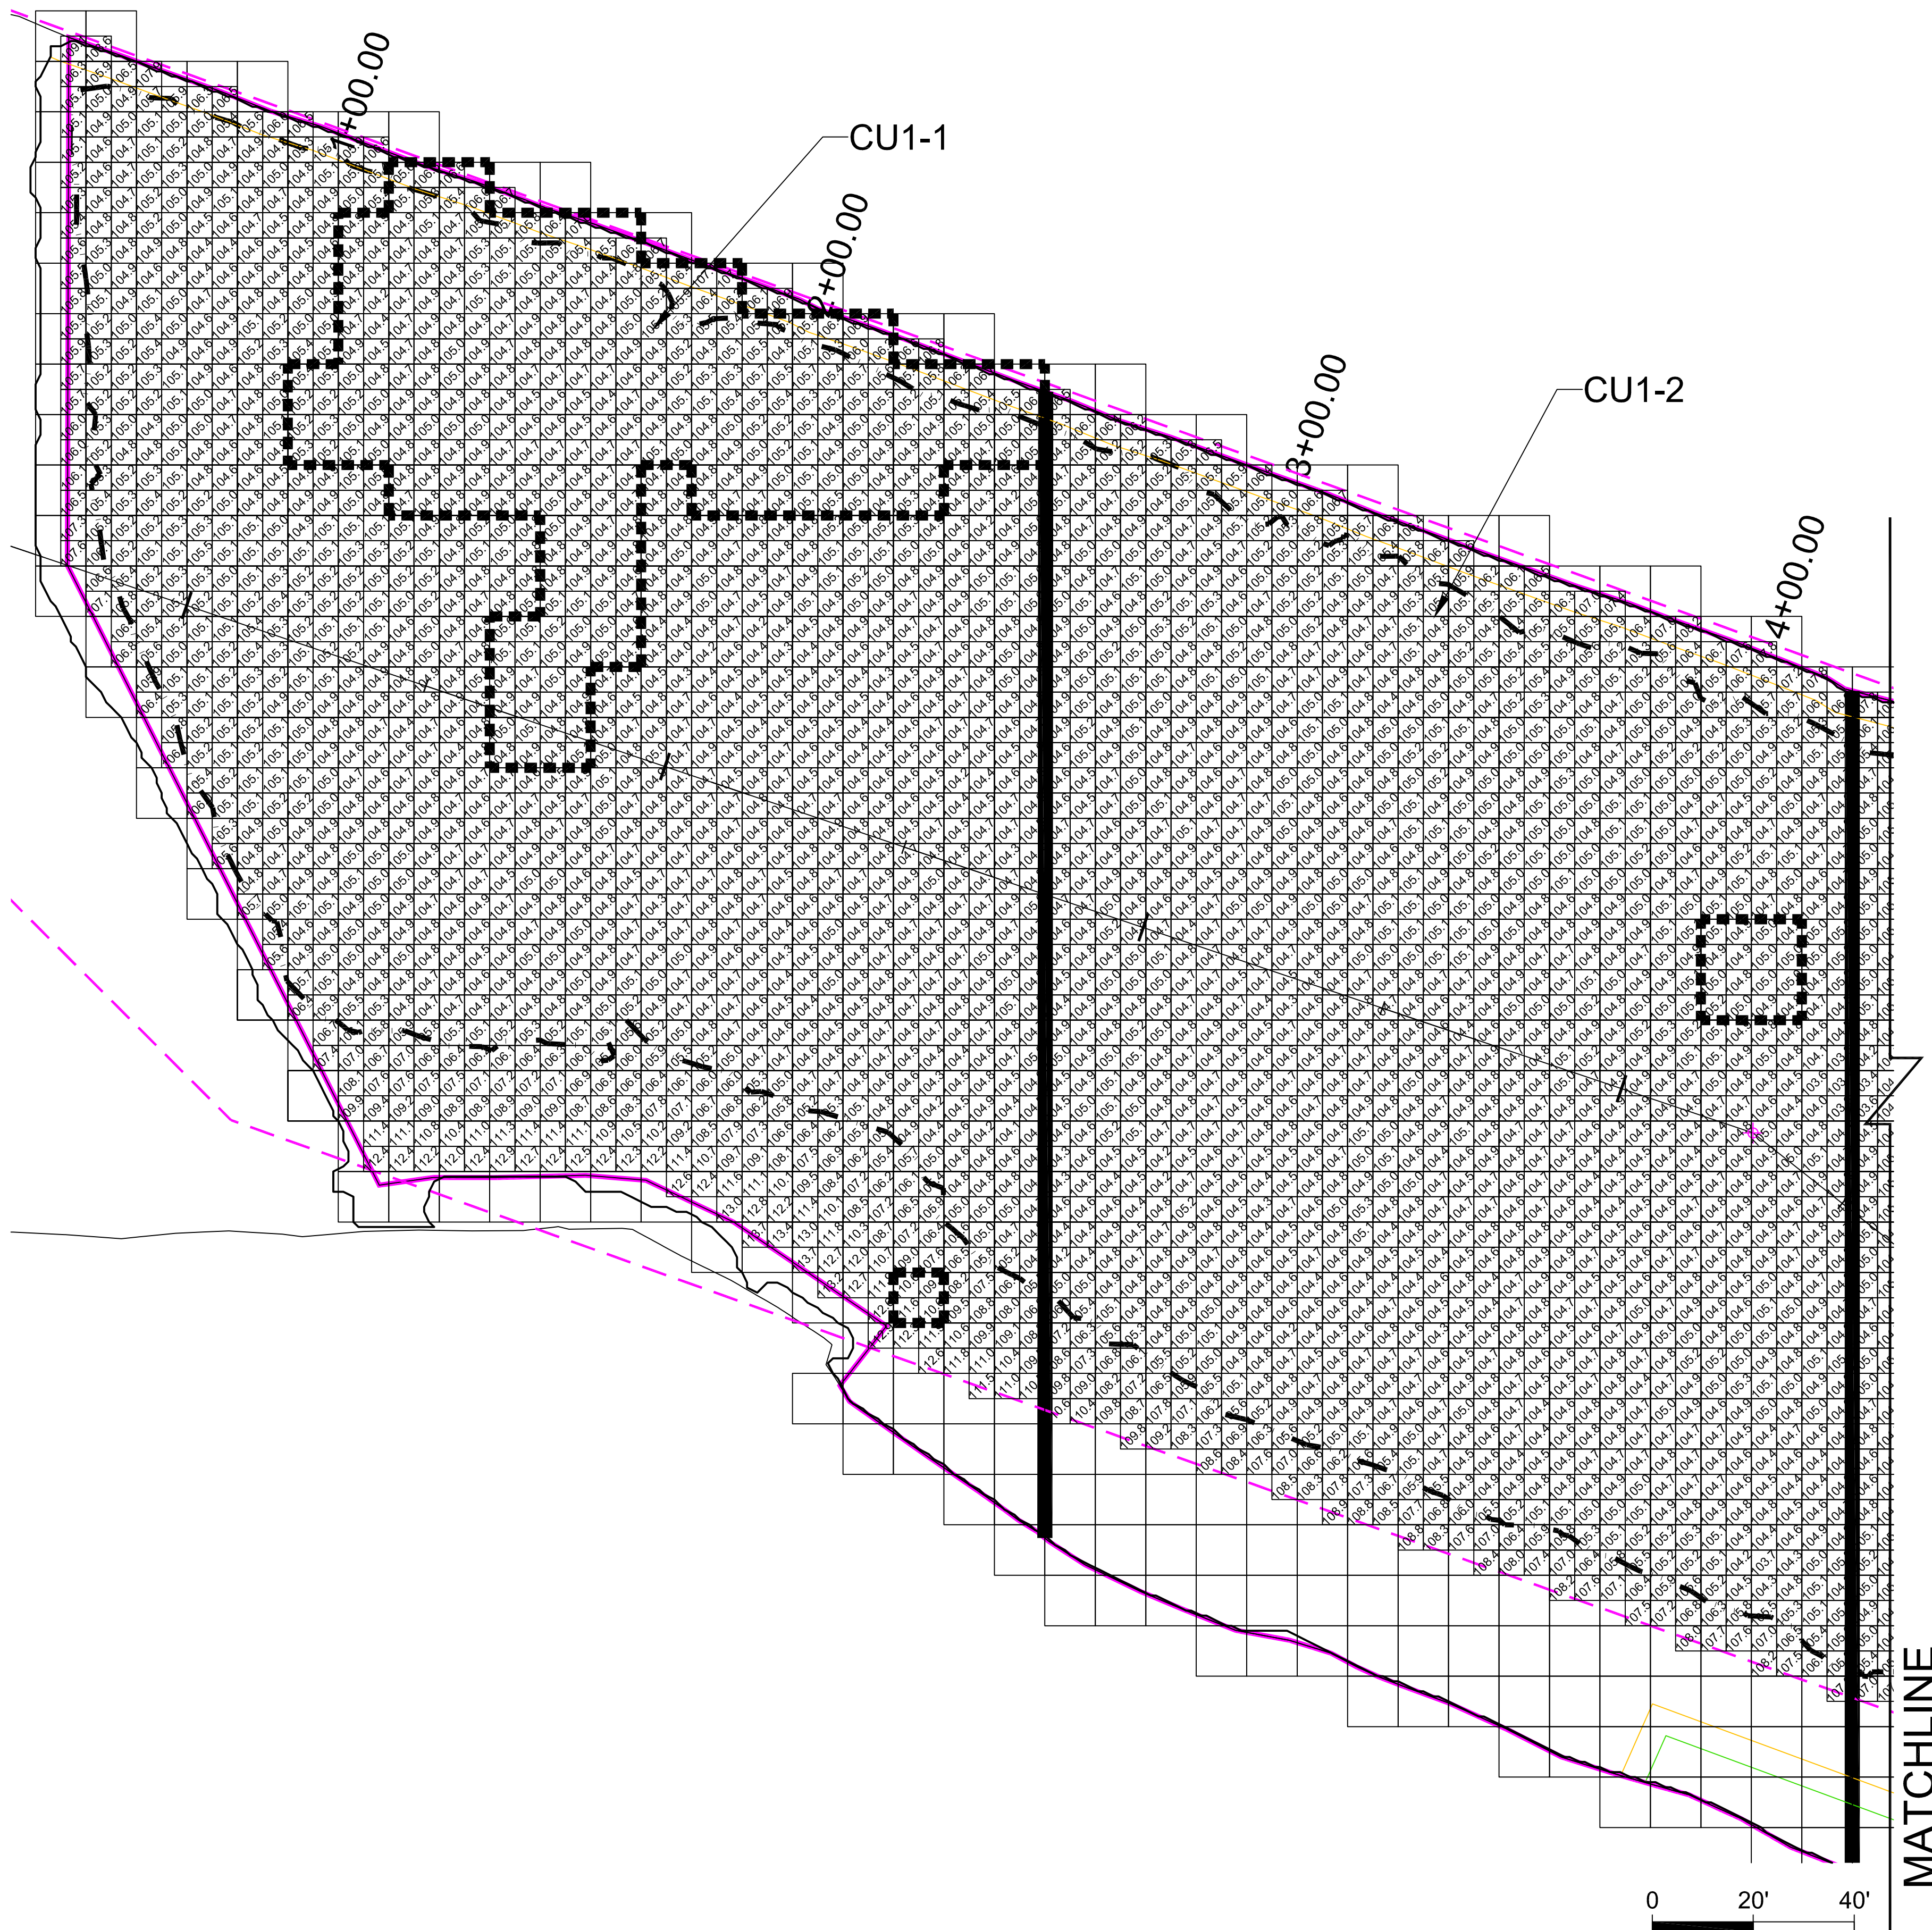

**CU1-1 & CU1-2 TYPE "B" CAP ARMOR
STONE PLACEMENT NAVIGATION
CHANNEL ELEVATIONS**



MATCHLINE









NOTES:



1. OSI MULTIBEAM SURVEY ON NOVEMBER 19, 2009.
2. ELEVATION OF CAP ARMOR LAYER IS LISTED IN 5'X5' GRIDS.
3. A REDUCED ARMOR LAYER (TYPE "O" AND TYPE "N" STONE) WAS PLACED IN CERTAIN LOCATIONS DUE TO RESTRICTIONS OF FINAL CAP ELEVATION IN NAVIGATION CHANNEL.

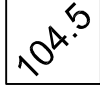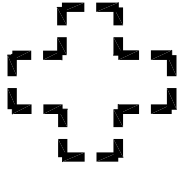DWG 1 OF 2

PARSONS ENGINEERING CONSULTING AND ARCHITECTURE GE COMPANY - PARSONS PROJECT OFFICE BUILDING 40-1, 381 BROADWAY FORT EDWARD, N.Y. 12828 (518) 746-5311		DRAWING TITLE CU1 TYPE "B" CAP ARMOR STONE NAV CHANNEL ELEVATIONS	
DRAWN BY JHC	CHECKED BY MG	DRAWING NO. CU1-7-1	SCALE AS SHOWN
DATE 11/21/09	APPROVED BY MG		JCB 442209.01401

LEGEND

-  5'x5' GRID ELEVATION (FT)
-  BUCKET REFUSAL ENCOUNTERED VIA DREDGING
-  CU BOUNDARY
-  CU SUBUNIT BOUNDARY
-  MUD - RIP RAP INTERFACE
-  5 FOOT INTERFACE OFFSET
-  NAVIGATION CHANNEL
-  TOE OF FINAL DREDGE PRISM SLOPE

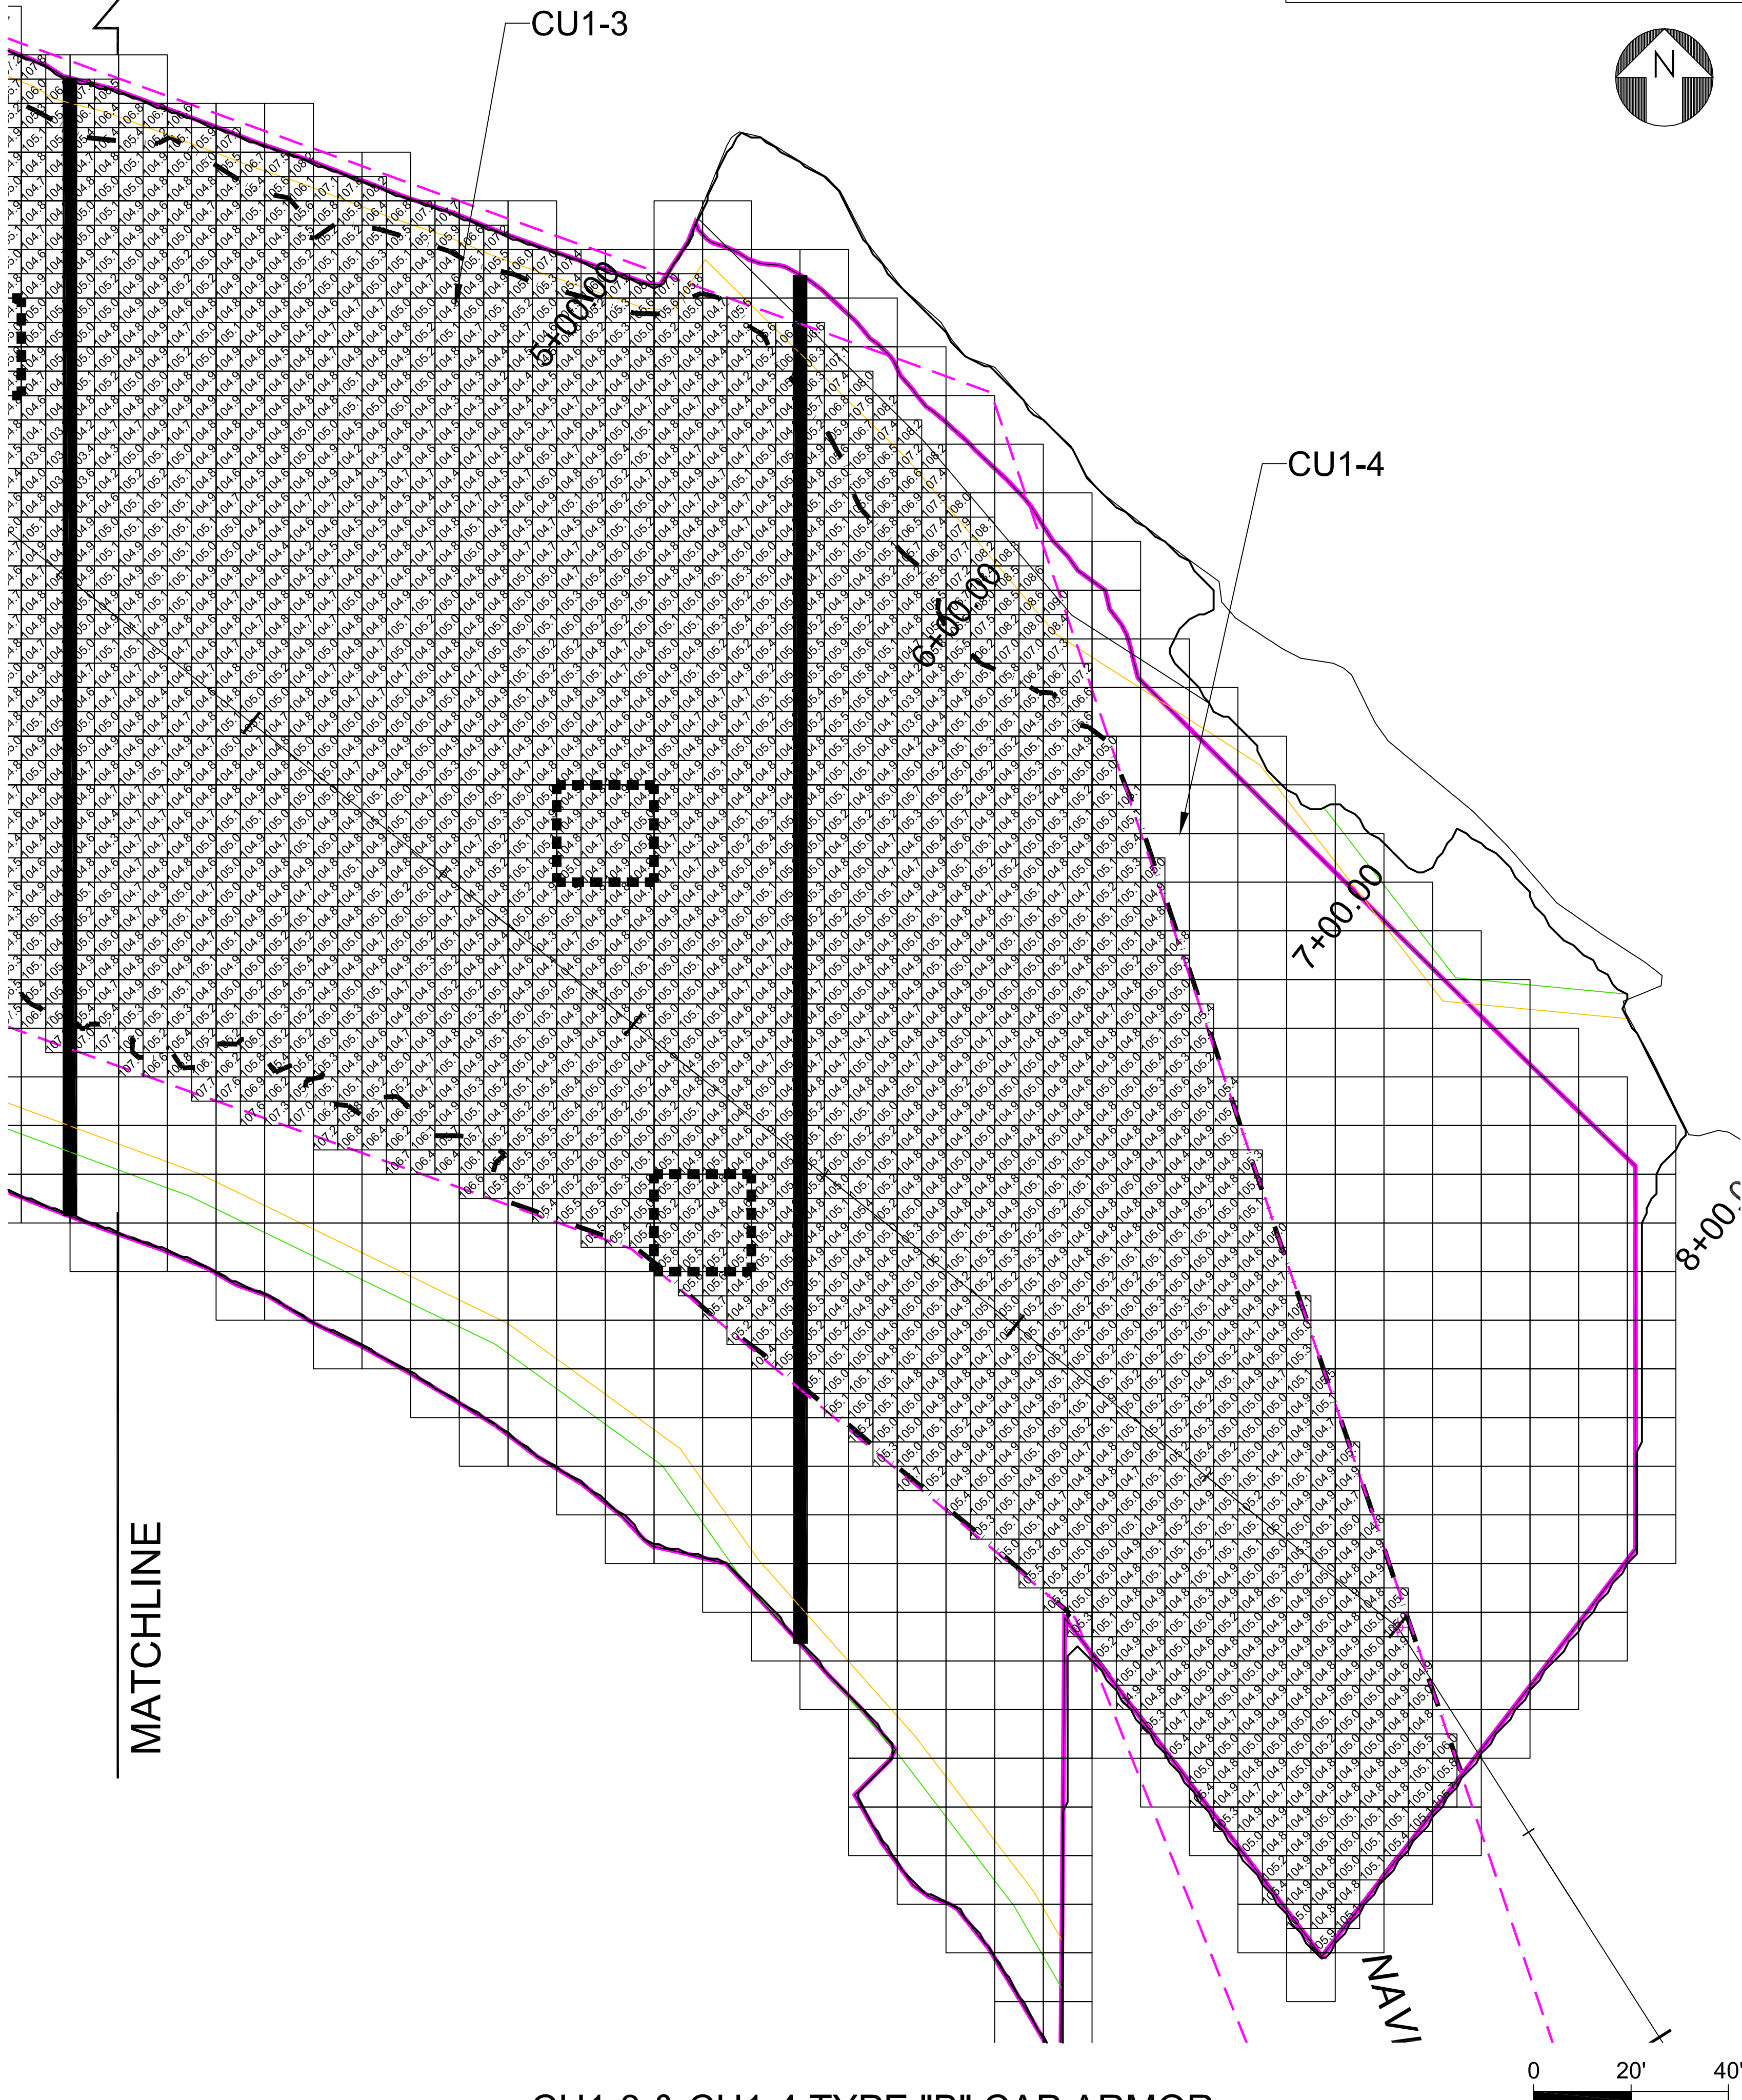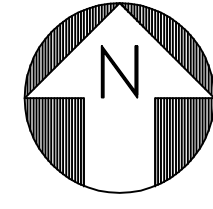

**CU1-3 & CU1-4 TYPE "B" CAP ARMOR
STONE PLACEMENT NAVIGATION
CHANNEL ELEVATIONS**




NOTES:

1. OSI MULTIBEAM SURVEY ON NOVEMBER 19, 2009.
2. ELEVATION OF CAP ARMOR LAYER IS LISTED IN 5'X5' GRIDS.
3. A REDUCED ARMOR LAYER (TYPE "O" AND TYPE "N" STONE) WAS PLACED IN CERTAIN LOCATIONS DUE TO RESTRICTIONS OF FINAL CAP ELEVATION IN NAVIGATION CHANNEL.

CU1
TYPE "B" CAP
ARMOR STONE
ACCEPTANCE SURVEY
NAVIGATION CHANNEL
ELEVATIONS

DWG 2 OF 2


PARSONS ENGINEERING CONSULTANTS ARCHITECTS		DRAWING TITLE	
GE COMPANY - PARSONS PROJECT OFFICE BUILDING 40-1, 381 BROADWAY FORT EDWARD, N.Y. 12828 (518) 746-5311		CU1 TYPE "B" CAP ARMOR STONE NAV CHANNEL ELEVATIONS	
DRAWN BY JHC	CHECKED BY MG	DRAWING NO. CU1-7-2	SCALE AS SHOWN
DATE 11/21/09	APPROVED BY MG	JOB 442209.01401	

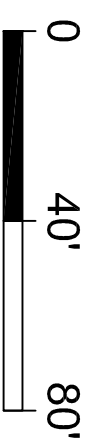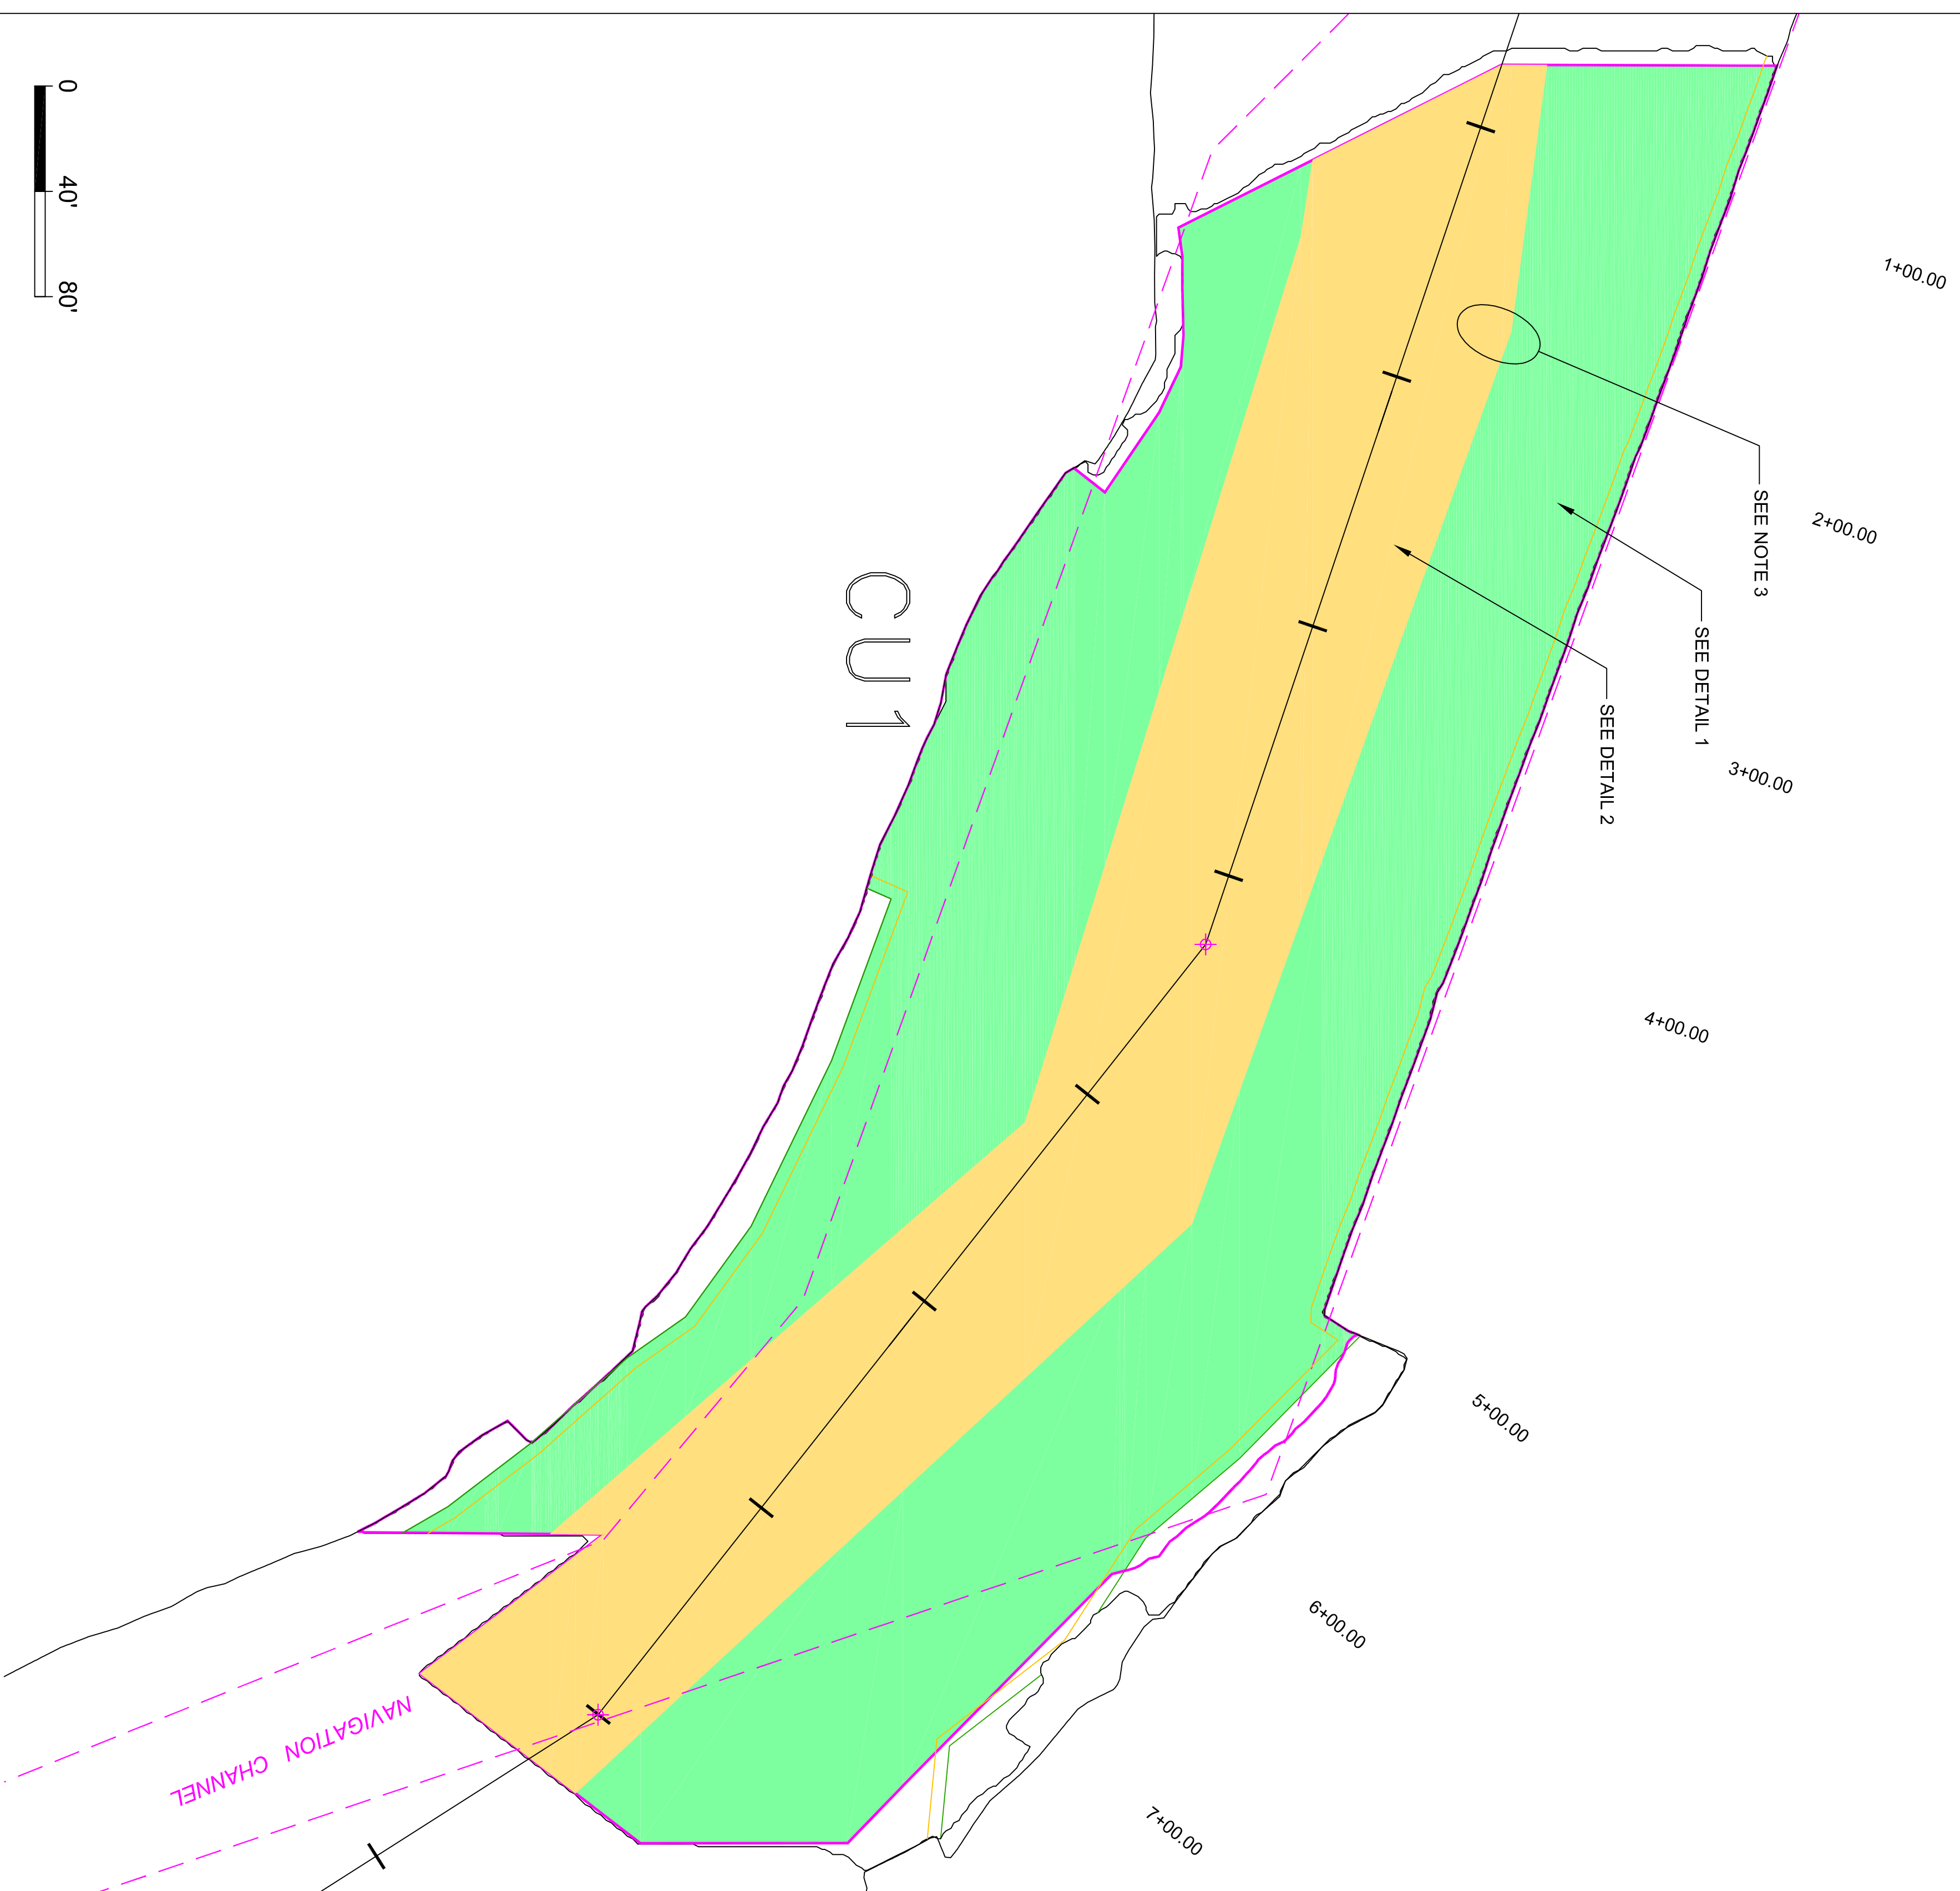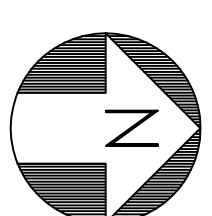


LEGEND

- CU BOUNDARY
- MUD - RIP RAP INTERFACE
- DREDGING OFFSET
- TYPE "B" - HIGH VELOCITY CAP (9 INCH ISOLATION LAYER OF TYPE 2 BACKFILL WITH TOC AND 6 INCH LAYER TYPE "O" COBBLE ARMOR)
- TYPE "B" - MEDIUM VELOCITY CAP (9 INCH ISOLATION LAYER OF TYPE 2 BACKFILL WITH TOC AND 6 INCH LAYER TYPE "N" ARMOR-STONE)
- COARSE GRAVEL

DETAIL 1 - TYPE "B" MEDIUM VELOCITY CAP CU1
NOT TO SCALE

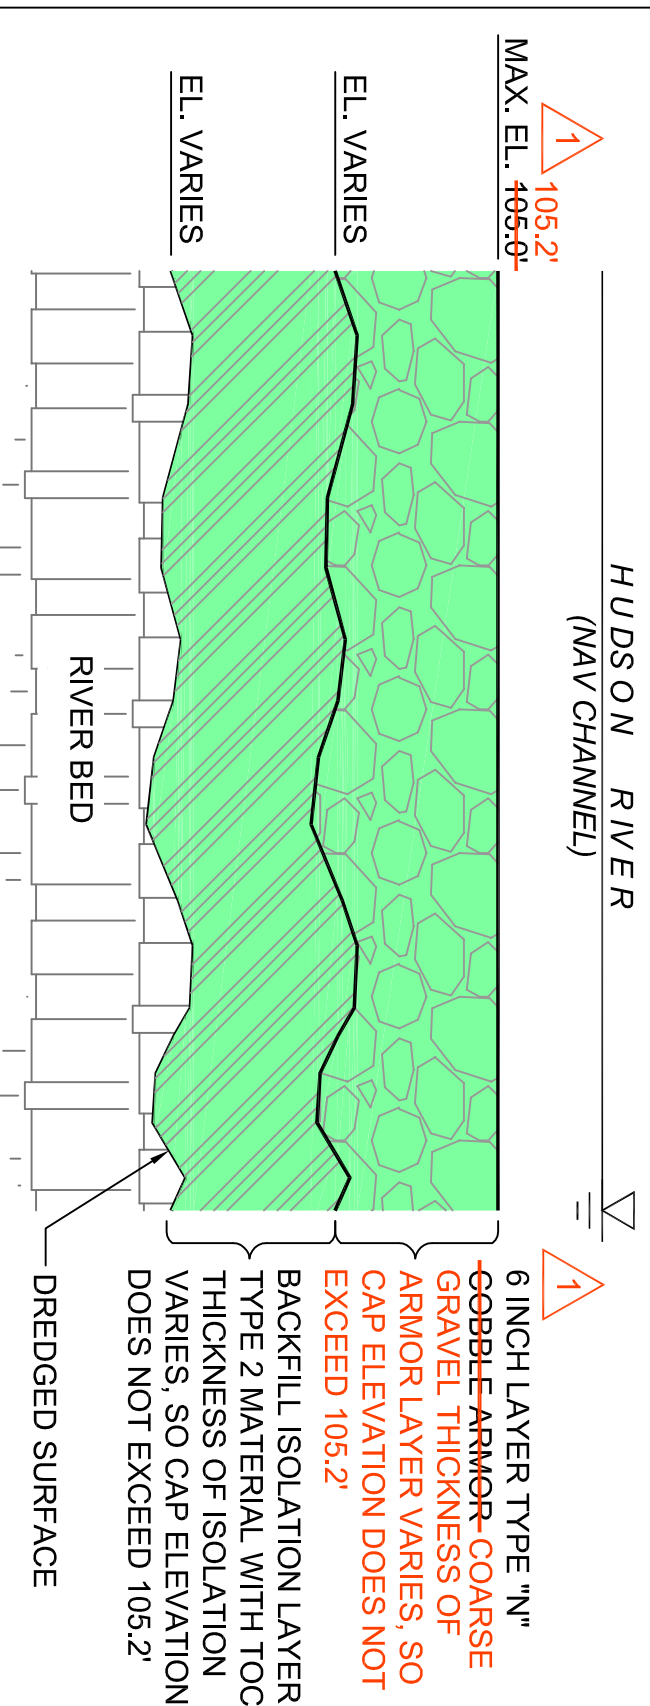

DETAIL 2 - TYPE "B" HIGH VELOCITY CAP CU1
NOT TO SCALE

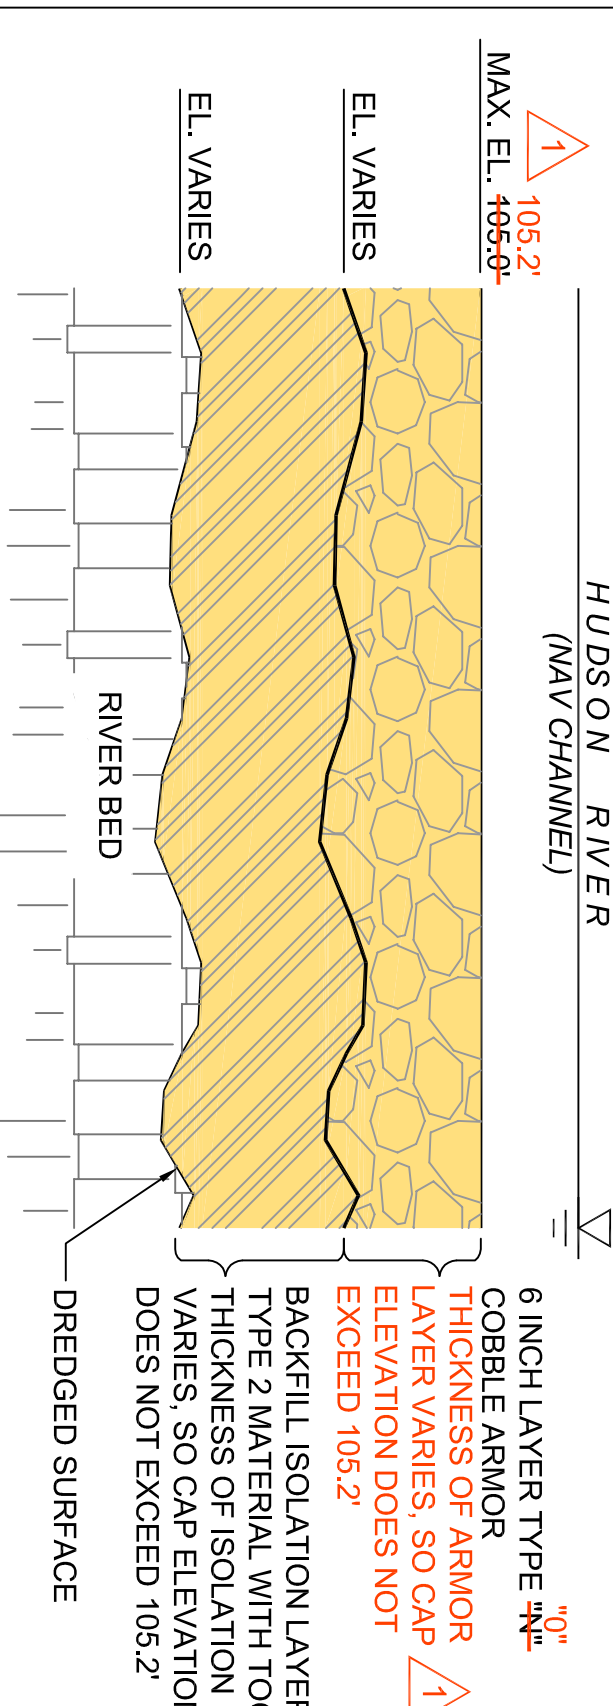

- NOTES:**
1. CAP MATERIALS TO BE PLACED IN ACCORDANCE WITH SECTION 13720 AND DESIGN DRAWING C-0038.
 2. THE TOP OF CAP IN NAVIGATION CHANNEL NOT TO EXCEED ELEVATION 105.2'.
 3. AERIAL EXTENT OF MEDIUM AND HIGH VELOCITY TYPE "B" ISOLATION CAP REVISED FROM PHASE 1 FINAL DESIGN DUE TO CHANGE IN VELOCITIES DUE TO DEEPER FINAL BATHYMETRY.

RECORD
DRAWING

DATE	11/21/09	DRAWN BY	JHG	CHECKED BY	MG	DRAWING TITLE	BACKFILL & CAP PLAN
APPROVED BY	MG	VERSION	AS SHOWN				
REV	DATE	DRN BY	DESCRIPTION		MG		
0	11/03/09	JHG	ISSUED FOR EPA REVIEW		MG		
1	11/21/09	JHG	RECORD DRAWING		MG		

Correspondence
(Letters and Emails)

Inglis, Andrew A (GE, Corporate)

From: Inglis, Andrew A (GE, Corporate)
Sent: Tuesday, November 10, 2009 8:13 PM
To: king.david@epamail.epa.gov
Cc: MJohnson@louisberger.com; timothy.kruppenbacher@ge.com; michael.galbraith@parsons.com; Bryan Miner (USACE_HRFO@roadrunner.com); GKlawinski@ene.com; Joseph Moloughney
Subject: Discussion regarding CU1 and 2 Backfill and Cap

Dave,

Yesterday we met and reviewed progress surveys of cap isolation layer placement in CU1 and cap armor stone placement in CU2. This email confirms decisions made during the meeting based on reviews of the maps.

CU1.

In Cu1-1 GE will remove excess backfill material so that armor stone can be placed below 105.2' elevation. This excess backfill material will then be placed in areas of CU1-3 and Cu1-4.

In CU1-3 and 1-4 GE will place additional material to raise the isolation layer to be as close to 9" as possible while also providing room to place the armor layer below 105.2'.

It was agreed that the isolation layer placement in CU1-2 was acceptable.

CU2.

The cap armor stone layer in the southern half of the CU was agreed to be acceptable. It was agreed that portions of the cap armor stone in the northern half of the CU will require additional material. It was also agreed that placing additional Type O material in those areas would result in the cap being above elevation 105.2'. To avoid this situation we agreed that Type N stone could be placed to supplement areas where type O stone had already been placed.

Please let me know if I missed anything.

Thanks,

Andrew A. Inglis
Dredging Task Leader
GE

T +1 518-746-5256

381 Broadway
Building 40-2
Fort Edward, NY 12828
GE Corporate Environmental Programs

[GE Imagination at Work](#)

Inglis, Andrew A (GE, Corporate)

From: King.David@epamail.epa.gov
Sent: Saturday, November 14, 2009 9:36 AM
To: Inglis, Andrew A (GE, Corporate)
Cc: Michael J. Johnson; Kruppenbacher, Timothy A (GE, Corporate); michael galbraith; Bryan Minor; Gary Klawinski; Joseph Moloughney
Subject: Re: Discussions regarding CU Backfill and Cap placement

Andrew, I agree with summary.
Dave
Sent by EPA Wireless E-Mail Services

From: "Inglis, Andrew A (GE, Corporate)" [andrew.inglis@ge.com]
Sent: 11/13/2009 05:13 PM EST
To: David King
Cc: <MJohnson@louisberger.com>; "Kruppenbacher, Timothy A (GE, Corporate)" <timothy.kruppenbacher@ge.com>; <michael.galbraith@parsons.com>; <USACE_HRFO@roadrunner.com>; <GKlawinski@ene.com>; "Joseph Moloughney" <Joseph_Moloughney@canals.state.ny.us>
Subject: Discussions regarding CU Backfill and Cap placement

Dave,
Today and yesterday we met and reviewed progress surveys of cap and backfill placement in CUs 1, 2, 3, 4, 7 and 18. This email confirms decisions made during the meeting based on reviews of the maps presented during the meeting.

CU1.

In CU1 it was agreed that sufficient thickness of isolation layer material has been placed while providing enough room to place armor stone below the 105.2' elevation in the navigation channel. It was agreed that placement of armor stone can begin.

CU2.

In CU2 it was agreed that the top of cap and backfill elevations were acceptable. GE will prepare a Form 2 package for EPA review.

CU3 .

In CU3 it was agreed that the top of cap and backfill elevations were acceptable, it was discussed that GE was in the process of placing backfill in an area of the navigation channel where the post dredge elevations were below 102' elevation. Once GE has surveyed that additional backfill location GE will prepare a Form 2 package for EPA review.

CU4.

In CU4 it was agreed that the top of cap elevations in the north east quarter of the CU was acceptable and that backfill placment in that area may begin.

CU7.

In CU7 it was agreed that the top of cap and backfill elevations were acceptable. GE will prepare a Form 2 package for EPA review.

CU18

In CU18 it was agreed that the top of cap elevations were acceptable in both of the cap locations in that CU.

Please let me know if I missed anything.

Thanks,

Andrew A. Inglis
Dredging Task Leader
GE

T +1 518-746-5256

381 Broadway
Building 40-2
Fort Edward, NY 12828
GE Corporate Environmental Programs

GE Imagination at Work

Inglis, Andrew A (GE, Corporate)

From: King.David@epamail.epa.gov
Sent: Saturday, November 21, 2009 9:09 AM
To: Inglis, Andrew A (GE, Corporate)
Cc: Mirarchi, Jeff (GE, Corporate, non-ge); Joseph Moloughney; MJohnson@louisberger.com; Kruppenbacher, Timothy A (GE, Corporate); USACE_HRFO@roadrunner.com; MJohnson@louisberger.com; Klawinski, Gary; Rosoff.David@epamail.epa.gov; Skopeck.Kristen@epamail.epa.gov; USACE_HRFO@roadrunner.com; Conetta.Benny@epamail.epa.gov; EGarvey@louisberger.com; mchapman@ene.com
Subject: RE: CU1 Elevations

Andrew,
Cap elevations look good for CU1.

Dave

CU-02

Form 2

CU Certification of Completion

CU BACKFILL/ENGINEERED CAP COMPLETION APPROVAL - FORM 2						
Reporting Date	11/19/2009				Placement Start Date	10/12/2009
CU Number	2				Placement End Date	11/13/2009
Approximate CU Centroid	Northing	1614979	Easting	736038	NY State NAD 83	
CU Size	5.06	Acres				
Backfill Area	1.64	Acres				
Cap Area	3.42	Acres				
Backfill Surface Mean Tri+ PCBs Concentration (when required)		NA		mg/kg		
Number of nodes sampled		NA		mg/kg		
Backfill X	Type of Backfill Type 1, Type 2, Nearshore	Reference to appropriate drawings attached to Approval Form 1 CU2 Backfill and Cap Plan, 10/11/09				
Cap X	Type of Cap Type "B" Low Velocity Cap, Type "B" Medium Velocity Cap, Type "B" High Velocity Cap & Type "B" High Velocity Low Profile Cap	Reference to appropriate drawings attached to Approval Form 1 CU2 Backfill and Cap Plan, 10/11/09				
CU Checklist		Indicate one of the following			Reviewer Initial Acceptance	
Item	Attached	Not Applicable	GE	EPA		
Drawing of Installed Backfill/Cap (with record details, thickness and sample locations [when backfill/cap are placed])	x					
Where applicable in backfill areas provide the following: Sample locations (coordinates), depths, Aroclor and Tri+ PCB concentrations collected including analytical data, field observations, (hard copy and electronic copies [in database format or equivalent])		x				
Comments						
Refer to attached Narrative Backfill Summary and CU 2 Backfill Placement Drawing.						
Upon signing this document, GE certifies that the backfill/cap has been installed satisfactorily and that no further backfill placement or capping is required for this CU. These remedial activities exclude long term operation, monitoring, maintenance and adaptive management at the CU. EPA accepts this certification.						
Signature of GE Representative				Signature of EPA Representative		
Signature _____				Signature _____		
Name _____				Name _____		
Date _____				Date _____		

Narrative

CU 2

Narrative Summary of Backfill and Capping and EPA Backfill and Capping Agreements

1.0 Cap Placement

A Type "B" Low Velocity Cap, a Type "B" Medium Velocity Cap, a Type "B" High Velocity Cap, and a Type "B" Low Profile High Velocity Cap was placed in accordance with the CU 2 Backfill and Cap Plan Drawing, dated October 11, 2009, which was provided to EPA as part of the CU 2 Form 1 package. A multi-beam bathymetric survey of the Type "B" Cap Isolation layer was performed on October 21, 2009. This survey indicated areas within the Navigation Channel from Station 21+00.00 to approximately Station 24+00.00 required shoaling to reduce the isolation layer thickness in order to place armor stone. This work was completed from October 23 through October 26, 2009 and resurveyed on October 27, 2009. On October 28, 2009 during a 3:00 PM meeting with EPA, GE presented a map showing the isolation layer thickness and corresponding elevations within the Navigation Channel. EPA agreed the isolation layer thickness was sufficient to place armor stone. Multi-beam surveys of the armor stone were completed on November 1 and November 11, 2009, as shown on the attached CU 2 Cap Type "B" Armor Layer Acceptance Survey, dated November 18, 2009. The surveyed cap thickness on a 5' x 5' grid is shown for all cap areas.

2.0 Backfill Placement

Backfill materials were placed in accordance with the CU 2 Backfill and Cap Plan Drawing, dated October 11, 2009, provided to EPA as part of the CU 18 Form 1 package. A multi-beam bathymetric survey for CU 2 was performed after backfill placement on November 14, 2009, as shown on the attached CU 2 Backfill Placement Acceptance Survey drawing, dated November 18, 2009. The numeric values difference in the 10' x 10' grids represent difference to target thickness (positive numbers reflect thickness above target thickness).

3.0 EPA Field Agreements Specific to CU 3 Backfill and Capping

1. During the 4:00 PM meeting on October 12, 2009, EPA agreed that acceptance surveys of partial areas of a CU may be performed and used for acceptance once placement of backfill or cap in those areas is complete.
2. During the 4:00 PM meeting on October 14, 2009, GE discussed the challenges in placing cap material in areas with slopes in excess of 3:1. In CU2 north of Bond Creek, placement of the isolation layer on steep slopes near the navigation channel slopes are light of isolation layer

material and bottom of slope were heavy with material. EPA agreed the ability to maintain the design cap tolerance was limited in these areas.

3. On October 28, 2009 during a 3:00 PM meeting with EPA, GE presented a map showing the isolation layer thickness and corresponding elevations within the Navigation Channel. EPA agreed the isolation layer thickness, as shown, was sufficient to place armor stone (see attached e-mail dated October 28, 2009).
4. During a 3:00 PM meeting with EPA on November 9, 2009, GE presented a preliminary Cap Acceptance Survey Map on a 5' x 5' grid in CU 2. It was observed that the required thickness of armor stone in high velocity Type "B" caps in navigation channel areas had not been obtained but there was not sufficient depth to place additional Type "O" material. GE proposed that rather than place additional Type "O" material in these areas, that Type "N" material be placed. EPA agreed that placement of Type "N" material to finish high velocity Type B caps was acceptable in areas of the Navigation Channel with depth restrictions (see attached e-mail summary dated November 10, 2009).
5. During a 3:00 PM meeting with EPA on November 12, 2009, GE presented a Cap Acceptance Survey Map on a 5' x 5' grid in CU 2. EPA agreed that the cap thicknesses, as shown, were acceptable (see attached e-mail, dated November 14, 2009). The CU2 Type "B" Cap Acceptance Survey Drawing, dated November 18, 2009 is included in this package.
6. During a 3:00 PM meeting with EPA on November 13, 2009, GE presented a drawing and table showing the Riverine Fringing Wetland (RFW) area in Bond Creek. EPA agreed that backfill placement within the RFW area was acceptable. Table and drawing CU2 Bond Creek RFW Detail, dated November 11, 2009, is included in this package.
7. On November 18, 2009, GE provided EPA with acceptance surveys of the difference to backfill prisms on a 10' x 10' grid in CU 2. EPA agreed that the top backfill elevations, as shown, were acceptable. The Backfill Placement Acceptance Survey Drawing, dated November 18, 2009 is included in this package.

Tables

Table 1. CU-2 All Near-Shore Topographic Measurements

Published Near-Shore Border Set Points				Near-Shore Topographic Measurements				
Name	Easting	Northing	Target Elevation	Easting	Northing	Check Elevation	Horz. Dist	Vert Diff.
2-1	735841.76	1615734.89	117.50	735,841.81	1,615,734.91	117.89	0.05	0.39
2-2	735857.89	1615684.63	117.50	735,857.96	1,615,684.72	118.67	0.12	1.17
				735,854.93	1,615,684.60	117.80	2.97	0.30
2-3	735883.57	1615617.11	117.50	735,883.37	1,615,617.11	117.90	0.20	0.40
2-4	735908.80	1615548.38	117.50	735,908.60	1,615,548.34	118.82	0.21	1.32
				735,907.95	1,615,547.73	118.19	1.07	0.69
				735,904.76	1,615,547.37	117.23	4.17	-0.28
2-5	735939.67	1615458.34	117.50	735,939.54	1,615,458.45	117.91	0.17	0.41
2-6	735985.11	1615367.25	117.50	735,985.26	1,615,367.53	117.22	0.31	-0.28
2-7	736022.46	1615300.38	117.50	736,022.22	1,615,300.28	117.22	0.26	-0.28
2-8	736050.98	1615230.08	117.50	736,050.92	1,615,230.05	116.50	0.07	-1.00
				736,051.83	1,615,235.19	116.70	5.18	-0.80
				736,055.43	1,615,236.74	117.64	8.01	0.14
2-9	736071.44	1615163.20	117.50	736,071.41	1,615,163.13	116.45	0.08	-1.05
				736,076.99	1,615,166.56	117.12	6.48	-0.38
				736,080.32	1,615,166.94	117.61	9.63	0.11
2-10	736083.15	1615096.33	117.50	736,083.23	1,615,096.37	116.78	0.09	-0.72
				736,085.77	1,615,097.60	117.55	2.92	0.05
				736,089.37	1,615,098.07	118.69	6.46	1.19
2-11	736116.21	1615029.22	117.50	736,116.34	1,615,029.11	117.89	0.17	0.39
2-12	736157.82	1614957.28	117.50	736,157.70	1,614,957.53	118.87	0.28	1.37
				736,153.59	1,614,955.37	118.81	4.64	1.31
				736,151.41	1,614,954.40	118.54	7.02	1.04
				736,147.60	1,614,951.10	117.44	11.94	-0.06
2-13	736171.84	1614931.95	117.50	736,171.89	1,614,931.93	118.65	0.06	1.15
				736,167.88	1,614,932.28	118.45	3.97	0.95
				736,160.59	1,614,928.52	117.77	11.75	0.27
2-14	736219.74	1614698.77	117.50	736,219.71	1,614,698.78	116.76	0.03	-0.74
				736,222.65	1,614,700.01	117.42	3.16	-0.08
				736,227.14	1,614,700.64	118.15	7.63	0.65
2-15	736217.02	1614697.84	117.50	736,217.10	1,614,697.70	116.14	0.16	-1.36
2-16	736243.00	1614614.90	117.50	736,243.06	1,614,615.16	115.39	0.27	-2.11
				736,246.34	1,614,615.16	117.34	3.35	-0.16
				736,250.04	1,614,615.57	118.88	7.07	1.38
2-17	736269.59	1614532.00	117.50	736,269.88	1,614,531.94	117.25	0.30	-0.25
2-18	736279.53	1614491.00	117.50	736,279.56	1,614,491.00	116.43	0.03	-1.07
				736,282.48	1,614,492.13	117.67	3.16	0.17
				736,286.44	1,614,493.87	118.44	7.48	0.94
				736,291.76	1,614,495.04	118.17	12.88	0.67
2-19	735851.62	1615280.20	117.50	735,851.54	1,615,280.36	117.55	0.17	0.05
2-20	735881.26	1615194.92	117.50	735,881.40	1,615,195.12	116.56	0.25	-0.94
				735,879.06	1,615,194.84	117.66	2.21	0.16
2-21	735906.78	1615109.24	117.50	735,906.68	1,615,109.48	116.69	0.26	-0.81
				735,903.59	1,615,108.47	117.63	3.28	0.13
2-22	735933.67	1615017.86	117.50	735,933.56	1,615,017.85	117.14	0.12	-0.36
2-23	735955.32	1614925.87	117.50	735,955.34	1,614,926.13	117.66	0.26	0.16
	735970.50	1614847.32	117.50	735,970.67	1,614,847.28	116.73	0.17	-0.77
2-24				735,967.97	1,614,846.38	117.22	2.70	-0.28
				735,964.47	1,614,845.57	117.97	6.28	0.47
				735,960.15	1,614,844.41	118.33	10.76	0.83
2-25	735987.03	1614754.34	117.50	735,986.81	1,614,754.02	117.29	0.39	-0.21
2-26	736010.78	1614665.66	117.50	736,010.97	1,614,665.51	116.73	0.25	-0.77
				736,007.38	1,614,664.75	117.55	3.51	0.05
				736,003.07	1,614,663.15	118.48	8.11	0.97
				736,000.11	1,614,662.99	119.06	10.99	1.56
2-27	736028.90	1614572.77	117.50	736,029.07	1,614,572.73	116.62	0.17	-0.88
				736,027.27	1,614,572.07	117.54	1.78	0.04
				736,024.64	1,614,571.13	118.14	4.56	0.64
2-28	736055.32	1614461.44	117.50	736,055.29	1,614,461.74	117.78	0.30	0.28
2-29	736057.92	1614451.52	117.50	736,058.13	1,614,451.34	117.53	0.28	0.03

Notes:

1. Measurements Collected 2009-11-12 and 2009-11-16 using standard land survey methods.
2. At near shore set point locations where the set point elevation was not at tolerance, additional measurements were taken at nearby locations to provide additional information.

Figures

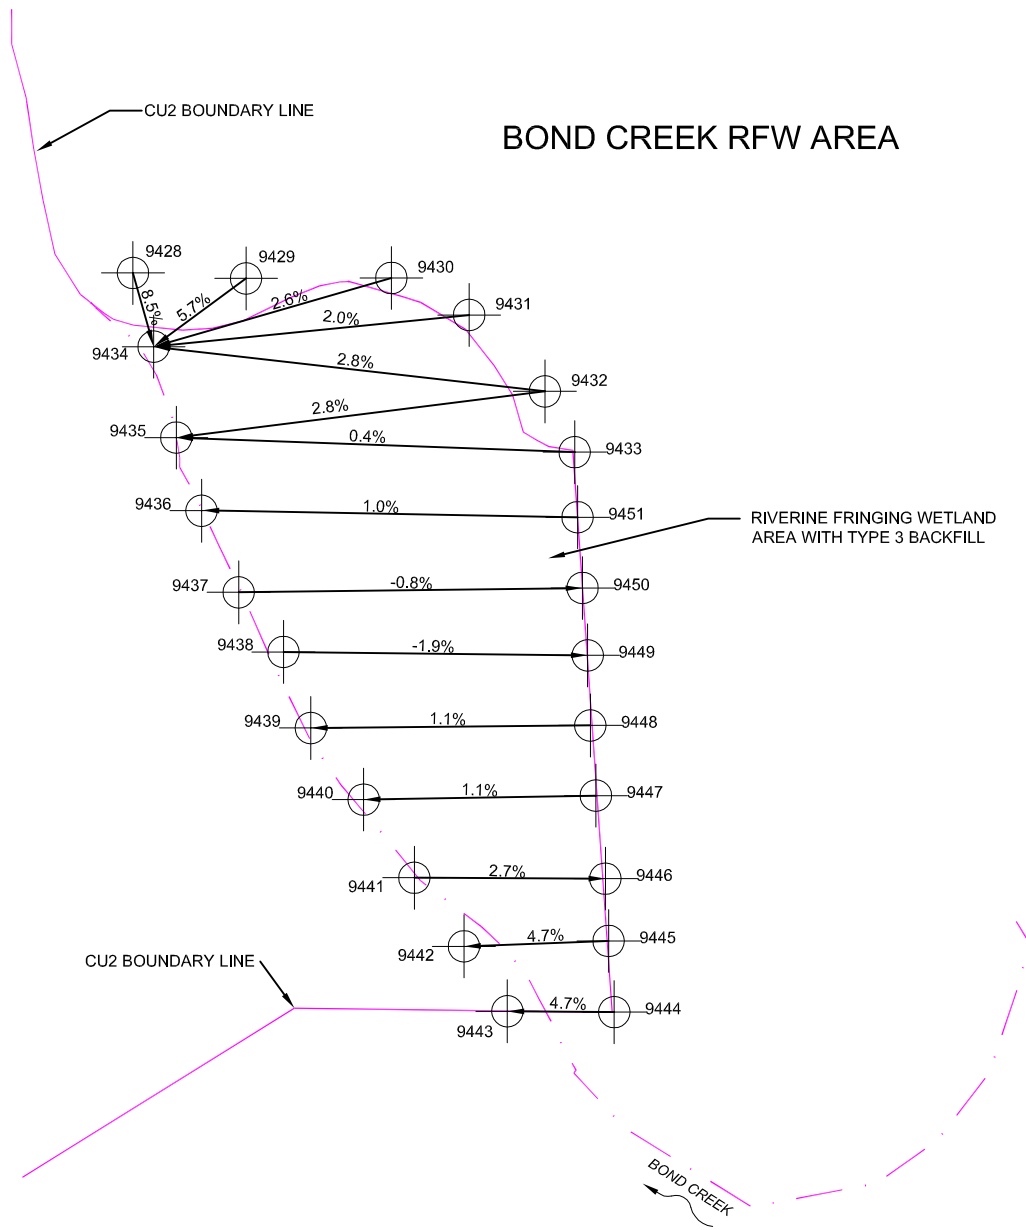


Table 1. CU-2 Bond Creek Riverine Fringing Wetland Area
 Topographic data collected 2009-11-05.

ID #	Easting	Northing	Elev. (ft)	Comments	ID #	Easting	Northing	Elev. (ft)	Comments	Elev. Change (ft)	Distance (ft)	Grade %
9443	736,198.25	1,614,931.53	118.35	Behind Bio-log	9444	736,221.03	1,614,931.36	119.42	CU Border	1.07	22.8	4.7%
9442	736,189.01	1,614,945.37	117.82	Behind Bio-log	9445	736,219.84	1,614,946.52	119.26	CU Border	1.44	30.8	4.7%
9441	736,178.43	1,614,960.00	118.35	Behind Bio-log	9446	736,219.14	1,614,959.81	119.45	CU Border	1.10	40.7	2.7%
9440	736,167.62	1,614,976.66	117.83	Behind Bio-log	9447	736,217.12	1,614,977.51	118.39	CU Border	0.56	49.5	1.1%
9439	736,156.35	1,614,991.92	116.92	Behind Bio-log	9448	736,215.93	1,614,992.46	117.57	CU Border	0.65	59.6	1.1%
9438	736,150.53	1,615,008.12	118.80	Behind Bio-log	9449	736,215.38	1,615,007.40	117.57	CU Border	-1.22	64.9	-1.9%
9437	736,140.98	1,615,020.84	118.99	Behind Bio-log	9450	736,214.27	1,615,021.76	118.37	CU Border	-0.61	73.3	-0.8%
9436	736,133.06	1,615,038.23	117.90	Behind Bio-log	9451	736,213.22	1,615,036.84	118.73	CU Border	0.83	80.2	1.0%
9435	736,127.68	1,615,053.82	118.11	Behind Bio-log	9433	736,212.61	1,615,050.73	118.49	CU Border	0.38	85.0	0.4%
9435	736,127.68	1,615,053.82	118.11	Behind Bio-log	9432	736,206.26	1,615,063.68	120.36	Water's Edge	2.25	79.2	2.8%
9434	736,122.85	1,615,073.21	118.95	Behind Bio-log	9428	736,118.44	1,615,088.93	120.33	Water's Edge	1.39	16.3	8.5%
9434	736,122.85	1,615,073.21	118.95	Behind Bio-log	9429	736,142.56	1,615,087.76	120.35	Water's Edge	1.40	24.5	5.7%
9434	736,122.85	1,615,073.21	118.95	Behind Bio-log	9430	736,173.53	1,615,087.85	120.32	Water's Edge	1.37	52.8	2.6%
9434	736,122.85	1,615,073.21	118.95	Behind Bio-log	9431	736,190.11	1,615,079.97	120.32	Water's Edge	1.37	67.6	2.0%
9434	736,122.85	1,615,073.21	118.95	Behind Bio-log	9432	736,206.26	1,615,063.68	120.36	Water's Edge	1.42	84.0	1.7%

Notes:

1. Grid system is in feet and in the New York State Plane coordinate system (East Zone) North American Datum 1983 (NAD83).
2. Elevations are in feet and are referenced to North American Vertical Datum 1988 (NAVD88) based on benchmark "GE-HR-07R" having an elevation of 131.89' NAVD88.
3. The information provided represents the results of surveys performed by Ocean Surveys, Inc. (OSI) with Van Dusen and Steves on 5 November 2009 and can only be considered as indicating the conditions existing at that






PARSONS
 COMMERCIAL TECHNOLOGY GROUP
 GE COMPANY - PARSONS PROJECT OFFICE
 BUILDING 40-1, 381 BROADWAY
 FORT EDWARD, N.Y. 12828 (518) 746-5311

DRAWN BY: JHG
 CHECKED BY: MG
 DATE: 11/11/09
 APPROVED BY: MG

DRAWING TITLE: CU2 BOND CREEK RFW DETAIL

DRAWING NO.: CU2-BOND CREEK
 SCALE: AS SHOWN
 JOB: 442209.01401

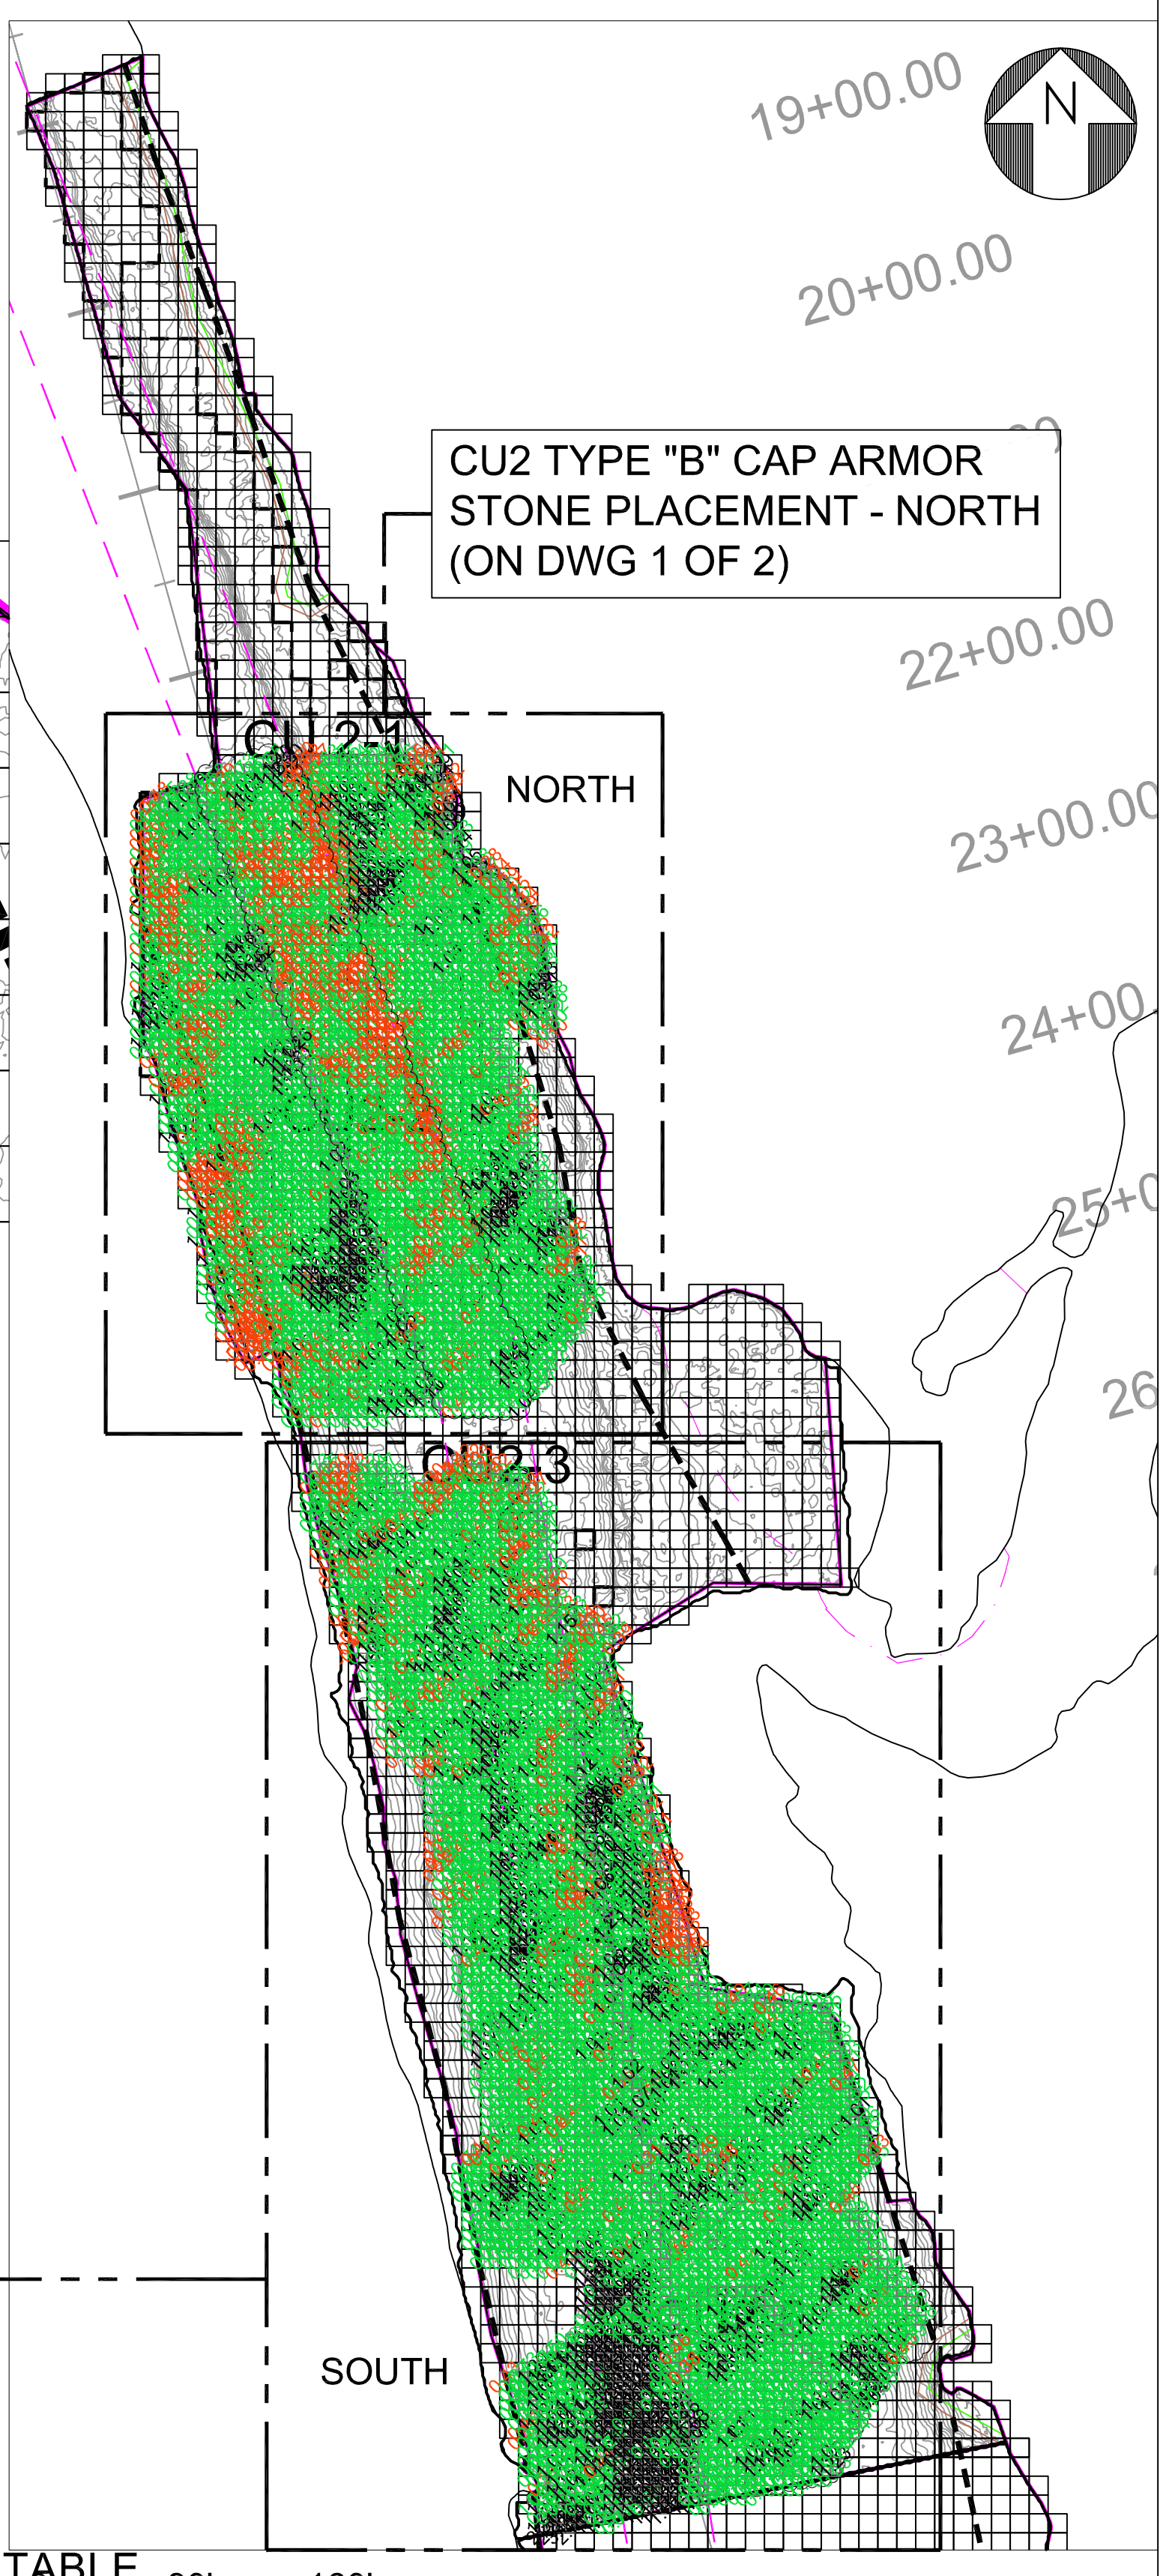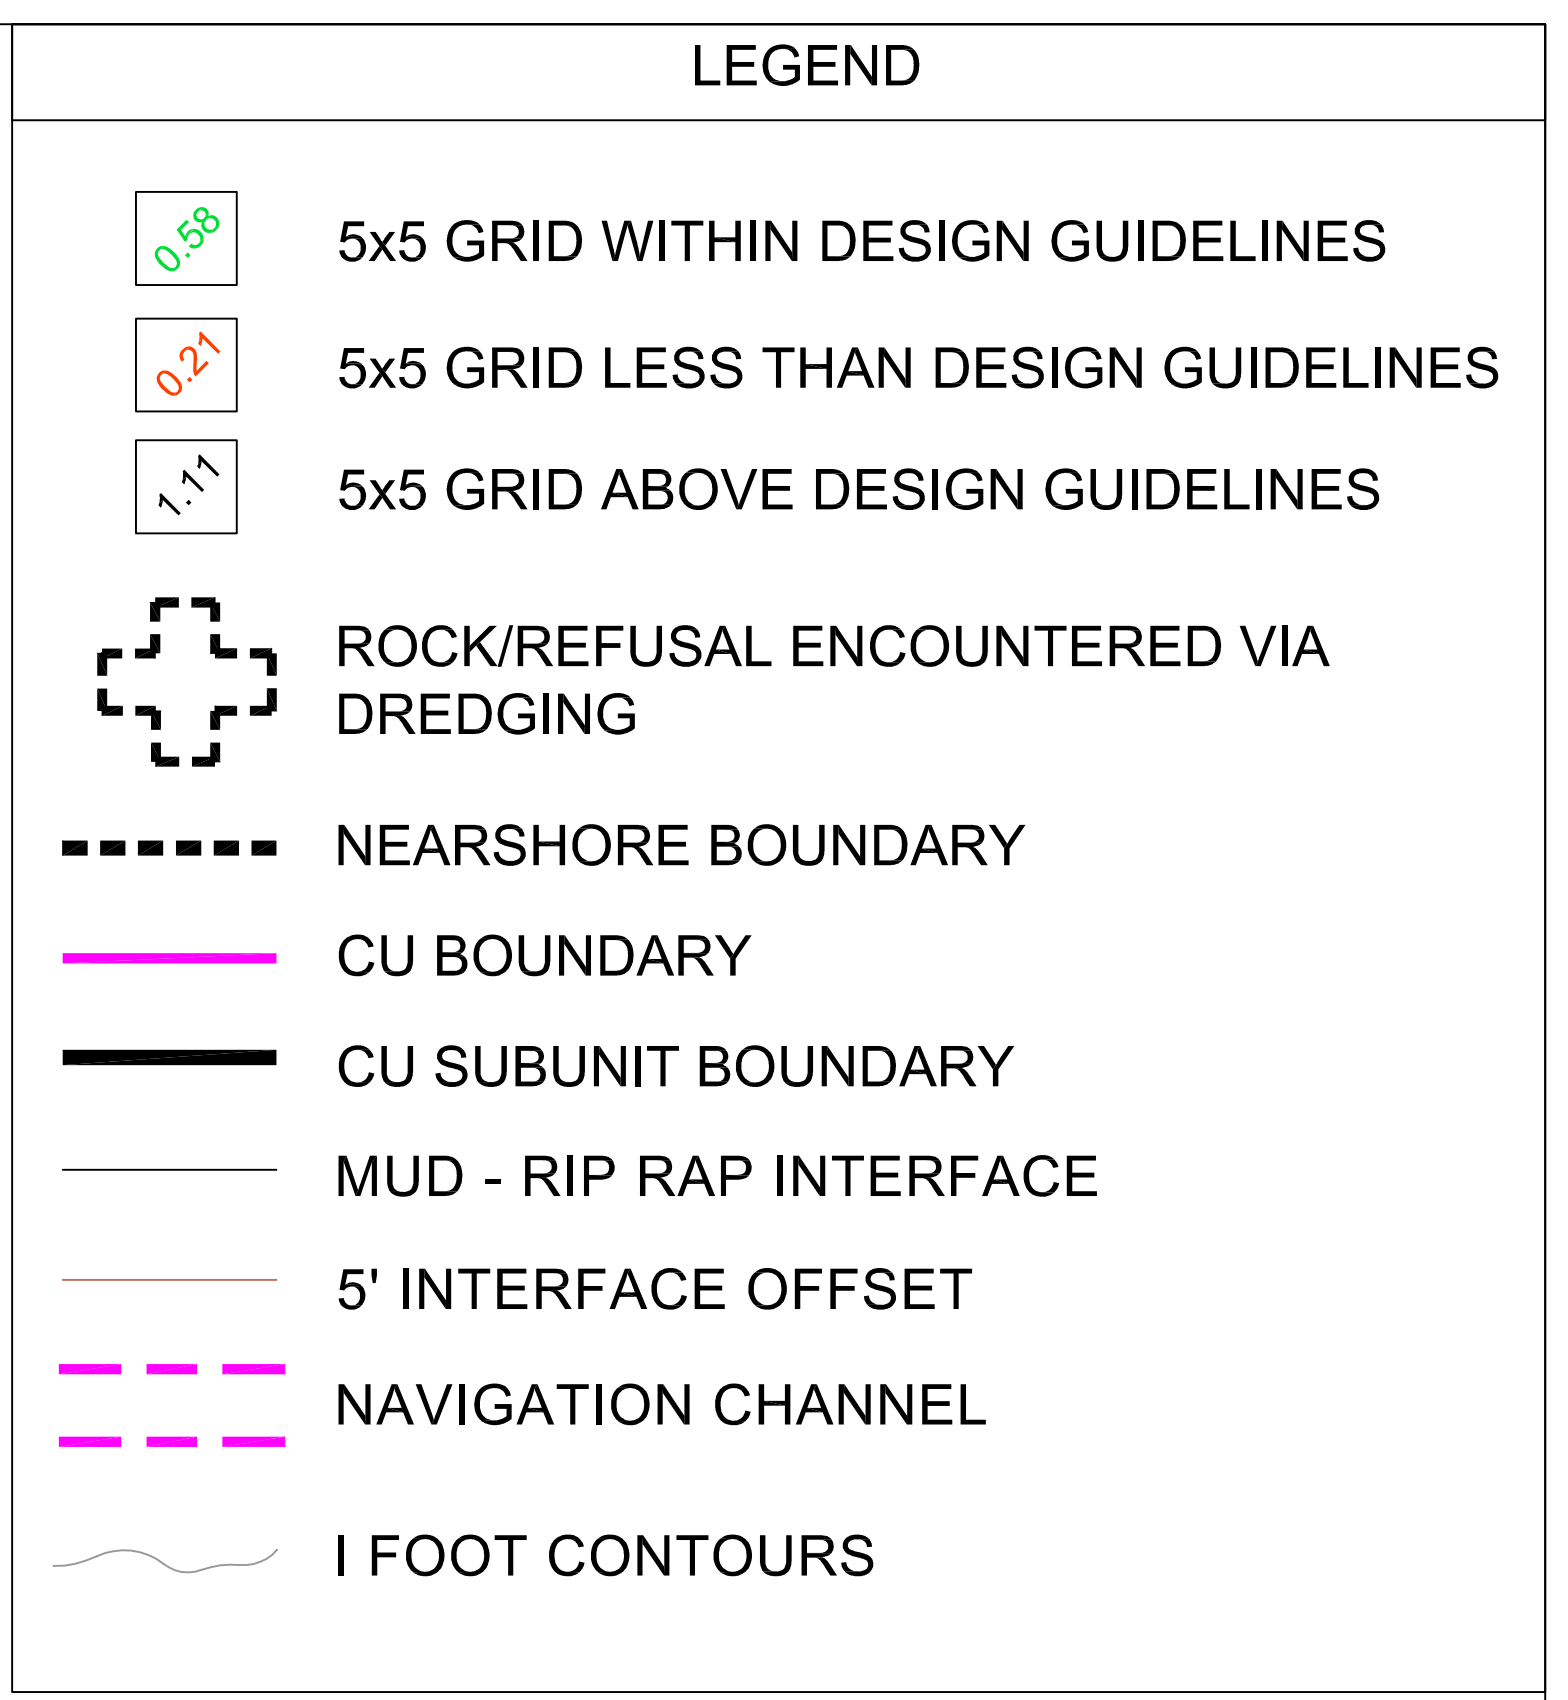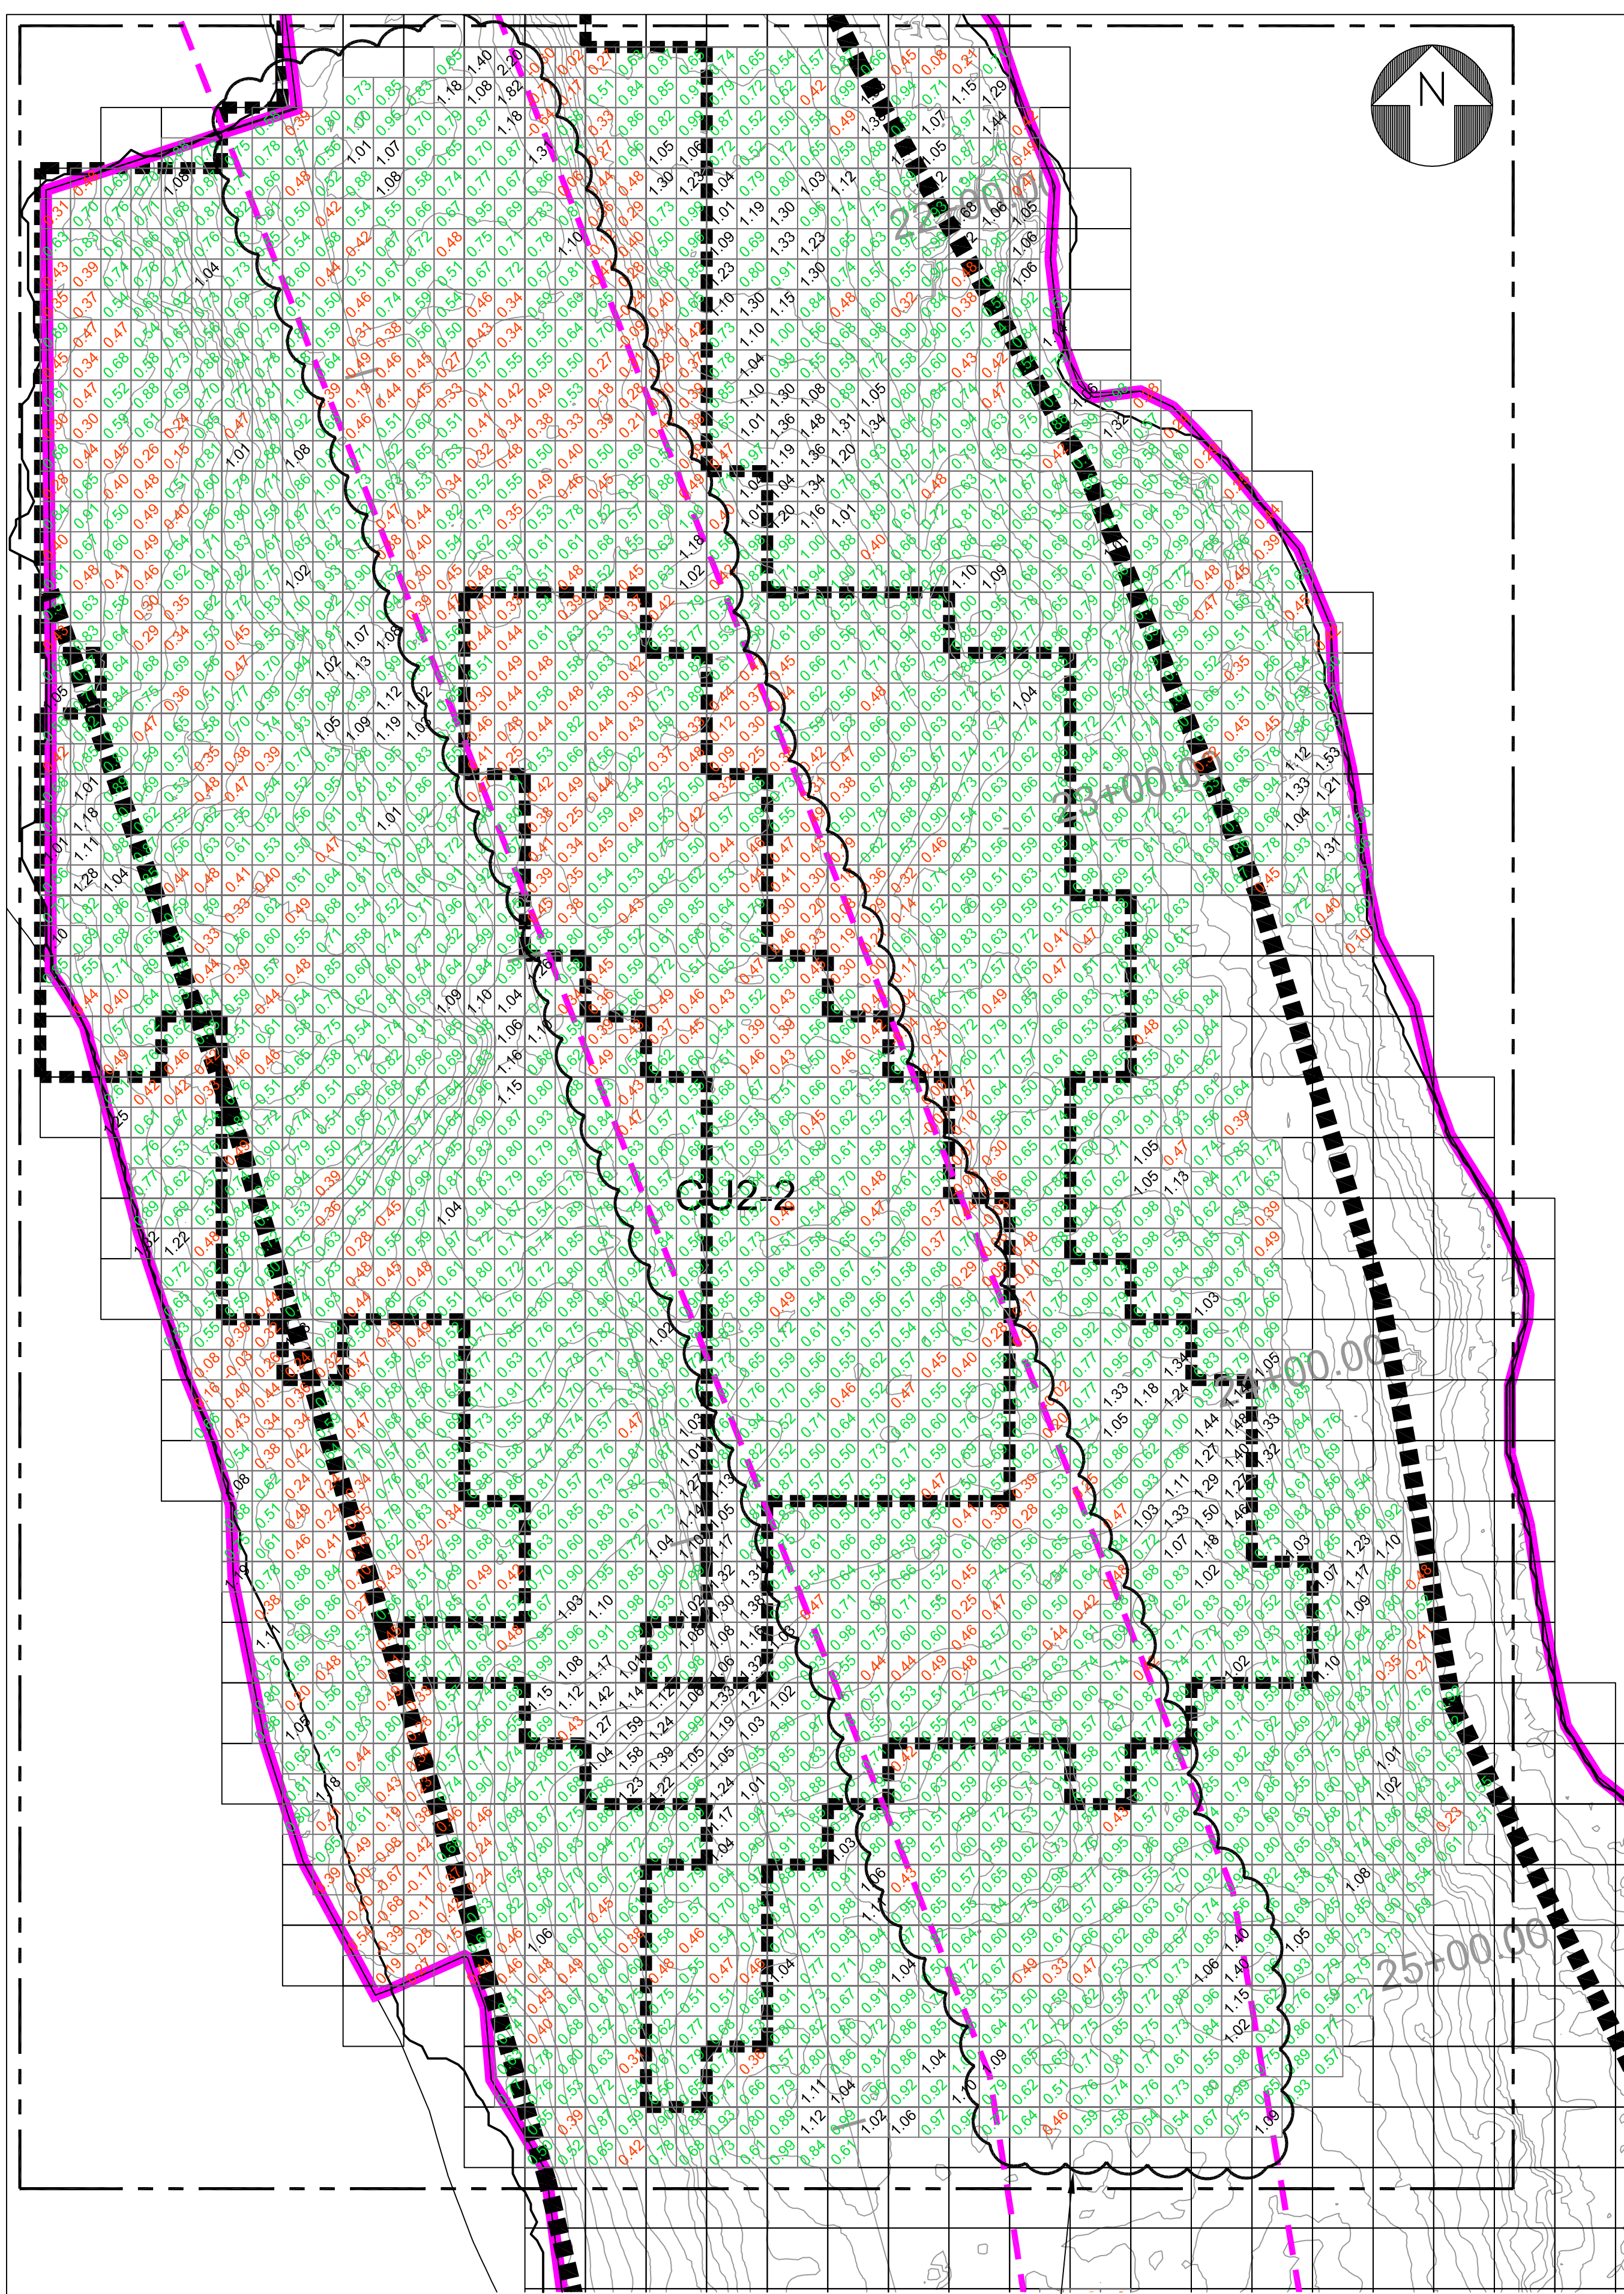

CU2 TYPE "B" CAP ARMOR STONE PLACEMENT NORTH

CU2 TYPE "B" CAP ARMOR STONE PLACEMENT - SOUTH (DWG 2 OF 2)

NOTES:

1. OSI MULTIBEAM SURVEY ON NOVEMBER 1, AND NOVEMBER 11, 2009.
2. CAP THICKNESS IS LISTED IN 5'x5' GRIDS AND IS RELATIVE TO THE ISOLATION LAYER SURVEY FROM OCTOBER 21, 2009.
3. ADDITIONAL ARMOR STONE PLACED ON NOVEMBER 10, 2009 AND SURVEYED ON NOVEMBER 11, 2009
4. ARMOR STONE PLACEMENT IN STEEP AREAS WAS REVIEWED WITH EPA ON NOVEMBER 12, 2009 AND



DEEMED ACCEPTABLE. 80' 160'

CU2 TYPE "B" CAP LOCATION

CU2
TYPE "B" CAP ARMOR LAYER
ACCEPTANCE SURVEY
(NORTH)

DWG 1 OF 2

PARSONS		DRAWING TITLE	
GE COMPANY - PARSONS PROJECT OFFICE BUILDING 40-1, 381 BROADWAY FORT EDWARD, N.Y. 12828 (518) 746-5311		CU2 TYPE "B" CAP ARMOR LAYER ACCEPTANCE SURVEY (NORTH)	
DRAWN BY JHC	CHECKED BY MG	DRAWING NO. CU2-5-1	SCALE AS SHOWN
DATE 11/18/09	APPROVED BY MG	JOB 442209.01401	

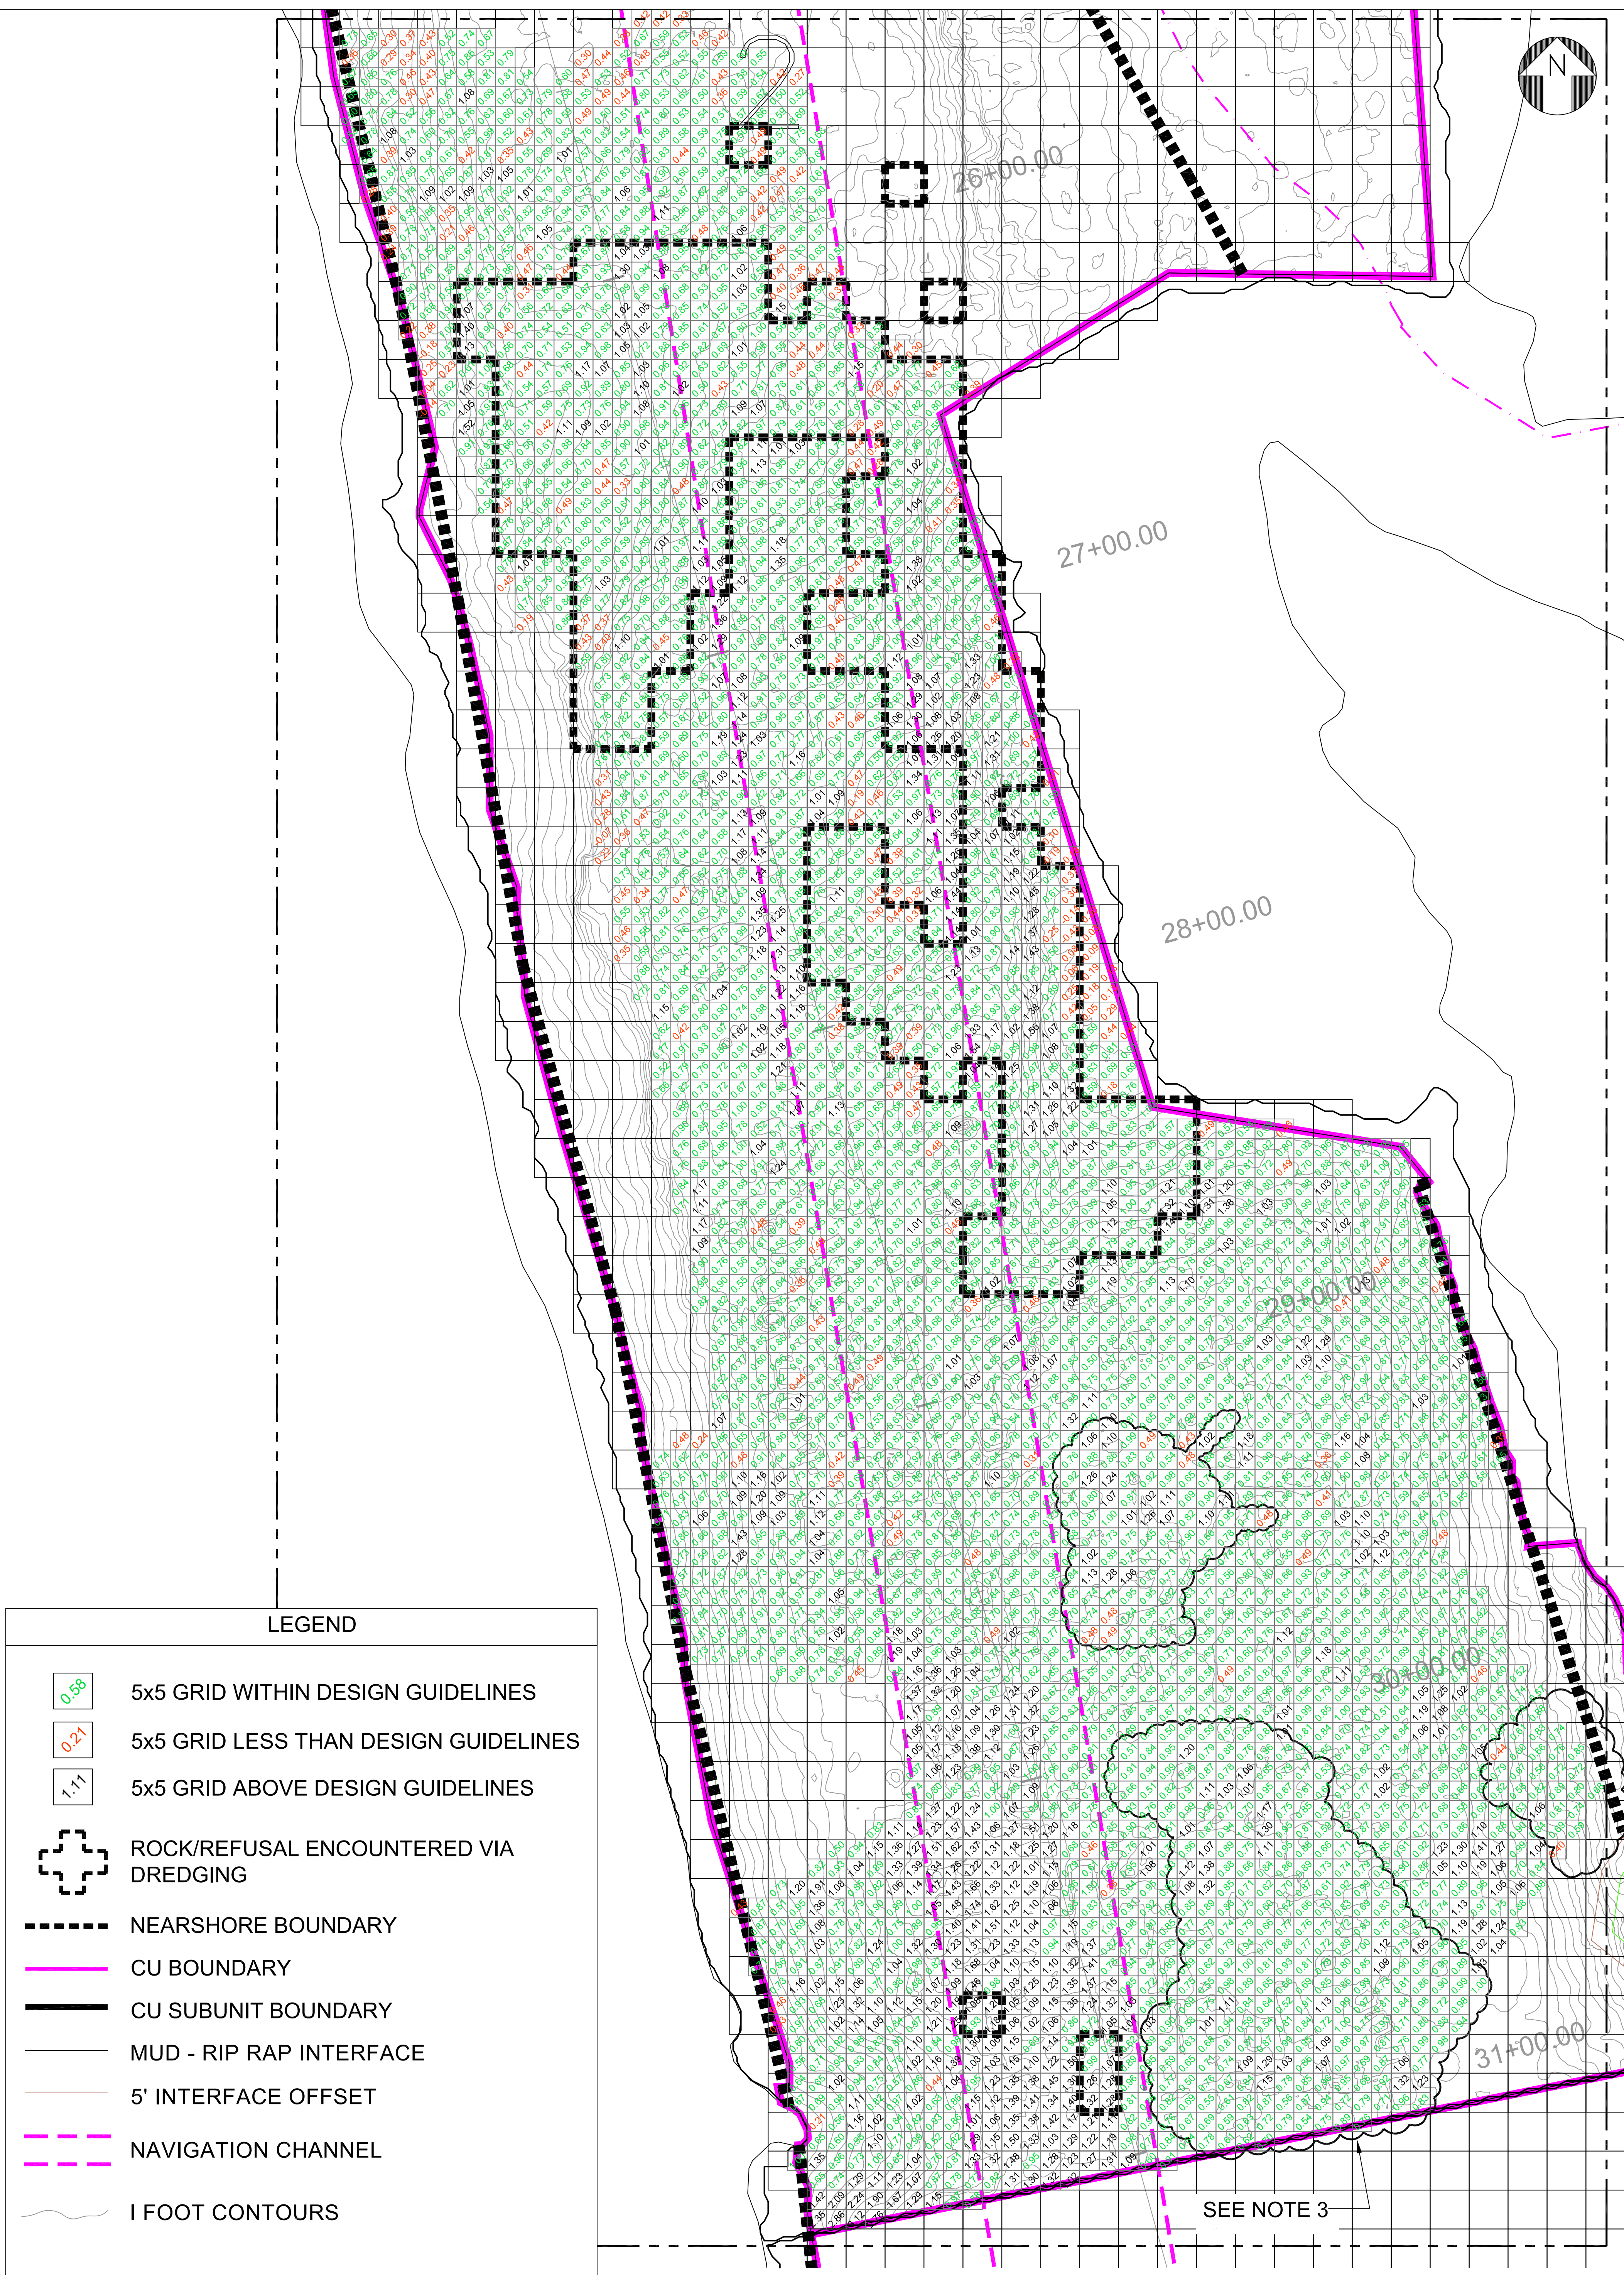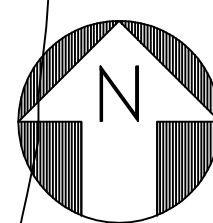

LEGEND

- 5x5 GRID WITHIN DESIGN GUIDELINES
- 5x5 GRID LESS THAN DESIGN GUIDELINES
- 5x5 GRID ABOVE DESIGN GUIDELINES
- ROCK/REFUSAL ENCOUNTERED VIA DREDGING
- NEARSHORE BOUNDARY
- CU BOUNDARY
- CU SUBUNIT BOUNDARY
- MUD - RIP RAP INTERFACE
- 5' INTERFACE OFFSET
- NAVIGATION CHANNEL
- 1 FOOT CONTOURS

NOTES:


1. CAP THICKNESS IN CU2 SOUTH IS LISTED IN 5'x5' GRIDS AND IS RELATIVE TO THE ISOLATION LAYER SURVEY FROM OCTOBER 21, NOVEMBER 1, AND NOVEMBER 6, 2009.
2. ARMOR STONE PLACEMENT IN STEEP AREAS WAS REVIEWED WITH EPA ON NOVEMBER 12, 2009 AND DEEMED ACCEPTABLE.
3. ADDITIONAL ARMOR STONE PLACED ON NOVEMBER 5, 2009 AND SURVEYED ON NOVEMBER 6, 2009.

**CU2 TYPE "B" CAP ARMOR STONE
PLACEMENT
SOUTH**

**CU2
TYPE "B" CAP ARMOR LAYER
ACCEPTANCE SURVEY
(SOUTH)**

DWG 2 OF 2

PARSONS <small>CONSULTING ENGINEERS</small>		DRAWING TITLE	
<small>GE COMPANY - PARSONS PROJECT OFFICE BUILDING 40-1, 381 BROADWAY FORT EDWARD, N.Y. 12828 (518) 746-5311</small>		CU2 TYPE "B" CAP ARMOR LAYER ACCEPTANCE SURVEY (SOUTH)	
<small>DRAWN BY</small> JHC	<small>CHECKED BY</small> MG	<small>DRAWING NO.</small> CU2-5-2	<small>VERSION SCALE</small> A AS SHOWN
<small>DATE</small> 11/18/09	<small>APPROVED BY</small> MG	<small>JOB</small> 442209.01401	

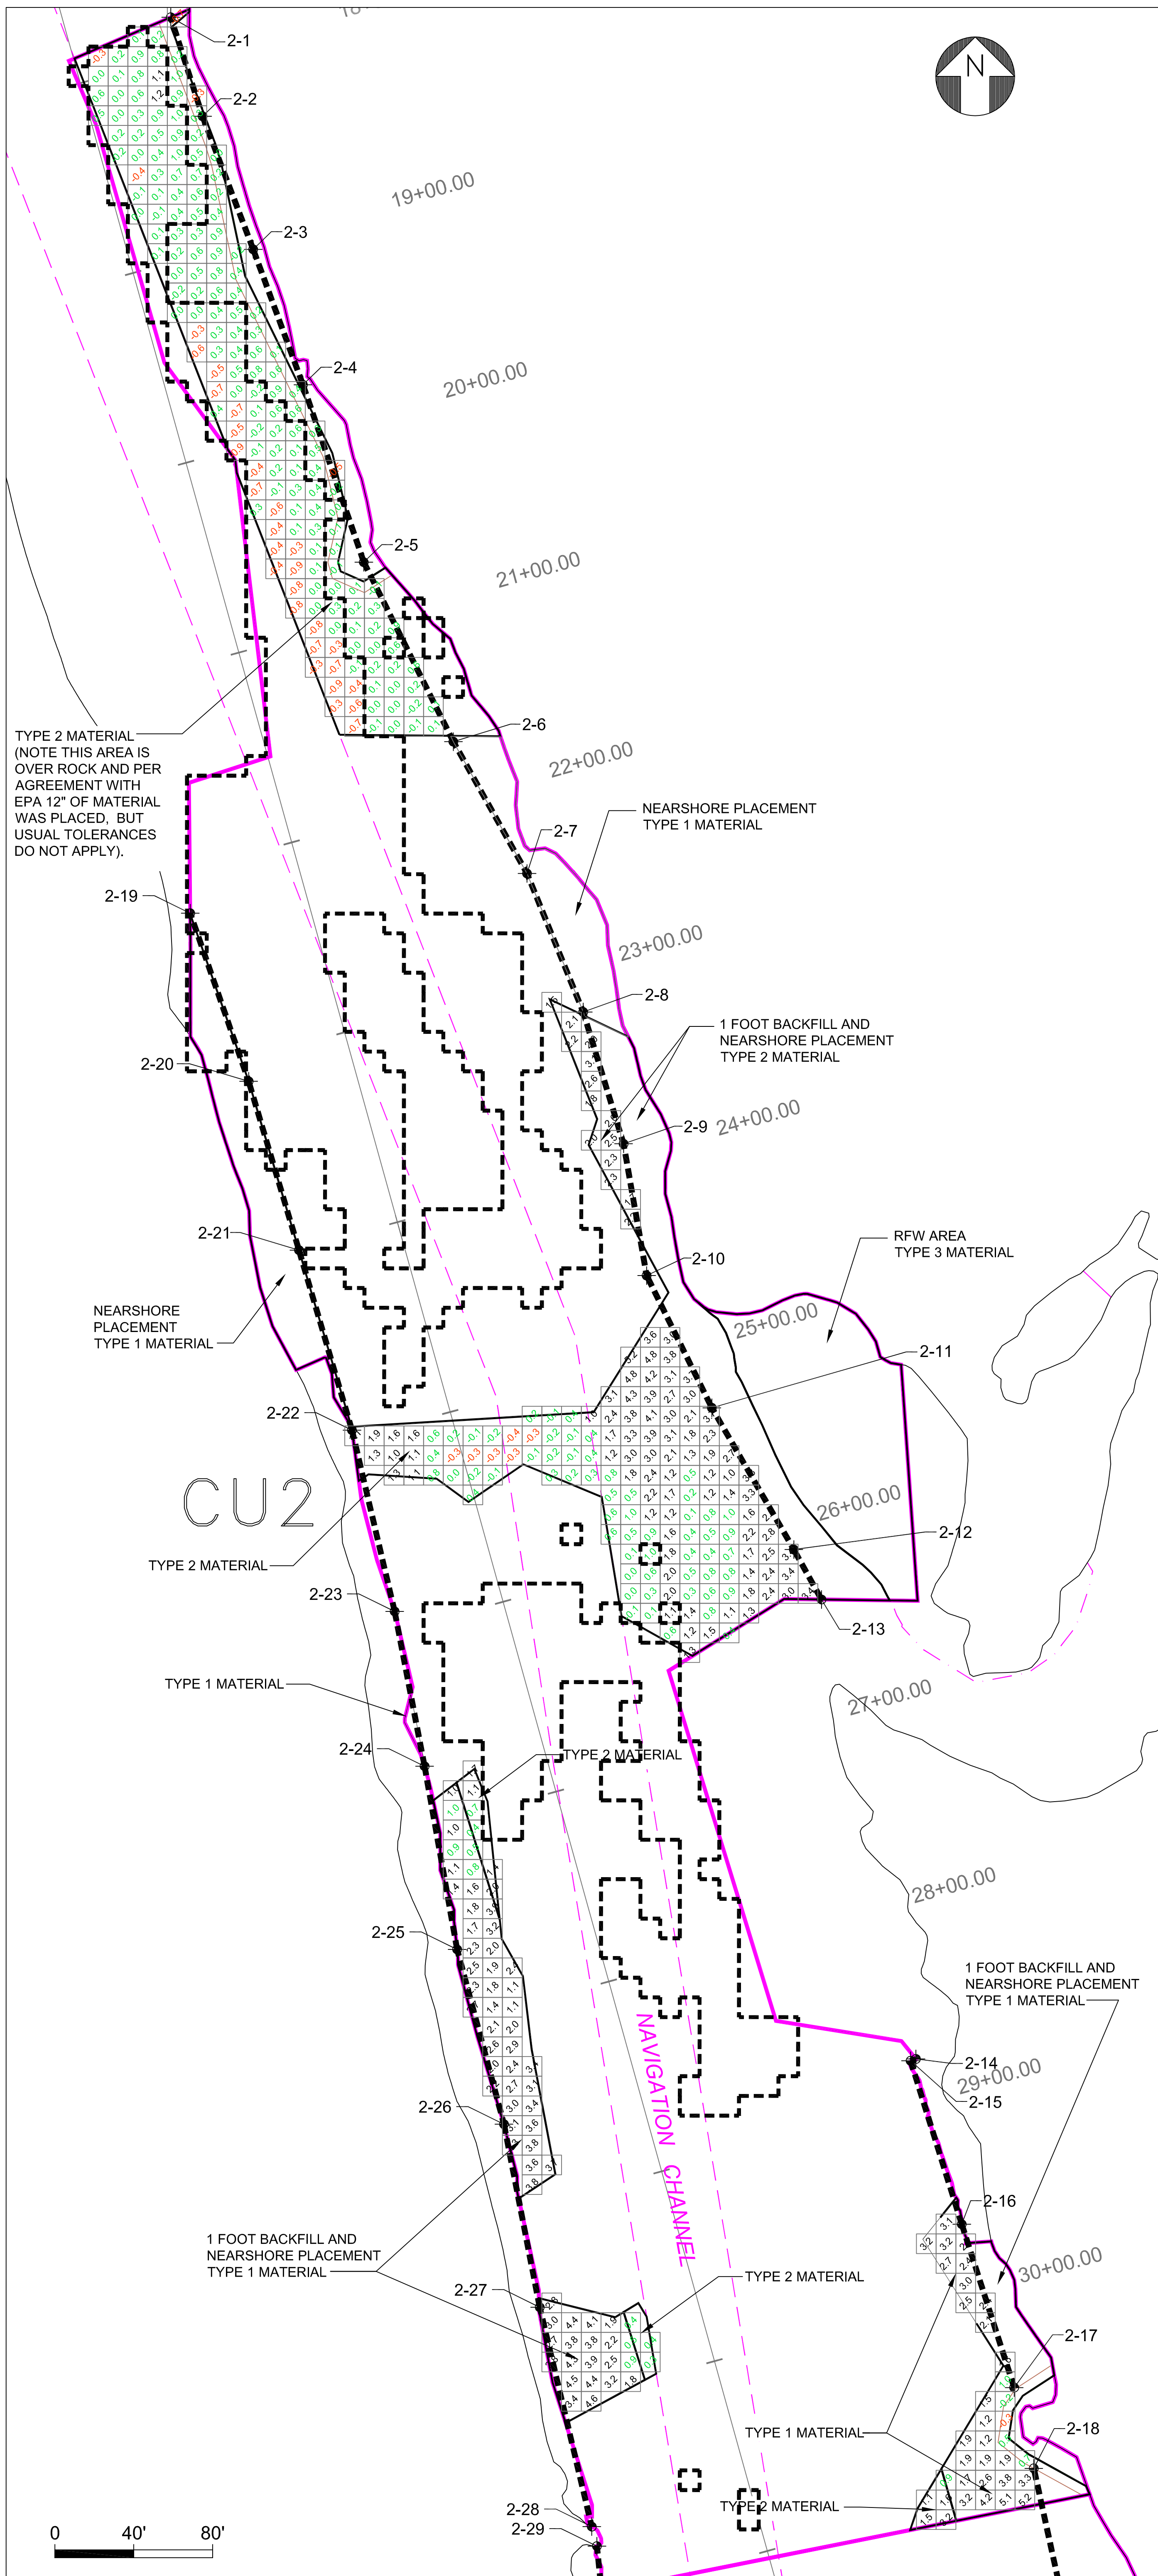

CU-2 Near-Shore Topographic Soundings Collected 2009-11-12 and 2009-11-16

Published Near-Shore Border Set Points			Near-Shore Topographic Measurements					
Name	Easting	Northing	Target Elevation	Easting	Northing	Check Elevation	Horz. Dist.	Vert. Diff.
2-1	735841.76	1615734.89	117.50	735,841.81	1,615,734.91	117.89	0.05	0.39
2-2	735857.89	1615684.63	117.50	735,857.96	1,615,684.72	118.67	0.12	1.17
				735,854.93	1,615,684.60	117.80	2.97	0.30
2-3	735883.57	1615617.11	117.50	735,883.37	1,615,617.11	117.90	0.20	0.40
2-4	735908.80	1615548.38	117.50	735,908.60	1,615,548.34	118.82	0.21	1.32
				735,907.95	1,615,547.73	118.19	1.07	0.69
				735,904.76	1,615,547.37	117.23	4.17	-0.28
2-5	735939.67	1615458.34	117.50	735,939.54	1,615,458.45	117.91	0.17	0.41
2-6	735985.11	1615367.25	117.50	735,985.26	1,615,367.53	117.22	0.31	-0.28
2-7	736022.46	1615300.38	117.50	736,022.22	1,615,300.28	117.22	0.26	-0.28
2-8	736050.98	1615230.08	117.50	736,050.92	1,615,230.05	116.50	0.07	-1.00
				736,051.83	1,615,235.19	116.70	5.18	-0.80
				736,055.43	1,615,236.74	117.64	8.01	0.14
2-9	736071.44	1615163.20	117.50	736,071.41	1,615,163.13	116.45	0.08	-1.05
				736,076.99	1,615,166.56	117.12	6.48	-0.38
2-10	736083.15	1615096.33	117.50	736,083.23	1,615,096.37	116.78	0.09	-0.72
				736,085.77	1,615,097.60	117.55	2.92	0.05
2-11	736116.21	1615029.22	117.50	736,116.34	1,615,029.11	117.89	0.17	0.39
2-12	736157.82	1614957.28	117.50	736,157.70	1,614,957.53	118.87	0.28	1.37
				736,153.59	1,614,955.37	118.81	4.64	1.31
				736,151.41	1,614,954.40	118.54	7.02	1.04
				736,147.60	1,614,951.10	117.44	11.94	-0.06
2-13	736171.84	1614931.95	117.50	736,171.89	1,614,931.93	118.65	0.06	1.15
				736,167.88	1,614,932.28	118.45	3.97	0.95
				736,160.59	1,614,928.52	117.77	11.75	0.27
2-14	736219.74	1614698.77	117.50	736,219.71	1,614,698.78	116.76	0.03	-0.74
				736,222.65	1,614,700.01	117.42	3.16	-0.08
2-15	736217.02	1614697.84	117.50	736,217.10	1,614,697.70	116.14	0.16	-1.36
2-16	736243.00	1614614.90	117.50	736,243.06	1,614,615.16	115.39	0.27	-2.11
				736,246.34	1,614,615.16	117.34	3.35	-0.16
2-17	736269.59	1614532.00	117.50	736,269.88	1,614,531.94	117.25	0.30	-0.25
2-18	736279.53	1614491.00	117.50	736,279.56	1,614,491.00	116.43	0.03	-1.07
				736,282.48	1,614,492.13	117.67	3.16	0.17
2-19	735851.62	1615280.20	117.50	735,851.54	1,615,280.36	117.55	0.17	0.05
2-20	735881.26	1615194.92	117.50	735,881.40	1,615,195.12	116.56	0.25	-0.94
				735,879.06	1,615,194.84	117.66	2.21	0.16
2-21	735906.78	1615109.24	117.50	735,906.68	1,615,109.48	116.69	0.26	-0.81
				735,903.59	1,615,108.47	117.63	3.28	0.13
2-22	735933.67	1615017.86	117.50	735,933.56	1,615,017.85	117.14	0.12	-0.36
2-23	735955.32	1614925.87	117.50	735,955.34	1,614,926.13	117.66	0.26	0.16
2-24	735970.50	1614847.32	117.50	735,970.67	1,614,847.28	116.73	0.17	-0.77
				735,967.97	1,614,846.38	117.22	2.70	-0.28
2-25	735987.03	1614754.34	117.50	735,986.81	1,614,754.02	117.29	0.39	-0.21
2-26	736010.78	1614665.66	117.50	736,010.97	1,614,665.51	116.73	0.25	-0.77
				736,007.38	1,614,664.75	117.55	3.51	0.05
2-27	736028.90	1614572.77	117.50	736,029.07	1,614,572.73	116.62	0.17	-0.88
				736,027.27	1,614,572.07	117.54	1.78	0.04
2-28	736055.32	1614461.44	117.50	736,055.29	1,614,461.74	117.78	0.30	0.28
2-29	736057.92	1614451.52	117.50	736,058.13	1,614,451.34	117.53	0.28	0.03

Notes:
Additional Topographic measurements provided as part of CU2 Form 2 Acceptance Package.

Subunit	Average Thickness (ft)	Approx. Area (acre)	Intended Vol. Placed (CY)	Actual Vol. Placed (CY)	Variation from Planned (CY)
CU2-1	1.11	0.40	648.1	719.4	71.3
CU2-2 through 5	1.32	0.62	996.3	1311.0	314.7
			Total =	386.0	

Notes:
Average thickness and volumes were computed using 10x10 cell center average data sets.





LEGEND

- 10x10 GRID WITHIN DESIGN GUIDELINES
- 10x10 GRID LESS THAN DESIGN GUIDELINES
- 10x10 GRID ABOVE DESIGN GUIDELINES
- BUCKET REFUSAL AREA ENCOUNTERED DURING DREDGING
- CU BOUNDARY
- CU SUBUNIT BOUNDARY
- NEARSHORE BORDER SET POINT (DATA CONTAINED IN NEARSHORE SUMMARY TABLE)
- NEARSHORE BORDER (117.5 FEET)

- NOTES:**
- OSI MULTIBEAM SURVEYS BY NOVEMBER 15, 2009.
 - NUMERIC VALUES IN 10'x10' GRID REPRESENT DIFFERENCE TO TARGET THICKNESS (POSITIVE THICKNESS NUMBERS REFLECT THICKNESS ABOVE TARGET THICKNESS). COLORS DETERMINED USING DIFFERENT BACKFILL TOLERANCES DESCRIBED IN SPEC SECTION 13720.

CU2 BACKFILL PLACEMENT ACCEPTANCE SURVEY

PARSONS GE COMPANY - PARSONS PROJECT OFFICE BUILDING 40-1, 381 BROADWAY FORT EDWARD, N.Y. 12828 (518) 746-5311		DRAWING TITLE CU2 BACKFILL PLACEMENT ACCEPTANCE SURVEY	
DRAWN BY JHC	CHECKED BY MG	DRAWING NO. CU2-1	SCALE AS SHOWN
DATE 11/18/09	APPROVED BY MG	JOB 442209.01401	

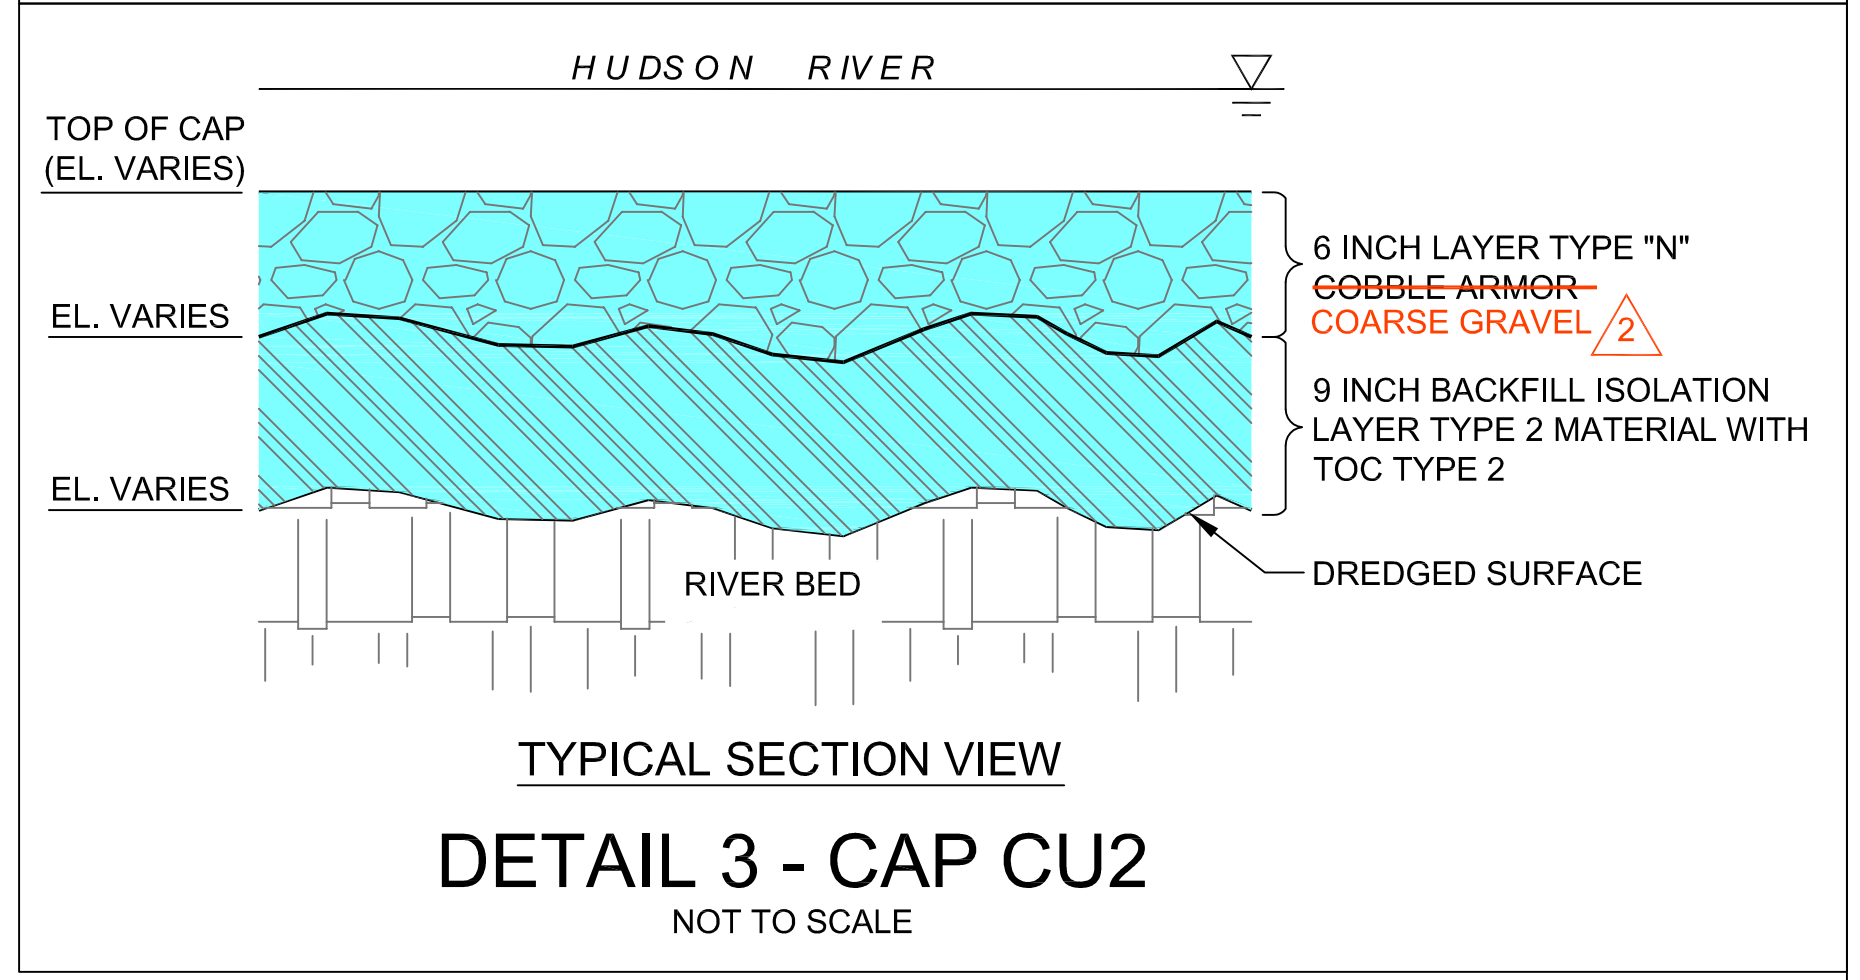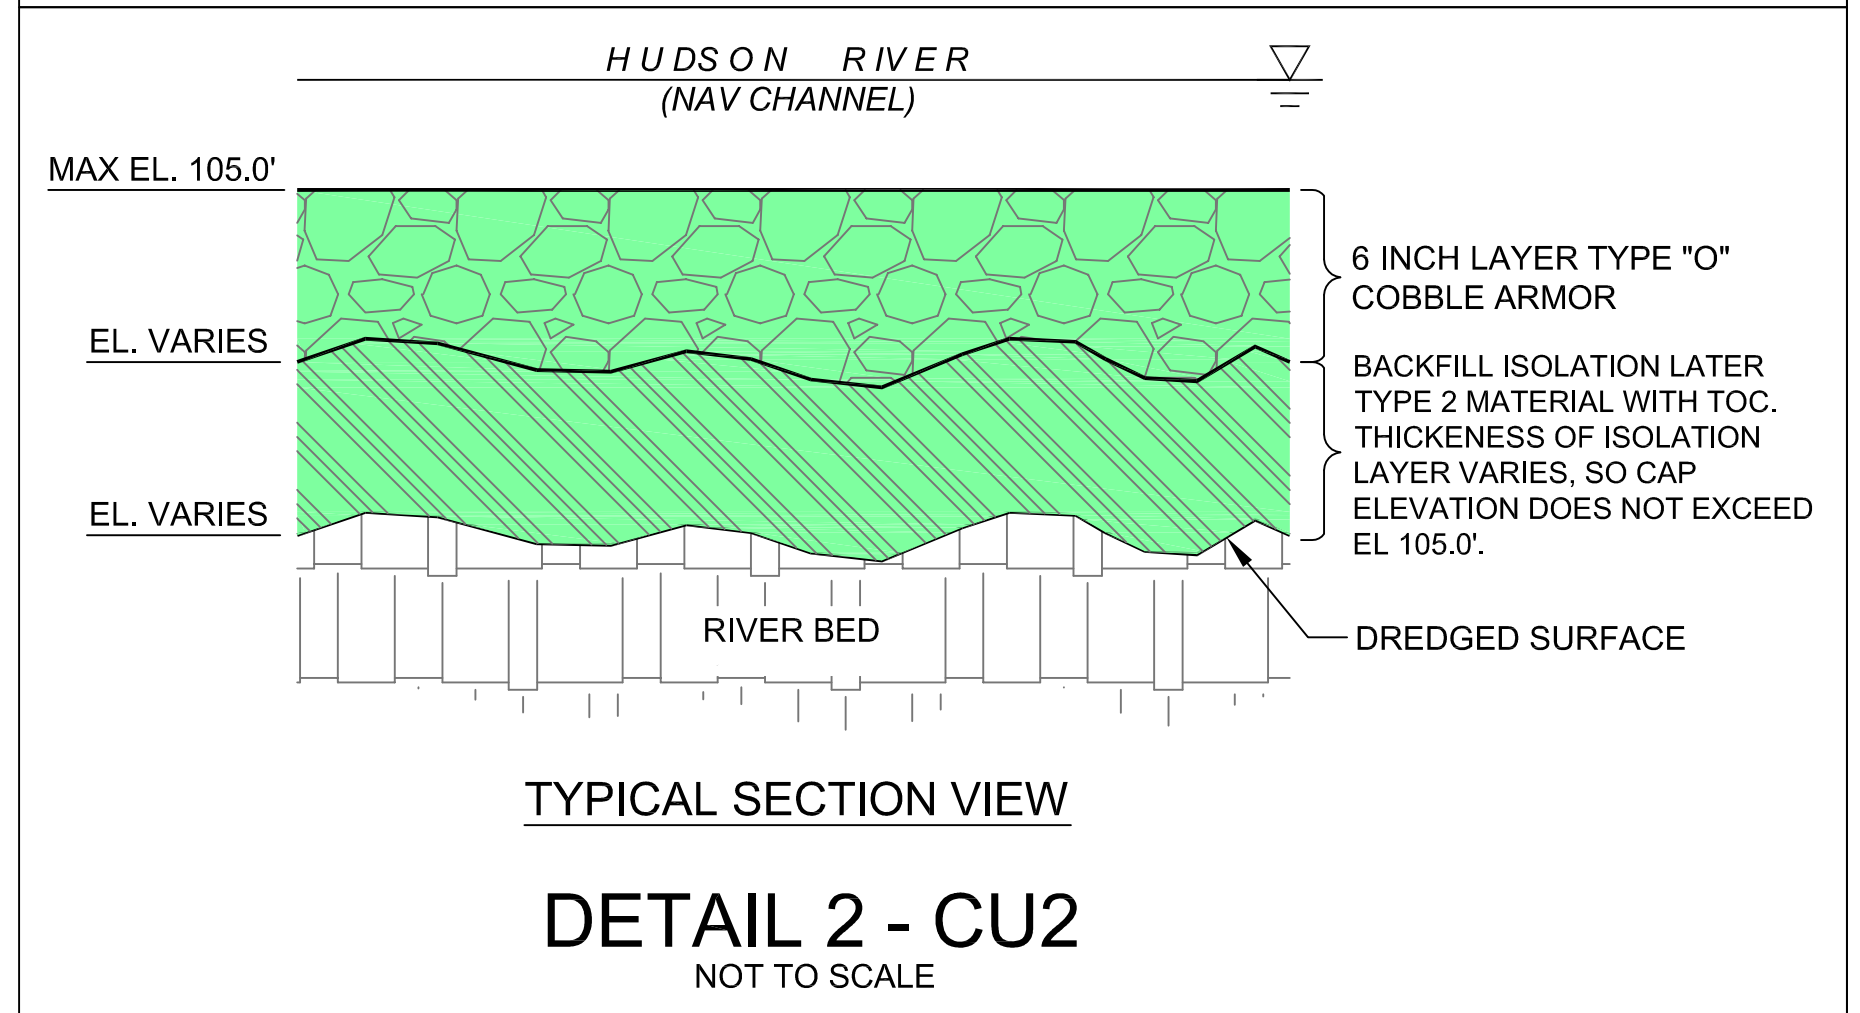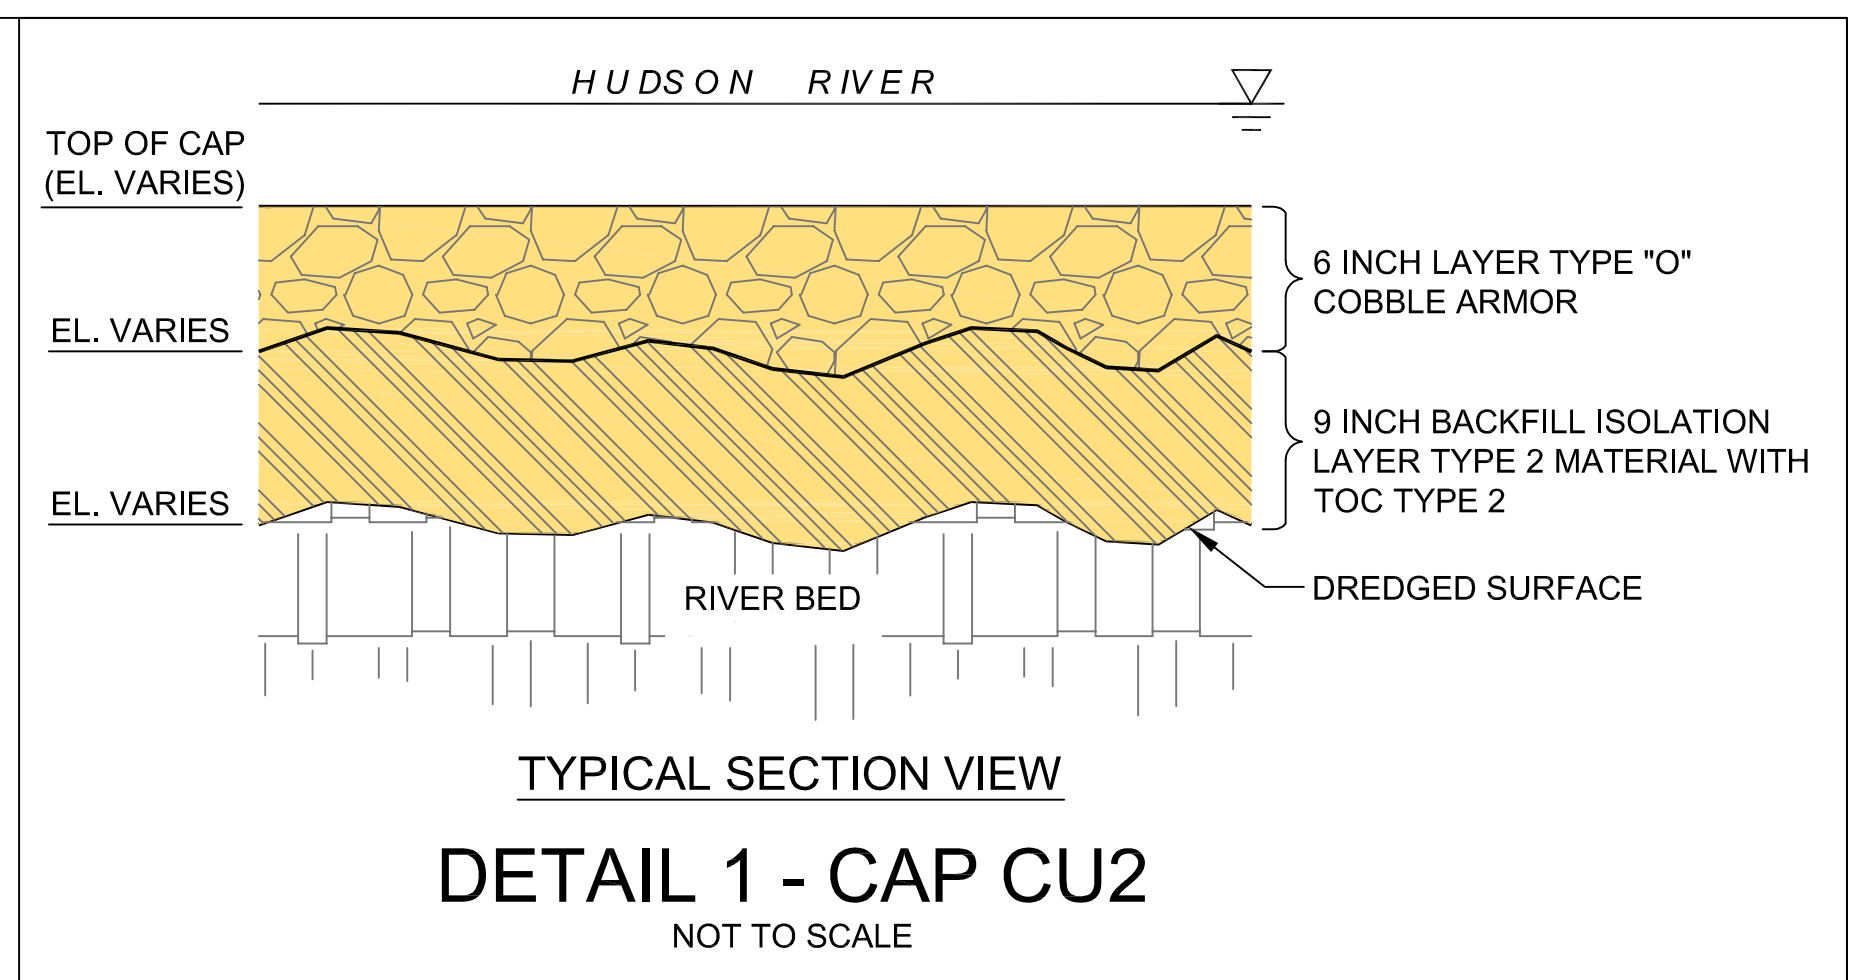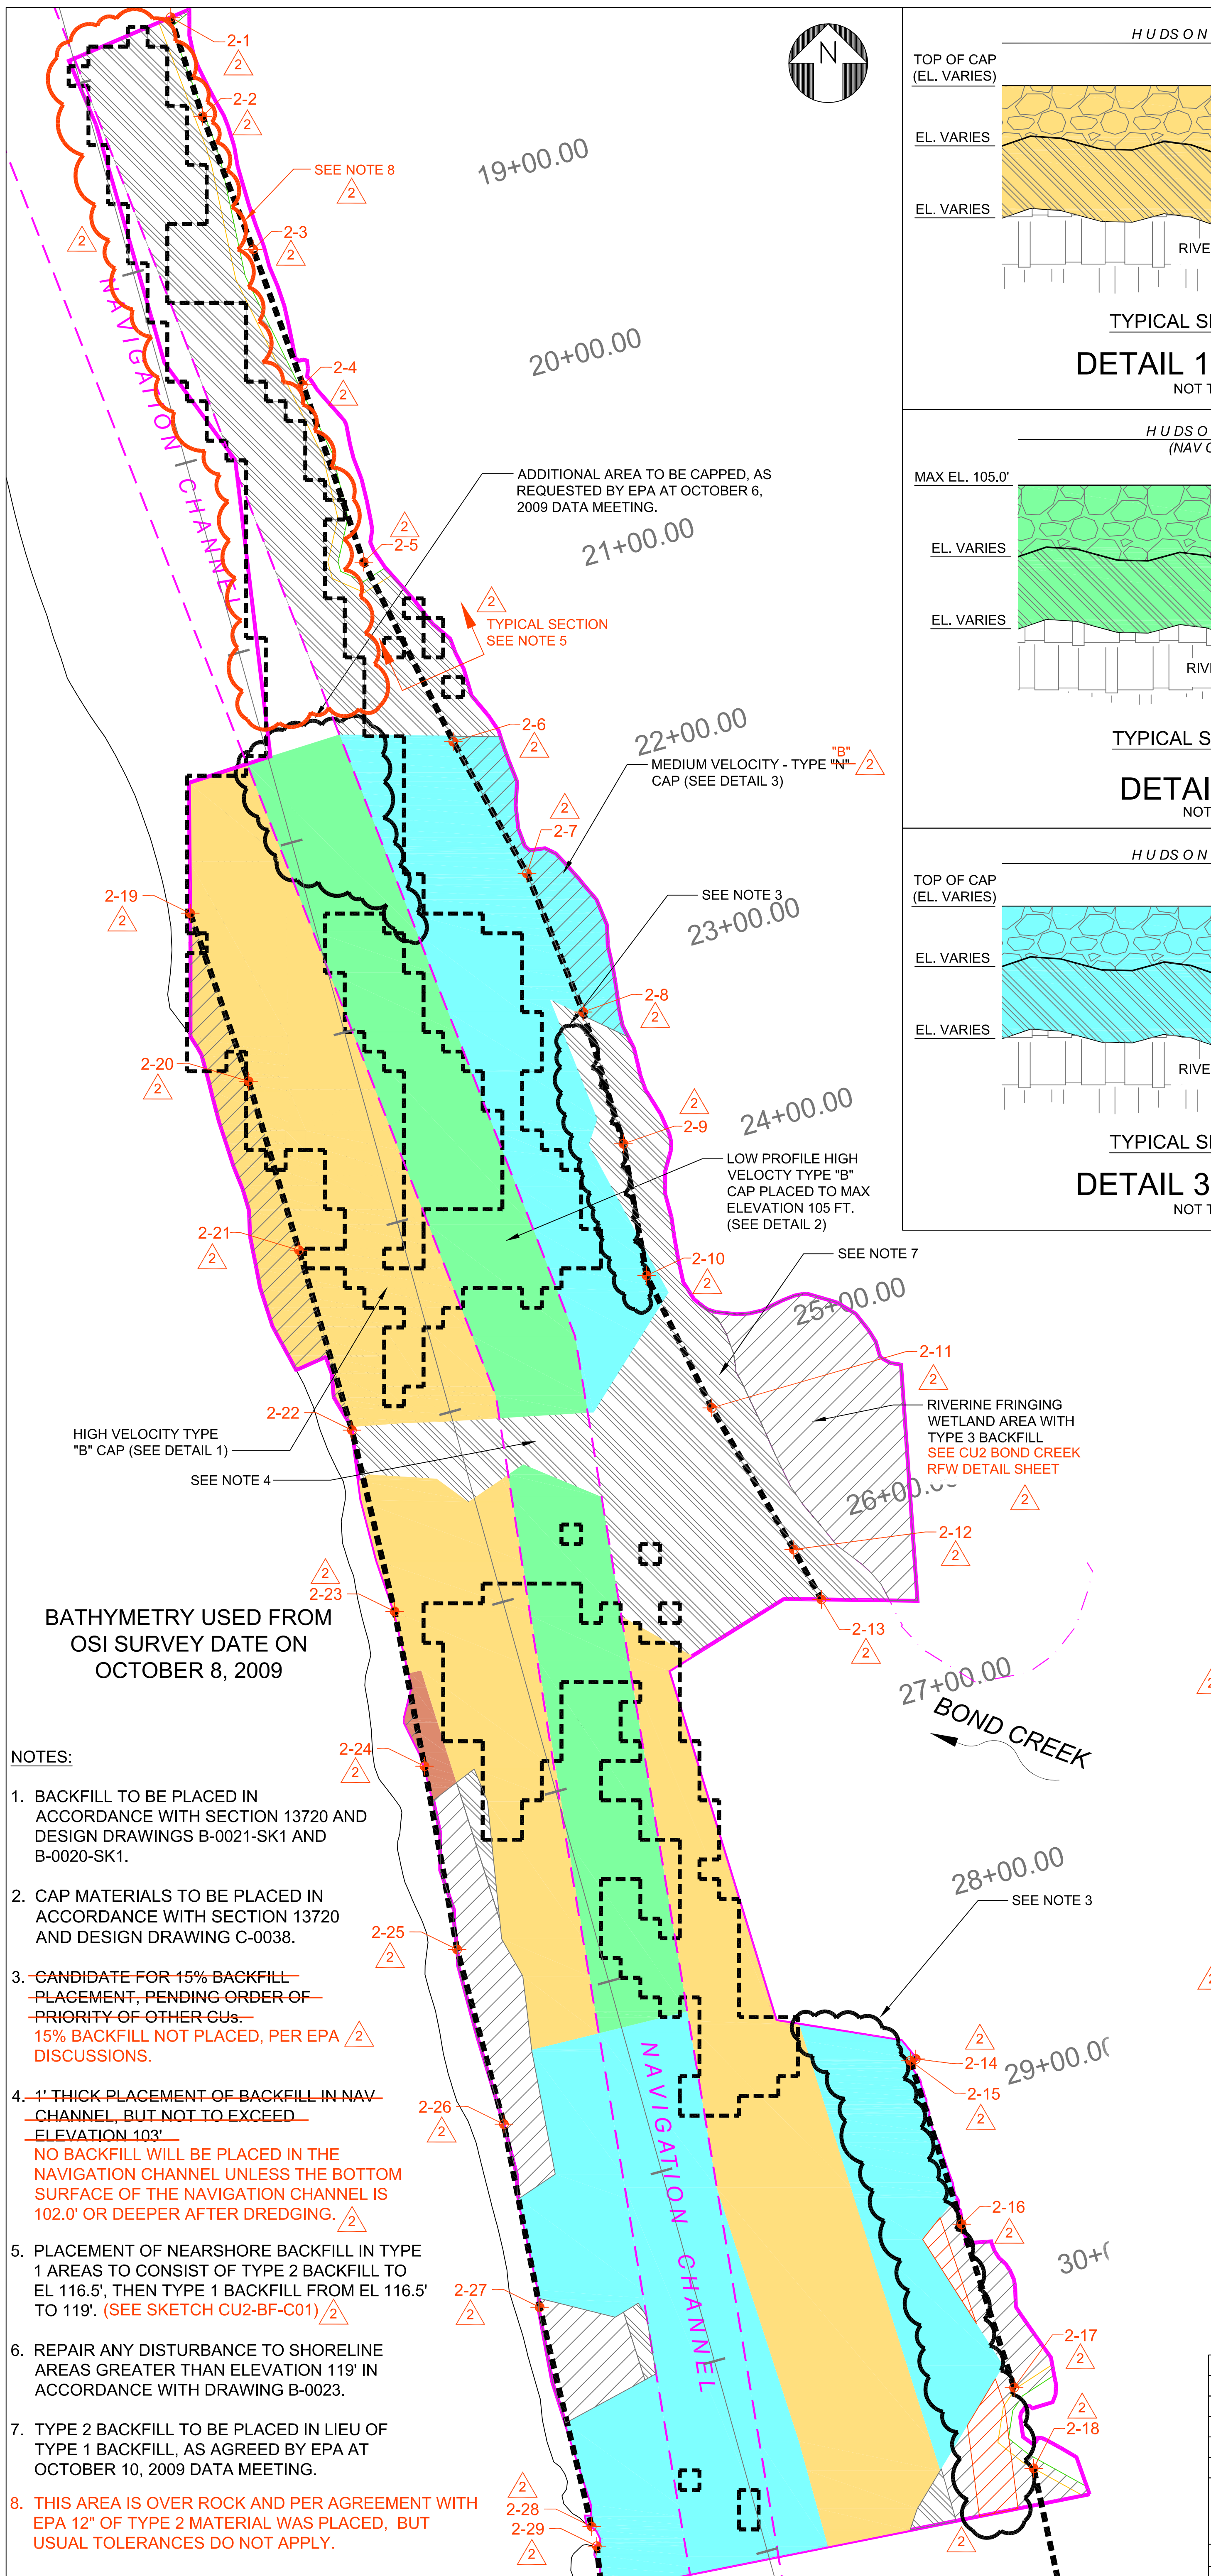

LEGEND

- BUCKET REFUSAL AREA ENCOUNTERED DURING DREDGING
- CU BOUNDARY
- CU SUBUNIT BOUNDARY
- MUD - RIP RAP INTERFACE
- 5' INTERFACE OFFSET
- 1 FOOT BACKFILL AND NEARSHORE PLACEMENT TYPE 1 MATERIAL
- 1 FOOT BACKFILL AND NEARSHORE PLACEMENT TYPE 2 MATERIAL
- 15% BACKFILL PLACEMENT TO AN ELEV. OF 114.0 FEET TYPE 1 MATERIAL
- TYPE B - LOW VELOCITY CAP (12 INCH LAYER OF TYPE 2 BACKFILL) WITH TOC
- TYPE B HIGH VELOCITY - LOW PROFILE CAP PLACED TO MAX ELEVATION 105 FT.
- TYPE B - HIGH VELOCITY CAP.
- TYPE B - MEDIUM VELOCITY CAP.
- 2-12 NEARSHORE BORDER SET POINT
- POTENTIAL LOCATION FOR RIVERINE FRINGING WETLAND CONSTRUCTION (PLANTING BY OTHERS)
- NEARSHORE BORDER (117.5 FEET)

RECORD DRAWING


0 40' 80'

- NOTES:**
1. BACKFILL TO BE PLACED IN ACCORDANCE WITH SECTION 13720 AND DESIGN DRAWINGS B-0021-SK1 AND B-0020-SK1.
 2. CAP MATERIALS TO BE PLACED IN ACCORDANCE WITH SECTION 13720 AND DESIGN DRAWING C-0038.
 3. ~~CANDIDATE FOR 15% BACKFILL PLACEMENT, PENDING ORDER OF PRIORITY OF OTHER CUs.~~ 15% BACKFILL NOT PLACED, PER EPA DISCUSSIONS.
 4. 1' THICK PLACEMENT OF BACKFILL IN NAVIGATION CHANNEL, BUT NOT TO EXCEED ELEVATION 103'. NO BACKFILL WILL BE PLACED IN THE NAVIGATION CHANNEL UNLESS THE BOTTOM SURFACE OF THE NAVIGATION CHANNEL IS 102.0' OR DEEPER AFTER DREDGING.
 5. PLACEMENT OF NEARSHORE BACKFILL IN TYPE 1 AREAS TO CONSIST OF TYPE 2 BACKFILL TO EL 116.5', THEN TYPE 1 BACKFILL FROM EL 116.5' TO 119'. (SEE SKETCH CU2-BF-C01)
 6. REPAIR ANY DISTURBANCE TO SHORELINE AREAS GREATER THAN ELEVATION 119' IN ACCORDANCE WITH DRAWING B-0023.
 7. TYPE 2 BACKFILL TO BE PLACED IN LIEU OF TYPE 1 BACKFILL, AS AGREED BY EPA AT OCTOBER 10, 2009 DATA MEETING.
 8. THIS AREA IS OVER ROCK AND PER AGREEMENT WITH EPA 12" OF TYPE 2 MATERIAL WAS PLACED, BUT USUAL TOLERANCES DO NOT APPLY.

REV	DATE	DRN BY	DRAWING DESCRIPTION	PM
2	11/18/09	JHG	RECORD DRAWING	MG
1	10/11/09	JHG	REVISED PER EPA COMMENTS	MG
0	10/10/09	JHG	ISSUED FOR EPA REVIEW	MG

PARSONS
 GE COMPANY - PARSONS PROJECT OFFICE
 BUILDING 40-1, 381 BROADWAY
 FORT EDWARD, N.Y. 12828 (518) 746-5311

DRAWN BY: JHG CHECKED BY: MG DRAWING NO.: CU-2-BC-5 SCALE: AS SHOWN
 DATE: 10/18/09 APPROVED BY: MG JOB: 442209.01401

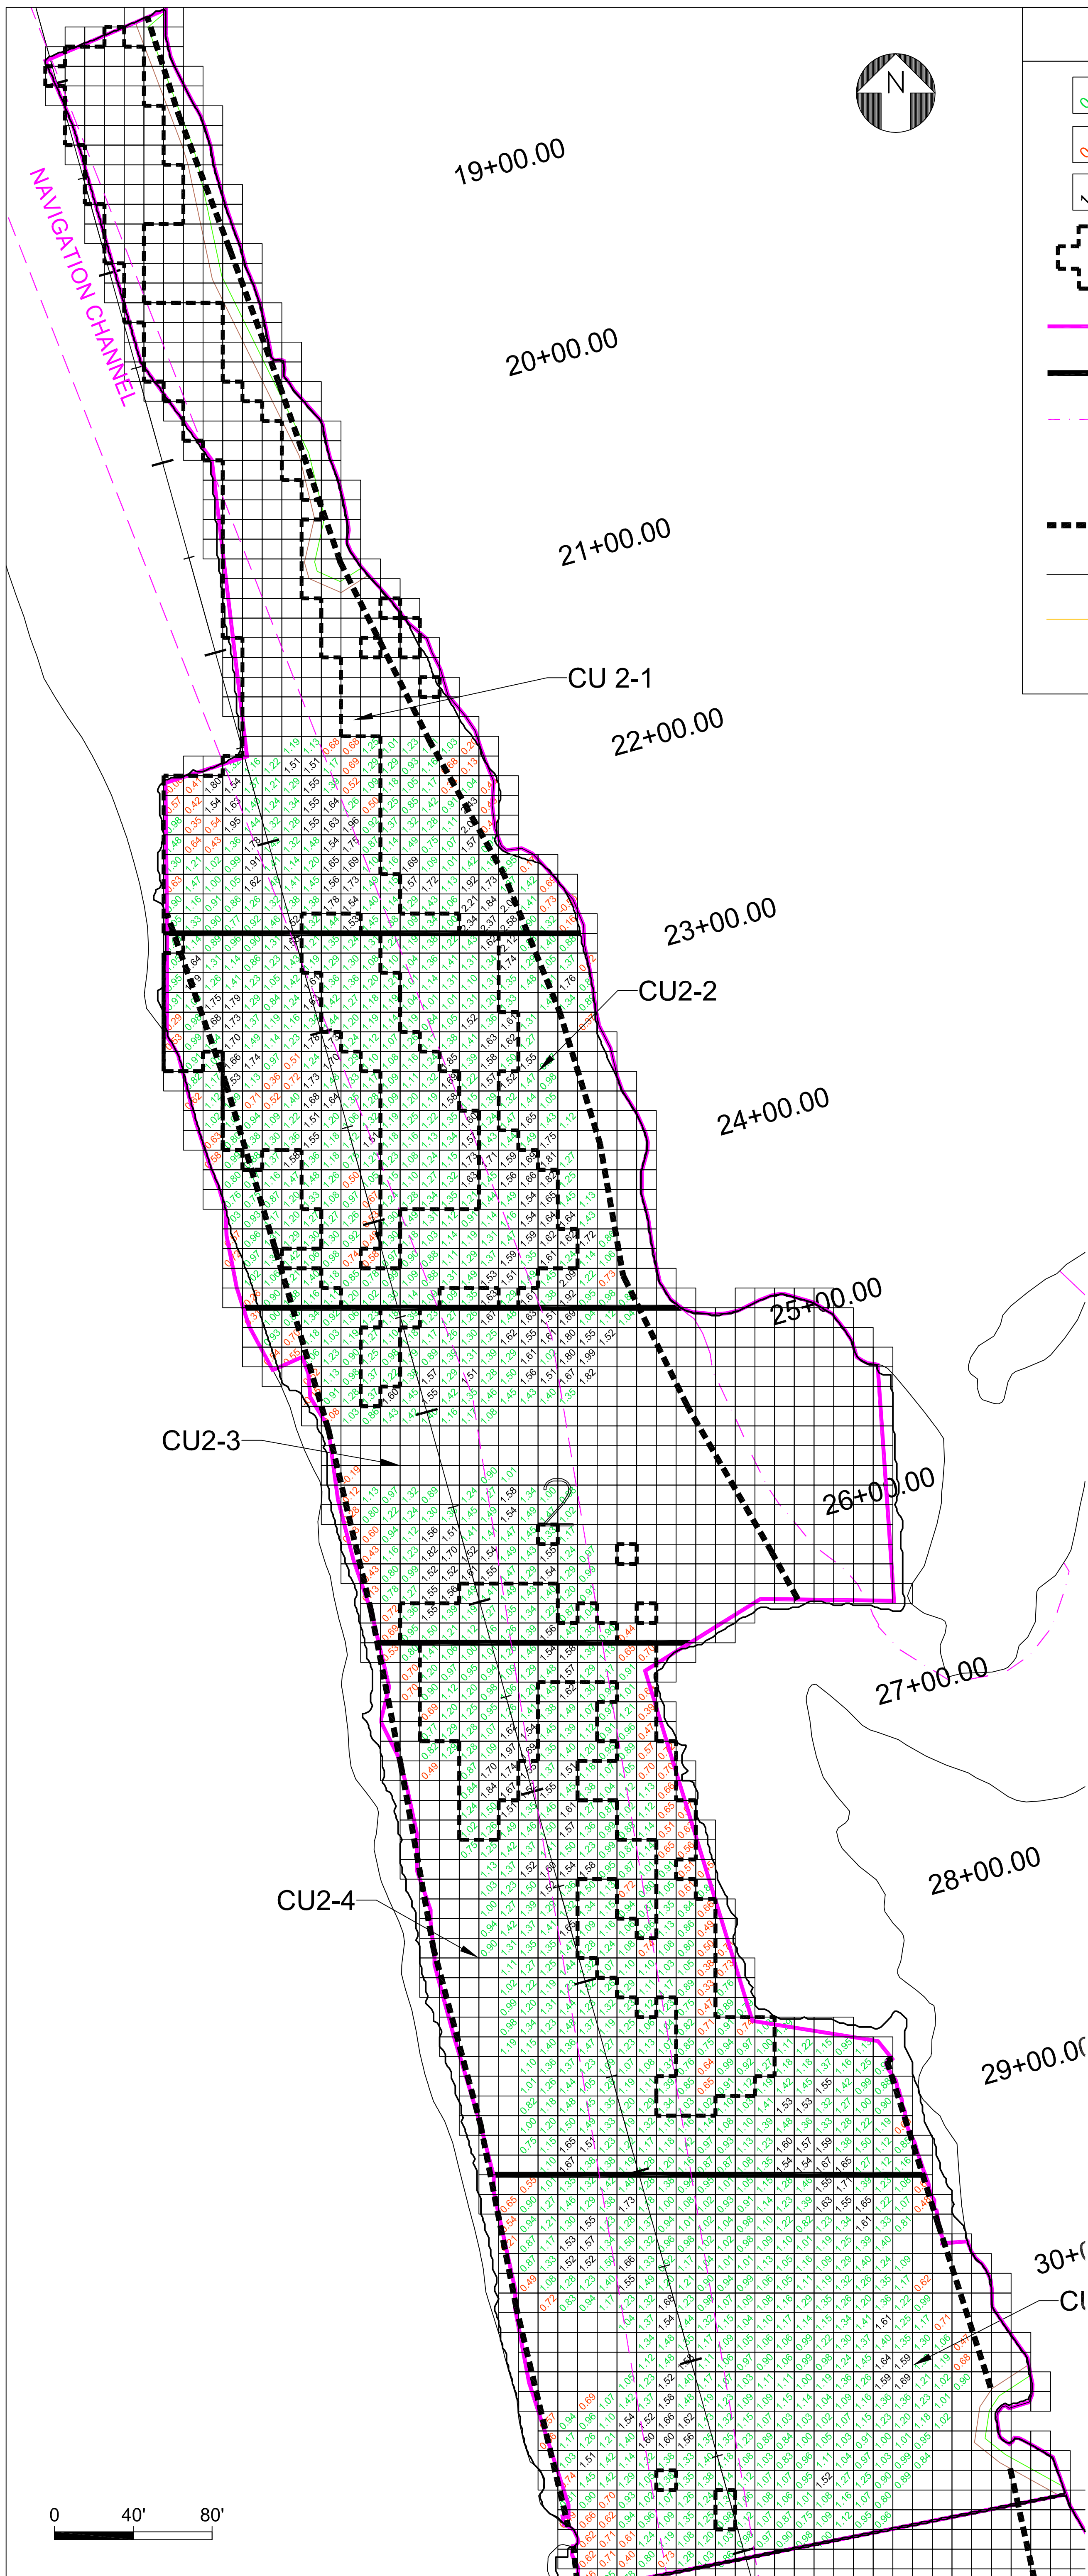


LEGEND


- 0.80 10'x10' GRID WITHIN DESIGN GUIDELINES
- 0.65 10'x10' GRID LESS THAN DESIGN GUIDELINES
- 1.60 10'x10' GRID ABOVE DESIGN GUIDELINES
- BUCKET REFUSAL ENCOUNTERED VIA DREDGING
- CU BOUNDARY
- CU SUBUNIT BOUNDARY
- POTENTIAL LOCATION FOR RIVERINE FRINGING WETLAND CONSTRUCTION (PLANTING BY OTHERS)
- NEARSHORE BORDER (117.5 FEET)
- MUD - RIP RAP INTERFACE
- 5 FOOT INTERFACE OFFSET

- NOTES:**
1. OSI MULTIBEAM SURVEY NOVEMBER 14, 2009.
 2. CAP THICKNESS OF ISOLATION LAYER IS LISTED 10'X10' GRID.

**CU2
TYPE "B" CAP
ISOLATION LAYER
10'x10' GRID
ACCEPTANCE SURVEY**

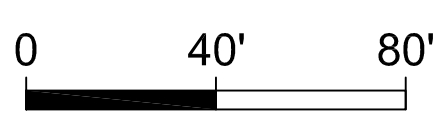

PARSONS <small>COMMERCIAL TECHNOLOGY GROUP</small>		DRAWING TITLE	
GE COMPANY - PARSONS PROJECT OFFICE BUILDING 40-1, 381 BROADWAY FORT EDWARD, N.Y. 12828 (518) 746-5311		CU2 CAP TYPE "B" ISOLATION LAYER ACCEPTANCE SURVEY	
DRAWN BY JHG	CHECKED BY MG	DRAWING NO.	SCALE AS SHOWN
DATE 11/18/09	APPROVED BY MG	CU2	JCR 442209.01401

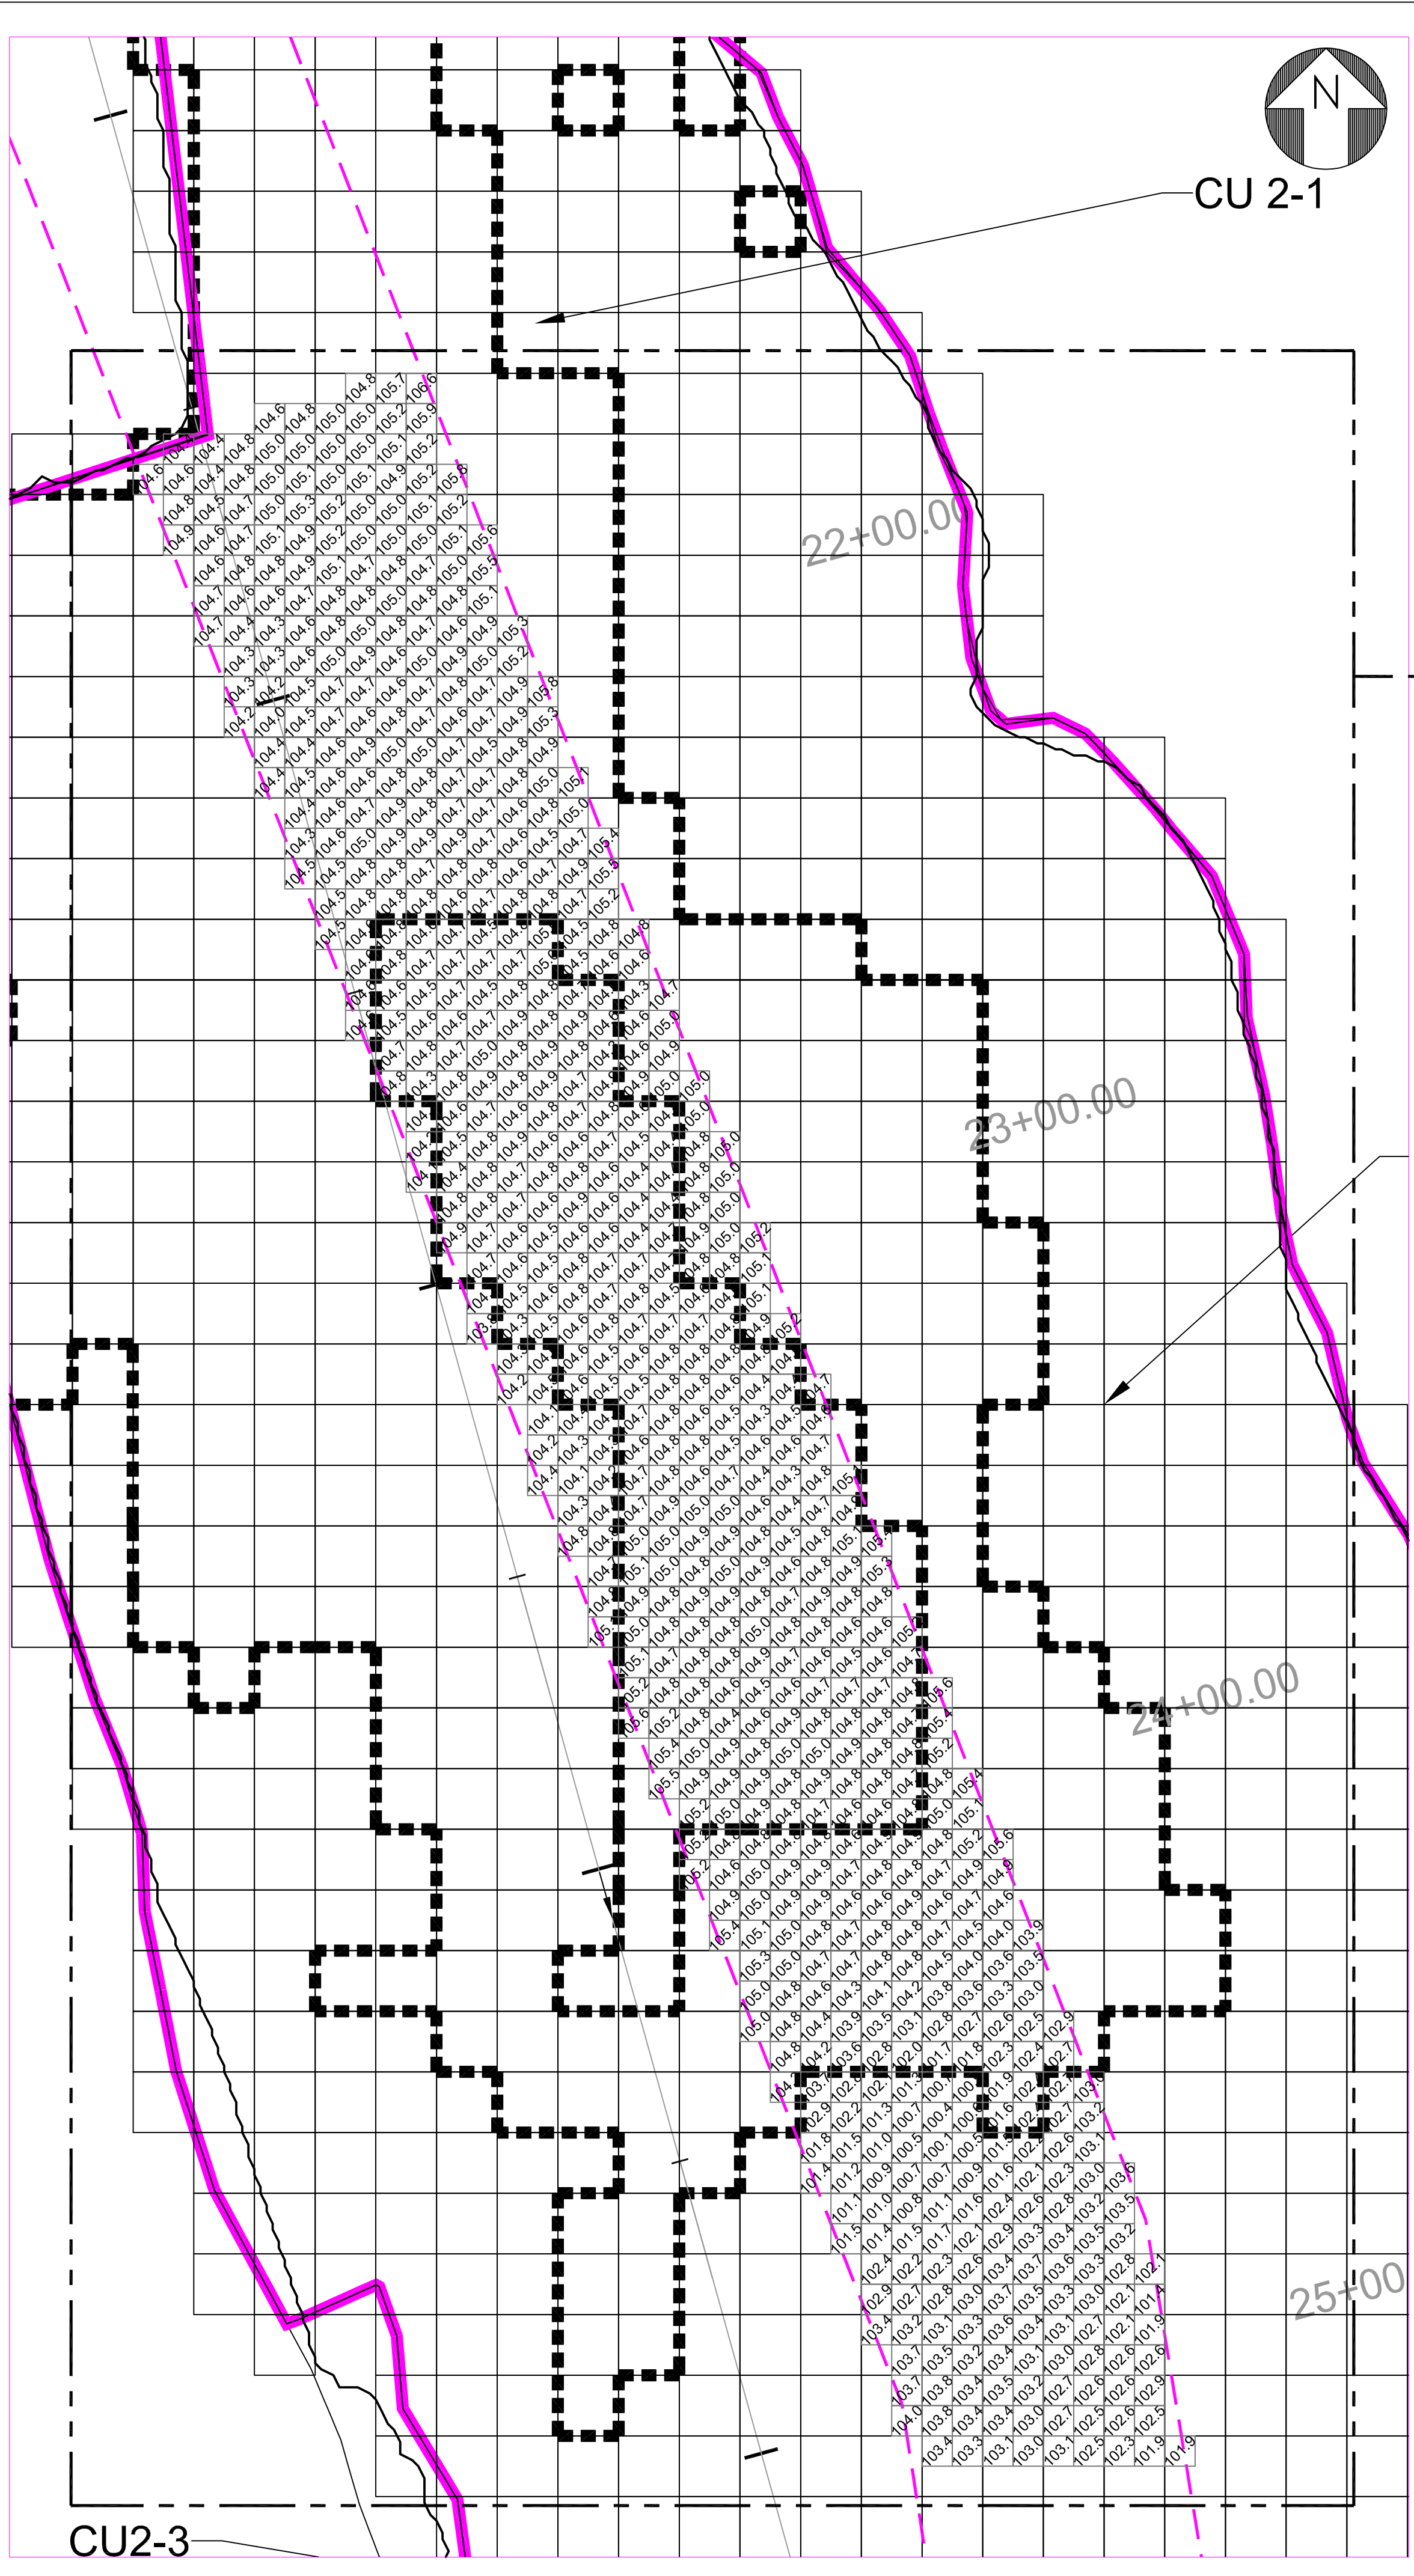


CU2 TYPE "B" CAP
MPLACEMENT-
NORTH (DWG 1 OF 2)

**CU2 TYPE "B" CAP PLACEMENT
NORTH**

LEGEND	
	5x5 GRID WITHIN DESIGN GUIDELINES
	5x5 GRID LESS THAN DESIGN GUIDELINES
	5x5 GRID ABOVE DESIGN GUIDELINES
	ROCK/REFUSAL ENCOUNTERED VIA DREDGING
	CU BOUNDARY
	CU SUBUNIT BOUNDARY
	MUD - RIP RAP INTERFACE
	5' INTERFACE OFFSET
	NAVIGATION CHANNEL

NOTES:

1. OSI MULTIBEAM SURVEY ON NOVEMBER 1, 2009 OF CU2 NAVIGATION CHANNEL.
2. CAP ELEVATIONS ARE LISTED IN 5'x5' GRIDS.

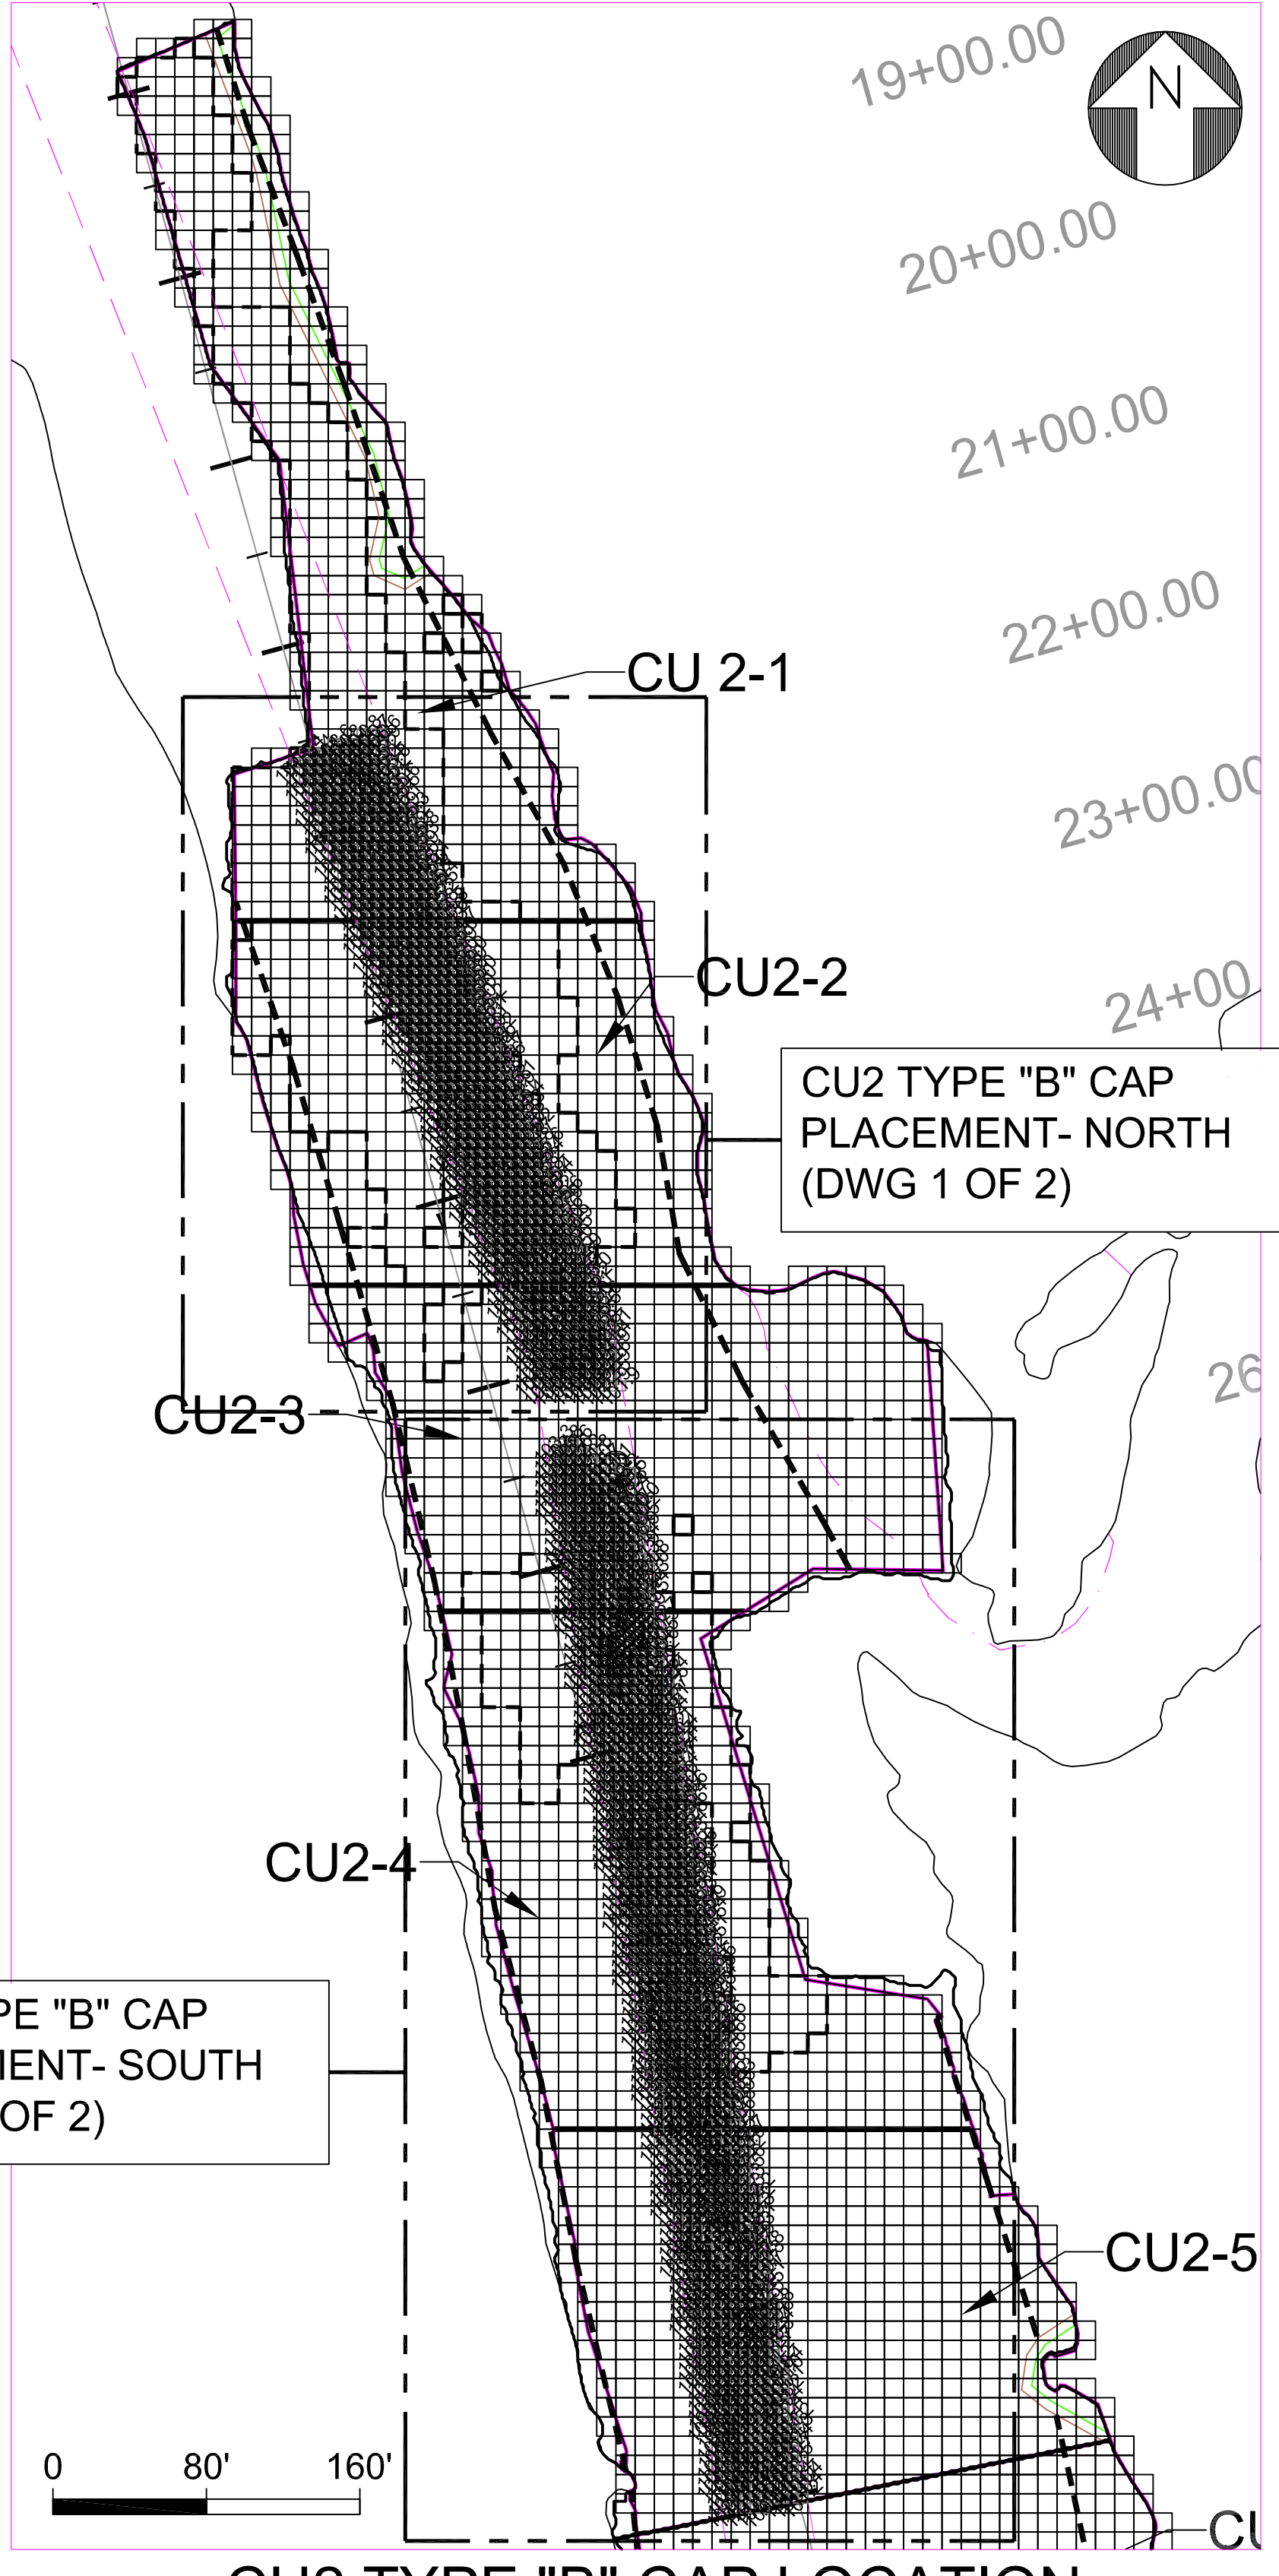


CU2 TYPE "B" CAP
PLACEMENT- SOUTH
(DWG 2 OF 2)




CU2 TYPE "B" CAP LOCATION

CU2
TYPE "B" CAP
ARMOR STONE
ACCEPTANCE SURVEY
NAVIGATION CHANNEL
ELEVATIONS

PARSONS CONSULTING ENGINEERS		DRAWING TITLE	
GE COMPANY - PARSONS PROJECT OFFICE BUILDING 40-1, 381 BROADWAY FORT EDWARD, N.Y. 12828 (518) 746-5311		CU2 TYPE "B" CAP ARMOR STONE NAV CHANNEL ELEVATIONS	
DRAWN BY JHC	CHECKED BY MG	DRAWING NO. CU2-3-1	SCALE AS SHOWN
DATE 11/18/09	APPROVED BY MG	JOB NO. 442209.01401	

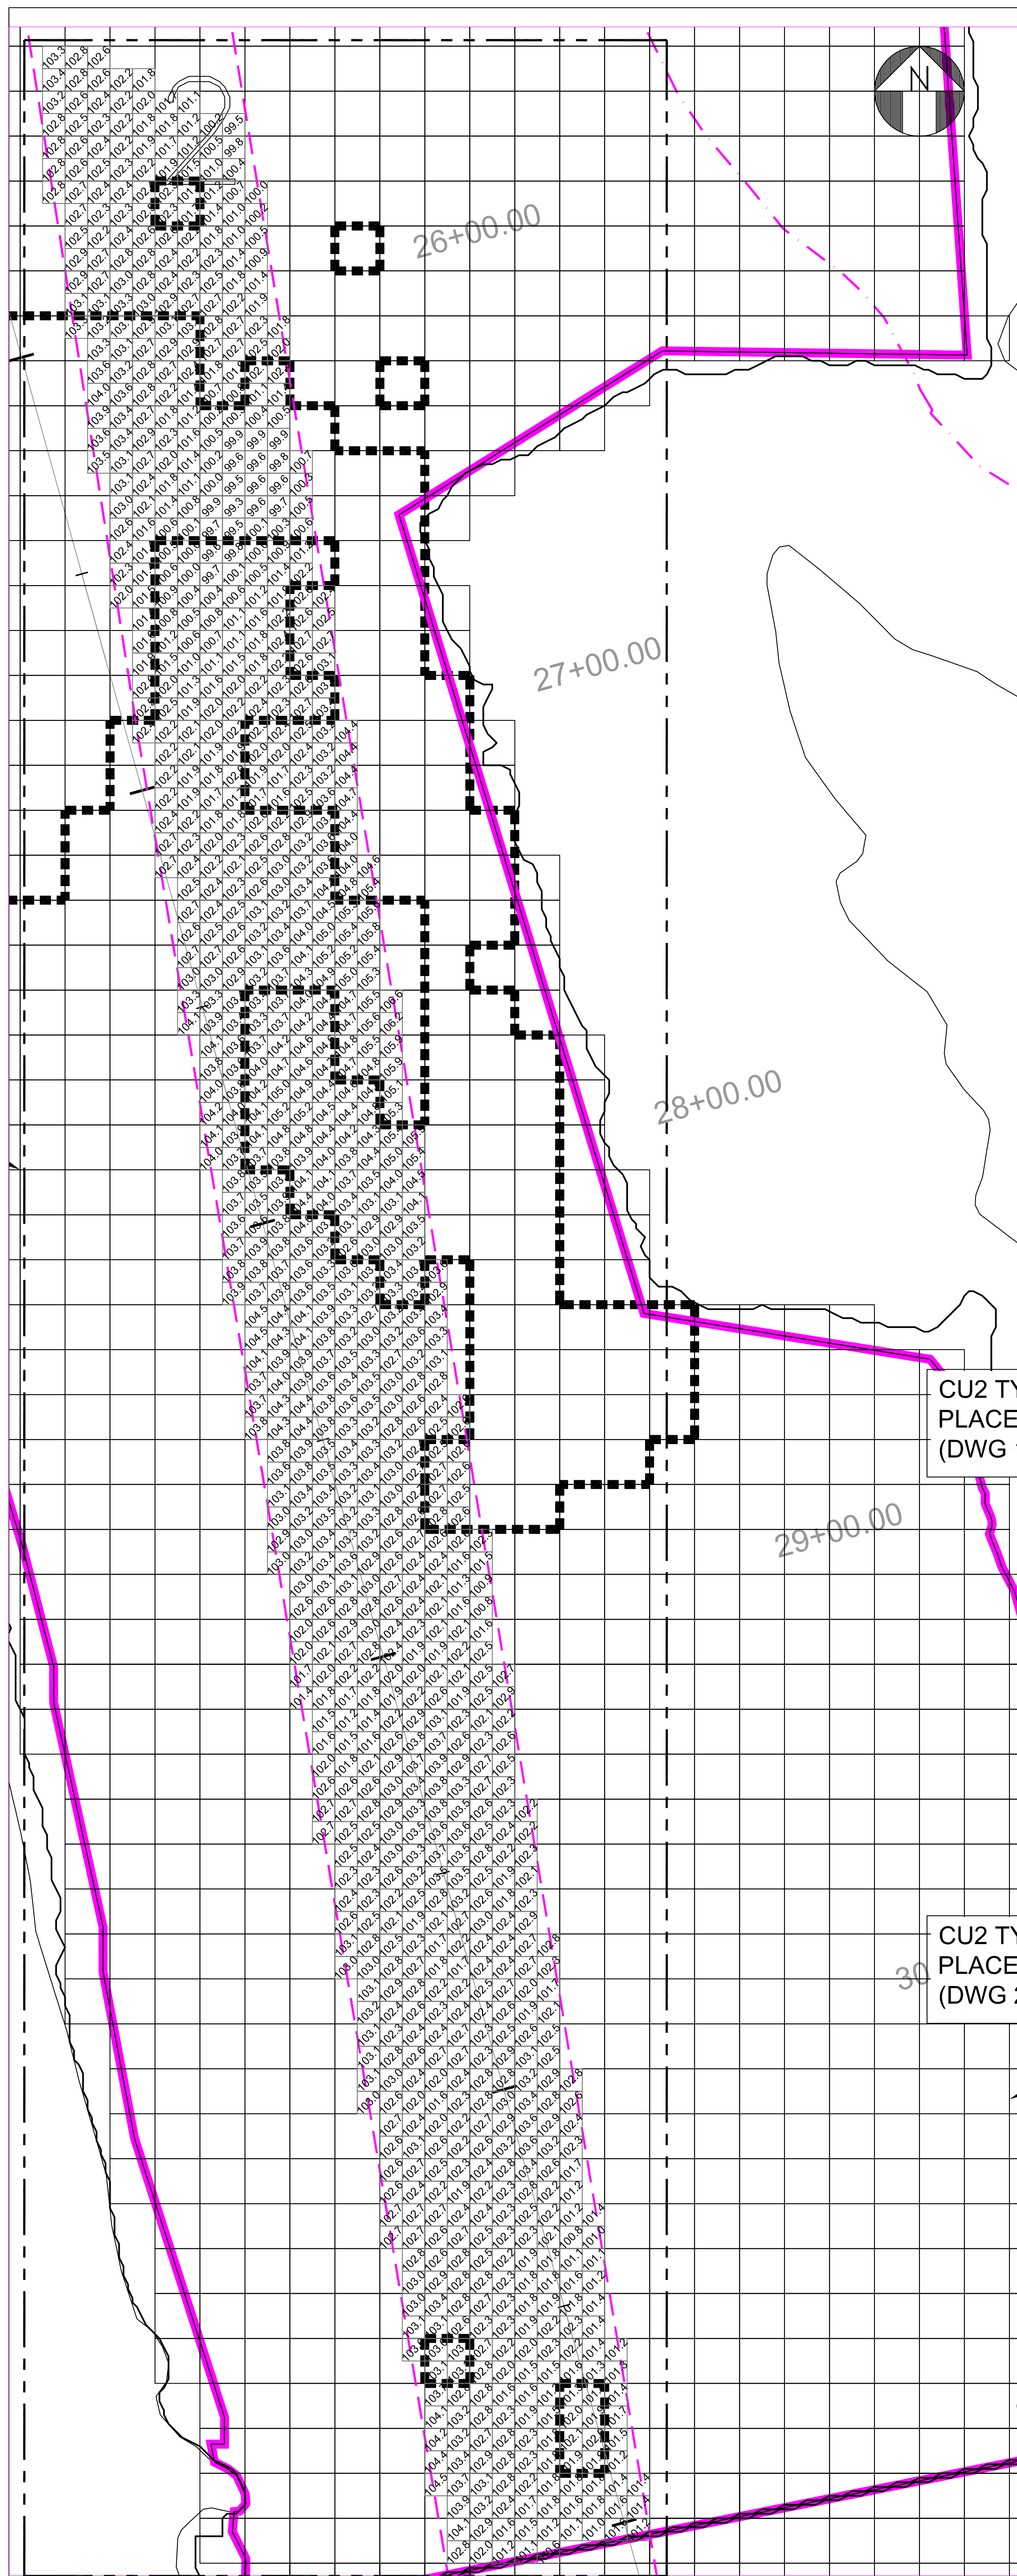

CU2 TYPE "B" CAP PLACEMENT SOUTH

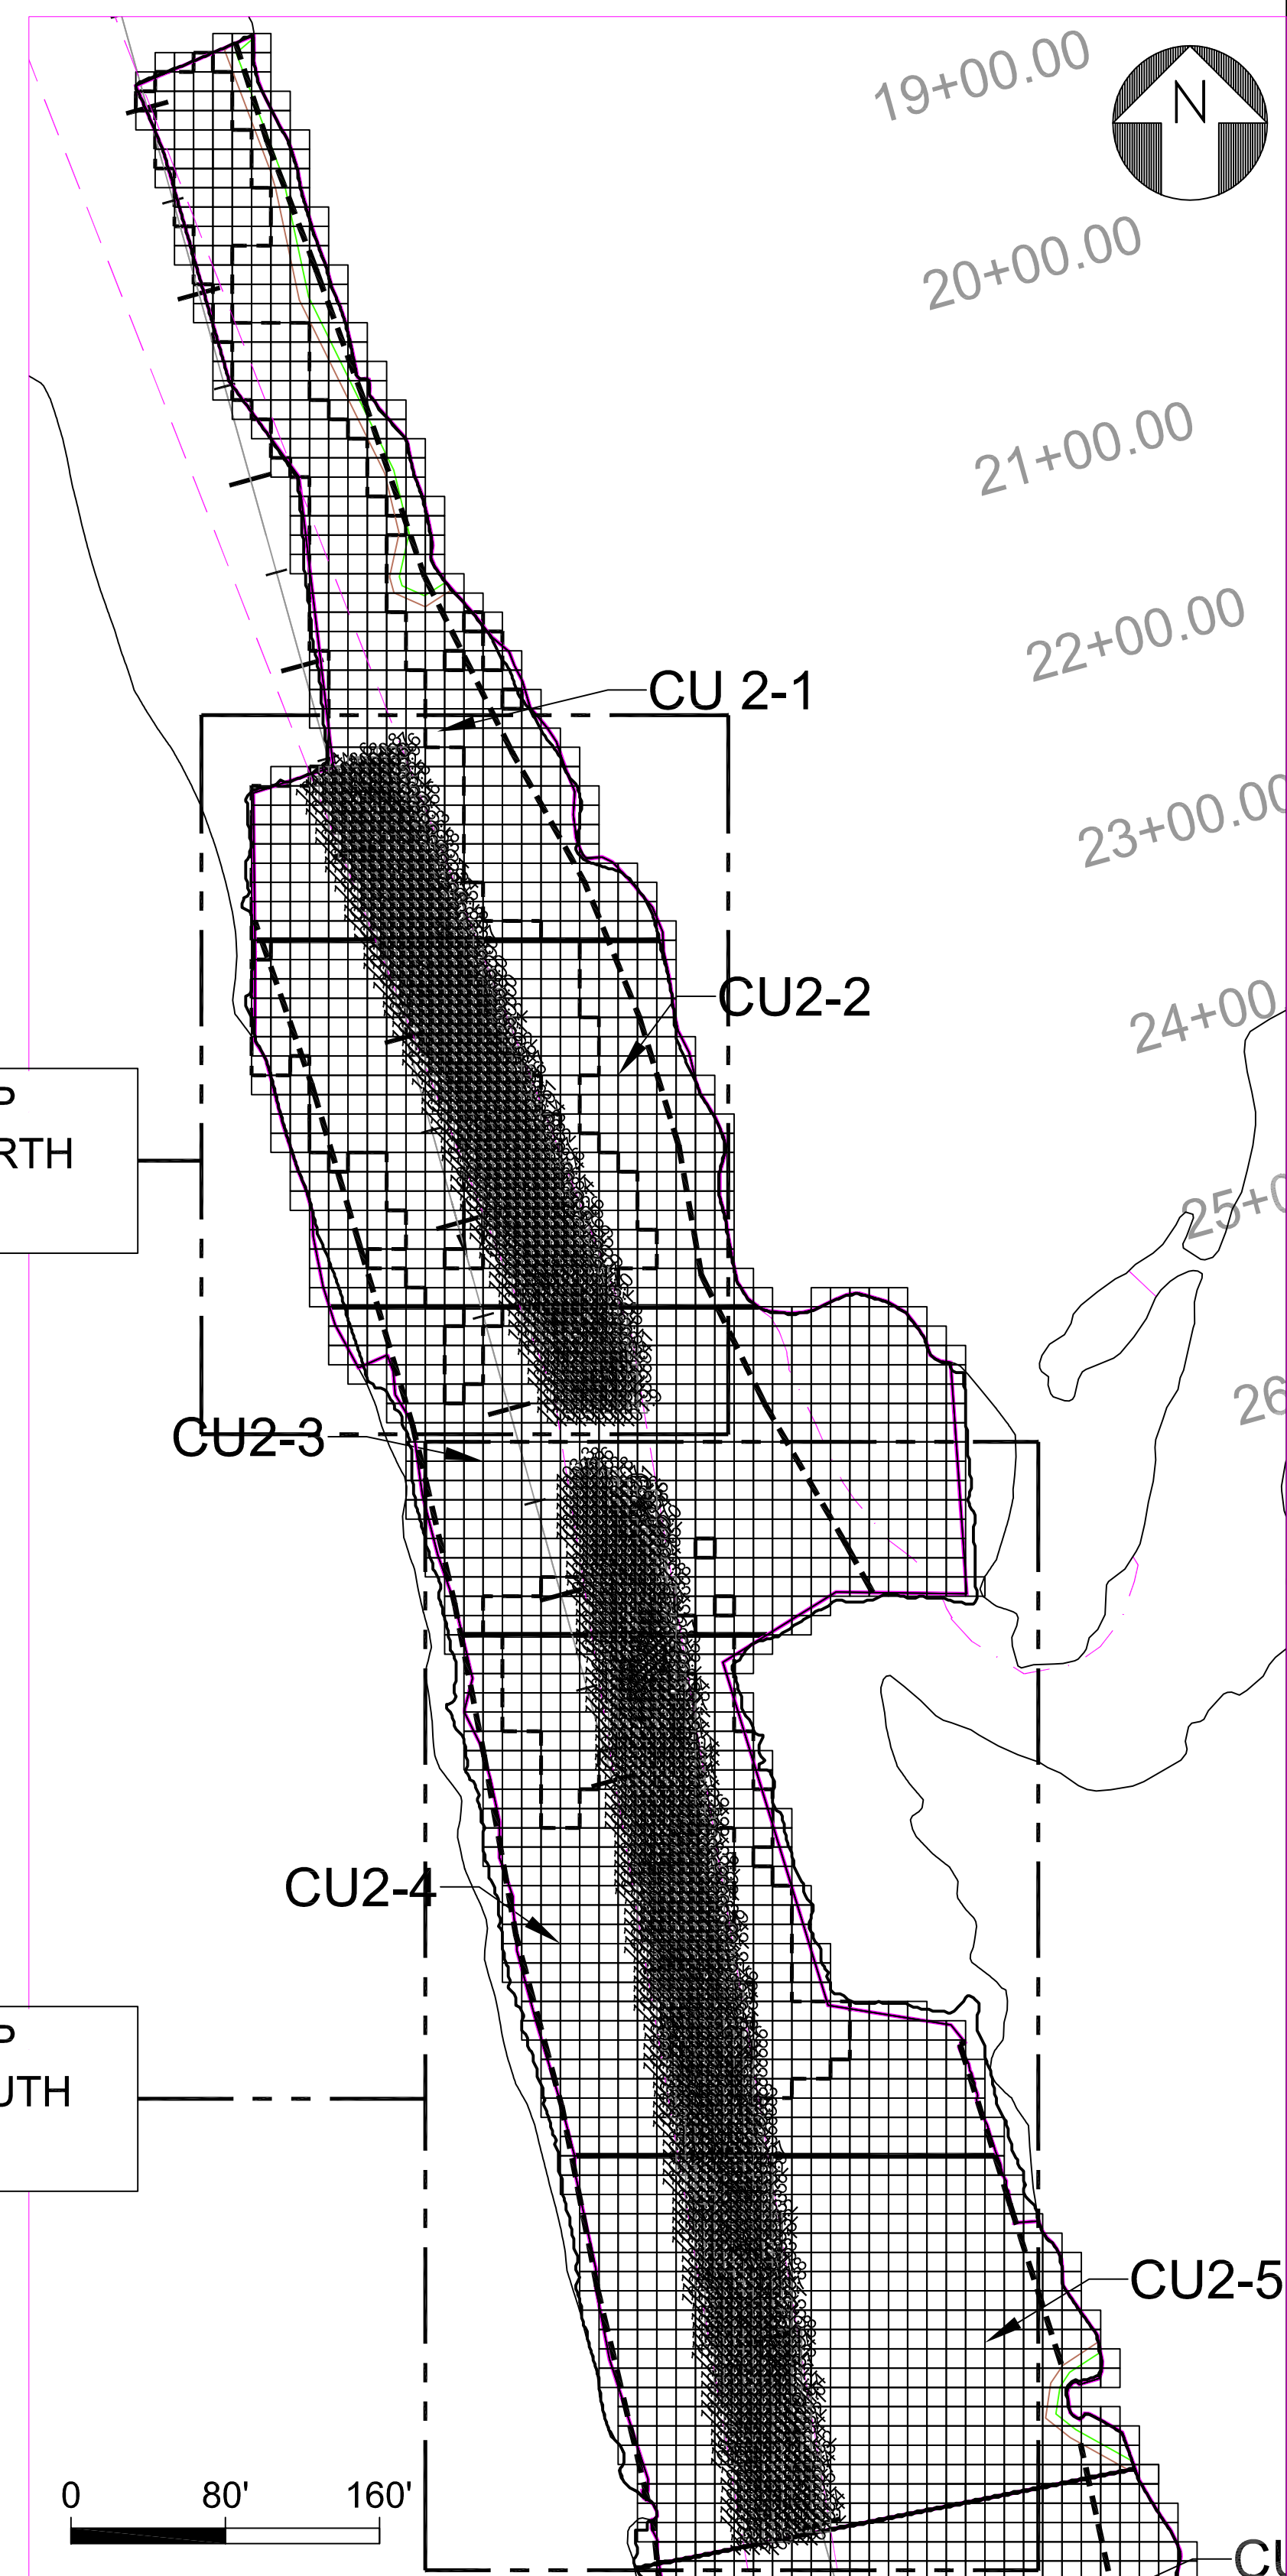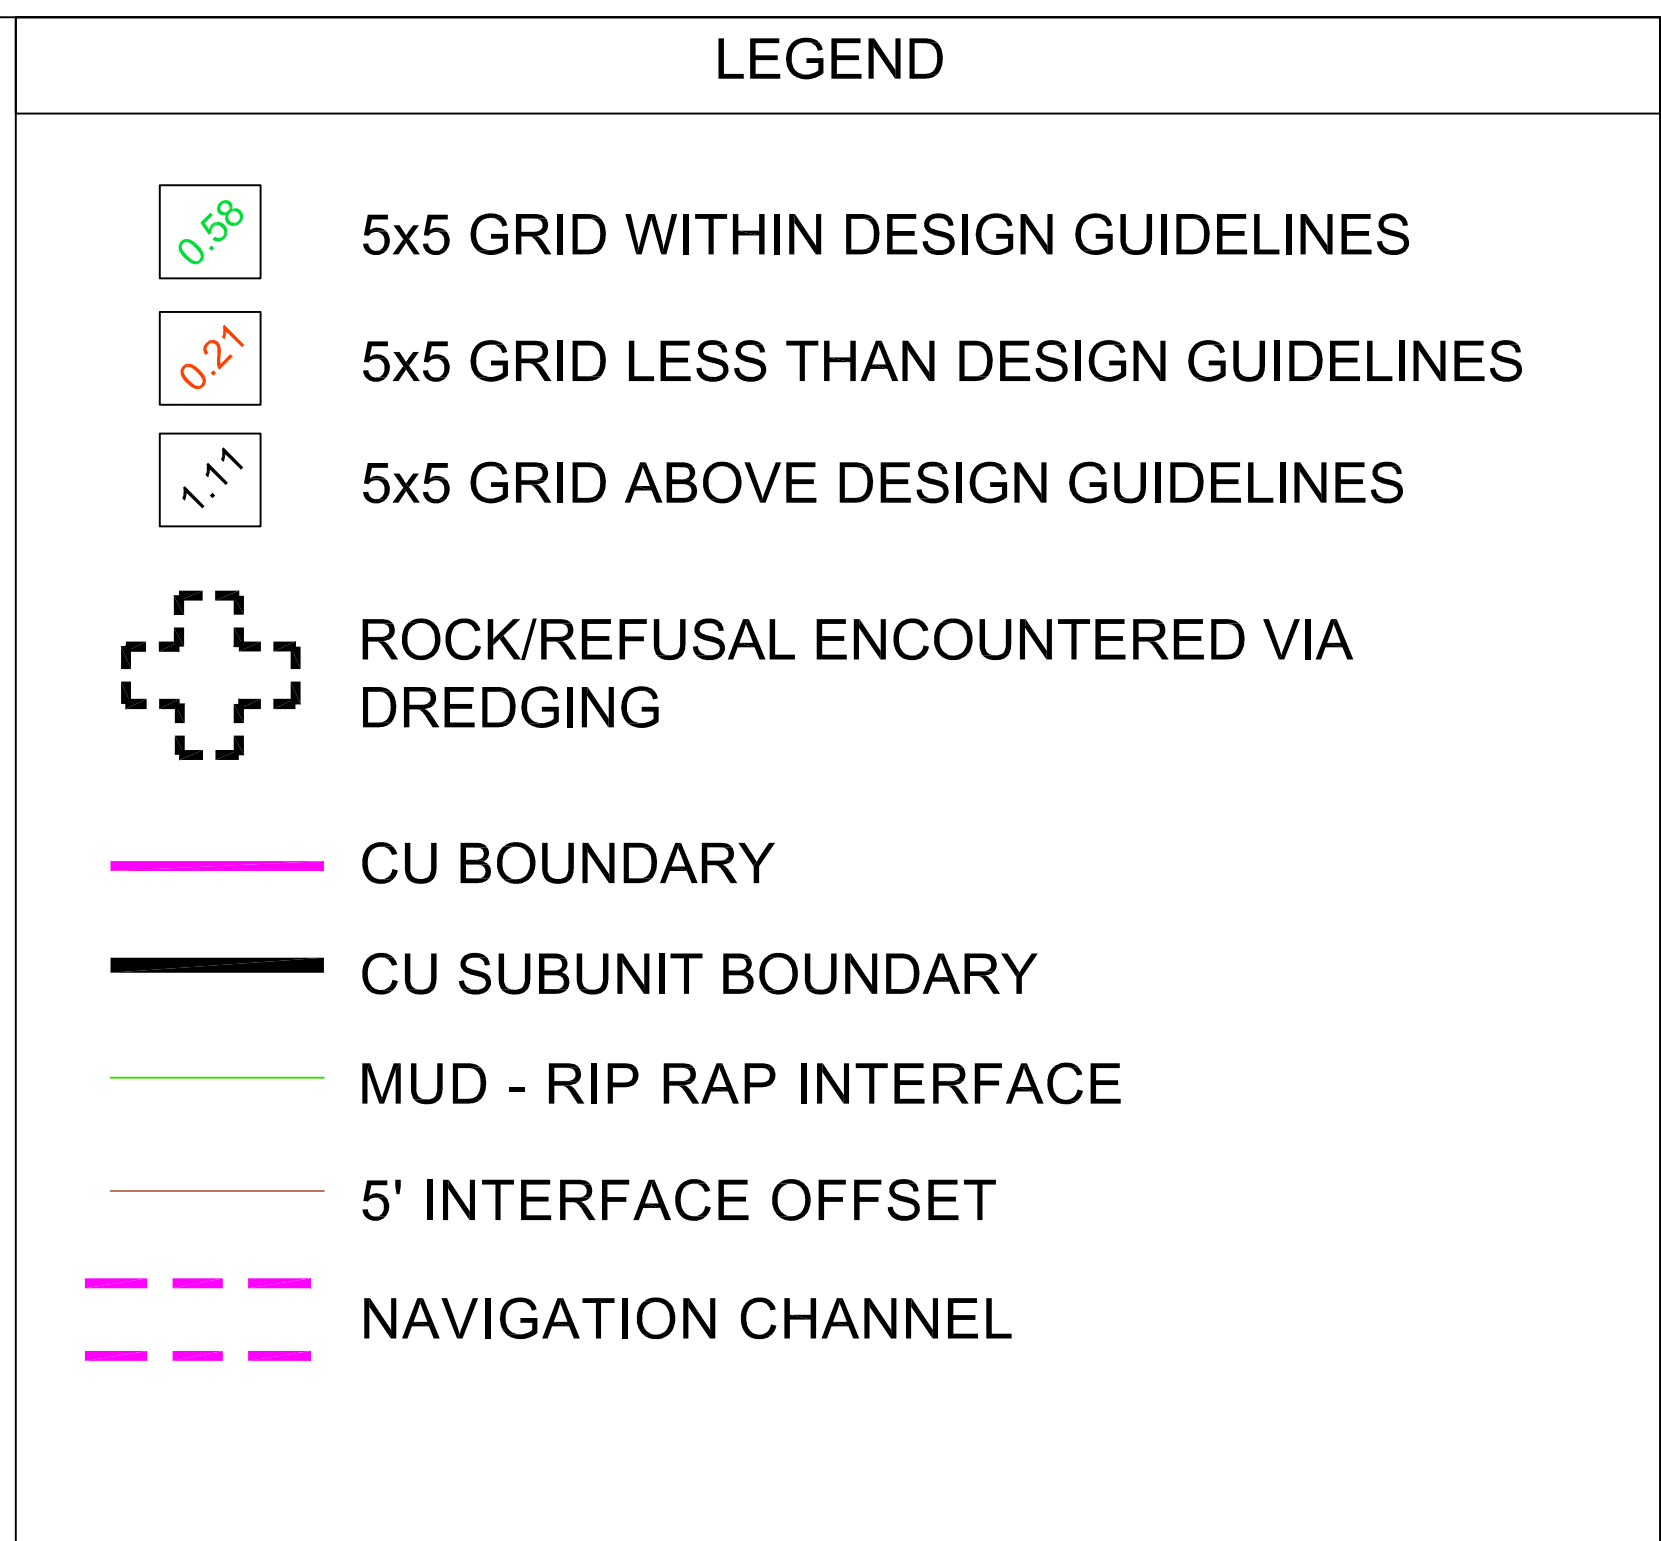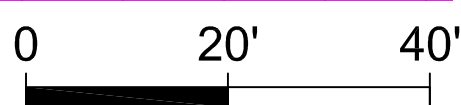


CU2 TYPE "B" CAP LOCATION

NOTES:

1. OSI MULTIBEAM SURVEY ON NOVEMBER 4, 2009 OF CU2 NAVIGATION CHANNEL.
2. CAP ELEVATIONS ARE LISTED IN 5'x5' GRIDS.

CU2
TYPE "B" CAP
ARMOR STONE
ACCEPTANCE SURVEY
NAVIGATION CHANNEL
ELEVATIONS

PARSONS CONSULTING ENGINEERS		DRAWING TITLE	
GE COMPANY - PARSONS PROJECT OFFICE BUILDING 40-1, 381 BROADWAY FORT EDWARD, N.Y. 12828 (518) 746-5311		CU2 TYPE "B" CAP ARMOR STONE NAVIGATION CHANNEL ELEVATIONS	
DRAWN BY: JHC	CHECKED BY: MG	DRAWING NO.:	VERSION SCALE:
DATE: 11/18/09	APPROVED BY: MG	CU2-3-2	A AS SHOWN
		JOB:	442209.01401

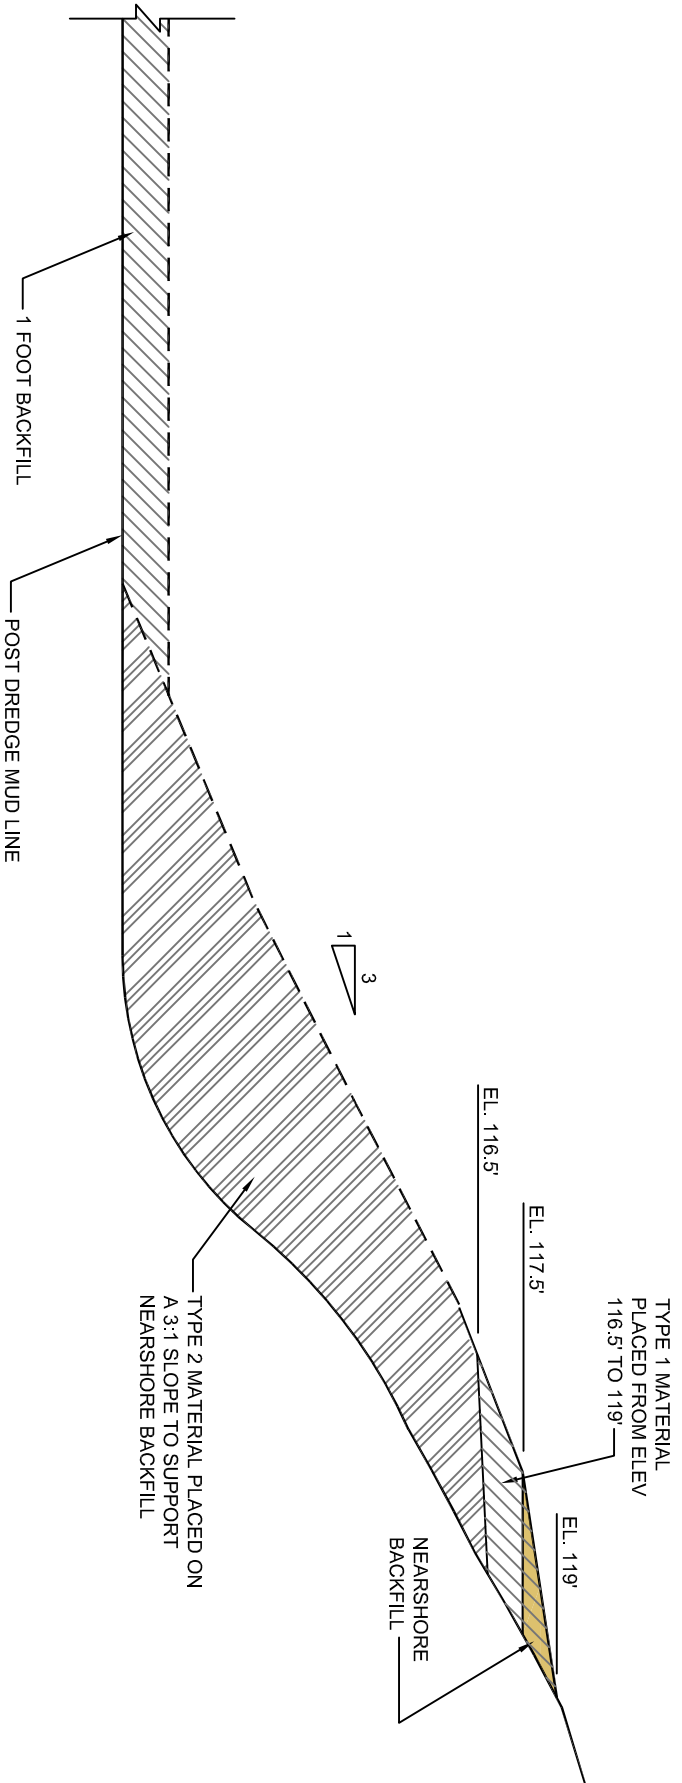


NEAR SHORE BACKFILL PLACEMENT DETAIL

TYPICAL SECTION NOT TO SCALE

RECORD
DRAWING

PARSONS <small>COMMERCIAL TECHNOLOGY GROUP</small>		DRAWING TITLE CU2 NEAR SHORE BACKFILL PLACEMENT DETAIL	
GE COMPANY - PARSONS PROJECT OFFICE BUILDING 40-1, 381 BROADWAY FORT EDWARD, N.Y. 12828 (518) 746-5311		CHECKED BY MG	
DRAWN BY JHG		APPROVED BY MG	
DATE 11/05/09		DRAWING NO. CU2-BF-C01	
		SCALE NOT TO SCALE JOB 442209	

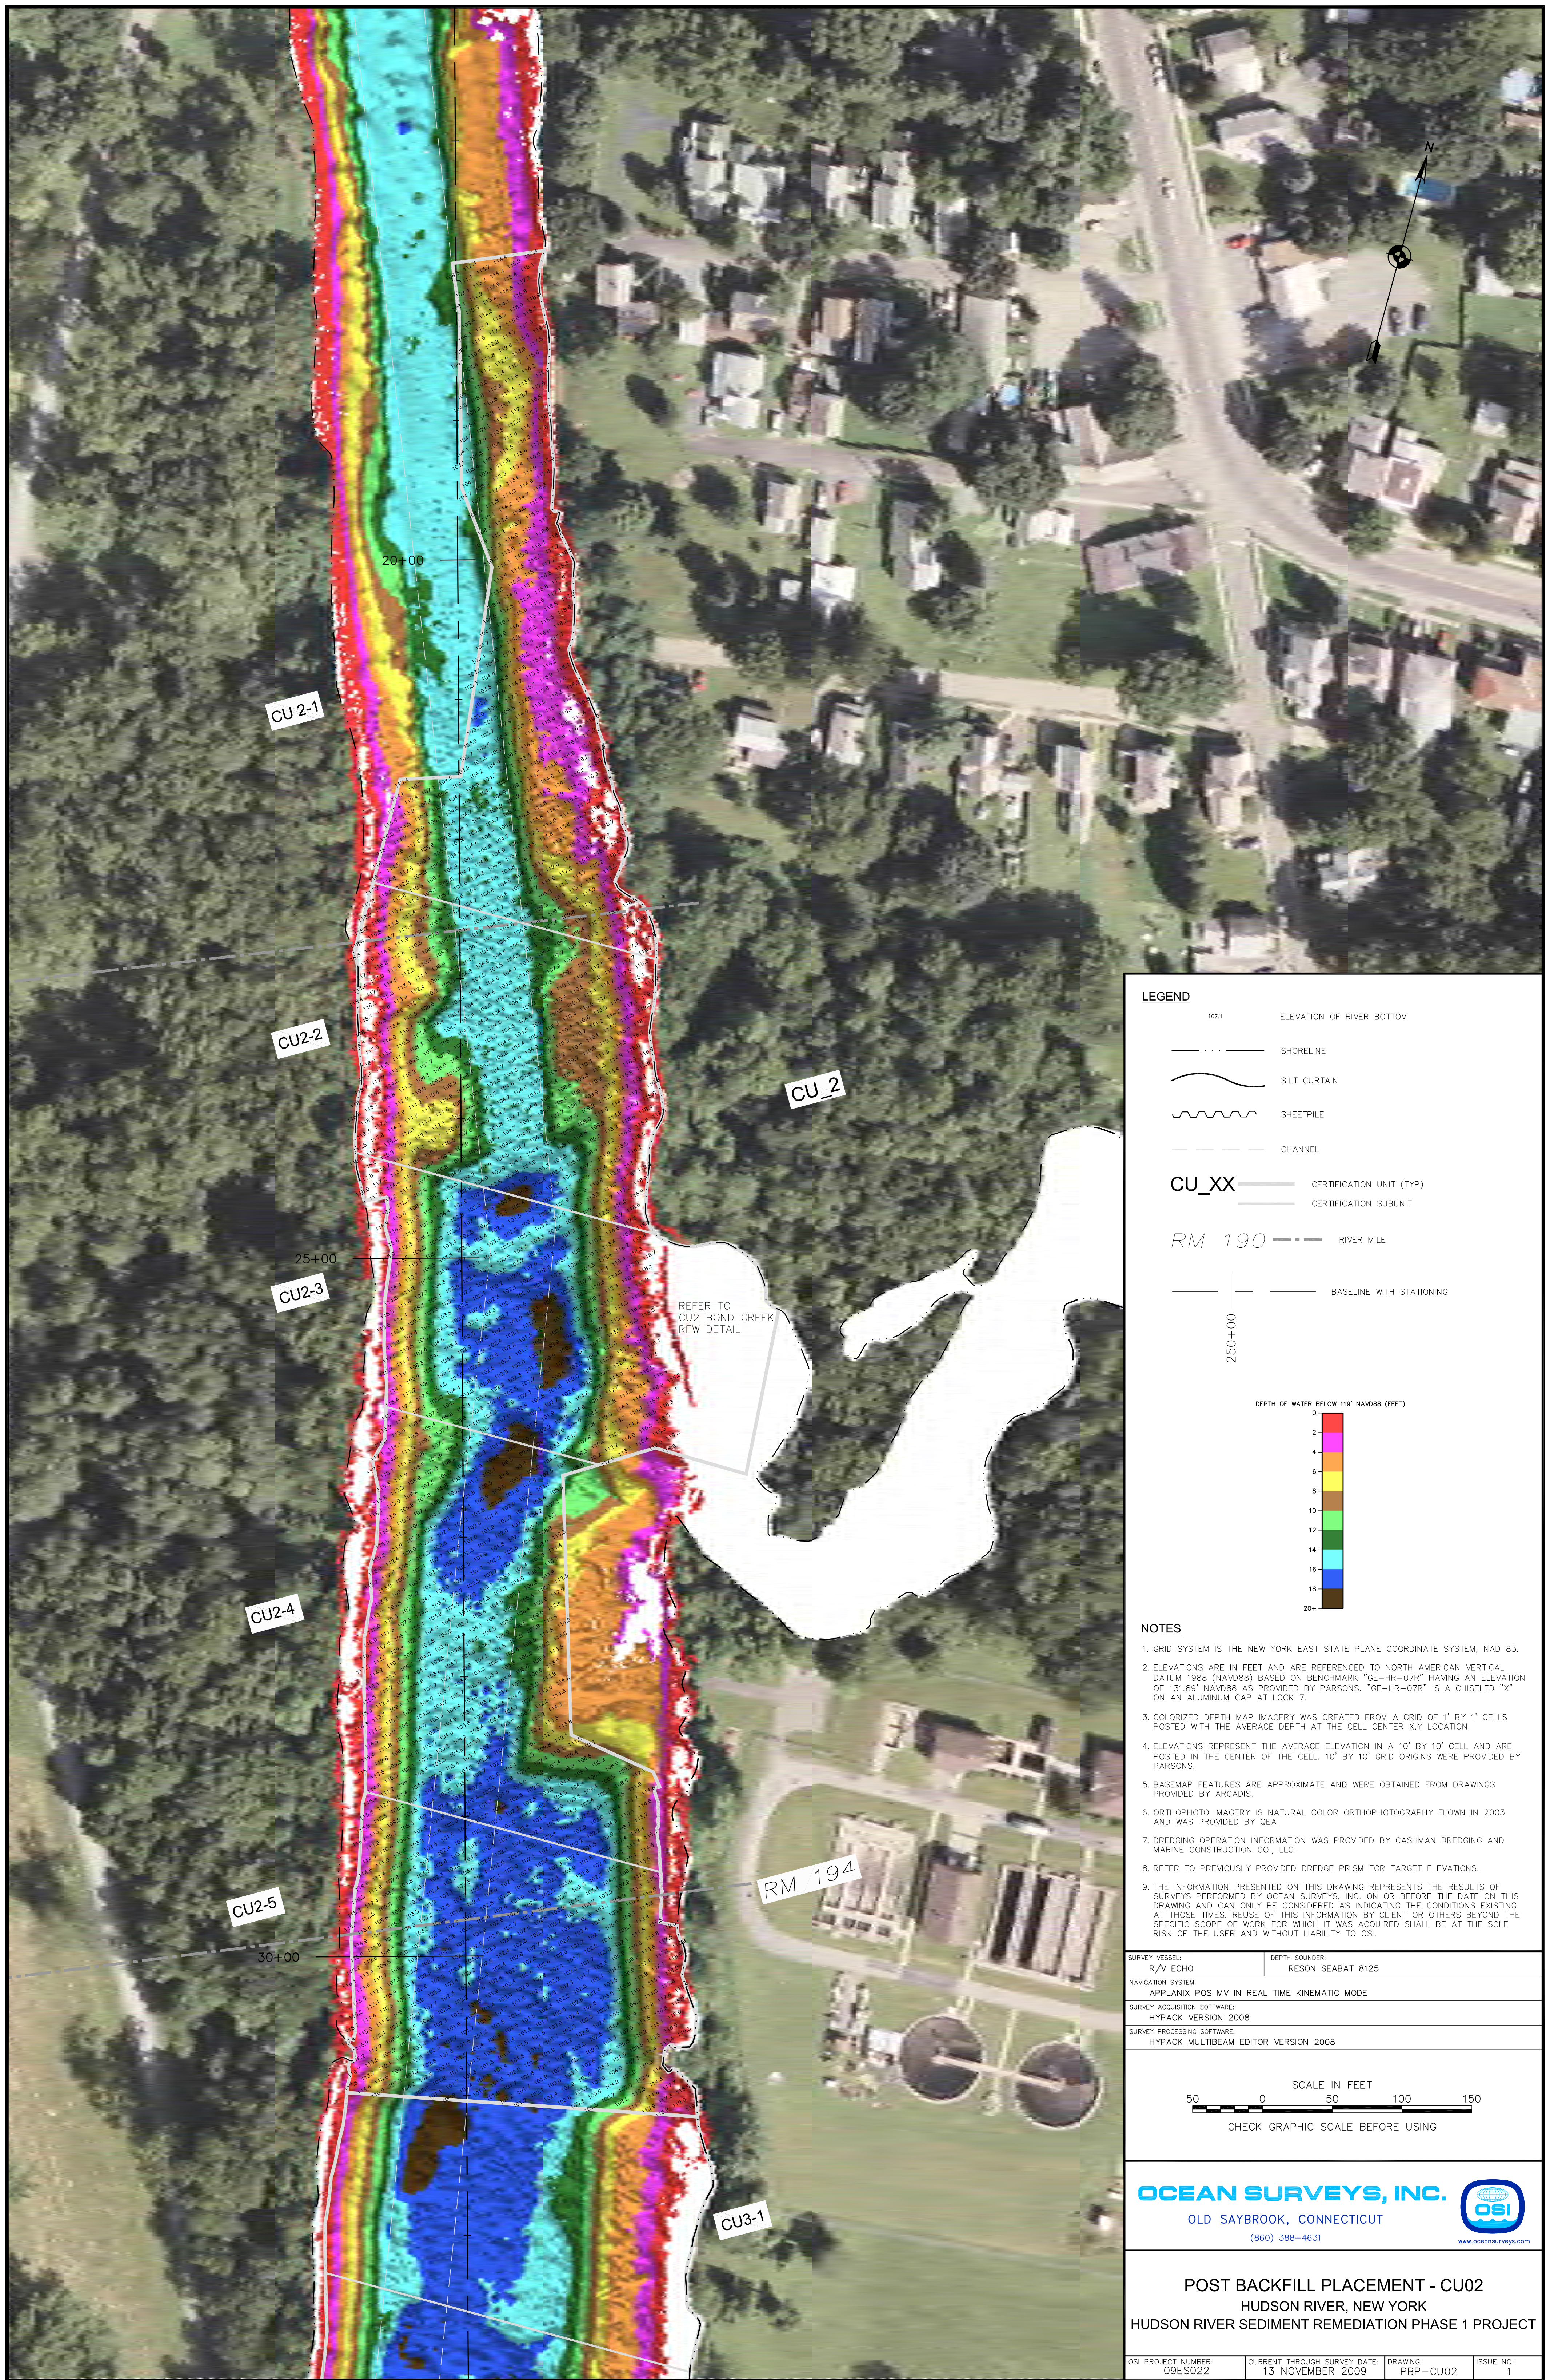

LEGEND

107.1 ELEVATION OF RIVER BOTTOM

--- SHORELINE

~ SILT CURTAIN

~ SHEETPILE


--- CHANNEL

CU_XX --- CERTIFICATION UNIT (TYP)

--- CERTIFICATION SUBUNIT


RM 190 --- RIVER MILE

--- BASELINE WITH STATIONING

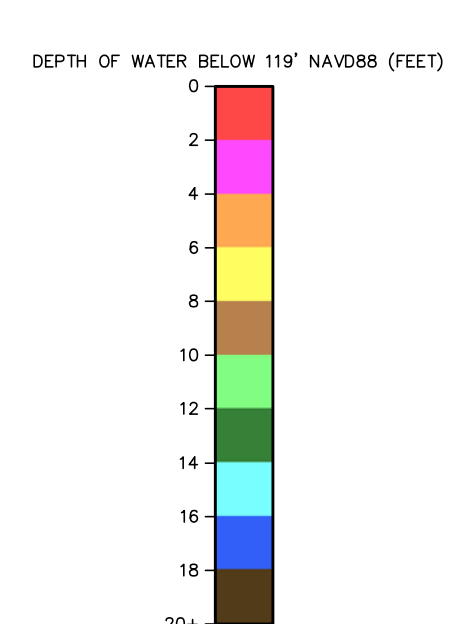

- NOTES**
1. GRID SYSTEM IS THE NEW YORK EAST STATE PLANE COORDINATE SYSTEM, NAD 83.
 2. ELEVATIONS ARE IN FEET AND ARE REFERENCED TO NORTH AMERICAN VERTICAL DATUM 1988 (NAVD88) BASED ON BENCHMARK "GE-HR-07R" HAVING AN ELEVATION OF 131.89' NAVD88 AS PROVIDED BY PARSONS. "GE-HR-07R" IS A CHISELED "X" ON AN ALUMINUM CAP AT LOCK 7.
 3. COLORIZED DEPTH MAP IMAGERY WAS CREATED FROM A GRID OF 1' BY 1' CELLS POSTED WITH THE AVERAGE DEPTH AT THE CELL CENTER X,Y LOCATION.
 4. ELEVATIONS REPRESENT THE AVERAGE ELEVATION IN A 10' BY 10' CELL AND ARE POSTED IN THE CENTER OF THE CELL. 10' BY 10' GRID ORIGINS WERE PROVIDED BY PARSONS.
 5. BASEMAP FEATURES ARE APPROXIMATE AND WERE OBTAINED FROM DRAWINGS PROVIDED BY ARCADIS.
 6. ORTHOPHOTO IMAGERY IS NATURAL COLOR ORTHOPHOTOGRAPHY FLOWN IN 2003 AND WAS PROVIDED BY OEA.
 7. DREDGING OPERATION INFORMATION WAS PROVIDED BY CASHMAN DREDGING AND MARINE CONSTRUCTION CO., LLC.
 8. REFER TO PREVIOUSLY PROVIDED DREDGE PRISM FOR TARGET ELEVATIONS.
 9. THE INFORMATION PRESENTED ON THIS DRAWING REPRESENTS THE RESULTS OF SURVEYS PERFORMED BY OCEAN SURVEYS, INC. ON OR BEFORE THE DATE ON THIS DRAWING AND CAN ONLY BE CONSIDERED AS INDICATING THE CONDITIONS EXISTING AT THOSE TIMES. REUSE OF THIS INFORMATION BY CLIENT OR OTHERS BEYOND THE SPECIFIC SCOPE OF WORK FOR WHICH IT WAS ACQUIRED SHALL BE AT THE SOLE RISK OF THE USER AND WITHOUT LIABILITY TO OSI.

SURVEY VESSEL: R/V ECHO	DEPTH SOUNDER: RESON SEABAT 8125
NAVIGATION SYSTEM: APPLANIX POS MV IN REAL TIME KINEMATIC MODE	
SURVEY ACQUISITION SOFTWARE: HYPACK VERSION 2008	
SURVEY PROCESSING SOFTWARE: HYPACK MULTIBEAM EDITOR VERSION 2008	

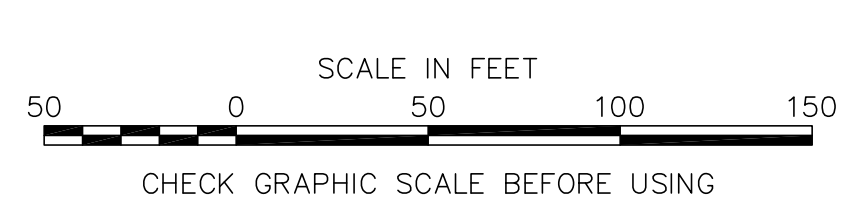

OCEAN SURVEYS, INC. 

OLD SAYBROOK, CONNECTICUT
(860) 388-4631
www.oceansurveys.com

POST BACKFILL PLACEMENT - CU02
HUDSON RIVER, NEW YORK
HUDSON RIVER SEDIMENT REMEDIATION PHASE 1 PROJECT

OSI PROJECT NUMBER: 09ES022	CURRENT THROUGH SURVEY DATE: 13 NOVEMBER 2009	DRAWING: PBP-CU02	ISSUE NO.: 1
--------------------------------	--	----------------------	-----------------

Correspondence
(Letters and Emails)

Galbraith, Michael

From: King.David@epamail.epa.gov
Sent: Wednesday, October 28, 2009 10:46 AM
To: Inglis, Andrew A (GE, Corporate)
Cc: Joseph Moloughney; Galbraith, Michael; MJohnson@louisberger.com; timothy.kruppenbacher@ge.com; USACE_HRFO@roadrunner.com
Subject: Re: CU2 isolation layer elevations
Attachments: CAP LAYER A 10x10 CU2-2 Nav Channel elev bd-landscape (1).pdf

Andrew,
Clearances look fine.

Dave

"Inglis, Andrew
A (GE,
Corporate)"
<andrew.inglis@ge.com>
10/28/2009 08:17
AM

David King/R2/USEPA/US@EPA
<MJohnson@louisberger.com>,
<USACE_HRFO@roadrunner.com>,
<timothy.kruppenbacher@ge.com>,
<michael.galbraith@parsons.com>,
"Joseph Moloughney"
<Joseph_Moloughney@canals.state.ny.us>

To
cc
Subject
CU2 isolation layer elevations

Dave,

See attached survey results for CU2-2 where the dredging contractor removed backfill material to create the space necessary for the armor layer.

Based on the survey we are directing the dredging contractor to place the armor layer in this area.

Let me know ASAP if you have any concerns.

thanks,

Andrew A. Inglis
Dredging Task Leader
GE

T +1 518-746-5256

381 Broadway
Building 40-2
Fort Edward, NY 12828
GE Corporate Environmental Programs

GE Imagination at Work

(See attached file: CAP LAYER A 10x10 CU2-2 Nav Channel elev bd-landscape (1).pdf)

Galbraith, Michael

From: Inglis, Andrew A (GE, Corporate) [andrew.inglis@ge.com]
Sent: Wednesday, November 18, 2009 4:14 PM
To: Galbraith, Michael
Subject: FW: Discussion regarding CU1 and 2 Backfill and Cap

From: Inglis, Andrew A (GE, Corporate)
Sent: Tuesday, November 10, 2009 8:13 PM
To: king.david@epamail.epa.gov
Cc: MJohnson@louisberger.com; timothy.kruppenbacher@ge.com; michael.galbraith@parsons.com; Bryan Miner (USACE_HRFO@roadrunner.com); GKlawinski@ene.com; Joseph Moloughney
Subject: Discussion regarding CU1 and 2 Backfill and Cap

Dave,

Yesterday we met and reviewed progress surveys of cap isolation layer placement in CU1 and cap armor stone placement in CU2. This email confirms decisions made during the meeting based on reviews of the maps.

CU1.

In CU1-1 GE will remove excess backfill material so that armor stone can be placed below 105.2' elevation. This excess backfill material will then be placed in areas of CU1-3 and CU1-4.

In CU1-3 and 1-4 GE will place additional material to raise the isolation layer to be as close to 9" as possible while also providing room to place the armor layer below 105.2'.

It was agreed that the isolation layer placement in CU1-2 was acceptable.

CU2.

The cap armor stone layer in the southern half of the CU was agreed to be acceptable. It was agreed that portions of the cap armor stone in the northern half of the CU will require additional material. It was also agreed that placing additional Type O material in those areas would result in the cap being above elevation 105.2'. To avoid this situation we agreed that Type N stone could be placed to supplement areas where type O stone had already been placed.

Please let me know if I missed anything.

Thanks,

Andrew A. Inglis
Dredging Task Leader
GE

T +1 518-746-5256

381 Broadway
Building 40-2
Fort Edward, NY 12828
GE Corporate Environmental Programs

GE Imagination at Work

Galbraith, Michael

From: King.David@epamail.epa.gov
Sent: Saturday, November 14, 2009 9:36 AM
To: Andrew Inglis
Cc: Michael J. Johnson; Timothy Kruppenbacher; Galbraith, Michael; Bryan Minor; Gary Klawinski; Joseph Moloughney
Subject: Re: Discussions regarding CU Backfill and Cap placement

Andrew, I agree with summary.

Dave

Sent by EPA Wireless E-Mail Services

From: "Inglis, Andrew A (GE, Corporate)" [andrew.inglis@ge.com]
Sent: 11/13/2009 05:13 PM EST
To: David King
Cc: <MJohnson@louisberger.com>; "Kruppenbacher, Timothy A (GE, Corporate)" <timothy.kruppenbacher@ge.com>; <michael.galbraith@parsons.com>; <USACE_HRFO@roadrunner.com>; <GKlawinski@ene.com>; "Joseph Moloughney" <Joseph_Moloughney@canals.state.ny.us>
Subject: Discussions regarding CU Backfill and Cap placement

Dave,

Today and yesterday we met and reviewed progress surveys of cap and backfill placement in CUs 1, 2, 3, 4, 7 and 18. This email confirms decisions made during the meeting based on reviews of the maps presented during the meeting.

CU1.

In CU1 it was agreed that sufficient thickness of isolation layer material has been placed while providing enough room to place armor stone below the 105.2' elevation in the navigation channel. It was agreed that placement of armor stone can begin.

CU2.

In CU2 it was agreed that the top of cap and backfill elevations were acceptable. GE will prepare a Form 2 package for EPA review.

CU3 .

In CU3 it was agreed that the top of cap and backfill elevations were acceptable, it was discussed that GE was in the process of placing backfill in an area of the navigation channel where the post dredge elevations were below 102' elevation. Once GE has surveyed that additional backfill location GE will prepare a Form 2 package for EPA review.

CU4.

In CU4 it was agreed that the top of cap elevations in the north east quarter of the CU was acceptable and that backfill placement in that area may begin.

CU7.

In CU7 it was agreed that the top of cap and backfill elevations were acceptable. GE will prepare a Form 2 package for EPA review.

CU18

In CU18 it was agreed that the top of cap elevations were acceptable in both of the cap locations in that CU.

Please let me know if I missed anything.

Thanks,

Andrew A. Inglis
Dredging Task Leader
GE

T +1 518-746-5256

381 Broadway
Building 40-2
Fort Edward, NY 12828
GE Corporate Environmental Programs

GE Imagination at Work