

EXHIBIT A

1044086

- LEGEND**
- o - VALVE
 - - PUMP
 - - FILTER
 - a - CENTRIFUGE
 - b - FILTER SYSTEM
 - c - HEATER
 - △ - FIRE EXTINGUISHERS
- BLUE LINES - TREATED WATER TO POTW
 BLACK LINES - FLOC TRANSFER
 GREEN LINES - UNTREATED WATER TRANSFER
 RED LINES - OIL PROCESS TRANSFER
 PURPLE LINES - CHEMICAL FEED

REVISED and UPDATED
 March 30, 1994
 REVISED and UPDATED
 March 20, 1995

RECEIVED
 MAR 30 1994
 Industrial Pre-treatment

RECEIVED
 MAR 30 1994
 Industrial Pre-treatment

(PROPOSED)


SLUDGE (PROPOSED) RECEIVING

WATER (PROPOSED) FROM FILTER PRESS

SLUDGE (PROPOSED) FILTER PRESS

RECEIVED
 MAR 30 1994
 Industrial Pre-treatment

REVISED and UPDATED
 March 20, 1994

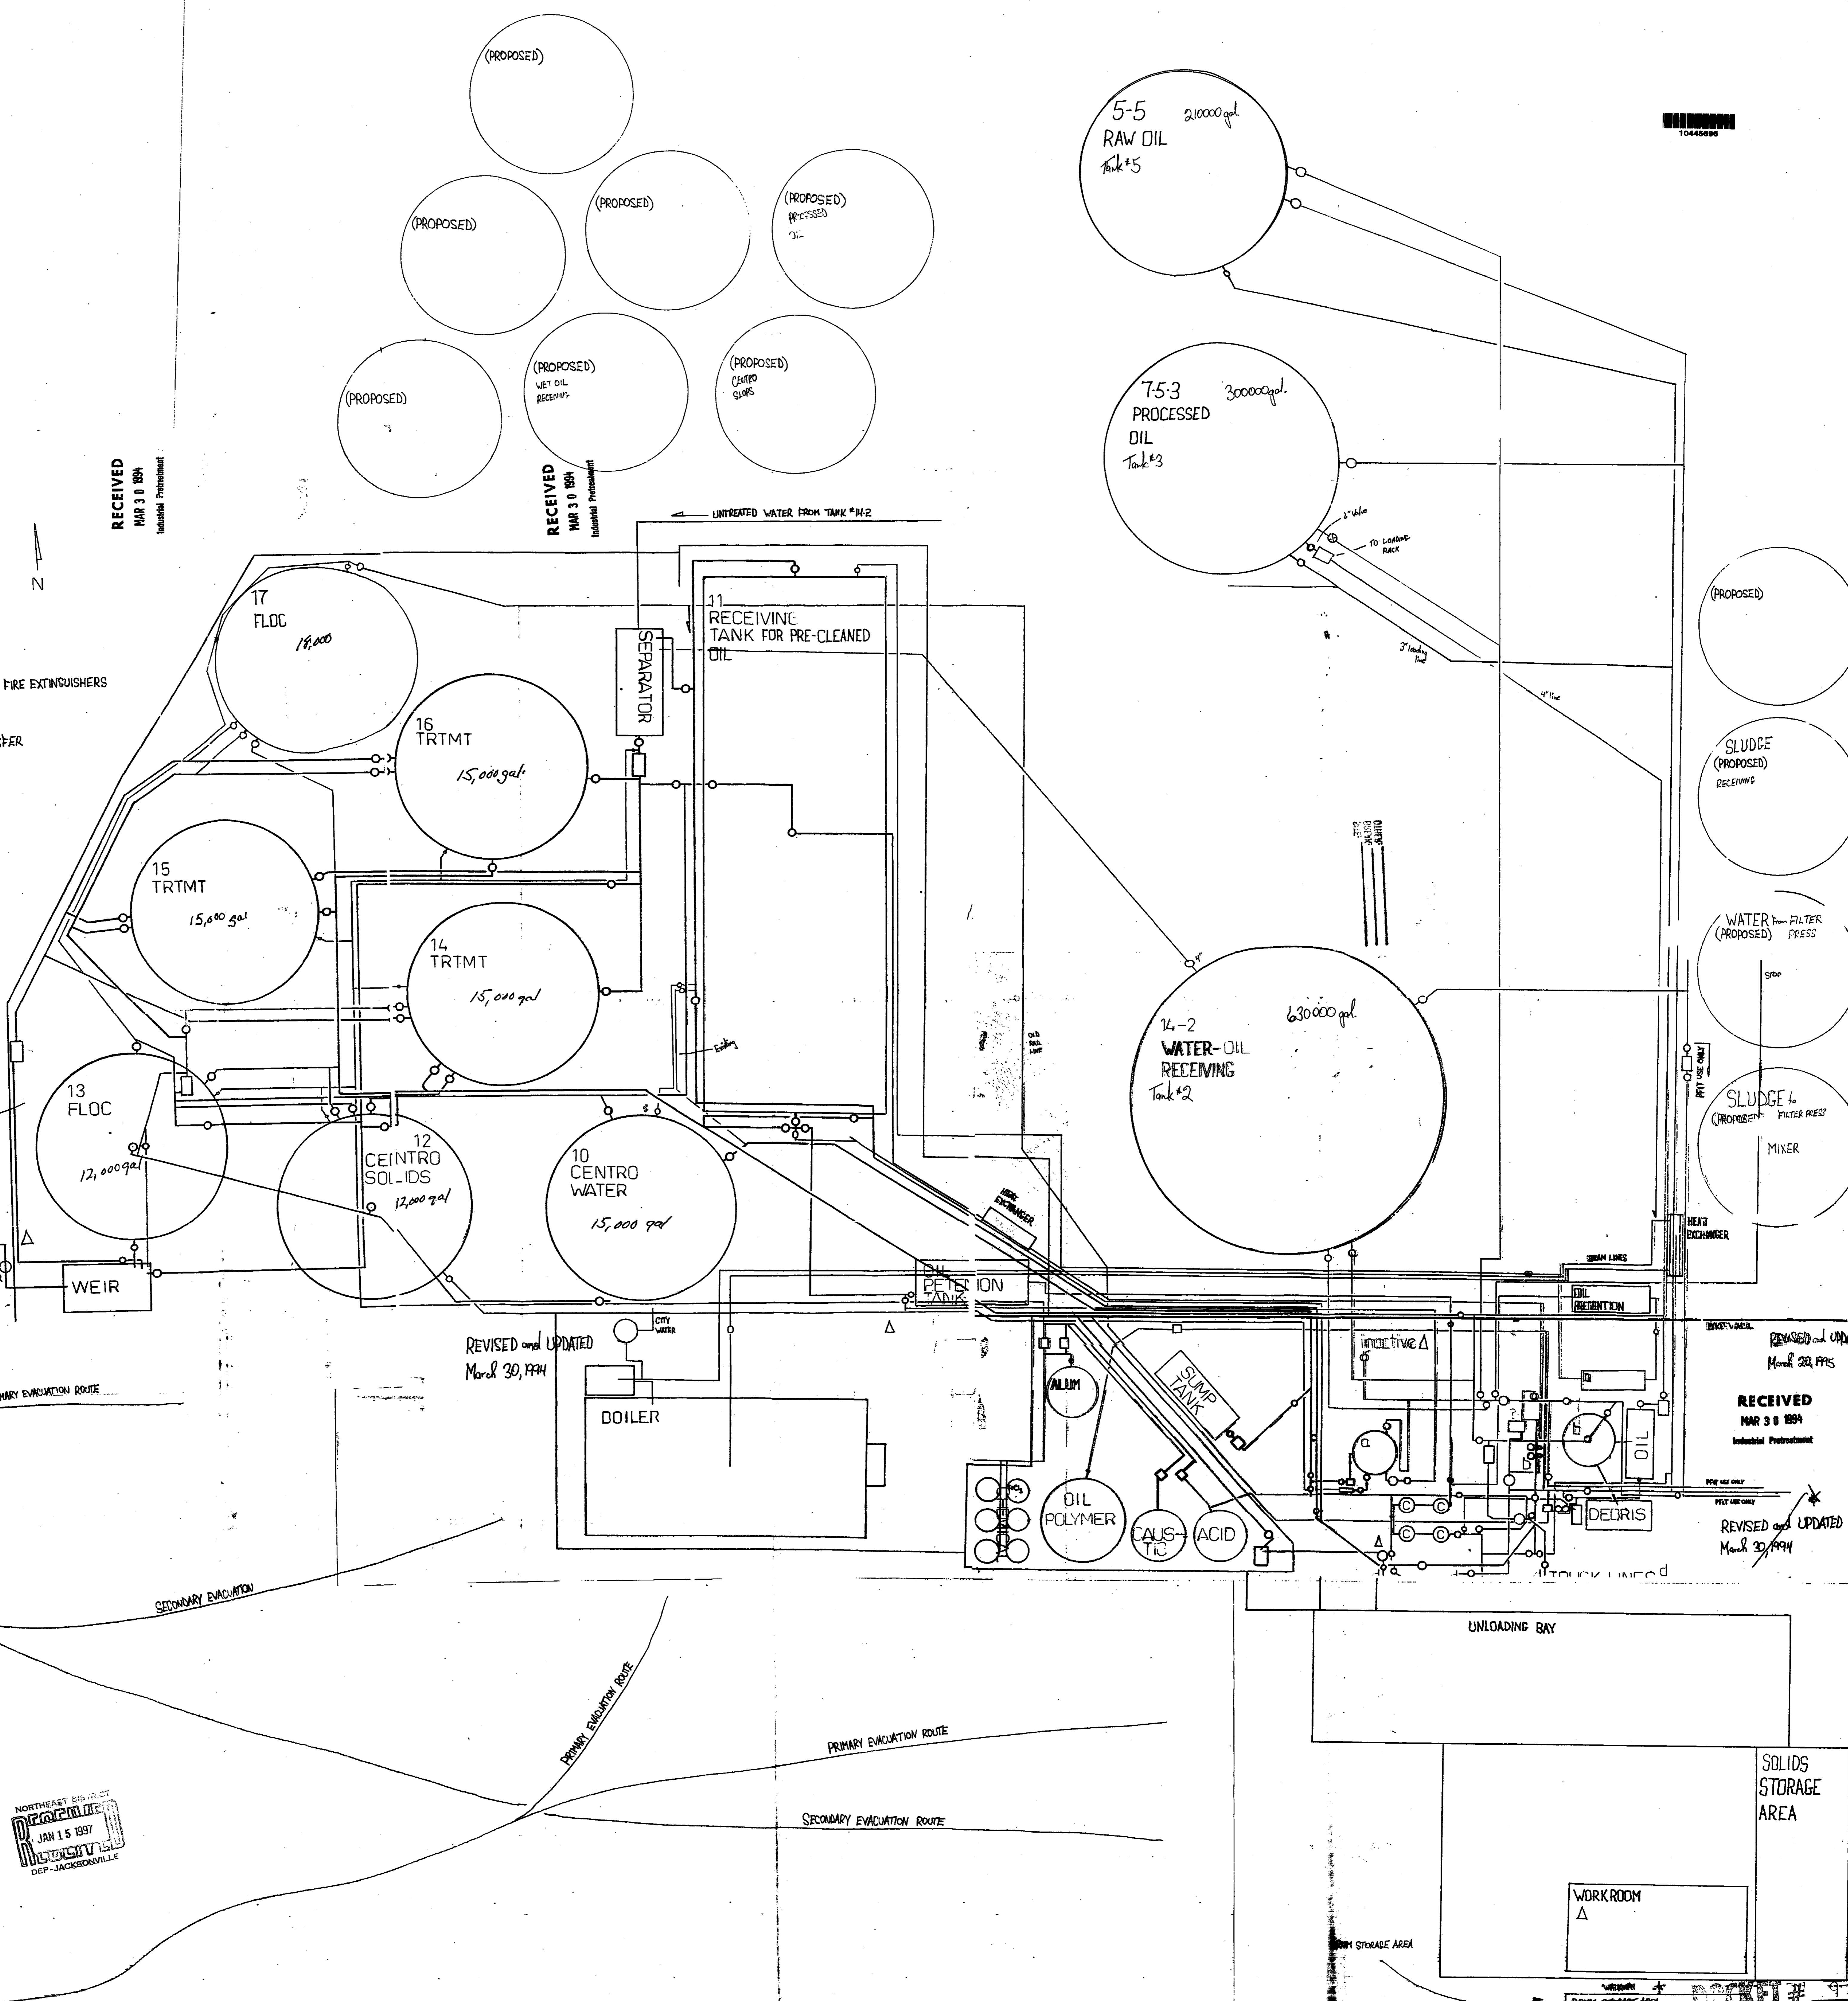

NORTHEAST DISTRICT
 RECEIVED
 JAN 15 1997
 RECEIVED
 DEP - JACKSONVILLE

EXHIBIT A

IP

USE

DRUM STORAGE AREA DOCKET # 971