

AECOM 100 S. Wacker Drive, Suite 500 Chicago, Illinois 60606 312-939-1000 tel 312-939-4198 fax

June 1, 2016

Mr. Mike Jasek Project Manager, Lakefront Trail Improvement F.H. Paschen 5515 N. East River Road Chicago, IL 60656

RE: Radiological Survey Results – 14th Letter Report

Navy Pier Flyover / Lakefront Trail Improvement

AECOM Project No. 60318016

Dear Mr. Jasek:

Pursuant to requirements of the United States Environmental Protection Agency (USEPA) and conditions specified in permits issued by the City of Chicago Department of Public Health (CDPH), radiation monitoring is required to be performed for the above referenced project when construction activities will disturb fill soil that has not been previously screened for thorium. AECOM Technical Services, Inc. (AECOM) has been contracted to provide the required radiation surveillance and reporting.

The last progress report (dated February 24, 2016) provided notification that screening activities would be conducted intermittently given that excavation activities requiring monitoring are occurring infrequently (i.e., construction activities are focusing on above grade structures). Discussed below are the construction related excavation screening activities performed between February 24, 2016 and June 1, 2016.

Lake Shore Drive and Grand Ave. \ E. Illinois Ave.

AECOM conducted radiological survey for the soil excavation activities conducted to install street light foundations at the northeast junctions of Lake Shore Drive (LSD) and East Grand Ave and the northwest junction of LSD and E. Illinois St., Chicago, Illinois. Additional, electrical trench excavation activities occurred near the southeast junctions of LSD and E. Illinois St. extending to the southwest for approximately 115 feet. The surveying was completed on March 22 and 23, 2016. The street light foundation excavations were approximately 3 to 5-feet in length and width, to a depth of 3-feet and 7-feet below ground surface (bgs). The additional electrical trench excavation included an excavation of 10-feet long by 10-feet wide to a depth of 3-feet bgs and an adjoining trench approximately 115-feet long, 2-feet wide, to a depth of 18 to 25-inches (refer to attached sketch).

The gamma survey did not indicate that the fill soils were above the removal action level established by the USEPA for the Streeterville area of Chicago. The USEPA removal action level for Chicago's Streeterville area is 7.1 picocuries per gram (pCi/g) total radium (Ra-226 + Ra-228). Gamma radiation count measurements for the irrigation trench were made using Ludlum Model 2221 survey meter and an unshielded 2 x 2 inch Nal probe (Model 44-10). For the instrument used on March 22 and 23, 2016 the gamma count threshold indicative of the 7.1 pCi/g removal action level was 17,015 counts per minute (cpm) unshielded and 6,684 cpm shielded (S/N: 172039).

The field gamma measurements within the excavation, and of the spoil, during the excavation process did not exceed the instrument threshold previously stated and unshielded readings ranged from a minimum of 4,600 cpm to a maximum of 14,200 cpm unshielded and shielded readings ranged from a minimum of 1,800 cpm to 2,680 cpm. Based on field observations there was no indication of the presence of radiologically-contaminated material and/or an exceedance of the USEPA removal action level of 7.1 pCi/g total radium. A copy of a field sketch documenting the area where work was performed is included as an attachment.

Lake Shore Drive Off-Ramp and River Walk

Surveying was performed on the soil excavated, east of (refer to the attached sketch) Lake Shore Drive Off-ramp (onto E. Illinois Ave.) and north of the adjacent River Walk, required to address trench excavation for electrical line connections. The radiological survey was conducted on March 28, 2016. The excavation included two perpendicular excavations, east-to-west trench was approximately 18-feet long, 6-feet wide, to a depth of 4.5-feet bgs, and the perpendicular north-to-south trench was approximately 13-feet long, 3-feet wide, to a depth of 3-feet bgs.

The monitoring results did not indicate that the fill soils were above the removal action level established by the USEPA for the Streeterville area of Chicago (7.1 picocuries pCi/g) total radium. Gamma radiation count measurements for the foundation excavation were recorded using Ludlum Models 2221 survey meter (S/N: 172039) and an unshielded 2 x 2 inch Nal probe (Model 44-10). For the instrument used, the gamma count threshold indicative of the 7.1 pCi/g removal action level was 17,015 counts per minute (cpm) unshielded.

The field gamma measurements within the excavation, and of the spoil, during the excavation process did not exceed the instrument threshold previously stated and ranged from a minimum of 6,100 cpm to a maximum of 12,900 cpm unshielded. Based on field observations there was no indication of the presence of radiologically-contaminated material and/or an exceedance of the USEPA removal action level of 7.1 pCi/g total radium. A copy of a field sketch documenting the area where work was performed is included as an attachment.

Central Sprinkler Water Line

AECOM conducted radiological survey for the soil excavation activities conducted to address a water line connection south of E. Illinois Ave. and west of N. Streeter Dr., Chicago, Illinois. The surveying was completed on April 4, 5, 6, and 7, 2016. The excavation was approximately 135-feet long, 4-feet wide, to a depth of 5 to 7-feet deep bgs.

The monitoring results did not indicate that the fill soils were above the removal action level established by the USEPA for the Streeterville area of Chicago (7.1 picocuries pCi/g) total radium. Gamma radiation count measurements for the foundation excavation were recorded using Ludlum Models 2221 survey meter (S/N: 172039) and an unshielded 2 x 2 inch Nal probe (Model 44-10). For the instrument used, the gamma count threshold indicative of the 7.1 pCi/g removal action level was 17,015 counts per minute (cpm) unshielded.

The field gamma measurements within the excavation, and of the spoil, during the excavation process did not exceed the instrument threshold previously stated and ranged from a minimum of 4,200 cpm to a maximum of 10,500 cpm unshielded. Based on field observations there was no indication of the presence of radiologically-contaminated material and/or an exceedance of the USEPA removal action level of 7.1 pCi/g total radium. A copy of a field sketch documenting the area where work was performed is included as an attachment.

Asphalt Removal

Radiological survey was conducted for soil excavation activities to address asphalt removal north of E. Grand Ave. and east of LSD on-ramp., and an additional area south of E. Illinois St. and west of N. Streeter Dr., Chicago, Illinois. The surveying was completed on April 5, 6, and 11, 2016. Asphalt removal, northeast of the intersection of E. Grand St. and LSD northbound on-ramp, was approximately 200-feet long and 20 to 40-feet wide. Asphalt removal south of E. Illinois St. was approximately 460-feet long and 16-feet wide (refer to attached sketch). The asphalt removal conducted did not included vertical excavations other than the removal of asphalt itself.

Navy Pier Flyover/Lakefront Trail Improvement 14th Letter Report Page 3

The monitoring results did not indicate that the fill soils were above the removal action level established by the USEPA for the Streeterville area of Chicago (7.1 picocuries pCi/g) total radium. Gamma radiation count measurements for the foundation excavation were recorded using Ludlum Models 2221 survey meter (S/N: 172039) and an unshielded 2 x 2 inch Nal probe (Model 44-10). For the instrument used, the gamma count threshold indicative of the 7.1 pCi/g removal action level was 17,015 cpm, unshielded.

The field gamma measurements within the excavation, and of the spoil, during the excavation process did not exceed the instrument threshold previously stated and ranged from a minimum of 4,200 cpm to a maximum of 9,500 cpm unshielded. Based on field observations there was no indication of the presence of radiologically-contaminated material and/or an exceedance of the USEPA removal action level of 7.1 pCi/g total radium. A copy of a field sketch documenting the area where work was performed is included as an attachment.

Steven C. Kornder, Ph.D.

Senior Project Geochemist

Please contact us with any questions you have regarding this letter or the reported results.

Regards,

Andrew Kozak Staff Geologist

cc: Michael Herbert, F.H. Paschen


Attachments: Sketches

LIGHTE FOUNDATION EXCAVATION SKETCHES

JOBTITLE Flyover - Lake Share Di	the & Grand Ave. E. Illinois the.
JOB NO. 603 18016	CALCULATION NO.
ORIGINATOR Andrew Kozak	DATE
REVIEWER Steve Koruder	DATE 4/22/16
SCALF.	SHEET NO. OF 2


	SCALE		SHEET NO	OF	
robe ZxZ NaI uush shi	S/N: 172039 S/N: 174496 cielded: 17,015 cpu delded: 6,684 cpu round: 2,700cpm (,			N
Lake shore Druc - On ramp (north-bound)	exavolion (#1)	<- Lake shake Drive (Lower) ->	E. Illin		s' /// excavation
Readings Am	ea # 1		Readings	Hea # 2	
Depth surface 1'-2' 2'-4' 4-7'	2,000-2,400 2,000-2,400 1,800-2,400 2,100-2,600		Dopk surface 12" 30"	4,600	-4,600 -6,500 -5,900

JOB TITLE	Flyover - Lake Share	Drive & Grand Ave. E. Illinois Ave
	603/80/6	CALCULATION NO
ORIGINATOR	Andrew Kozak	DATE 3/23/16
REVIEWER	Steve Kounder	DATE 4/22//6
SCALE		SHEET NO. Z OF Z

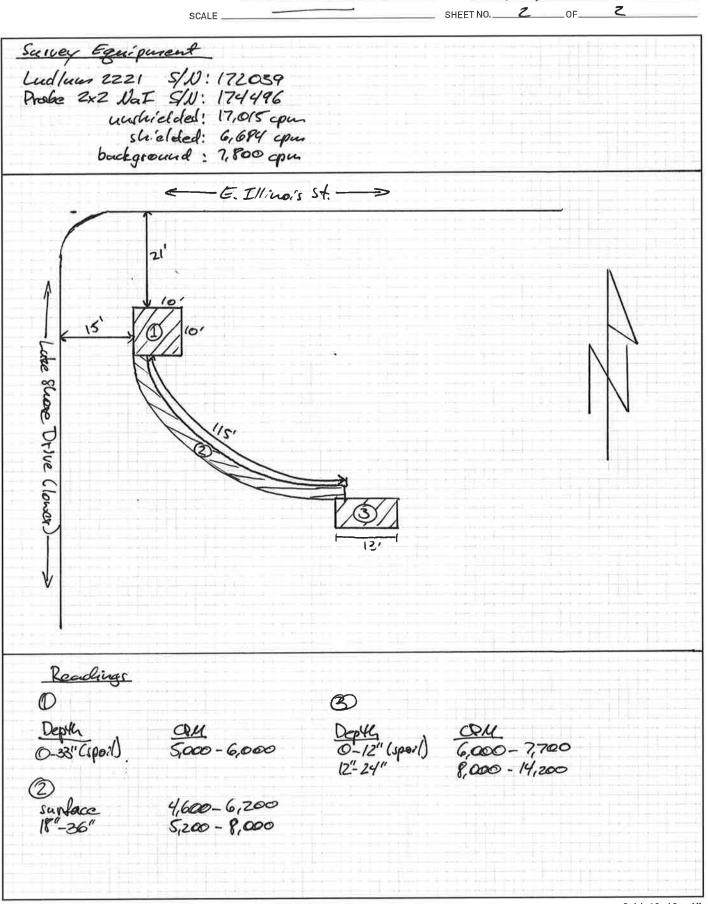


ELECTRICAL TRENCH EXCAVATION SKETCH

JOBTITLE Flyour - Lake Shore	Drove Off-ramp & Kiver Walk
JOB NO. 603/80/6	CALCULATION NO.
ORIGINATOR Andrew Kozak	DATE 3/28/16
REVIEWER Steve Kornder	DATE 4/22/16
SCALE	SHEET NO. / OF /

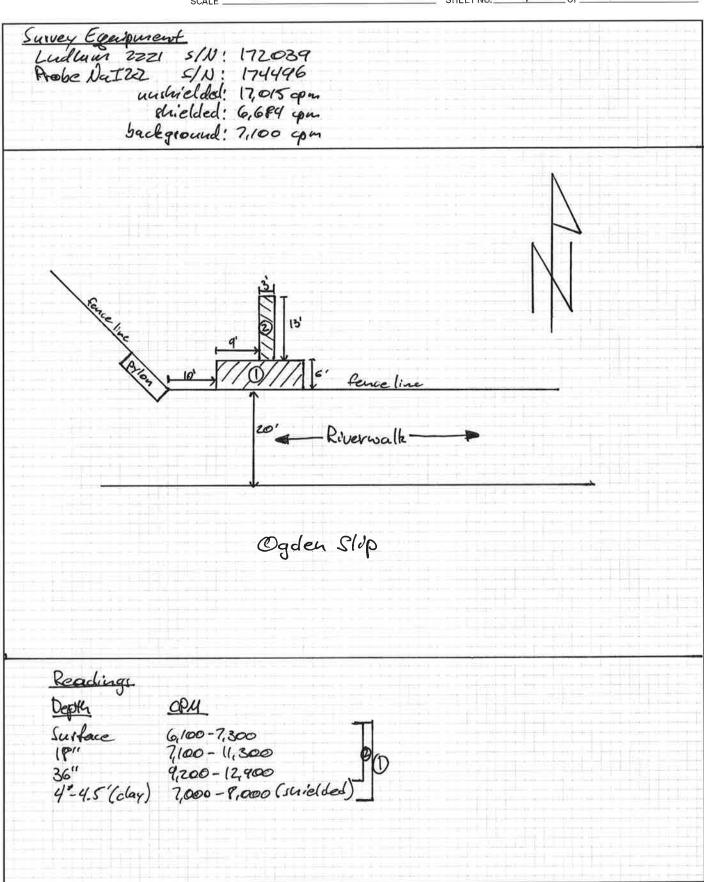

WATER LINE SKETCH

JOBTITLE Flyover - Central	Sproutler
JOB NO. 60318016	CALCULATION NO
ORIGINATOR <u>Andrew Kozak</u>	DATE 4/4, 4/5, 4/6, 4/7
REVIEWER Steve Kornder	DATE 4/22/16
SCALE	SHEET NO / OF

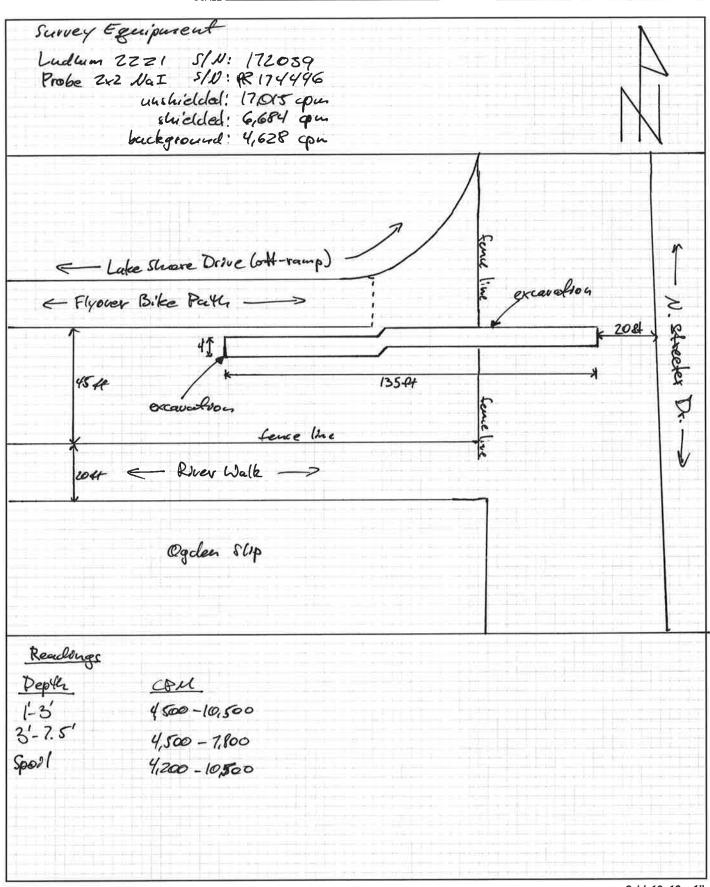

ASPHALT REMOVAL SKETCH

JOB NO. 60318016	roud
JOB NO. 60318016	CALCULATION NO.
ORIGINATOR Andrew Kozak	DATE 4/5, 4/6, 4/11
REVIEWER Steve Kornder	DATE 4/22/16
SCALE	SHEET NO OF

