

CU-03

Form 2

CU Certification of Completion

CU BACKFILL/ENGINEERED CAP COMPLETION APPROVAL - FORM 2						
Reporting Date	11/19/2009				Placement Start Date	10/15/2009
CU Number	3				Placement End Date	11/10/2009
Approximate CU Centroid	Northing	1614048	Easting	736253	NY State NAD 83	
CU Size	4.87	Acres				
Backfill Area	3.55	Acres*				
Cap Area	1.32	Acres				
Backfill Surface Mean Tri+ PCBs Concentration (when required)		NA		mg/kg		
Number of nodes sampled		NA		mg/kg		
Backfill X	Type of Backfill Type 1, Type 2, Nearshore, 15%	Reference to appropriate drawings attached to Approval Form 1 CU3 Backfill and Cap Plan, 10/13/09				
Cap X	Type of Cap Type "A" Low Velocity Cap and Type "A" Medium to High Velocity Cap	Reference to appropriate drawings attached to Approval Form 1 CU3 Backfill and Cap Plan, 10/13/09				
CU Checklist		Indicate one of the following			Reviewer Initial Acceptance	
Item	Attached	Not Applicable	GE	EPA		
Drawing of Installed Backfill/Cap (with record details, thickness and sample locations [when backfill/cap are placed])	x					
Where applicable in backfill areas provide the following: Sample locations (coordinates), depths, Aroclor and Tri+ PCB concentrations collected including analytical data, field observations, (hard copy and electronic copies [in database format or equivalent])		x				
Comments						
Refer to attached Narrative Backfill and Capping Summary and CU 3 Backfill and Cap Drawings. *Backfill Area does not include 15% backfill material placed over Cap Area.						
Upon signing this document, GE certifies that the backfill/cap has been installed satisfactorily and that no further backfill placement or capping is required for this CU. These remedial activities exclude long term operation, monitoring, maintenance and adaptive management at the CU. EPA accepts this certification.						
Signature of GE Representative			Signature of EPA Representative			
Signature _____			Signature _____			
Name _____			Name _____			
Date _____			Date _____			

Narrative

CU 3

Narrative Summary of Backfill and Capping and EPA Backfill and Capping Agreements

1.0 Cap Placement

A Type "A" Medium to High Velocity Cap and a Type "A" Low Velocity Cap was placed in accordance with the CU 3 Backfill and Capping Plan Drawing, dated October 13, 2009, which was provided to EPA as part of the CU 3 Form 1 package. A multi-beam bathymetric survey of the CU 3 cap was performed after final cap placement on October 28 and November 8, 2009, as shown on the attached CU 3 Type "A" Cap Acceptance Survey, dated November 17, 2009. The surveyed cap thickness on a 5' x 5' grid is shown for all cap areas. Cap thicknesses for the Type "A" Low Velocity Cap at the shoreline near station 33+00 is not shown, as the cap was installed within the near shore boundary where multi-beam data could not be obtained. Type 1 near shore material was placed over this cap.

2.0 Backfill Placement

Backfill materials were placed in accordance with the CU 3 Backfill and Capping Plan Drawing, dated October 13, 2009, provided to EPA as part of the CU 3 Form 1 package. Multi-beam bathymetric surveys for CU 3 were performed after backfill placement on November 8 and November 12, 2009, as shown on the attached CU 3 Backfill Placement Acceptance Drawing, dated November 17, 2009. The difference to backfill prism on a 10' x 10' grid is shown for all backfill areas. The elevations within the Navigation Channel on a 10' x 10' grid are shown on the attached CU3 Navigation Channel Elevations, dated November 17, 2009.

3.0 EPA Field Agreements Specific to CU 3 Backfill and Capping

1. During the 4:00 PM meeting on October 12, 2009, EPA agreed that acceptance surveys of partial areas of a CU may be performed and used for acceptance once placement of backfill or cap in those areas is complete.
2. The plan used to place backfill and cap in CU 3 was approved by EPA on October 13, 2009 as part of the CU 3 Acceptance Form 1 package. Changes were made to the CU 3 Backfill and Cap Plan on November 10, 2009 to show the near shore set points, and the 5' offset of the cap extending into compliant areas (see CU 3 Backfill and Cap Record Drawing, dated November 19, 2009).
3. During a 3:00 PM meeting with EPA on November 12, 2009, GE presented acceptance surveys of the difference to backfill prisms on a 10' x 10' grid in CU3. GE also presented the

Cap Acceptance Survey Drawing during the meeting of November 12, 2009. EPA accepted that the top of cap and backfill elevations were acceptable (see attached e-mail, dated November 14, 2009). The CU3 Type "A" Cap Acceptance Survey Drawing, dated November 17, 2009 is included in this package.

Tables


Table 1. CU-3 - All Near-Shore Topographic Measurements

Published Near-Shore Border Set Points				Near-Shore Topographic Measurements				
Name	Easting	Northing	Target Elevation	Easting	Northing	Check Elevation	Horz. Dist	Vert Diff.
3-1	736,296.72	1,614,412.28	117.5	736,296.73	1,614,411.95	117.59	0.33	0.09
3-2	736,314.60	1,614,313.18	117.5	736,314.73	1,614,313.15	116.51	0.13	-0.99
				736,314.37	1,614,312.36	116.37	0.85	-1.13
				736,316.98	1,614,313.70	116.84	2.43	-0.66
				736,319.50	1,614,313.66	117.35	4.92	-0.15
				736,322.56	1,614,313.83	118.37	7.99	0.86
				736,325.84	1,614,314.08	118.86	11.28	1.36
				736,328.03	1,614,314.38	118.77	13.48	1.27
				736,328.14	1,614,315.89	118.95	13.80	1.45
3-3	736,335.34	1,614,216.00	117.5	736,335.37	1,614,215.73	117.11	0.27	-0.39
3-4	736,348.58	1,614,117.42	117.5	736,348.62	1,614,117.38	117.68	0.05	0.18
3-5	736,366.73	1,614,018.36	117.5	736,366.94	1,614,018.36	117.41	0.21	-0.09
3-6	736,381.73	1,613,919.61	117.5	736,381.81	1,613,919.38	117.25	0.24	-0.25
3-7	736,389.45	1,613,819.80	117.5	736,389.59	1,613,819.96	117.04	0.21	-0.46
3-8	736,398.73	1,613,763.17	117.5	736,398.51	1,613,763.06	116.17	0.25	-1.33
				736,400.46	1,613,764.06	116.99	1.94	-0.51
				736,401.69	1,613,764.17	117.43	3.13	-0.07
				736,395.60	1,613,763.06	115.77	3.13	-1.73
				736,404.77	1,613,764.37	117.68	6.16	0.17
				736,406.37	1,613,762.89	117.87	7.64	0.37
				736,411.18	1,613,761.72	118.17	12.54	0.67
				736,413.98	1,613,761.12	118.20	15.39	0.70
				736,415.53	1,613,761.02	118.22	16.93	0.72
				736,418.58	1,613,761.12	118.62	19.95	1.12
				736,420.27	1,613,760.65	119.04	21.69	1.54
3-9	736,397.62	1,613,663.54	117.5	736,397.32	1,613,663.40	117.19	0.33	-0.31
3-10	736,067.36	1,614,359.93	117.5	736,067.34	1,614,360.13	118.50	0.20	1.00
				736,064.88	1,614,359.71	118.86	0.22	1.36
				736,067.03	1,614,360.21	118.45	0.28	0.95
				736,064.88	1,614,359.23	118.93	0.70	1.43
				736,069.99	1,614,360.84	117.22	0.91	-0.28
				736,072.16	1,614,361.69	116.22	1.76	-1.28
3-11	736,089.25	1,614,269.50	117.5	736,089.45	1,614,269.49	117.84	0.20	0.34
3-12	736,104.12	1,614,178.18	117.5	736,104.08	1,614,178.11	118.56	0.08	1.06
				736,103.94	1,614,178.13	118.90	0.19	1.40
				736,106.28	1,614,178.71	117.82	2.22	0.32
3-13	736,121.03	1,614,087.37	117.5	736,120.92	1,614,087.30	119.05	0.13	1.55
				736,121.36	1,614,087.65	118.78	0.44	1.28
				736,123.01	1,614,087.32	118.49	1.98	0.99
				736,124.19	1,614,087.57	117.66	3.16	0.16
				736,126.18	1,614,088.21	116.69	5.22	-0.81
3-14	736,137.26	1,614,010.52	117.5	736,136.89	1,614,010.58	119.12	0.38	1.61
				736,138.77	1,614,010.54	118.41	1.51	0.91
				736,140.61	1,614,010.76	117.28	3.36	-0.22
				736,142.93	1,614,010.74	116.33	5.67	-1.17
3-15	736,148.76	1,613,914.92	117.5	736,148.31	1,613,914.84	118.89	0.46	1.39
				736,145.99	1,613,914.31	119.14	2.84	1.64
				736,151.94	1,613,916.13	117.43	3.41	-0.07
3-16	736,163.48	1,613,828.29	117.5	736,163.57	1,613,828.41	118.42	0.15	0.92
				736,165.18	1,613,828.68	117.23	1.74	-0.27
				736,158.75	1,613,828.03	119.09	4.74	1.59
3-17	736,179.04	1,613,731.04	117.5	736,178.80	1,613,731.32	116.06	0.37	-1.44
				736,176.93	1,613,731.29	116.58	2.12	-0.92
				736,175.21	1,613,731.24	117.59	3.83	0.09
				736,172.47	1,613,730.53	118.83	6.59	1.33
				736,169.81	1,613,730.57	119.17	9.24	1.67
3-18	736,188.70	1,613,634.17	117.5	736,188.82	1,613,633.70	117.96	0.48	0.46



Notes:

1. Measurements Collected on the 11th and 12th of November 2009 using standard land survey methods
2. At near shore set point locations where the set point elevation was not at tolerance, additional measurements were taken at nearby locations to provide additional information.



Figures

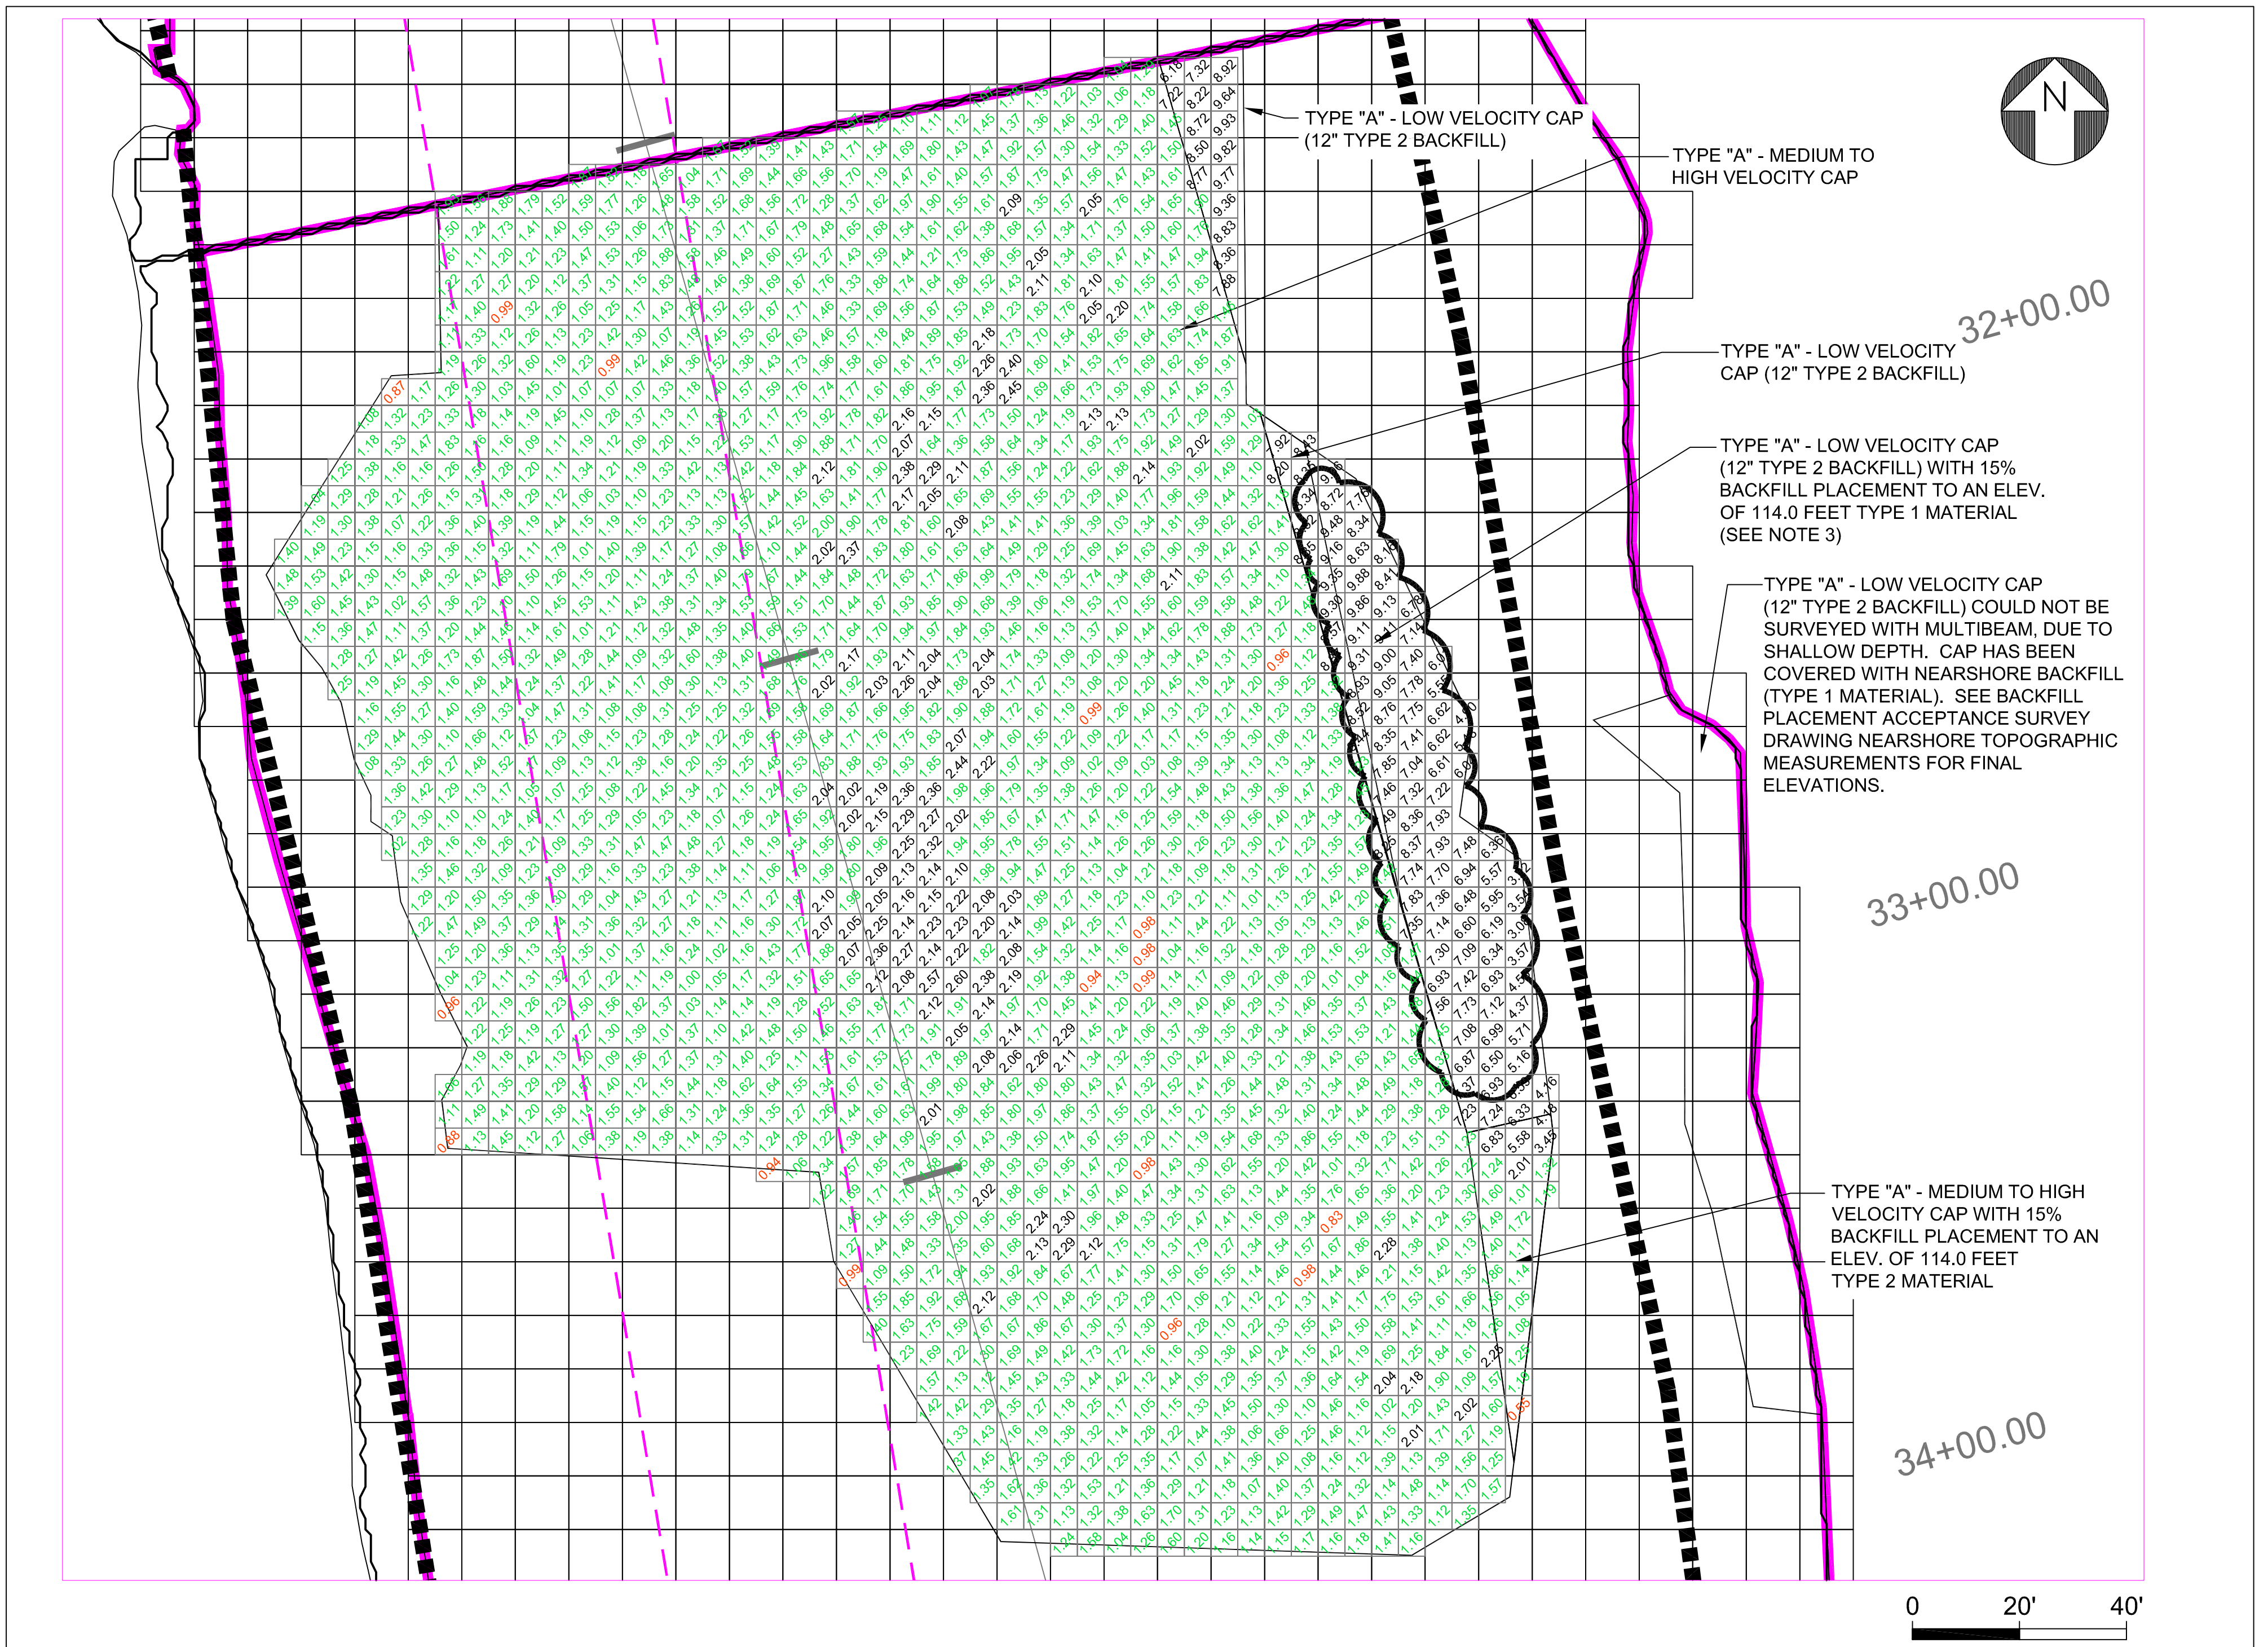


CU3 TYPE "A" CAP PLACEMENT

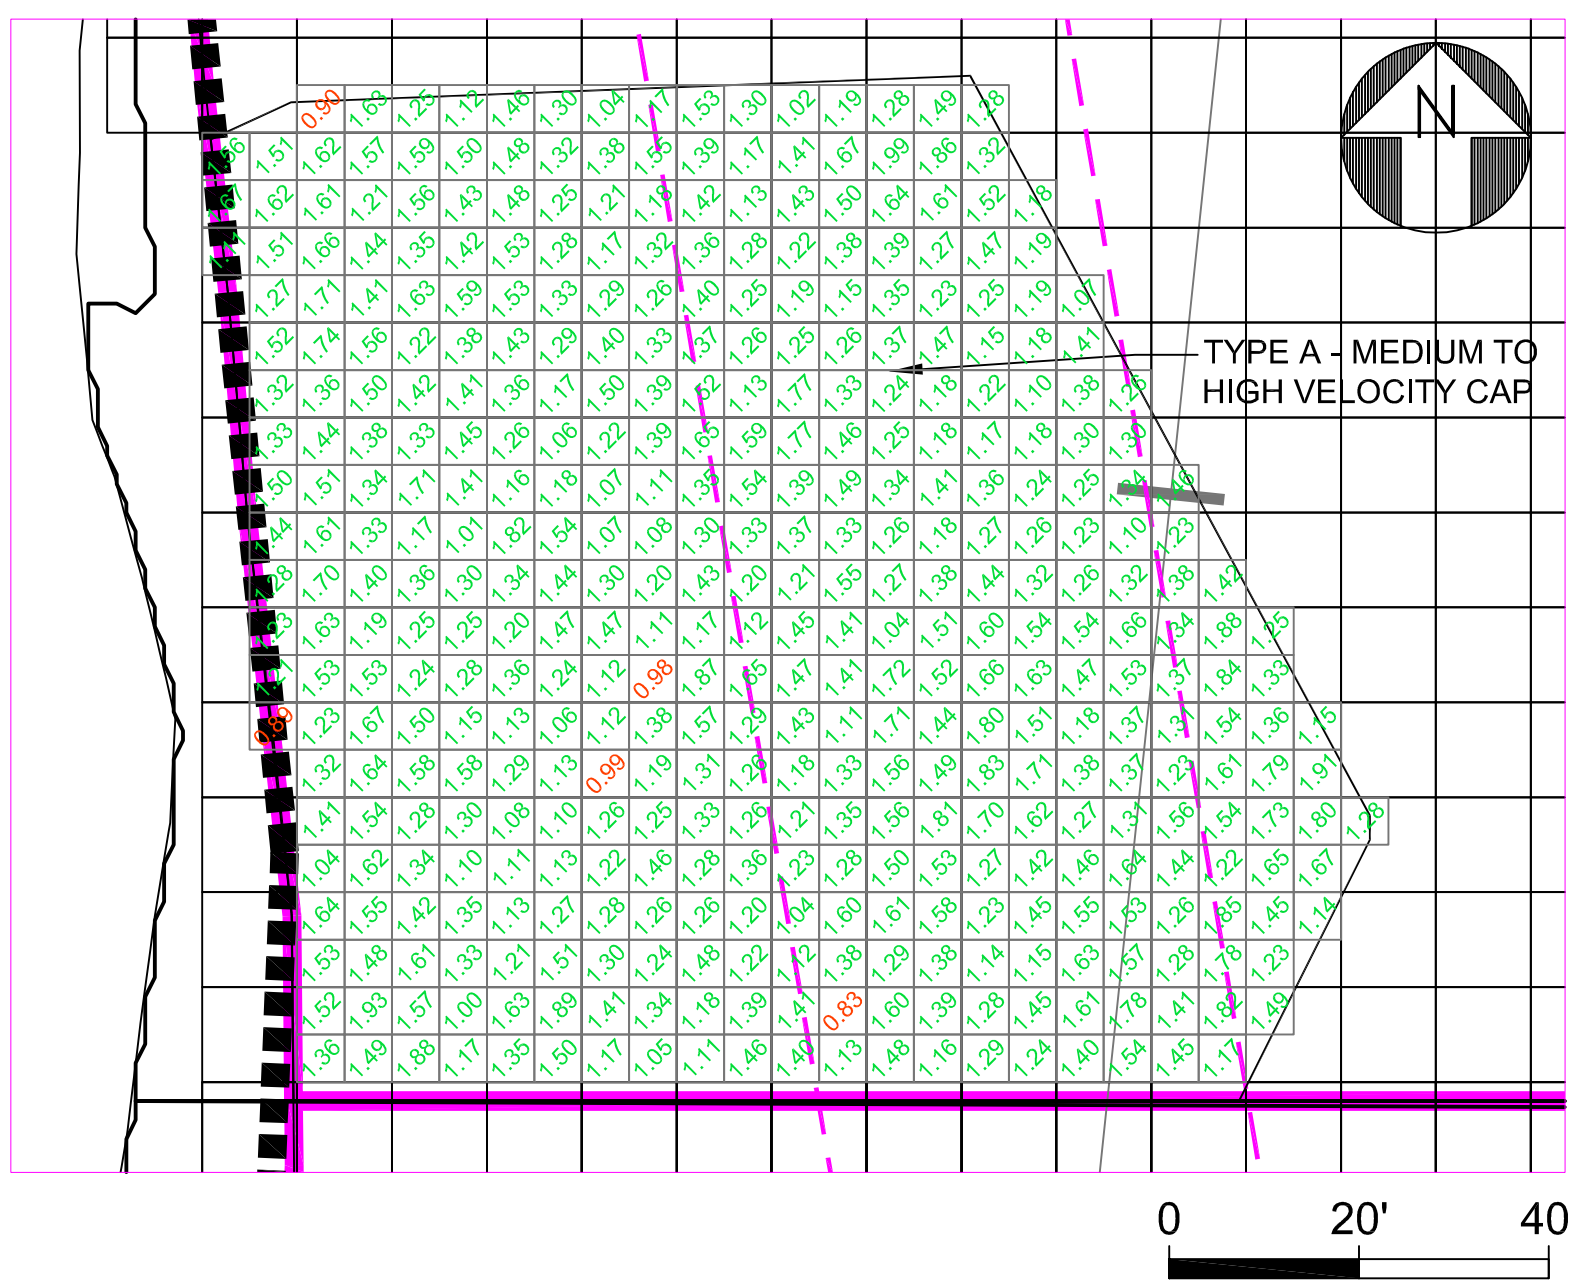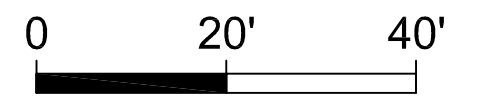

CU3 TYPE "A" CAP PLACEMENT

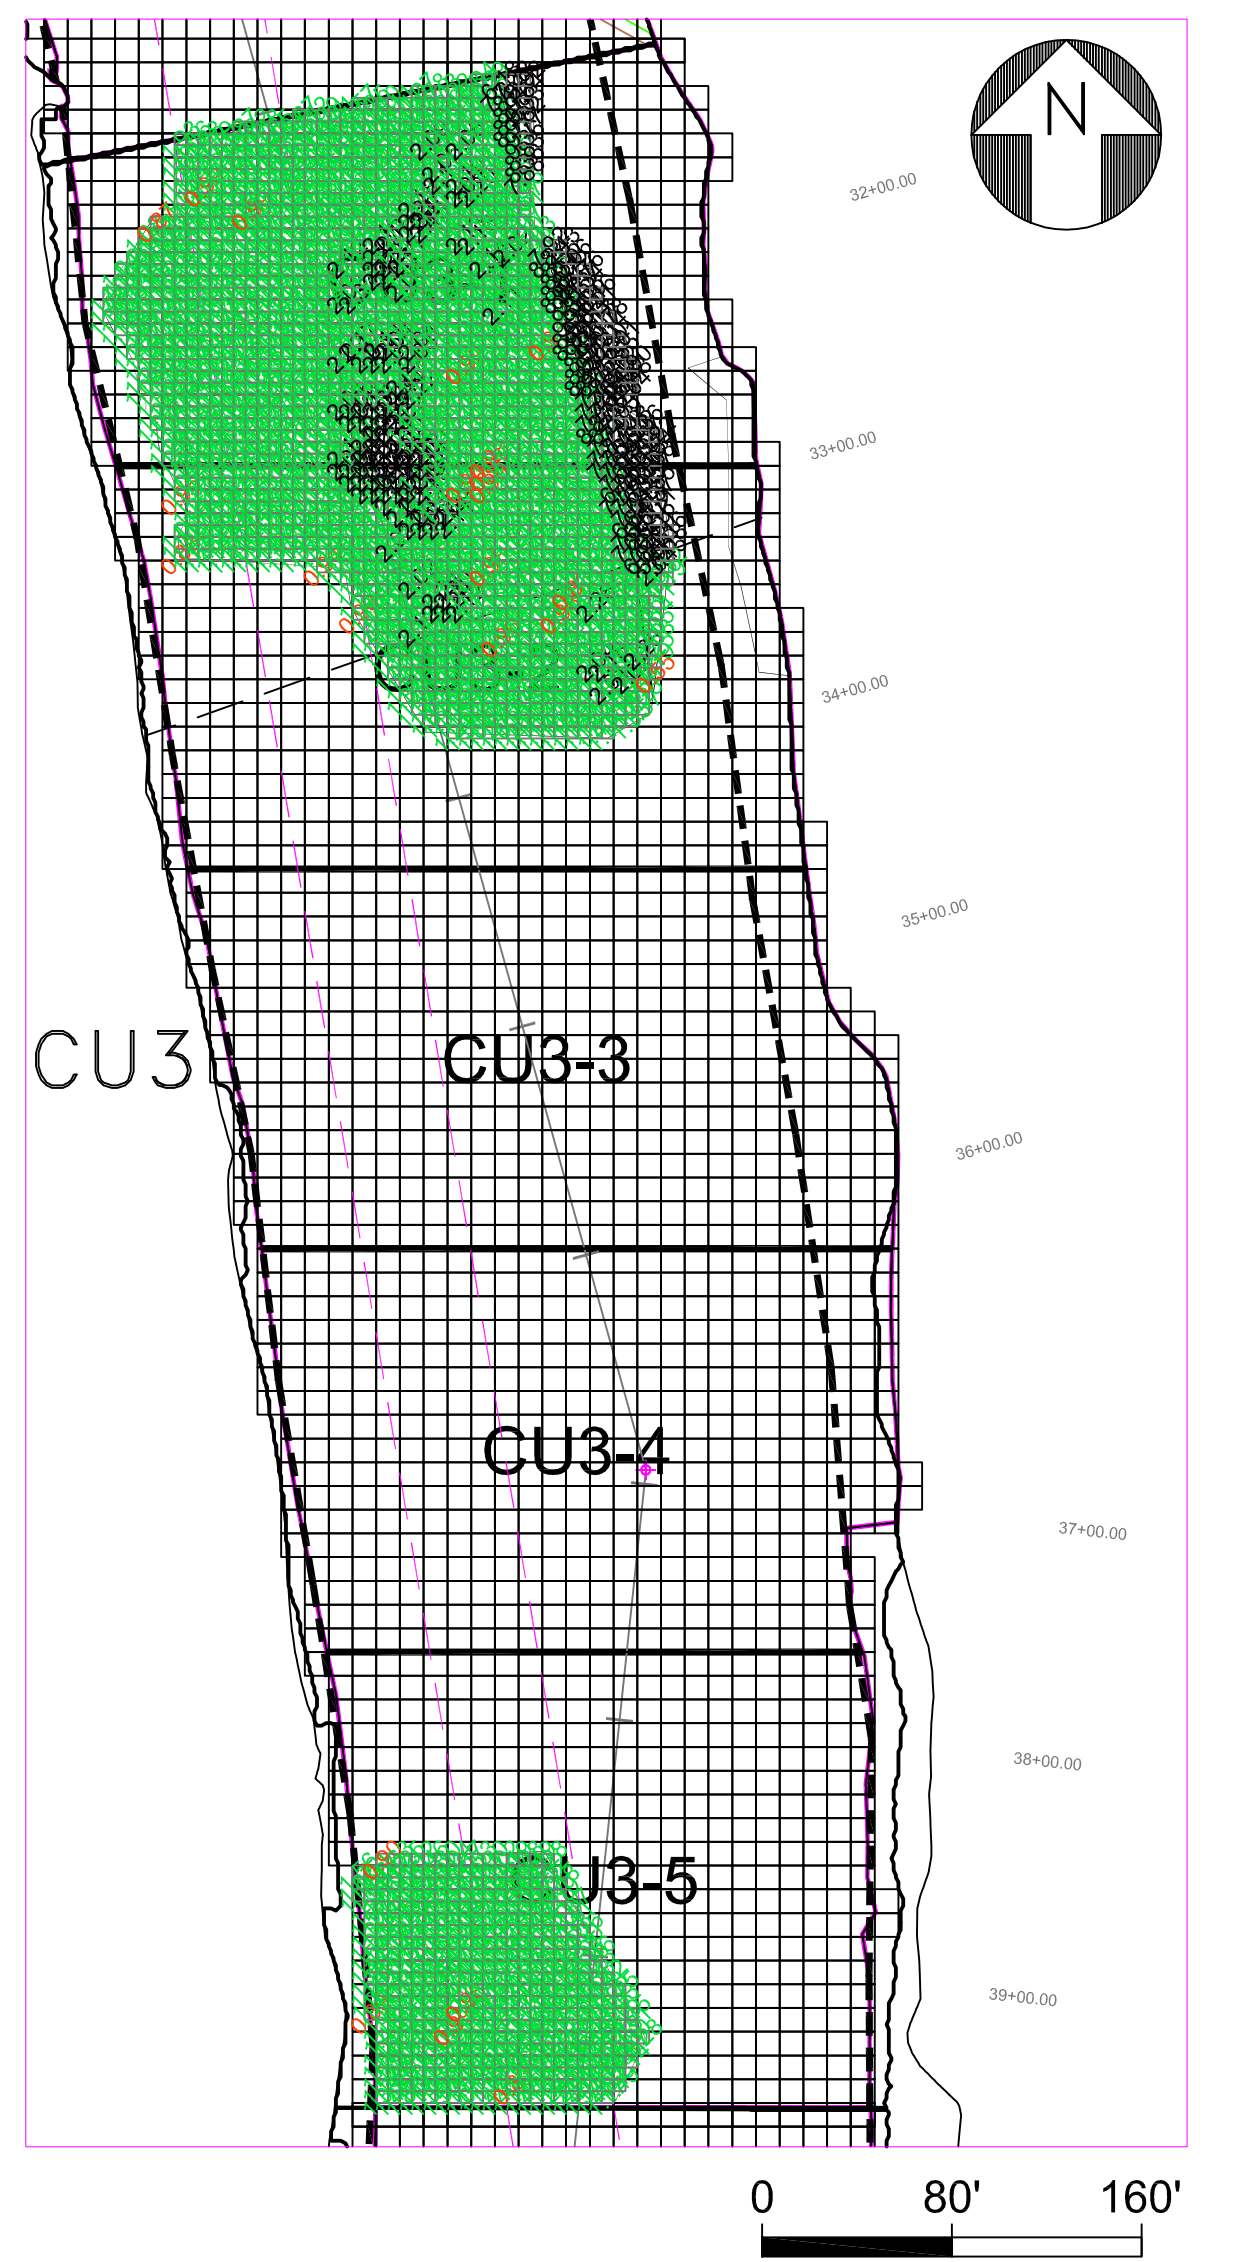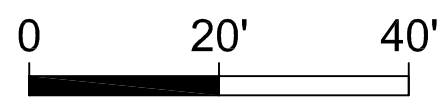

CU3 TYPE "A" CAP LOCATION

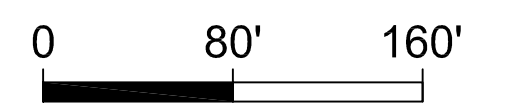



LEGEND	
	5x5 GRID WITHIN DESIGN GUIDELINES
	5x5 GRID LESS THAN DESIGN GUIDELINES
	5x5 GRID ABOVE DESIGN GUIDELINES
	ROCK/REFUSAL ENCOUNTERED VIA INVENTORY 1 DREDGING AS OF (JULY 2009)
	NEARSHORE BOUNDARY
	CU BOUNDARY
	CU SUBUNIT BOUNDARY

NOTES:

1. OSI MULTIBEAM SURVEYS ON OCTOBER 28 AND NOVEMBER 8, 2009.
2. CAP THICKNESS IS LISTED IN 5'x5' GRIDS.
3. TYPE "A" LOW VELOCITY CAP THICKNESS ALSO INCLUDES PLACEMENT OF 15% BACKFILL MATERIAL.

CU3
TYPE "A" CAP
ACCEPTANCE SURVEY

PARSONS GE COMPANY - PARSONS PROJECT OFFICE BUILDING 40-1, 381 BROADWAY FORT EDWARD, N.Y. 12828 (518) 746-5311		DRAWING TITLE CU3 TYPE "A" CAP ACCEPTANCE SURVEY	
DRAWN BY JHC	CHECKED BY MG	DRAWING NO. CU3-1	SCALE AS SHOWN
DATE 11/17/09	APPROVED BY MG	JOB 442209.01401	

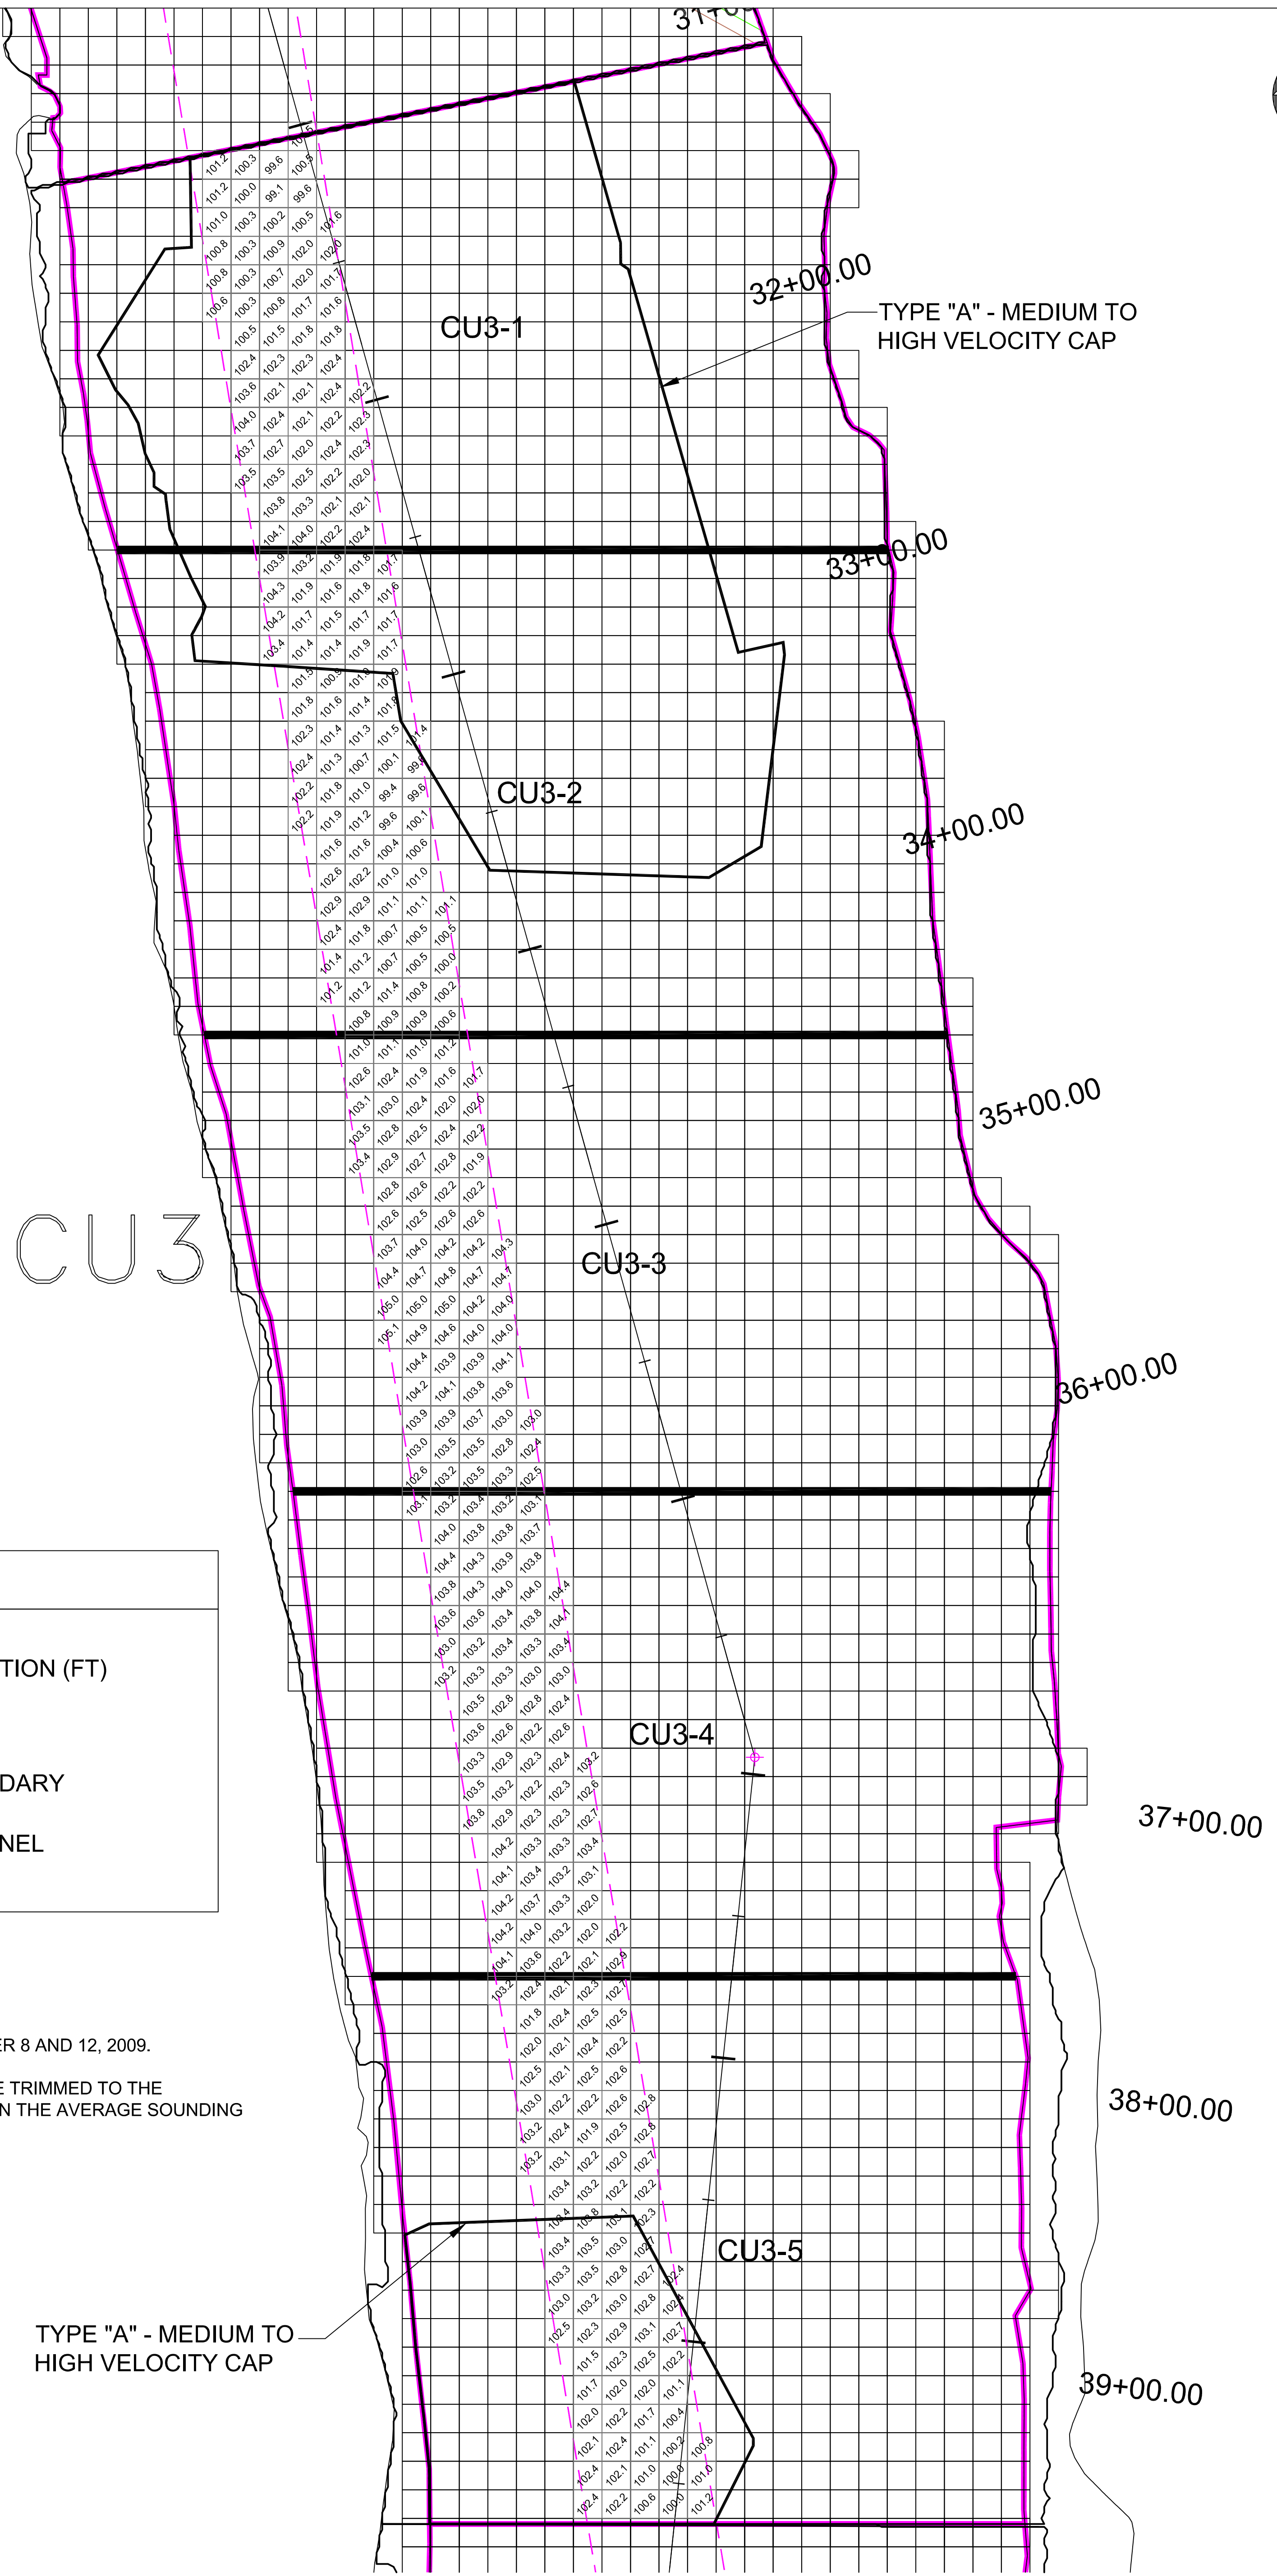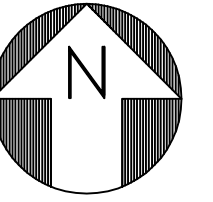


CU3

LEGEND

104.5	10'x10' GRID ELEVATION (FT)
— (magenta line)	CU BOUNDARY
— (thick black line)	CU SUBUNIT BOUNDARY
- - - (dashed magenta line)	NAVIGATION CHANNEL

- NOTES:**
- OSI MULTIBEAM SURVEYS ON NOVEMBER 8 AND 12, 2009.
 - NAVIGATION CHANNEL ELEVATIONS ARE TRIMMED TO THE NAVIGATION CHANNEL BOUNDARY, THEN THE AVERAGE SOUNDING IN EACH 10'x10' GRID CELL IS SHOWN.

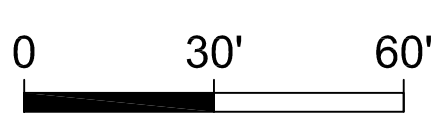


**CU3
NAVIGATIONAL CHANNEL ELEVATIONS
POST BACKFILL AND CAP PLACEMENT**

PARSONS GE COMPANY - PARSONS PROJECT OFFICE BUILDING 40-1, 381 BROADWAY FORT EDWARD, N.Y. 12828 (518) 746-5311		DRAWING TITLE	
		CU3 NAV CHANNEL ELEVATIONS POST BACKFILL AND CAP PLACEMENT	
DRAWN BY	CHECKED BY	DRAWING NO.	SCALE
JHG	MG	CU3-3	AS SHOWN
DATE	APPROVED BY	JOB	
11/17/09	MG	442209.01401	

15% Volume Table

Area	15% Volume Placed (CY)
CU-3 15%	4,504

- Notes.
- Volume calculations are based on data collected through the 11th of November 2009.
 - Volumes were computed using 1' x 1' cell center average data sets. In areas where the near-shore prism slope did not extend underneath the 15% backfill areas, additional slopes were added.
 - Volumes were computed using HYPACK, Inc. 2008 TIN to TIN method.
 - The volume information presented in this table are the results of multibeam surveys performed by Ocean Surveys, Inc. on the survey dates indicated and can only be considered representative of the conditions existing during that time.

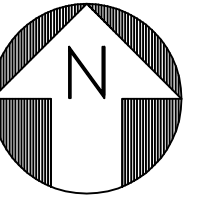

LEGEND

- 0.03 10x10 GRID WITHIN DESIGN GUIDELINES
- 0.11 10x10 GRID LESS THAN DESIGN GUIDELINES
- 1.11 10x10 GRID ABOVE DESIGN GUIDELINES
- CU BOUNDARY
- CU SUBUNIT BOUNDARY
- NEARSHORE BORDER (117.5 FEET)
- 3-11 NEARSHORE BORDER SET POINT (DATA CONTAINED IN NEARSHORE SUMMARY TABLE)
- NEARSHORE BORDER (117.5 FEET)

Subunit	Average Thickness (ft)	Approx. Area (acre)	Intended Vol. Placed (CY)	Actual Vol. Placed (CY)	Variation from Planned (CY)
CU3-1	1.00	0.15	240.7	240.7	0.0
CU3-2	1.13	0.50	807.4	913.7	106.3
CU3-3	1.16	0.64	1,029.6	1,191.3	161.7
CU3-4	1.11	0.64	1,037.0	1,150.3	113.3
CU3-5	1.11	0.54	874.1	968.6	94.5
Total =					475.9

- Notes:
- Average thickness and volumes were computed using 10x10 cell center average data sets.


CU-3 Near-Shore Topographic Measurements
Collected on the 11th and 12th of November 2009.

Published Near-Shore Border Set Points				Near-Shore Topographic Measurements					
Name	Easting	Northing	Target Elevation	Easting	Northing	Check Elevation	Horz. Dist	Vert. Diff.	
3-1	736,296.72	1,614,412.28	117.5	736,296.73	1,614,411.95	117.59	0.33	0.09	
	736,314.60	1,614,313.18	117.5	736,314.73	1,614,313.15	116.51	0.13	-0.99	
3-2				736,314.37	1,614,312.36	116.37	0.85	-1.13	
				736,316.98	1,614,313.70	116.84	2.43	-0.66	
				736,319.50	1,614,313.66	117.35	4.92	-0.15	
3-3	736,335.34	1,614,216.00	117.5	736,335.37	1,614,215.73	117.11	0.27	-0.39	
3-4	736,348.58	1,614,117.42	117.5	736,348.62	1,614,117.38	117.68	0.05	0.18	
3-5	736,366.73	1,614,018.36	117.5	736,366.94	1,614,018.36	117.41	0.21	-0.09	
3-6	736,381.73	1,613,919.61	117.5	736,381.81	1,613,919.38	117.25	0.24	-0.25	
3-7	736,389.45	1,613,819.80	117.5	736,389.59	1,613,819.96	117.04	0.21	-0.46	
	736,398.73	1,613,763.17	117.5	736,398.51	1,613,763.06	116.17	0.25	-1.33	
3-8				736,400.46	1,613,764.06	116.99	1.94	-0.51	
				736,401.69	1,613,764.17	117.43	3.13	-0.07	
3-9	736,397.62	1,613,663.54	117.5	736,397.32	1,613,663.40	117.19	0.33	-0.31	
	736,067.36	1,614,359.93	117.5	736,067.34	1,614,360.13	118.50	0.20	1.00	
3-10				736,064.88	1,614,359.71	118.86	0.22	1.36	
				736,067.03	1,614,360.21	118.45	0.28	0.95	
				736,064.88	1,614,359.23	118.93	0.70	1.43	
				736,069.99	1,614,360.84	117.22	0.91	-0.28	
3-11	736,089.25	1,614,269.50	117.5	736,089.45	1,614,269.49	117.84	0.20	0.34	
	736,104.12	1,614,178.18	117.5	736,104.08	1,614,178.11	118.56	0.08	1.06	
3-12				736,103.94	1,614,178.13	118.90	0.19	1.40	
				736,106.28	1,614,178.71	117.82	2.22	0.32	
3-13				736,121.03	1,614,087.37	117.5	119.05	0.13	1.55
				736,121.36	1,614,087.65	118.78	0.44	1.28	
				736,123.01	1,614,087.32	118.49	1.98	0.99	
				736,124.19	1,614,087.57	117.66	3.16	0.16	
3-14				736,126.18	1,614,088.21	116.69	5.22	-0.81	
	736,137.26	1,614,010.52	117.5	736,136.89	1,614,010.58	119.12	0.38	1.61	
3-15				736,138.77	1,614,010.54	118.41	1.51	0.91	
				736,140.61	1,614,010.76	117.28	3.36	-0.22	
3-16	736,148.76	1,613,914.92	117.5	736,148.31	1,613,914.84	118.89	0.46	1.39	
				736,145.99	1,613,914.31	119.14	2.84	1.64	
3-17				736,151.94	1,613,916.13	117.43	3.41	-0.07	
	736,163.48	1,613,828.29	117.5	736,163.57	1,613,828.41	118.42	0.15	0.92	
3-18				736,165.18	1,613,828.68	117.23	1.74	-0.27	
	736,179.04	1,613,731.04	117.5	736,178.80	1,613,731.32	116.06	0.37	-1.44	
3-19				736,176.93	1,613,731.29	116.58	2.12	-0.92	
	736,188.70	1,613,634.17	117.5	736,188.82	1,613,633.70	117.96	0.48	0.46	


Notes.

Additional Topographic Measurements provided as part of CU3 Form 2 Acceptance Package.



- NOTES:
- OSI MULTIBEAM SURVEYS ON NOVEMBER 8 AND 12, 2009.

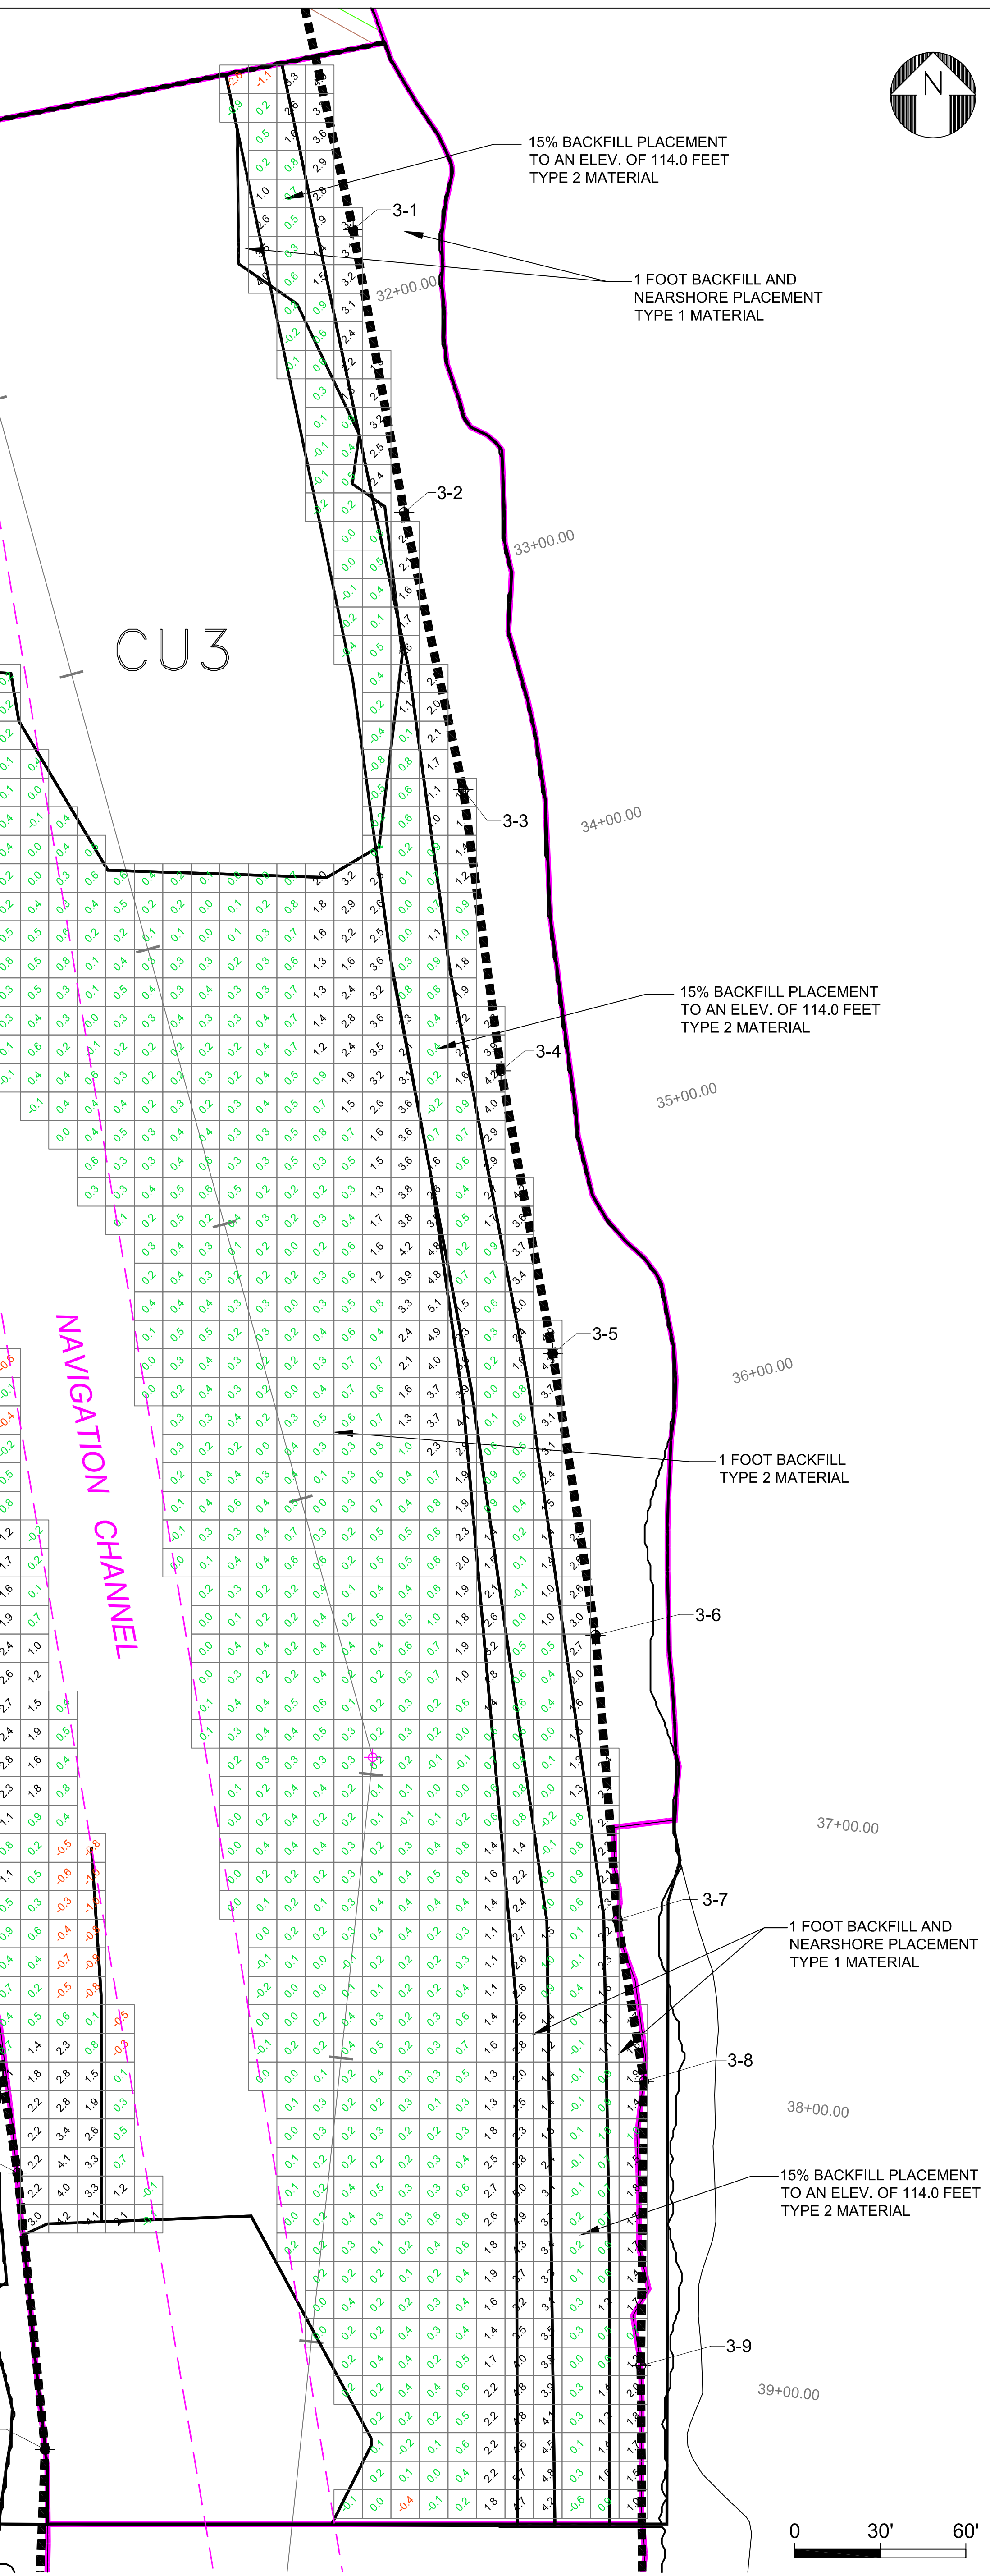

CU3
1 FOOT BACKFILL, 15% BACKFILL, AND NEARSHORE PLACEMENT ACCEPTANCE SURVEY

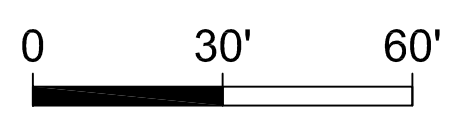

PARSONS		DRAWING TITLE	
GE COMPANY - PARSONS PROJECT OFFICE BUILDING 40-1, 381 BROADWAY FORT EDWARD, N.Y. 12828 (518) 746-5311		CU3 BACKFILL PLACEMENT ACCEPTANCE SURVEY	
DRAWN BY JHC	CHECKED BY MG	DRAWING NO. CU3-2	VERSION/SCALE AS SHOWN
DATE 11/17/09	APPROVED BY MG	JOB 442209.01401	

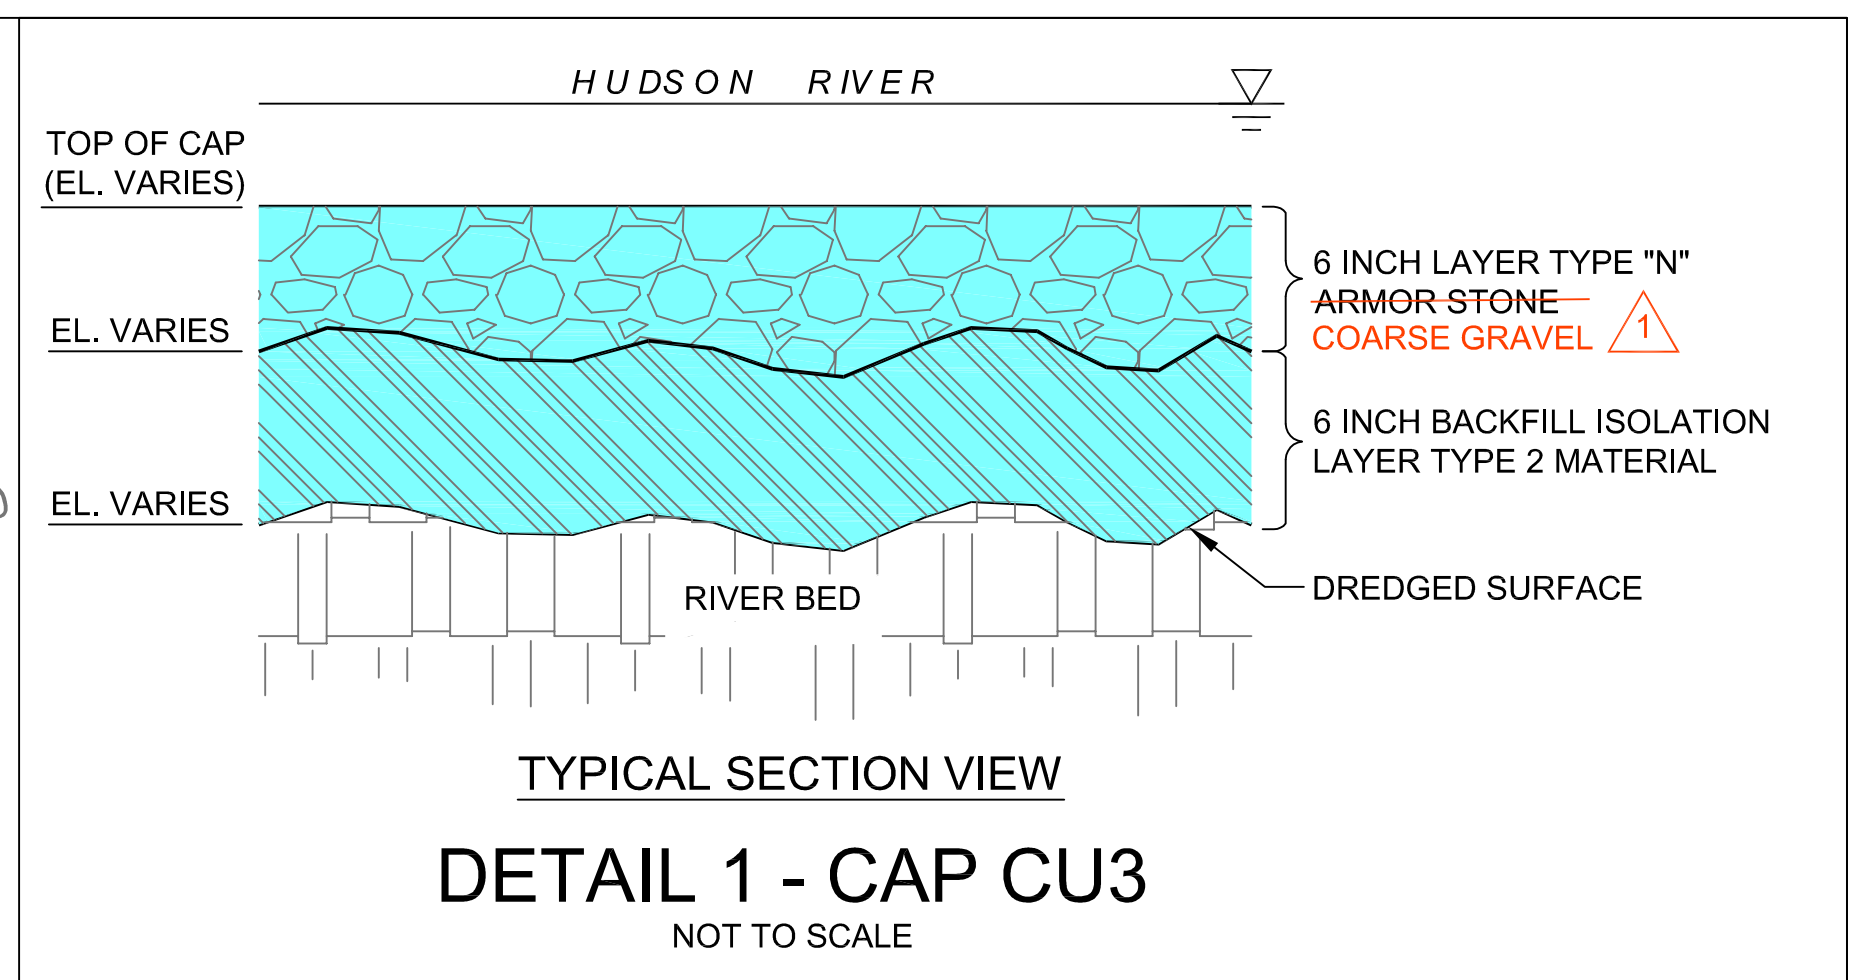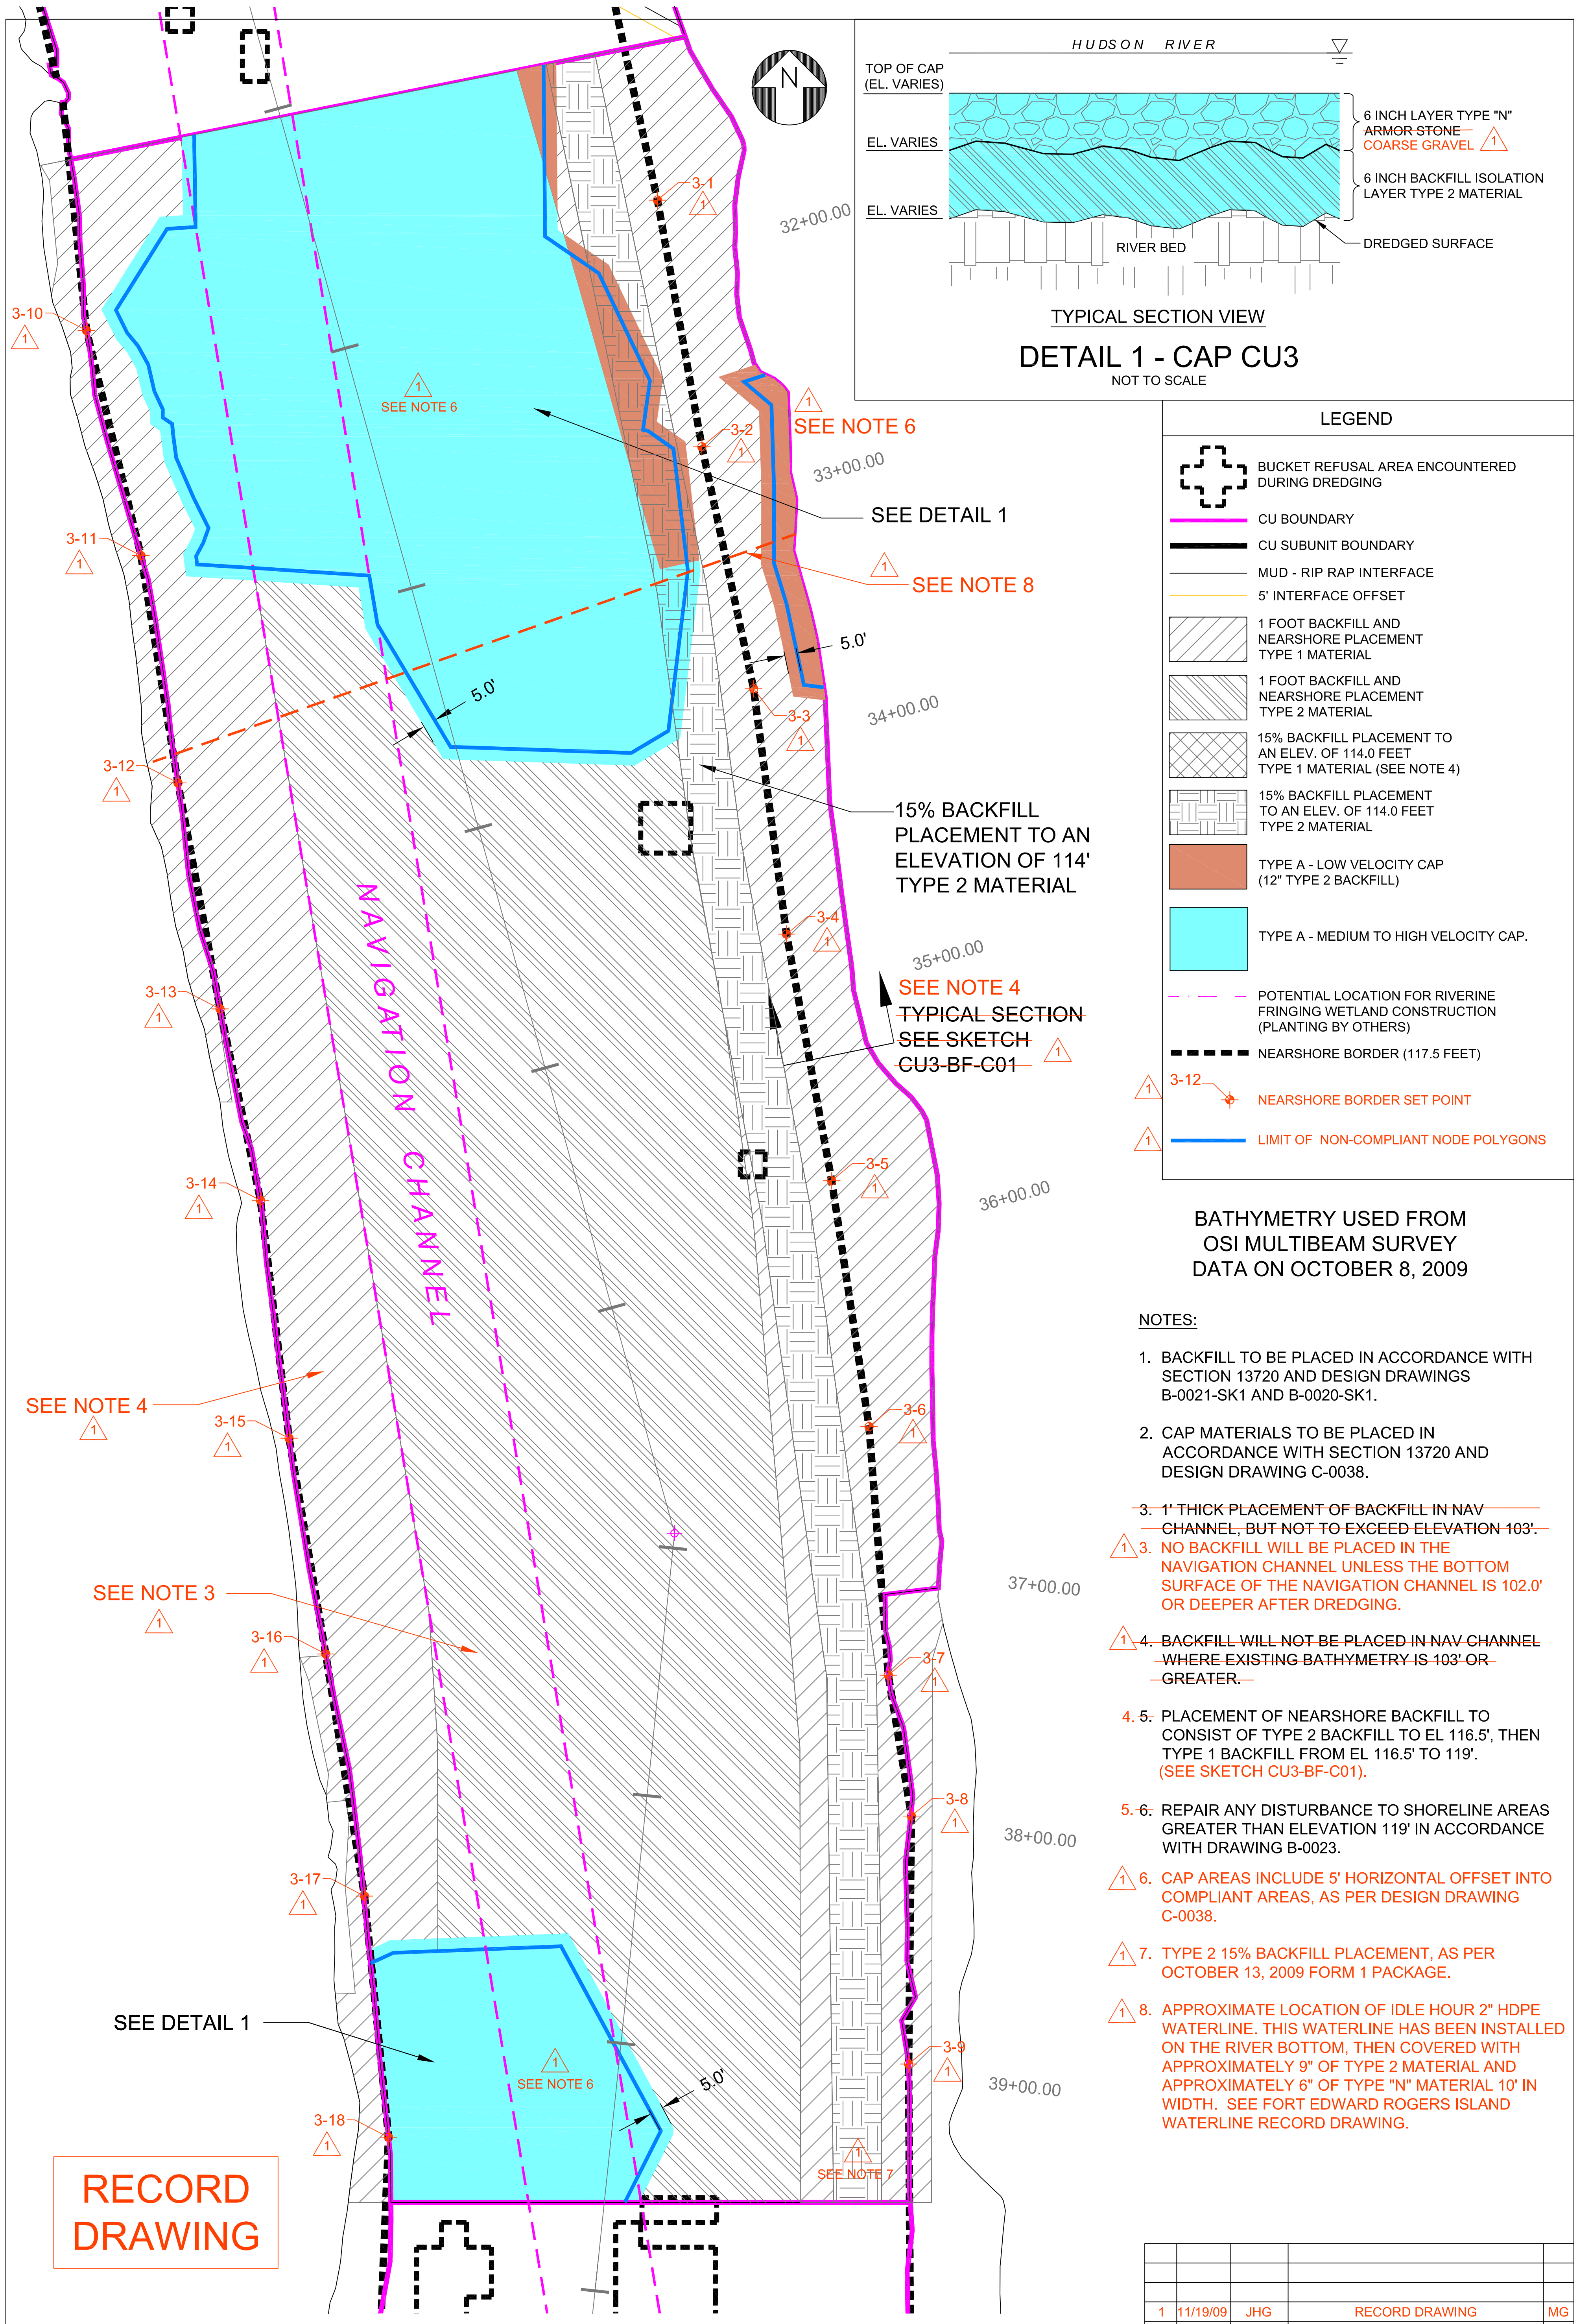

LEGEND


- BUCKET REFUSAL AREA ENCOUNTERED DURING DREDGING
- CU BOUNDARY
- CU SUBUNIT BOUNDARY
- MUD - RIP RAP INTERFACE
- 5' INTERFACE OFFSET
- 1 FOOT BACKFILL AND NEARSHORE PLACEMENT TYPE 1 MATERIAL
- 1 FOOT BACKFILL AND NEARSHORE PLACEMENT TYPE 2 MATERIAL
- 15% BACKFILL PLACEMENT TO AN ELEV. OF 114.0 FEET TYPE 1 MATERIAL (SEE NOTE 4)
- 15% BACKFILL PLACEMENT TO AN ELEV. OF 114.0 FEET TYPE 2 MATERIAL
- TYPE A - LOW VELOCITY CAP (12" TYPE 2 BACKFILL)
- TYPE A - MEDIUM TO HIGH VELOCITY CAP.
- POTENTIAL LOCATION FOR RIVERINE FRINGING WETLAND CONSTRUCTION (PLANTING BY OTHERS)
- NEARSHORE BORDER (117.5 FEET)
- 3-12 NEARSHORE BORDER SET POINT
- LIMIT OF NON-COMPLIANT NODE POLYGONS

BATHYMETRY USED FROM OSI MULTIBEAM SURVEY DATA ON OCTOBER 8, 2009

NOTES:

1. BACKFILL TO BE PLACED IN ACCORDANCE WITH SECTION 13720 AND DESIGN DRAWINGS B-0021-SK1 AND B-0020-SK1.
2. CAP MATERIALS TO BE PLACED IN ACCORDANCE WITH SECTION 13720 AND DESIGN DRAWING C-0038.
3. 1" THICK PLACEMENT OF BACKFILL IN NAV CHANNEL, BUT NOT TO EXCEED ELEVATION 103'.
3. NO BACKFILL WILL BE PLACED IN THE NAVIGATION CHANNEL UNLESS THE BOTTOM SURFACE OF THE NAVIGATION CHANNEL IS 102.0' OR DEEPER AFTER DREDGING.
4. BACKFILL WILL NOT BE PLACED IN NAV CHANNEL WHERE EXISTING BATHYMETRY IS 103' OR GREATER.
4. 5. PLACEMENT OF NEARSHORE BACKFILL TO CONSIST OF TYPE 2 BACKFILL TO EL 116.5', THEN TYPE 1 BACKFILL FROM EL 116.5' TO 119'. (SEE SKETCH CU3-BF-C01).
5. 6. REPAIR ANY DISTURBANCE TO SHORELINE AREAS GREATER THAN ELEVATION 119' IN ACCORDANCE WITH DRAWING B-0023.
6. CAP AREAS INCLUDE 5' HORIZONTAL OFFSET INTO COMPLIANT AREAS, AS PER DESIGN DRAWING C-0038.
7. TYPE 2 15% BACKFILL PLACEMENT, AS PER OCTOBER 13, 2009 FORM 1 PACKAGE.
8. APPROXIMATE LOCATION OF IDLE HOUR 2" HDPE WATERLINE. THIS WATERLINE HAS BEEN INSTALLED ON THE RIVER BOTTOM, THEN COVERED WITH APPROXIMATELY 9" OF TYPE 2 MATERIAL AND APPROXIMATELY 6" OF TYPE "N" MATERIAL 10' IN WIDTH. SEE FORT EDWARD ROGERS ISLAND WATERLINE RECORD DRAWING.

1	11/19/09	JHG	RECORD DRAWING	MG
0	10/13/09	JHG	ISSUED FOR EPA REVIEW	MG
REV	DATE	DRN BY	DRAWING DESCRIPTION	PM
			DRAWING TITLE CU3 BACKFILL AND CAP PLAN	
GE COMPANY - PARSONS PROJECT OFFICE BUILDING 40-1, 381 BROADWAY FORT EDWARD, N.Y. 12828 (518) 746-5311			DRAWING NO. CU3-BC-2	
DRAWN BY JHG	CHECKED BY MG	APPROVED BY MG	SCALE AS SHOWN	JCR 442209.01401
DATE	11/19/09			

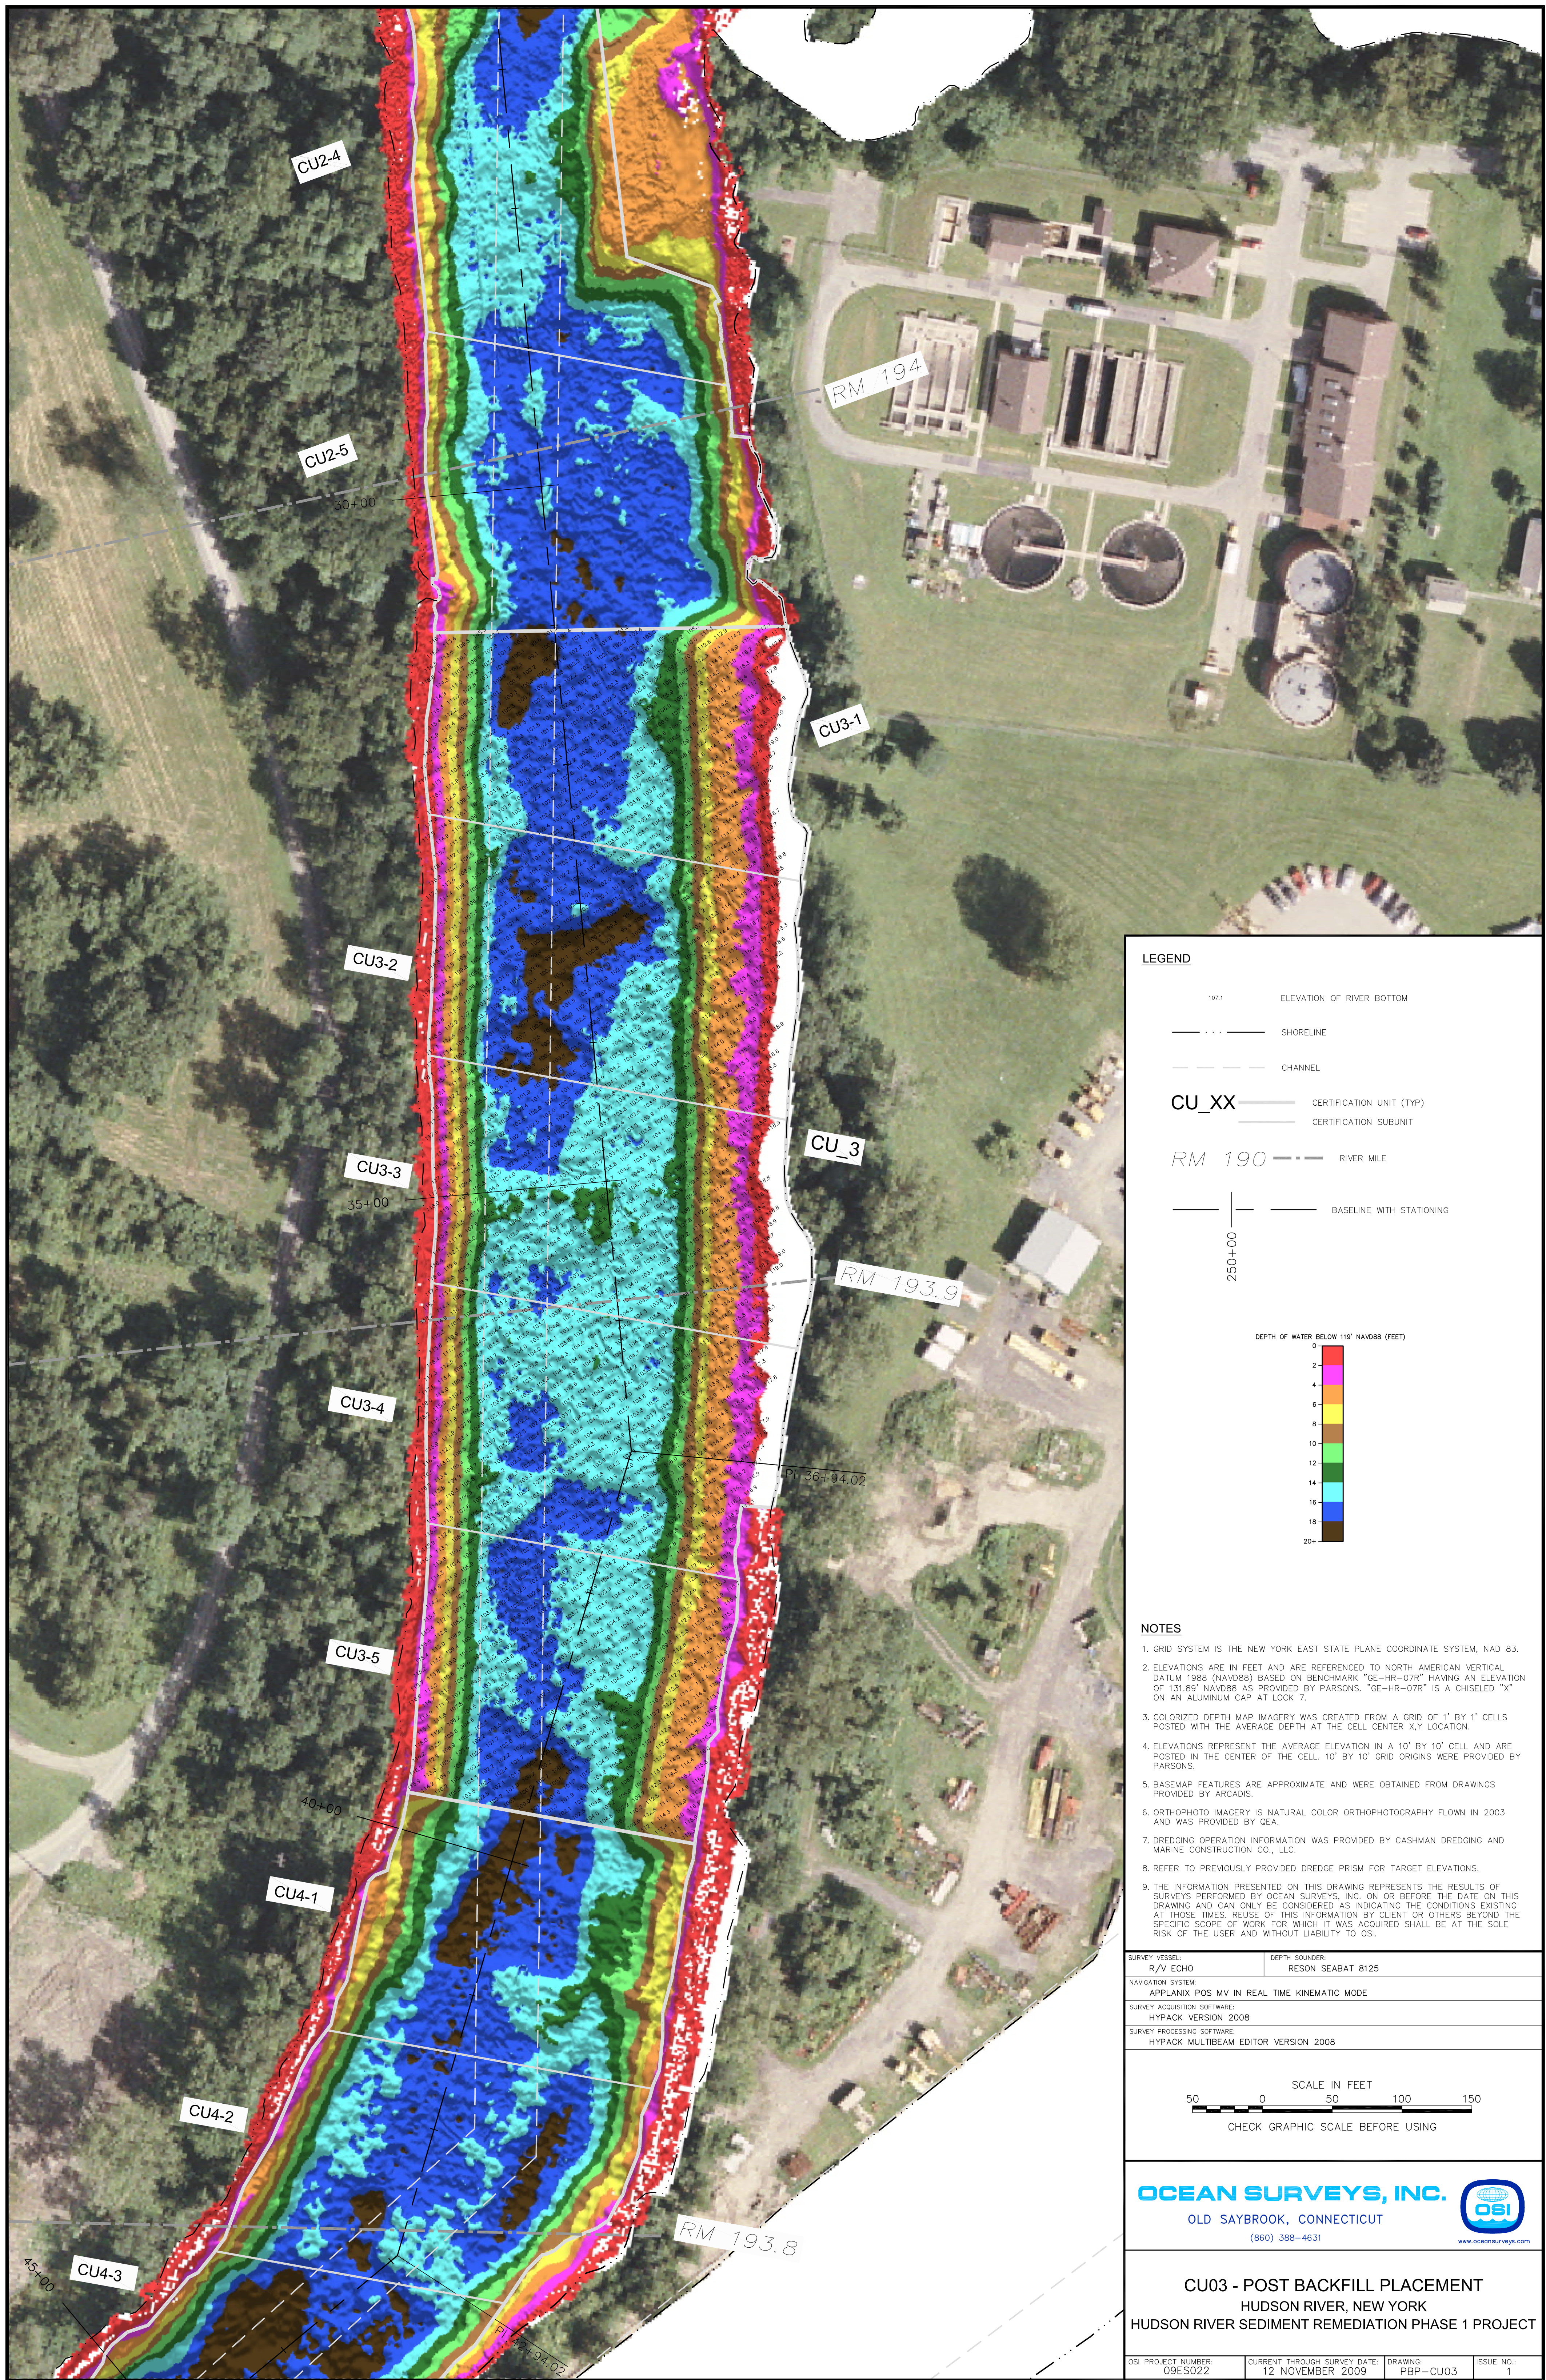

LEGEND

107.1 ELEVATION OF RIVER BOTTOM

SHORELINE


CHANNEL

CU_XX CERTIFICATION UNIT (TYP)
CERTIFICATION SUBUNIT

RM 190 RIVER MILE


BASELINE WITH STATIONING

250+00

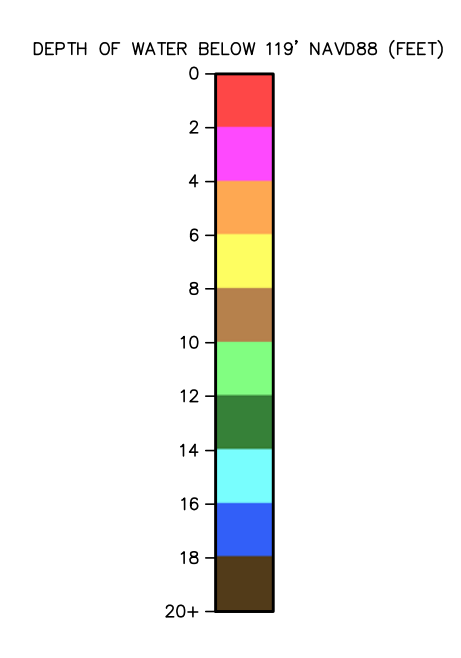

- NOTES**
- GRID SYSTEM IS THE NEW YORK EAST STATE PLANE COORDINATE SYSTEM, NAD 83.
 - ELEVATIONS ARE IN FEET AND ARE REFERENCED TO NORTH AMERICAN VERTICAL DATUM 1988 (NAVD88) BASED ON BENCHMARK "GE-HR-07R" HAVING AN ELEVATION OF 131.89' NAVD88 AS PROVIDED BY PARSONS. "GE-HR-07R" IS A CHISELED "X" ON AN ALUMINUM CAP AT LOCK 7.
 - COLORIZED DEPTH MAP IMAGERY WAS CREATED FROM A GRID OF 1' BY 1' CELLS POSTED WITH THE AVERAGE DEPTH AT THE CELL CENTER X,Y LOCATION.
 - ELEVATIONS REPRESENT THE AVERAGE ELEVATION IN A 10' BY 10' CELL AND ARE POSTED IN THE CENTER OF THE CELL. 10' BY 10' GRID ORIGINS WERE PROVIDED BY PARSONS.
 - BASEMAP FEATURES ARE APPROXIMATE AND WERE OBTAINED FROM DRAWINGS PROVIDED BY ARCADIS.
 - ORTHO PHOTO IMAGERY IS NATURAL COLOR ORTHOPHOTOGRAPHY FLOWN IN 2003 AND WAS PROVIDED BY QEA.
 - DREDGING OPERATION INFORMATION WAS PROVIDED BY CASHMAN DREDGING AND MARINE CONSTRUCTION CO., LLC.
 - REFER TO PREVIOUSLY PROVIDED DREDGE PRISM FOR TARGET ELEVATIONS.
 - THE INFORMATION PRESENTED ON THIS DRAWING REPRESENTS THE RESULTS OF SURVEYS PERFORMED BY OCEAN SURVEYS, INC. ON OR BEFORE THE DATE ON THIS DRAWING AND CAN ONLY BE CONSIDERED AS INDICATING THE CONDITIONS EXISTING AT THOSE TIMES. REUSE OF THIS INFORMATION BY CLIENT OR OTHERS BEYOND THE SPECIFIC SCOPE OF WORK FOR WHICH IT WAS ACQUIRED SHALL BE AT THE SOLE RISK OF THE USER AND WITHOUT LIABILITY TO OSI.

SURVEY VESSEL: R/V ECHO	DEPTH SOUNDER: RESON SEABAT 8125
NAVIGATION SYSTEM: APPLANIX POS MV IN REAL TIME KINEMATIC MODE	
SURVEY ACQUISITION SOFTWARE: HYPACK VERSION 2008	
SURVEY PROCESSING SOFTWARE: HYPACK MULTIBEAM EDITOR VERSION 2008	

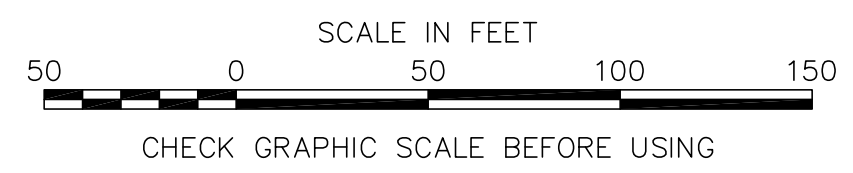


OCEAN SURVEYS, INC. 

OLD SAYBROOK, CONNECTICUT
(860) 388-4631
www.oceansurveys.com

CU03 - POST BACKFILL PLACEMENT
HUDSON RIVER, NEW YORK
HUDSON RIVER SEDIMENT REMEDIATION PHASE 1 PROJECT

OSI PROJECT NUMBER: 09ES022	CURRENT THROUGH SURVEY DATE: 12 NOVEMBER 2009	DRAWING: BFP-CU03	ISSUE NO.: 1
--------------------------------	--	----------------------	-----------------

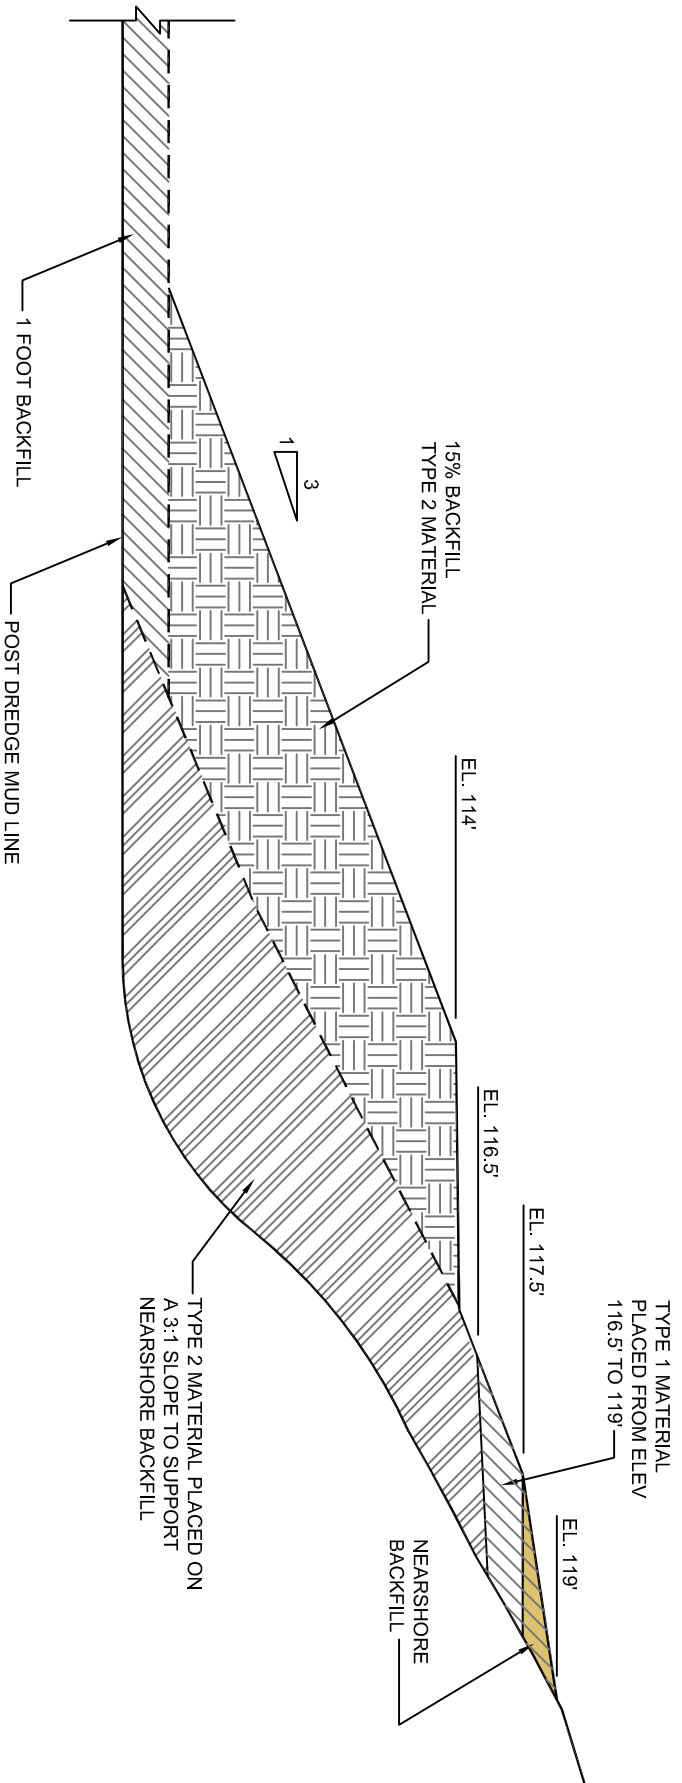

CU3 NEAR SHORE BACKFILL WITH 15% BACKFILL TO ELEV 114' PLACEMENT DETAIL

TYPICAL SECTION NOT TO SCALE

**RECORD
DRAWING**

PARSONS <small>COMMERCIAL TECHNOLOGY GROUP</small> GE COMPANY - PARSONS PROJECT OFFICE BUILDING 40-1, 381 BROADWAY FORT EDWARD, N.Y. 12828 (518) 746-5311		DRAWING TITLE CU3 NEAR SHORE BACKFILL WITH 15% BACKFILL PLACEMENT DETAIL	
DRAWN BY JHG	CHECKED BY MG	DRAWING NO. CU3-BF-C01	SCALE NOT TO SCALE
DATE 10/13/09	APPROVED BY MG	JOB 442209	

Correspondence
(Letters and Emails)

Galbraith, Michael

From: King.David@epamail.epa.gov
Sent: Saturday, November 14, 2009 9:36 AM
To: Andrew Inglis
Cc: Michael J. Johnson; Timothy Kruppenbacher; Galbraith, Michael; Bryan Minor; Gary Klawinski; Joseph Moloughney
Subject: Re: Discussions regarding CU Backfill and Cap placement

Andrew, I agree with summary.

Dave

Sent by EPA Wireless E-Mail Services

From: "Inglis, Andrew A (GE, Corporate)" [andrew.inglis@ge.com]
Sent: 11/13/2009 05:13 PM EST
To: David King
Cc: <MJohnson@louisberger.com>; "Kruppenbacher, Timothy A (GE, Corporate)" <timothy.kruppenbacher@ge.com>; <michael.galbraith@parsons.com>; <USACE_HRFO@roadrunner.com>; <GKlawinski@ene.com>; "Joseph Moloughney" <Joseph_Moloughney@canals.state.ny.us>
Subject: Discussions regarding CU Backfill and Cap placement

Dave,

Today and yesterday we met and reviewed progress surveys of cap and backfill placement in CUs 1, 2, 3, 4, 7 and 18. This email confirms decisions made during the meeting based on reviews of the maps presented during the meeting.

CU1.

In CU1 it was agreed that sufficient thickness of isolation layer material has been placed while providing enough room to place armor stone below the 105.2' elevation in the navigation channel. It was agreed that placement of armor stone can begin.

CU2.

In CU2 it was agreed that the top of cap and backfill elevations were acceptable. GE will prepare a Form 2 package for EPA review.

CU3 .

In CU3 it was agreed that the top of cap and backfill elevations were acceptable, it was discussed that GE was in the process of placing backfill in an area of the navigation channel where the post dredge elevations were below 102' elevation. Once GE has surveyed that additional backfill location GE will prepare a Form 2 package for EPA review.

CU4.

In CU4 it was agreed that the top of cap elevations in the north east quarter of the CU was acceptable and that backfill placement in that area may begin.

CU7.

In CU7 it was agreed that the top of cap and backfill elevations were acceptable. GE will prepare a Form 2 package for EPA review.

CU18

In CU18 it was agreed that the top of cap elevations were acceptable in both of the cap locations in that CU.

Please let me know if I missed anything.

Thanks,

Andrew A. Inglis
Dredging Task Leader
GE

T +1 518-746-5256

381 Broadway
Building 40-2
Fort Edward, NY 12828
GE Corporate Environmental Programs

GE Imagination at Work

CU-04

Form 2

CU Certification of Completion

CU BACKFILL/ENGINEERED CAP COMPLETION APPROVAL - FORM 2						
Reporting Date	11/24/2009				Placement Start Date	11/4/2009
CU Number	4				Placement End Date	11/21/2009
Approximate CU Centroid	Northing	1613165.797	Easting	736117.609	NY State NAD 83	
CU Size	4.51	Acres				
Backfill Area	0.98	Acres*				
Cap Area	3.53	Acres				
Backfill Surface Mean Tri+ PCBs Concentration (when required)		NA		mg/kg		
Number of nodes sampled		NA		mg/kg		
Backfill	Type of Backfill	Reference to appropriate drawings attached to Approval Form 1				
X	Type 1, Type 2, Nearshore, 15%	CU4 Backfill and Cap Plan, 11/3/09				
Cap	Type of Cap	Reference to appropriate drawings attached to Approval Form 1				
X	Type "A" Medium-High Velocity Cap Type "A" Low Velocity Cap Type "B" High Velocity Cap Type "B" Medium Velocity Cap Type "B" Low Velocity Cap	CU4 Backfill and Cap Plan, 11/3/09				
CU Checklist		Indicate one of the following			Reviewer Initial Acceptance	
Item	Attached	Not Applicable	GE	EPA		
Drawing of Installed Backfill/Cap (with record details, thickness and sample locations [when backfill/cap are placed])	X					
Where applicable in backfill areas provide the following: Sample locations (coordinates), depths, Aroclor and Tri+ PCB concentrations collected including analytical data, field observations, (hard copy and electronic copies [in database format or equivalent])		X				
Comments						
Refer to CU4 Narrative Summary of Backfill and Capping and CU4 Backfill Placement Drawings. *Backfill Area does not include 15% backfill material placed over Cap Area.						
Upon signing this document, GE certifies that the backfill/cap has been installed satisfactorily and that no further backfill placement or capping is required for this CU. These remedial activities exclude long term operation, monitoring, maintenance and adaptive management at the CU. EPA accepts this certification.						
Signature of GE Representative			Signature of EPA Representative			
Signature			Signature			
Name			Name			
Date			Date			

Narrative

CU 4

Narrative Summary of Backfill and Capping and EPA Backfill and Capping Agreements

1.0 Cap Placement

Type "A" Medium to High Velocity, Type "A" Low Velocity, Type "B" High Velocity, Type "B" Medium Velocity and Type "B" Low Velocity Caps were placed in accordance with the CU 4 Backfill and Cap Plan drawing, dated November 3, 2009, which was provided to EPA as part of the CU 4 Form 1 package. Final multi-beam bathymetric surveys of the Type "A" Caps was performed on November 18, 2009, as shown on the attached CU 4 Type "A" Cap Acceptance Survey map, dated November 23, 2009. The surveyed cap thickness on a 5'x5' grid is shown for all areas of Type "A" Caps. Final multi-beam bathymetric surveys of the Type "B" isolation layers were performed on November 12 and 13, 2009, as shown on the attached CU 4 Type "B" Cap Isolation Layer Acceptance Survey map, dated November 23, 2009. The surveyed isolation layer thickness on a 10' x 10' grid is shown for the High Velocity and Medium Velocity Caps and on a 5'x5' grid for the Low Velocity Cap. A multi-beam survey of the armor stone layer of the Type "B" High Velocity and Medium Velocity cap areas was completed on November 13, 16, and 20, 2009, as shown on the attached CU 4 Type "B" Cap Armor Layer Acceptance Survey maps, dated November 23, 2009. The surveyed armor layer thickness on a 5' x 5' grid is shown for the High and Medium Velocity Type "B" cap areas.

2.0 Backfill Placement

In accordance with the CU 4 Backfill and Cap Plan Drawing, dated November 3, 2009, which was provided to EPA as part of the CU 4 Form 1 package, 1-foot Backfill, Nearshore Backfill and 15% Additional Backfill were placed in CU 4. Final multi-beam bathymetric surveys of the backfill materials were performed on November 12 and 19, 2009 as shown on the attached CU 4 Backfill Placement Acceptance Survey map, dated November 23, 2009. The difference to target thickness of the final backfill surface is shown on a 10'x10' grid for the 1-foot Backfill and the 15% Additional Backfill. For Nearshore Backfill, the elevations of the nearshore set points are provided in the table on the attached CU 4 Backfill Placement Acceptance Survey map, dated November 23, 2009.

3.0 EPA Field Agreements Specific to CU 4 Backfill and Capping

1. During the 4:00 PM meeting with EPA on October 12, 2009, EPA agreed that acceptance surveys of partial areas of a CU may be performed and used for acceptance once placement of backfill or cap in those areas is complete.

2. During a meeting with EPA on November 13, 2009, GE presented surveys of the CU 4 Type "A" Caps in the north-east quarter of the CU. It was agreed that the Type "A" Cap placement in that area of CU 4 was acceptable, as shown. (See attached email dated, November 14, 2009.)
3. On November 14, 2009, GE provided surveys of the CU 4 Type "A" Caps in Subunits CU 4-1, 4-2 and 4-3 to EPA via email. In addition, on November 14, 2009 GE provided surveys of the CU 4 Type "B" low velocity cap and isolation layers of the Type "B" medium and high velocity caps to EPA via email. On November 20, 2009, GE provided surveys of the CU 4 Type "A" Caps in all of the CU to EPA via email. EPA informed GE on November 21, 2009, via email, that the cap areas were acceptable. (See attached e-mail dated November 21, 2009.)
4. Final backfill and armor layer placement surveys for CU 4 Type B Caps were provided to EPA on November 23, 2009. EPA agreed that the final backfill and cap surveys were acceptable, as shown, on November 24, 2009.

Figures

CU-04 Near-Shore Topographic Soundings Collected 2009-11-23.

Published Near-Shore Locations			Near-Shore Confirmation					
Name	Easting	Northing	Target Elevation	Easting	Northing	Check Elevation	Horz. Dist.	Vert. Diff.
4-1	736,398.25	1,613,563.00	117.50	736,398.34	1,613,562.67	117.41	0.34	-0.09
4-2	736,400.13	1,613,464.17	117.50	736,399.74	1,613,463.95	116.37	0.45	-1.13
				736,407.03	1,613,461.59	117.83	7.36	0.33
4-3	736,394.27	1,613,365.58	117.50	736,394.05	1,613,365.45	114.46	0.25	-3.05
				736,397.21	1,613,363.64	117.30	3.52	-0.20
4-4	736,385.15	1,613,331.81	117.50	736,385.48	1,613,331.64	117.67	0.38	0.17
4-5	736,362.48	1,613,285.52	117.50	736,362.33	1,613,285.32	117.60	0.25	0.10
4-6	736,325.00	1,613,232.00	117.50	736,324.83	1,613,232.38	117.24	0.41	-0.26
4-7	736,287.53	1,613,184.32	117.50	736,287.27	1,613,184.08	117.30	0.35	-0.20
4-8	736,221.80	1,613,107.44	117.50	736,221.51	1,613,107.19	117.33	0.39	-0.17
4-12	736,185.06	1,613,546.06	117.50	736,185.17	1,613,545.98	117.55	0.14	0.05
4-13	736,172.78	1,613,447.00	117.50	736,172.60	1,613,446.94	117.83	0.19	0.33
4-14	736,150.49	1,613,360.51	117.50	736,150.43	1,613,360.35	117.36	0.17	-0.14
4-15	736,115.74	1,613,259.37	117.50	736,116.10	1,613,259.51	117.37	0.39	-0.13
4-16	736,072.13	1,613,192.91	117.50	736,072.11	1,613,193.11	117.74	0.20	0.24
4-17	736,014.57	1,613,114.43	117.50	736,014.81	1,613,114.29	118.77	0.28	1.27
				736,016.44	1,613,111.02	117.64	3.89	0.14
4-18	735,962.44	1,613,046.56	117.50	735,962.29	1,613,046.36	117.60	0.25	0.10
4-19	735,908.71	1,612,979.85	117.50	735,908.81	1,612,980.14	117.64	0.30	0.14
4-20	735,853.70	1,612,911.00	117.50	735,853.555	1,612,911.161	117.62	0.22	0.12
4-21	735,800.06	1,612,845.64	117.50	735,800.328	1,612,845.578	118.38	0.28	0.88
				735,801.223	1,612,845.391	117.51	1.19	0.01
4-22	735,750.91	1,612,797.09	117.50	735,751.342	1,612,796.858	116.48	0.49	-1.03
				735,750.703	1,612,799.802	117.26	2.72	-0.24

CU4 AVERAGE THICKNESS, 1-FOOT BACKFILL


Subunit	Average Thickness (ft)	Approx. Area (acre)	Intended Vol. Placed (CY)	Actual Vol. Placed (CY)	Variation from Planned (CY)
CU-4	1.19	0.89	1433.3	1714.9	281.5

Notes:
Average thickness and volumes were computed using 10x10 cell center average data sets.

CU4-15% Backfill Volume Table


Area	15% Volume Placed
CU-4 15%	1,268

- Notes:
- Volume calculations are based on data collected through the 20th of November 2009.
 - Volumes were computed using 1' x 1' cell center average data sets.
 - Volumes were computed using HYPACK, Inc. 2008 TIN to TIN method.
 - The volume information presented in this table are the results of multibeam surveys performed by Ocean Surveys, Inc. on the survey dates indicated and can only be considered representative of the conditions existing during that time.

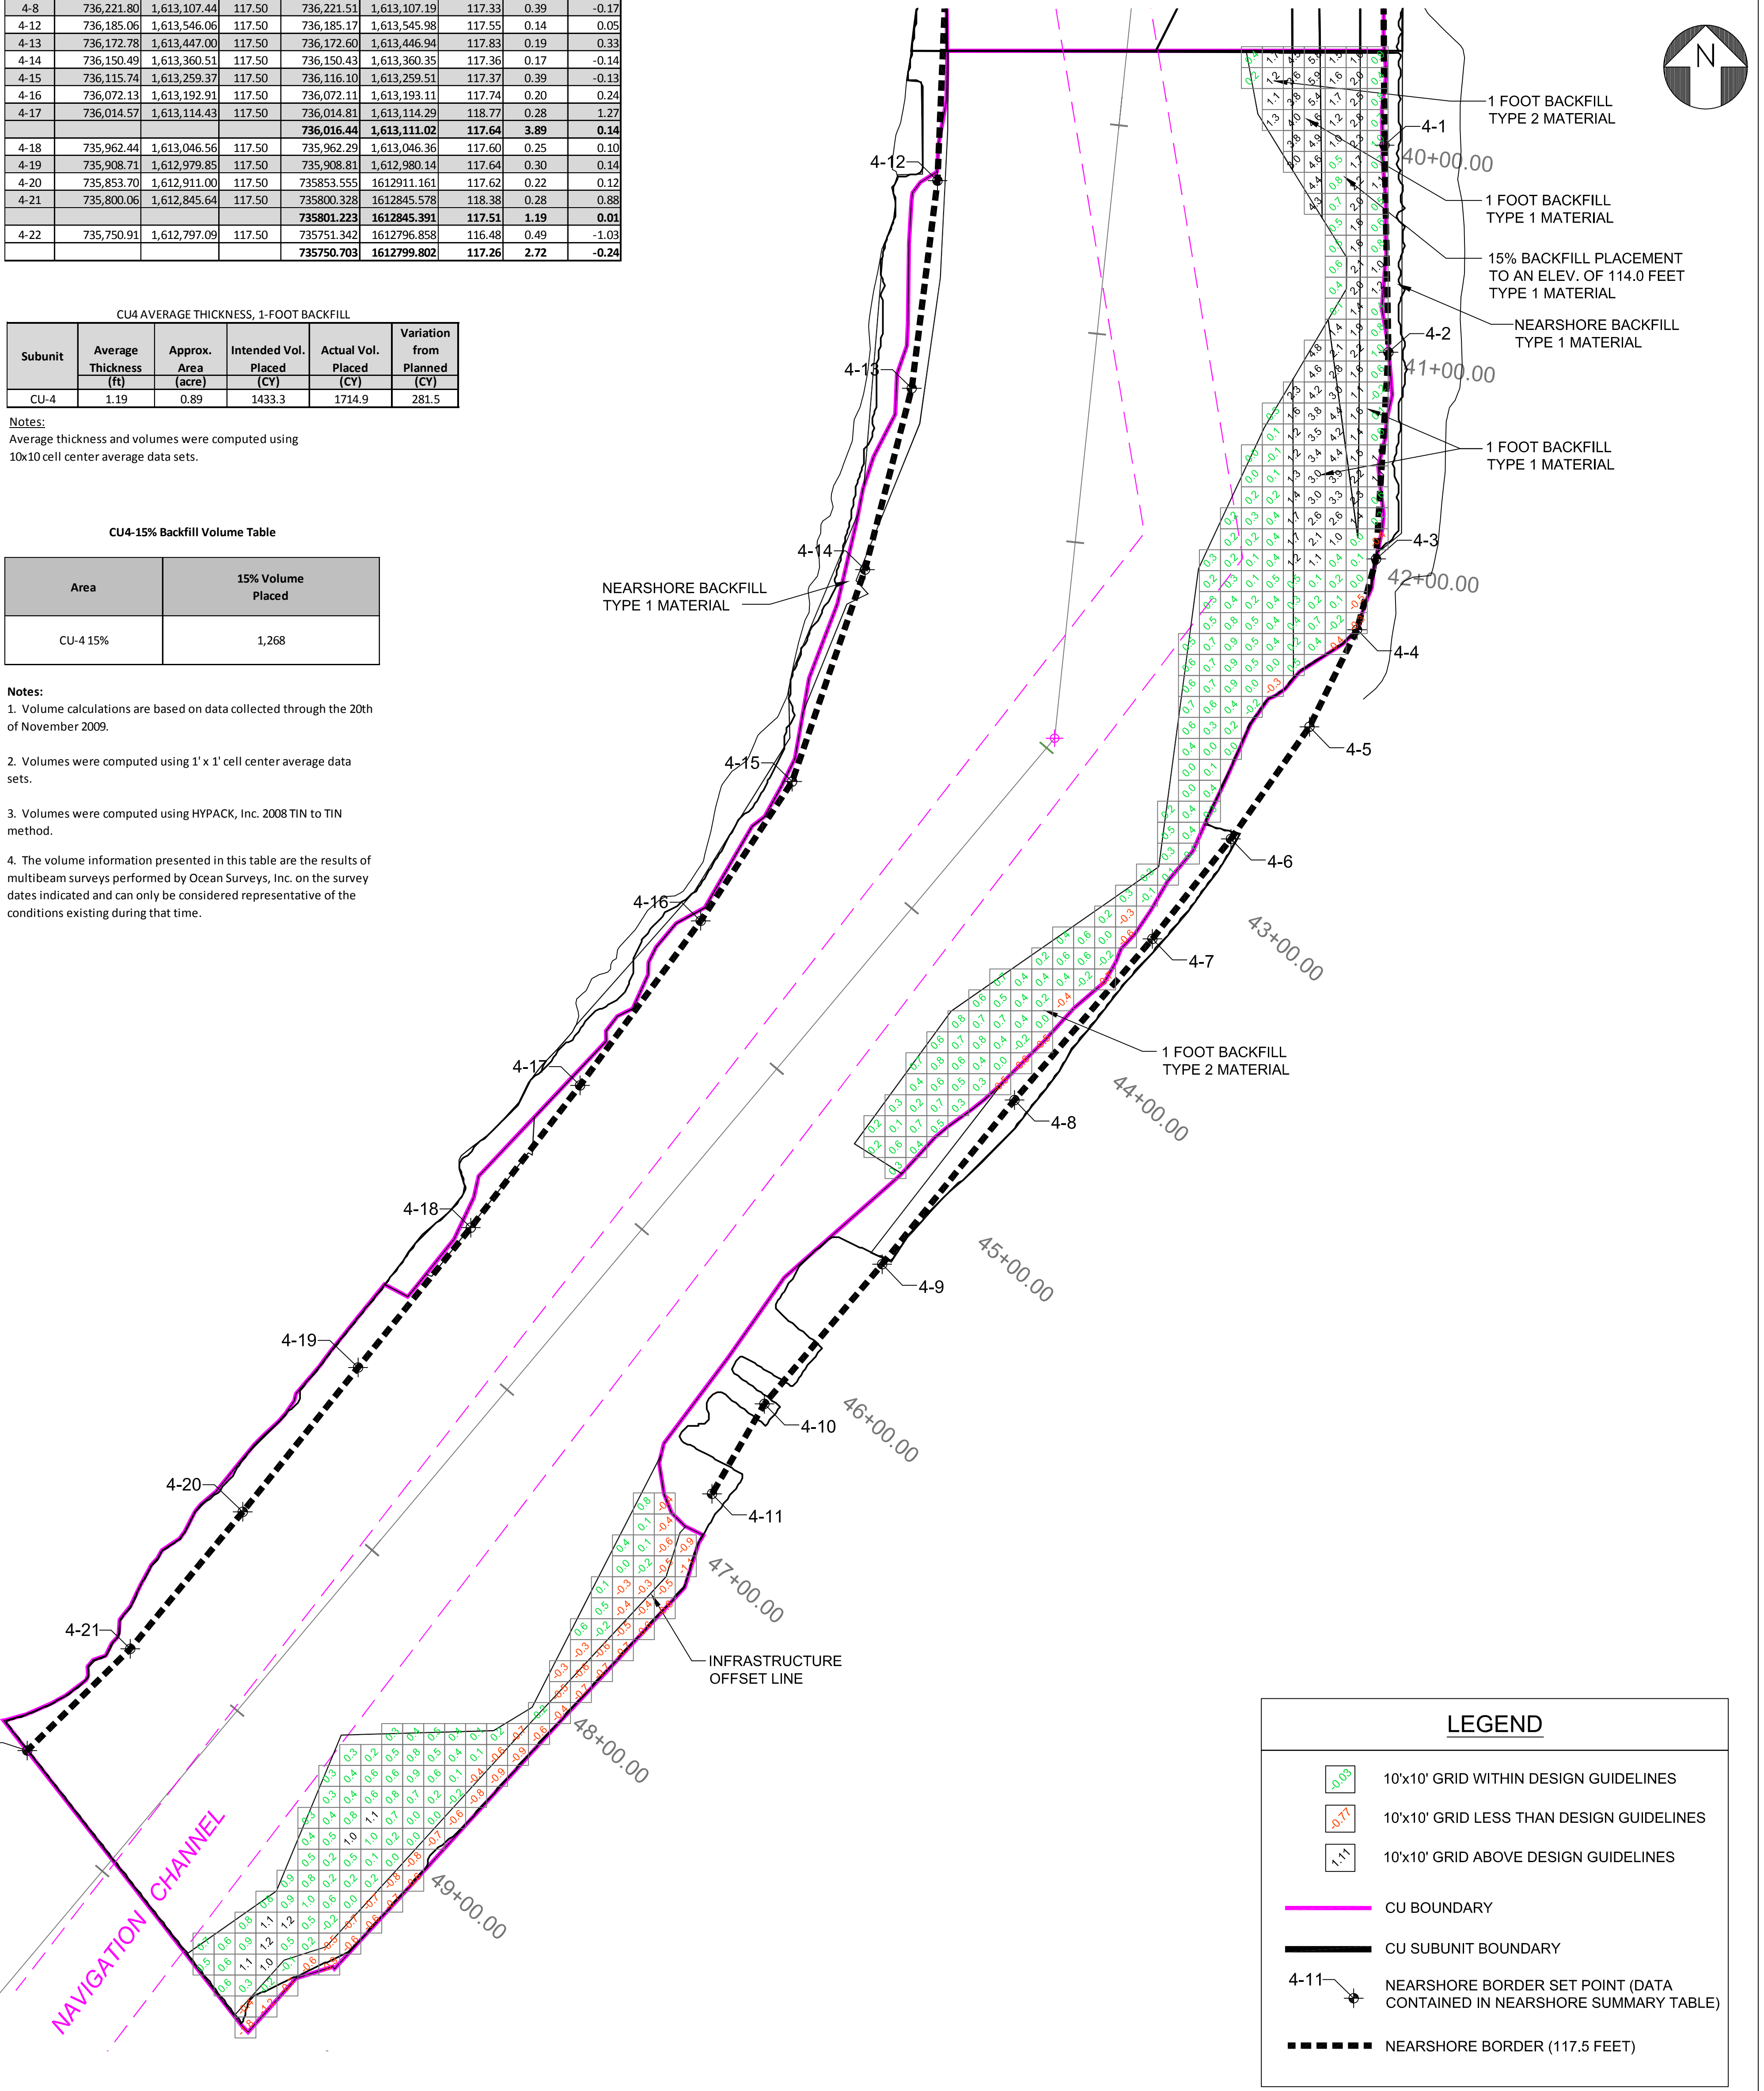

LEGEND


- 0.03 10'x10' GRID WITHIN DESIGN GUIDELINES
- 0.71 10'x10' GRID LESS THAN DESIGN GUIDELINES
- 1.11 10'x10' GRID ABOVE DESIGN GUIDELINES
- CU BOUNDARY
- CU SUBUNIT BOUNDARY
- 4-11 NEARSHORE BORDER SET POINT (DATA CONTAINED IN NEARSHORE SUMMARY TABLE)
- NEARSHORE BORDER (117.5 FEET)

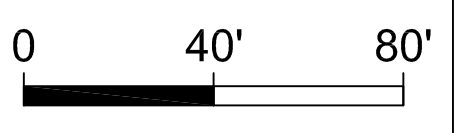


- NOTES:
- OSI MULTIBEAM SURVEYS ON NOVEMBER 12 AND 19, 2009.
 - NUMERIC VALUES IN 10'x10' GRID REPRESENT DIFFERENCE TO TARGET THICKNESS (POSITIVE NUMBERS REFLECT THICKNESS ABOVE TARGET THICKNESS). COLORS DETERMINED USING DIFFERENT BACKFILL TOLERANCES DESCRIBED IN SPEC SECTION 13720.

**CU4
1 FOOT BACKFILL, 15% BACKFILL, AND
NEARSHORE PLACEMENT
ACCEPTANCE SURVEY**

PARSONS		DRAWING TITLE	
GE COMPANY - PARSONS PROJECT OFFICE BUILDING 40-1, 381 BROADWAY FORT EDWARD, N.Y. 12828 (518) 746-5311		CU4 BACKFILL PLACEMENT ACCEPTANCE SURVEY	
DRAWN BY JHG	CHECKED BY MG	DRAWING NO. CU4-1A	SCALE AS SHOWN
DATE 11/23/09	APPROVED BY MG	JOB 442209.01401	

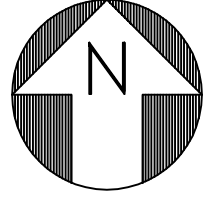

CU 4

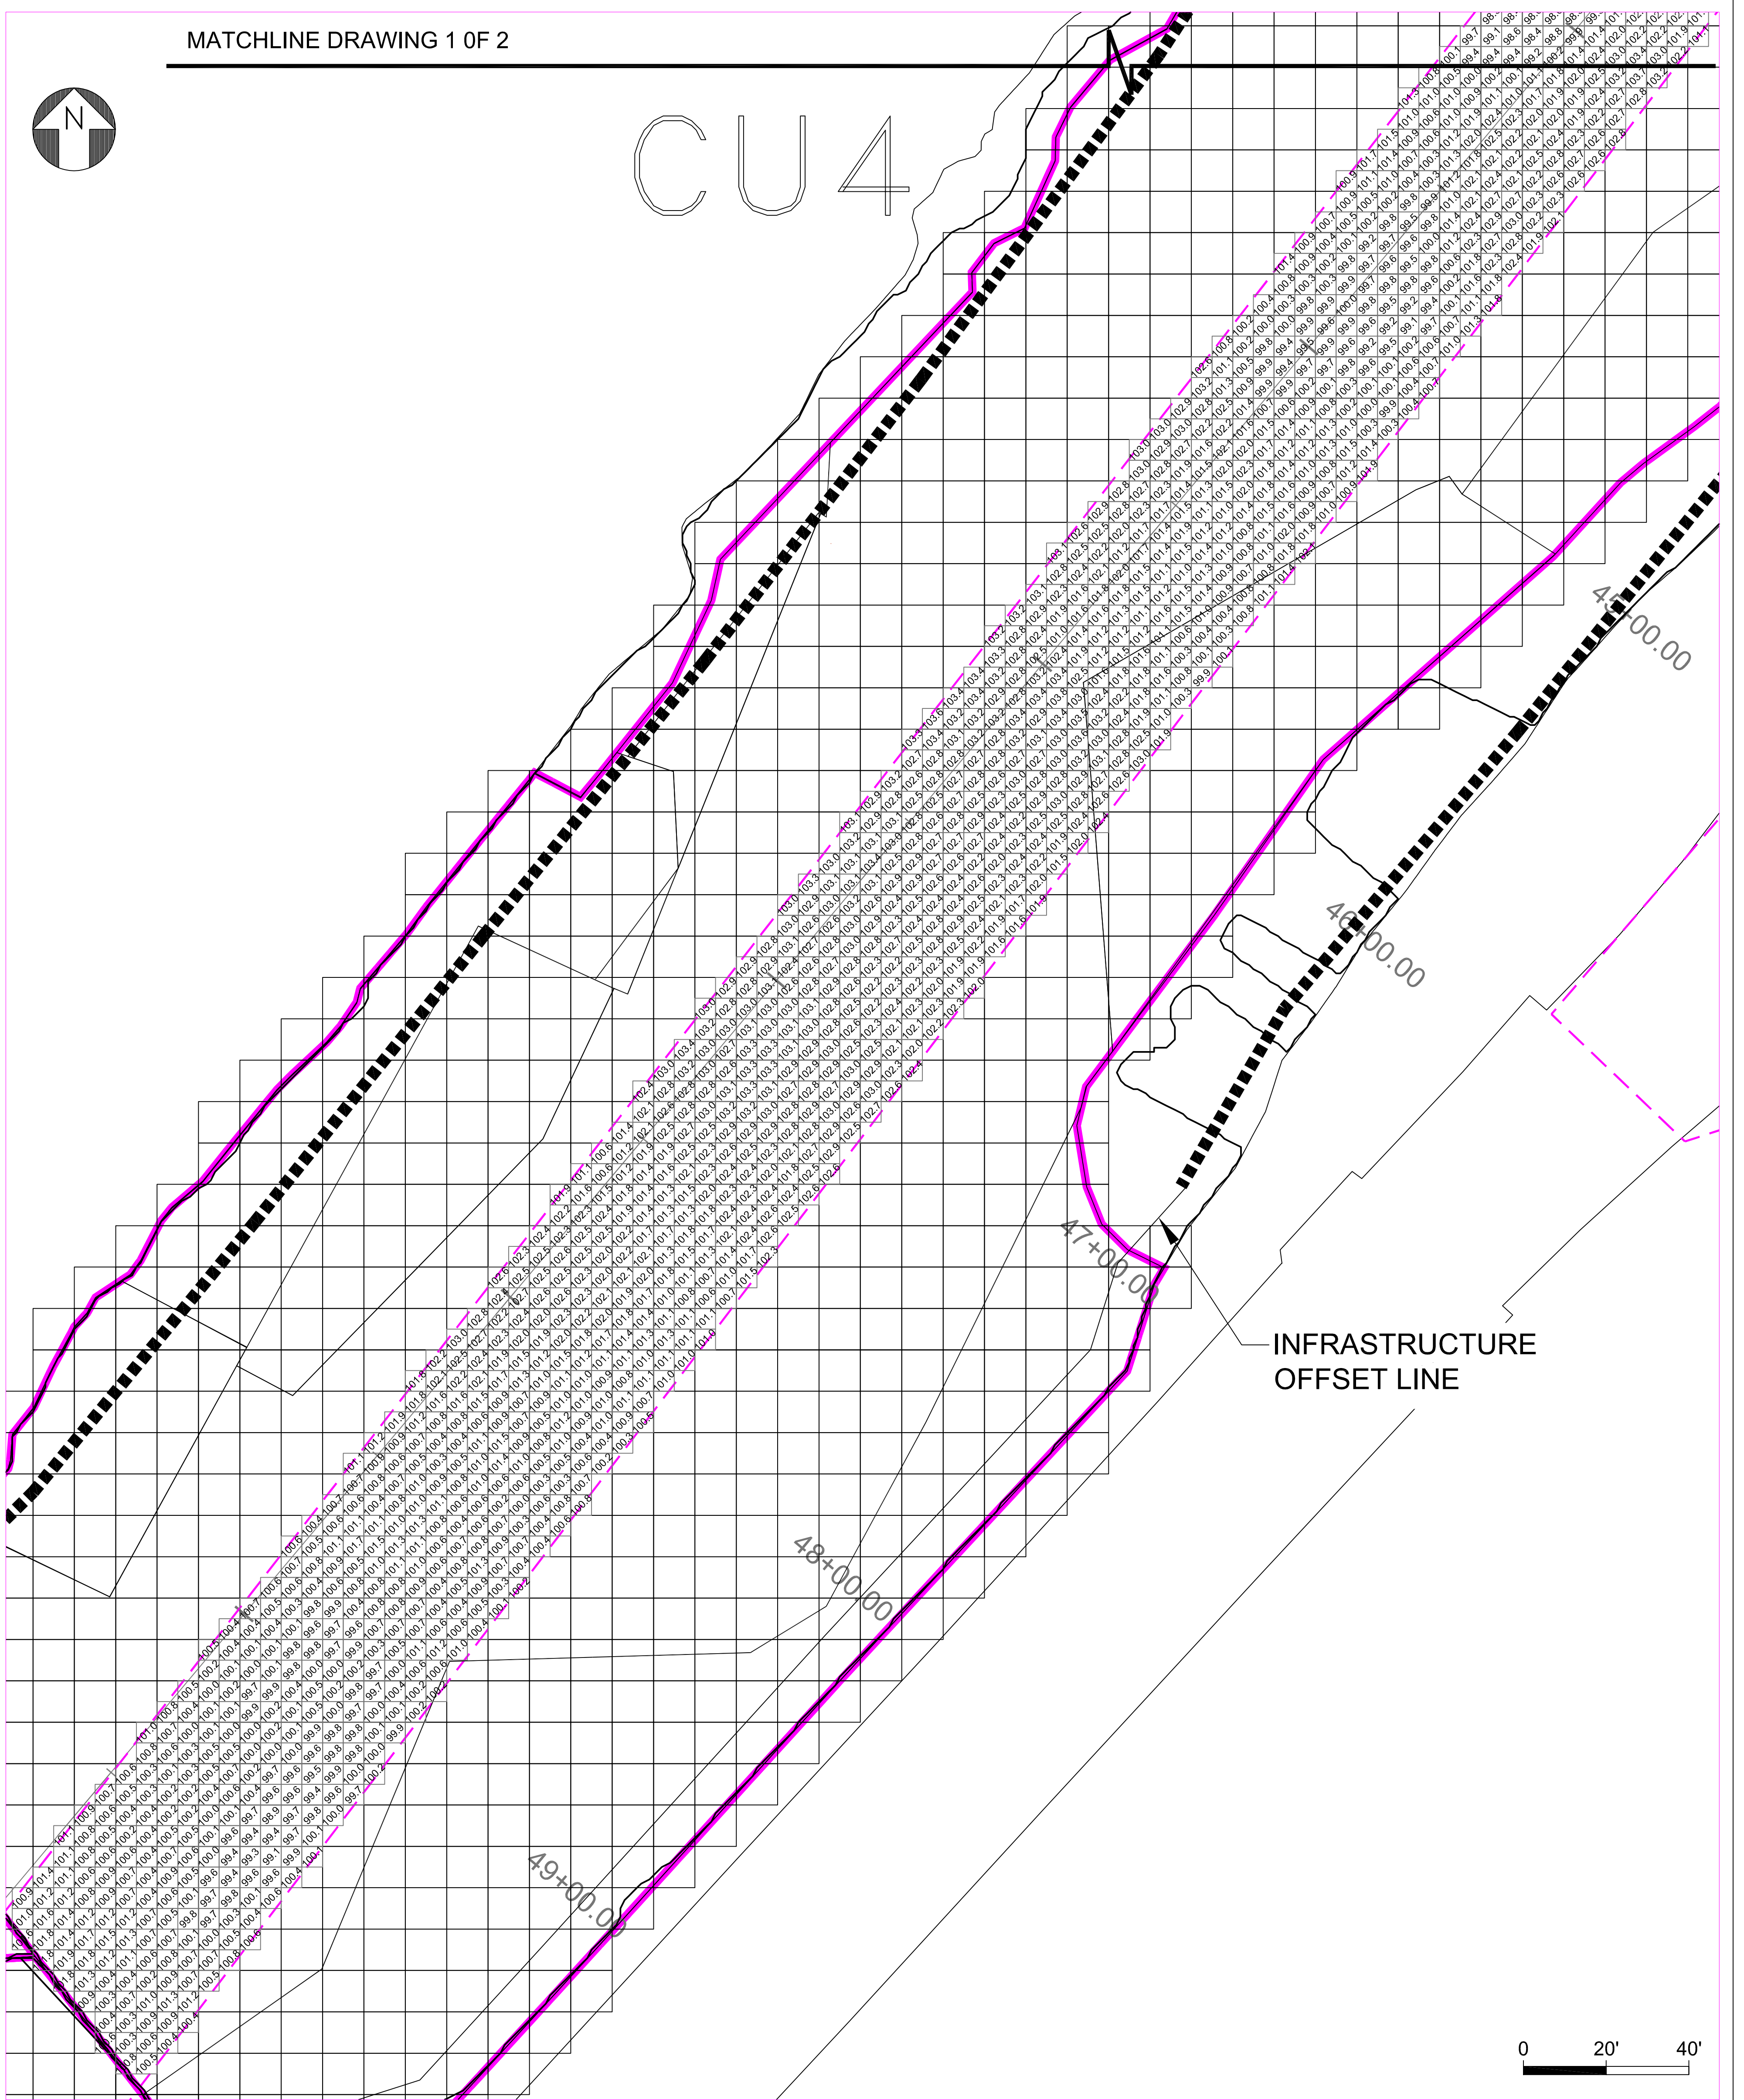

**CU4 POST BACKFILL/CAPPING
NAVIGATION CHANNEL ELEVATIONS**

LEGEND

- 104.5 5'x5' GRID ELEVATION (FT.) (/NAVD88)
- NEARSHORE BOUNDARY
- CU BOUNDARY
- CU SUBUNIT BOUNDARY
- MUD - RIP RAP INTERFACE
- 5' INTERFACE OFFSET

NOTES:

1. OSI MULTIBEAM SURVEY ON NOVEMBER 18, 2009.
2. NAVIGATION CHANNEL ELEVATIONS ARE SHOWN ON 5'x5' GRIDS.

DRAWING 2 OF 2







PARSONS GE COMPANY - PARSONS PROJECT OFFICE BUILDING 40-1, 381 BROADWAY FORT EDWARD, N.Y. 12828 (518) 746-5311		DRAWING TITLE	
		CU4 NAVIGATION CHANNEL ELEVATIONS	
DRAWN BY	CHECKED BY	DRAWING NO.	VERSION/SCALE
JHC	MG	CU4-1-2	A AS SHOWN
DATE	APPROVED BY	442209.01401	
11/23/09	MG		



**CU4 POST BACKFILL/CAPPING
NAVIGATION CHANNEL ELEVATIONS**

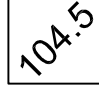
NOTES:

1. OSI MULTIBEAM SURVEY ON NOVEMBER 18, 2009.
2. NAVIGATION CHANNEL ELEVATIONS ARE SHOWN ON 5'x5' GRIDS.

LEGEND	
	5'x5' GRID ELEVATION (FT.) (/NAVD88)
	NEARSHORE BOUNDARY
	CU BOUNDARY
	CU SUBUNIT BOUNDARY
	MUD - RIP RAP INTERFACE
	5' INTERFACE OFFSET


DRAWING 1 OF 2

PARSONS GE COMPANY - PARSONS PROJECT OFFICE BUILDING 40-1, 381 BROADWAY FORT EDWARD, N.Y. 12828 (518) 746-5311	DRAWING TITLE	
	CU4 NAVIGATION CHANNEL ELEVATIONS	
DRAWN BY	CHECKED BY	DRAWING NO.
JHC	MG	CU4-1-1
DATE	APPROVED BY	SCALE
11/23/09	MG	AS SHOWN
		JOB
		442209.01401

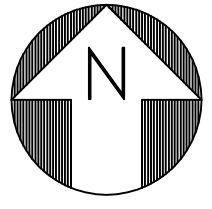

LEGEND	
	5'x5' GRID WITHIN DESIGN GUIDELINES
	5'x5' GRID LESS THAN DESIGN GUIDELINES
	5'x5' GRID ABOVE DESIGN GUIDELINES
	NEARSHORE BOUNDARY
	CU BOUNDARY
	MUD - RIP RAP INTERFACE
	5' INTERFACE OFFSET


TYPE "B" MEDIUM VELOCITY CAP

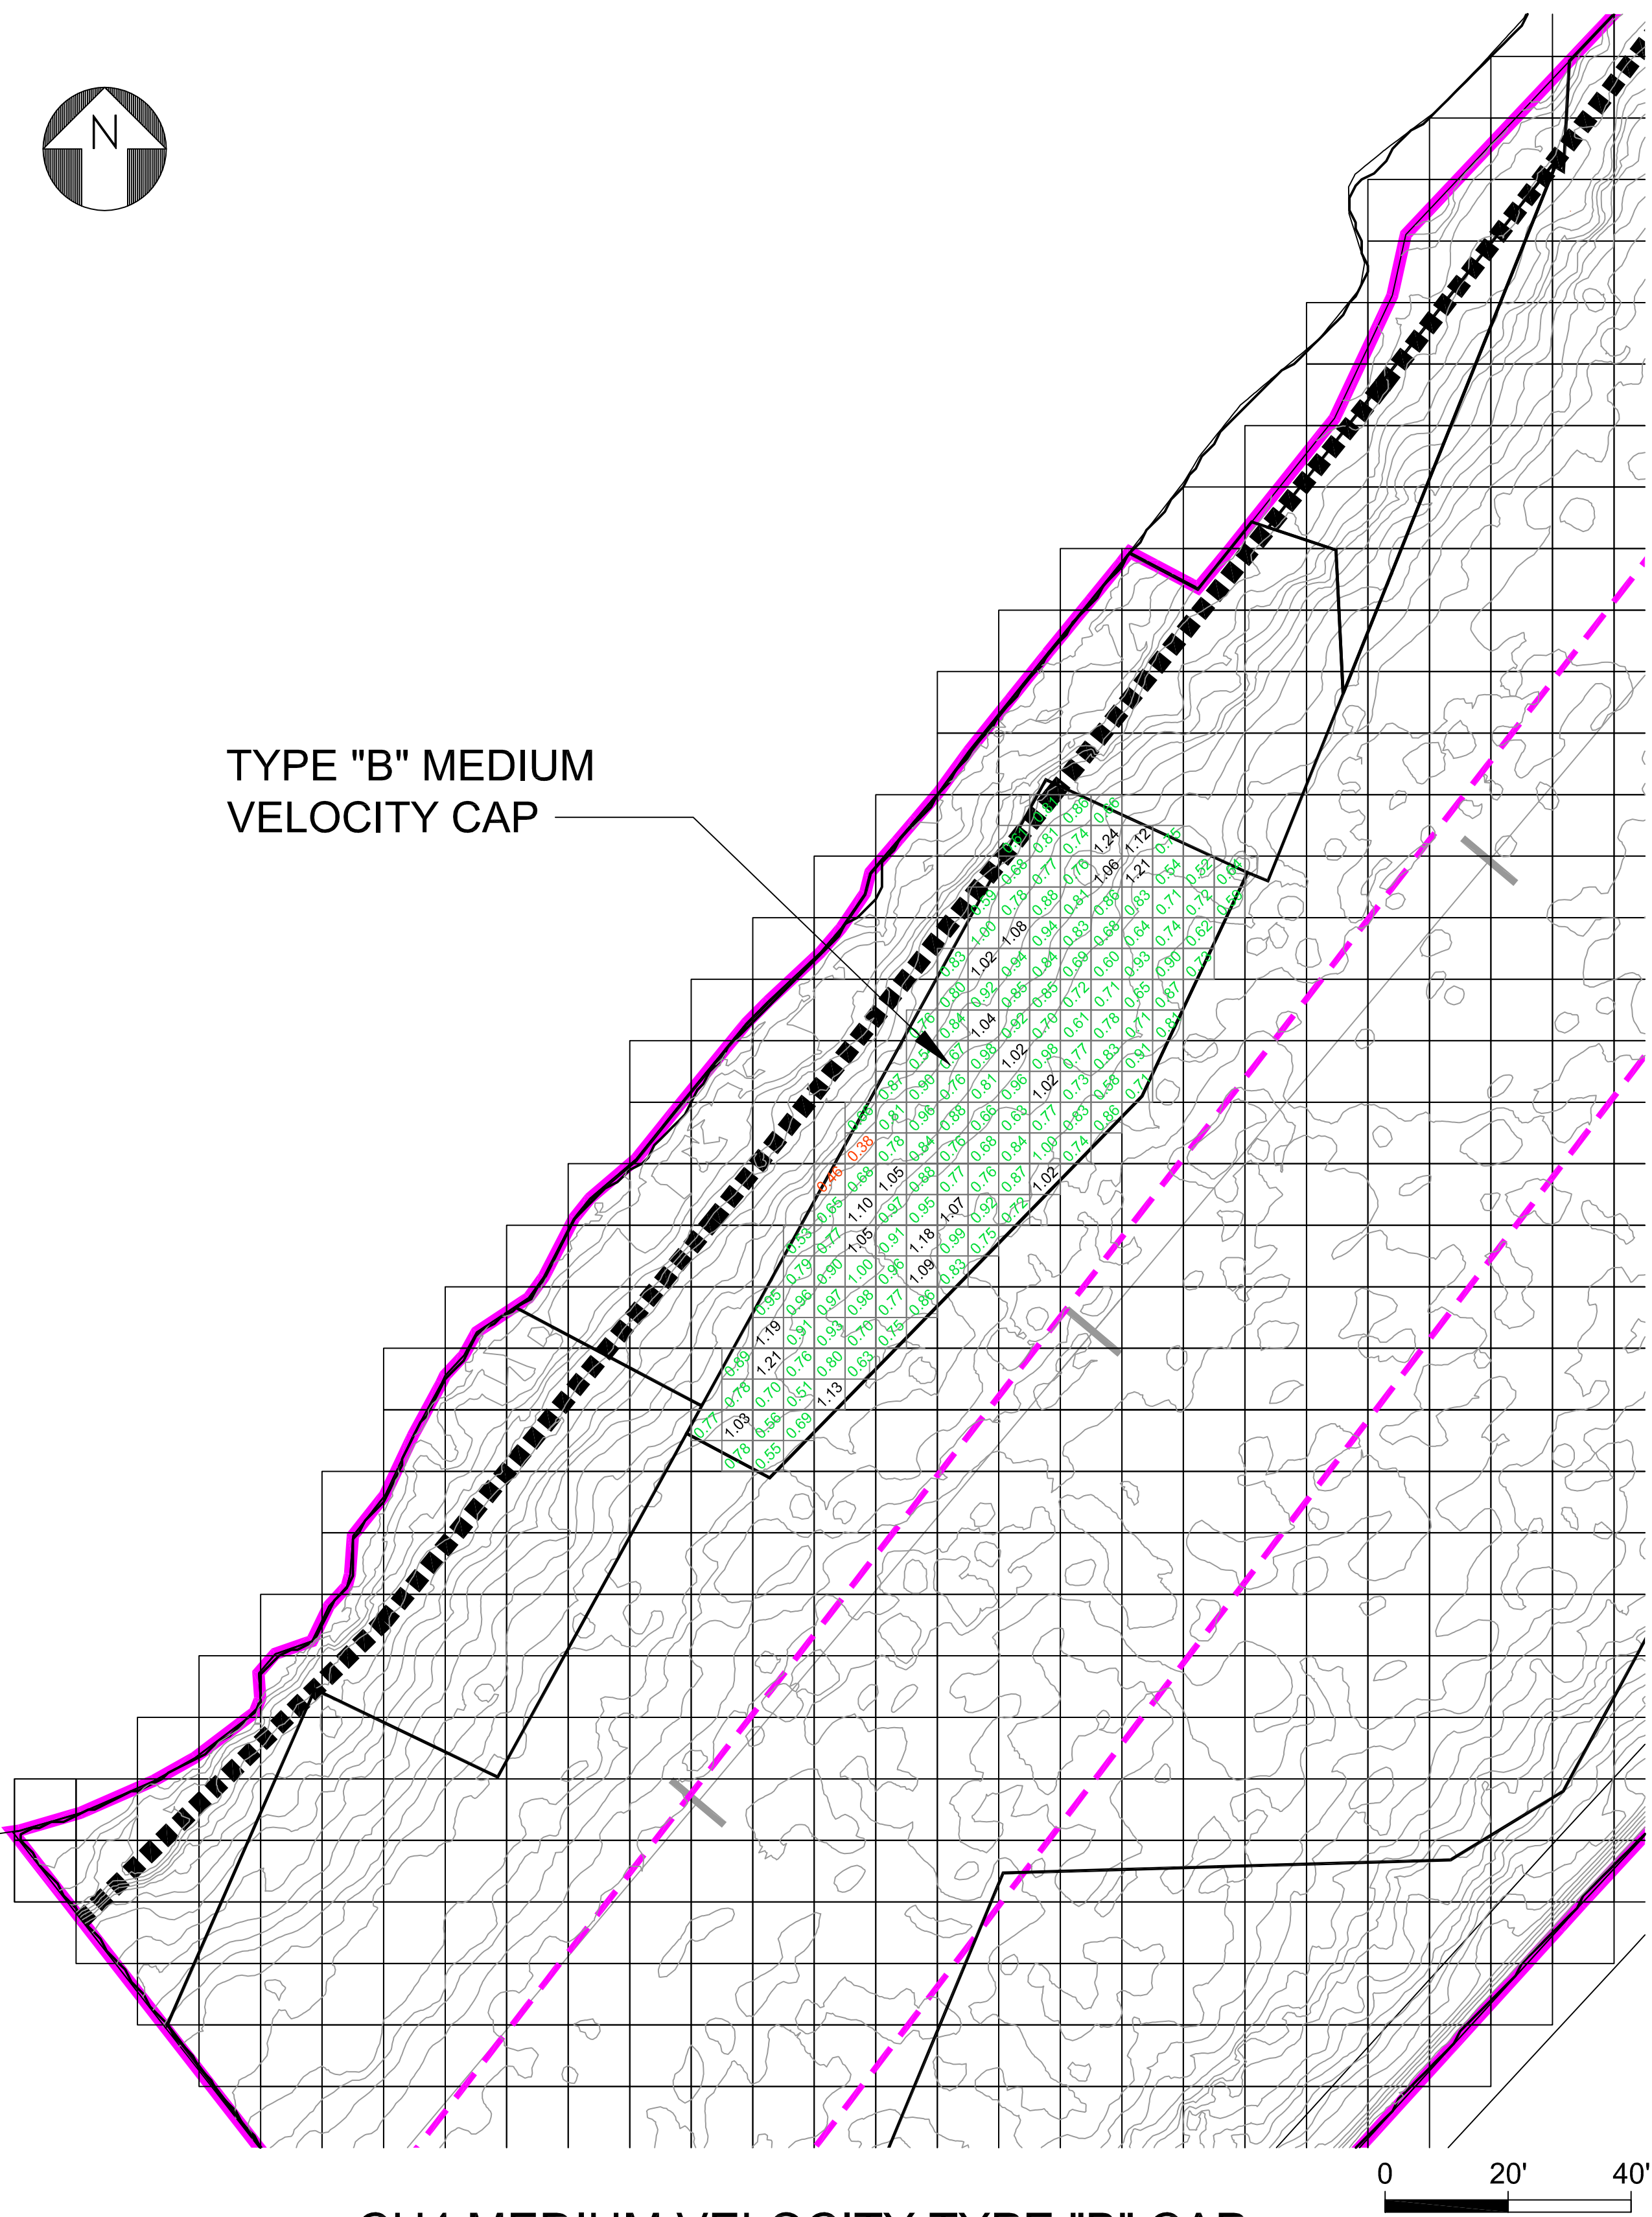


CU4 MEDIUM VELOCITY TYPE "B" CAP
TYPE "N" COARSE GRAVEL THICKNESS (FT.)

NOTES:

1. OSI MULTIBEAM SURVEY ON NOVEMBER 13, 16, AND 20, 2009.
2. ARMOR LAYER THICKNESS IS LISTED IN 5'x5' GRIDS.

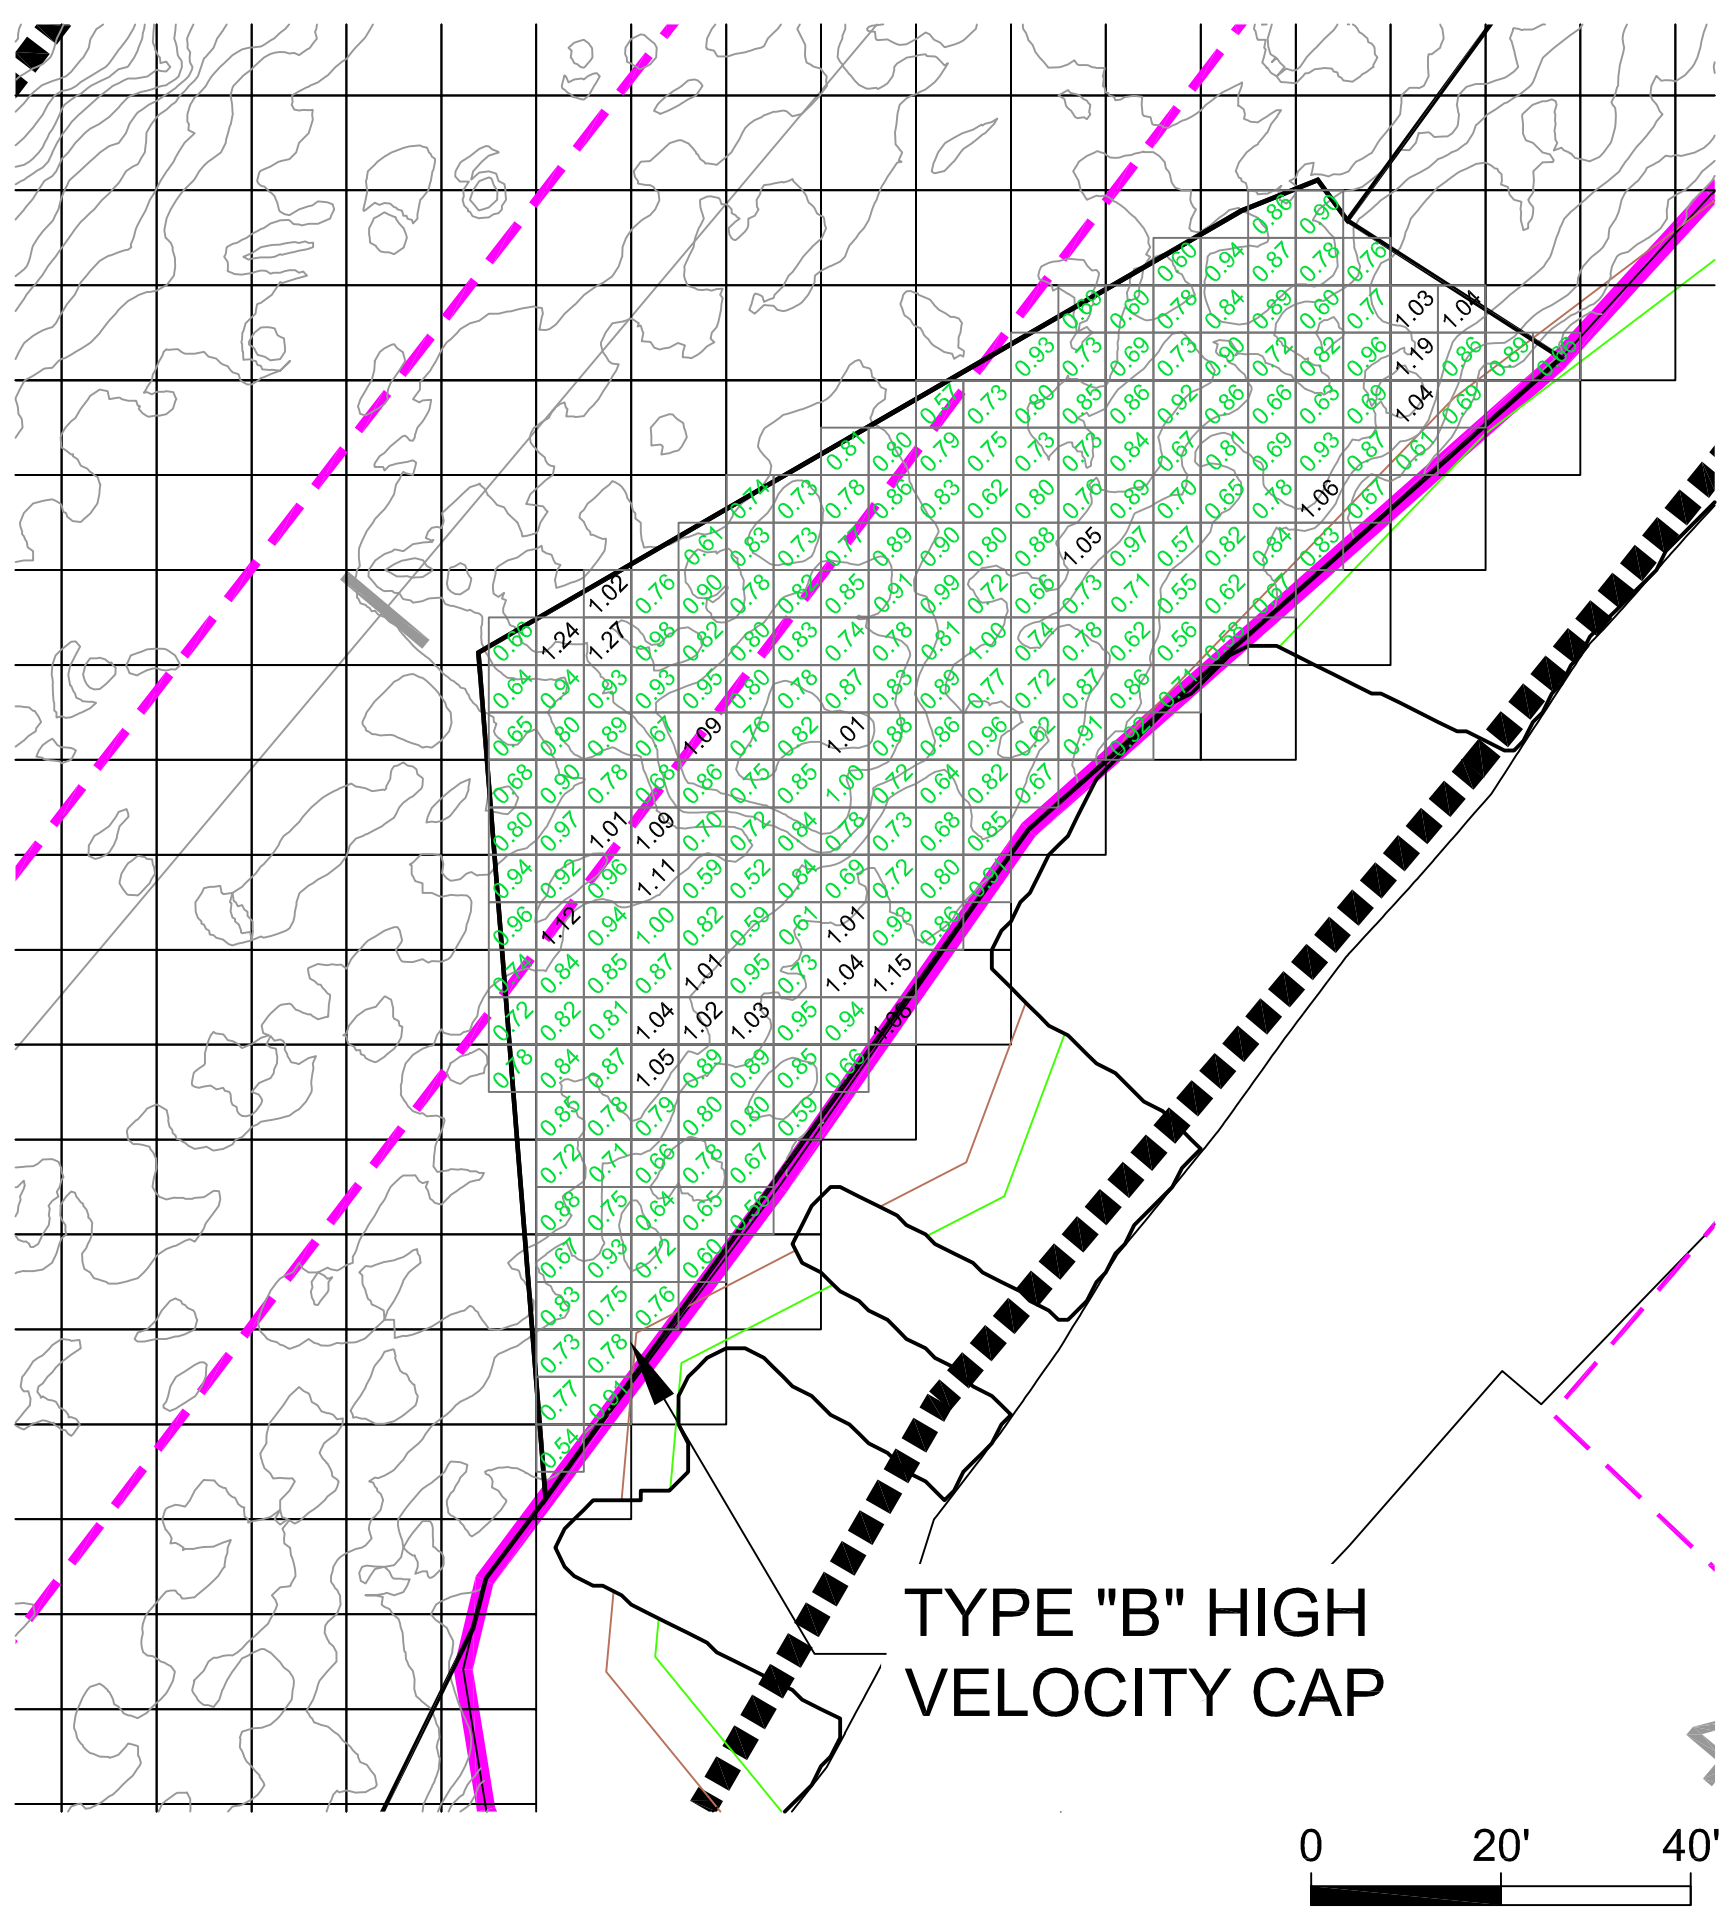

CU4 HIGH VELOCITY TYPE "B" CAP
TYPE "O" COBBLE ARMOR THICKNESS (FT.)

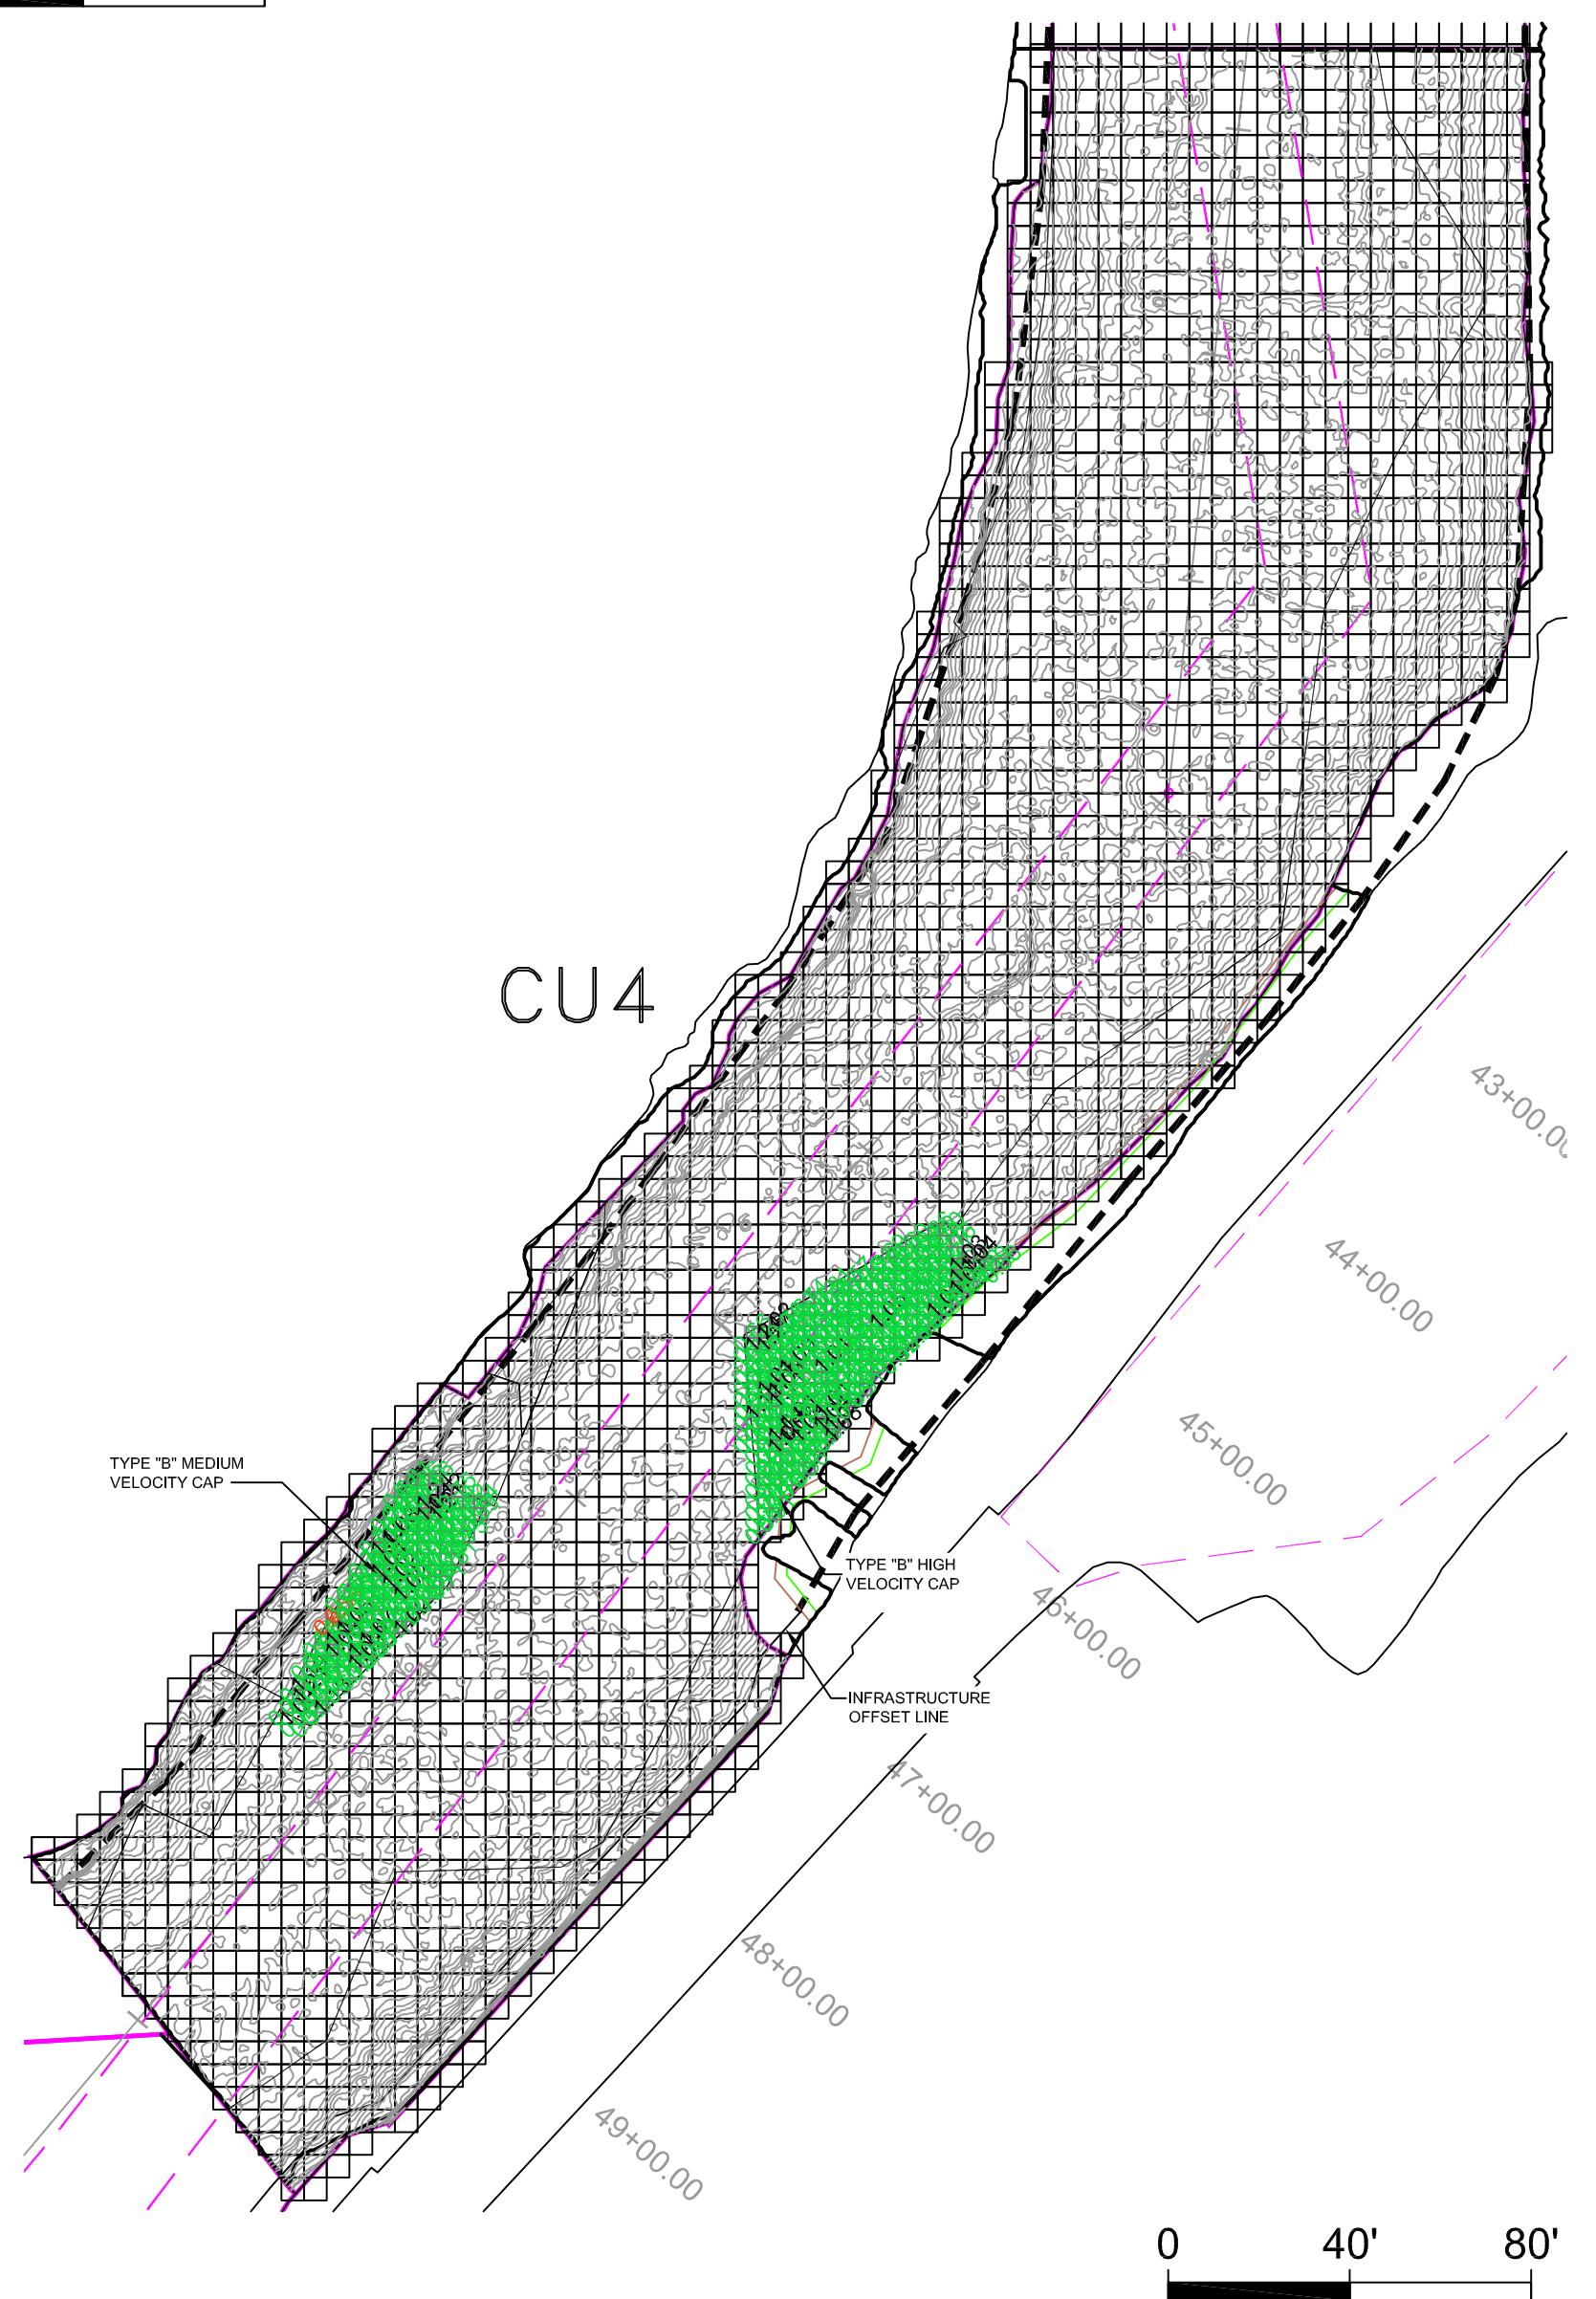


CU4 LOCATION PLAN

PARSONS COMMERCIAL TECHNOLOGY GROUP		DRAWING TITLE	
GE COMPANY - PARSONS PROJECT OFFICE BUILDING 40-1, 381 BROADWAY FORT EDWARD, N.Y. 12828 (518) 746-5311		CU4 TYPE "B" CAP ARMOR LAYER ACCEPTANCE SURVEY	
DRAWN BY JHC	CHECKED BY MG	DRAWING NO. CU4-1	SCALE AS SHOWN
DATE 11/23/09	APPROVED BY MG	JOB 442209.01401	

LEGEND

- 0.80 GRID WITHIN DESIGN GUIDELINES
- 0.65 GRID LESS THAN DESIGN GUIDELINES
- 1.60 GRID GREATER THAN DESIGN GUIDELINES
- CU BOUNDARY
- MUD - RIP RAP INTERFACE
- 5 FOOT INTERFACE OFFSET
- 1 FOOT CONTOURS, POST DREDGE SURFACE

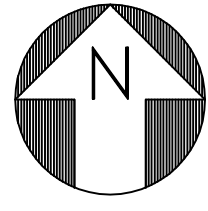

CU 4

TYPE "B" LOW VELOCITY
CAP THICKNESS (FT.)
(5'x5' GRID)

TYPE "B" MEDIUM VELOCITY
CAP - ISOLATION LAYER
THICKNESS (FT.)
(10'x10' GRID)

TYPE "B" HIGH VELOCITY CAP -
ISOLATION LAYER
THICKNESS (FT.)
(10'x10' GRID)

INFRASTRUCTURE
OFFSET LINE

NOTES:


1. OSI MULTIBEAM SURVEY ON NOVEMBER 12 & 13, 2009.
2. THICKNESS OF ISOLATION LAYER IS LISTED ON A 10'x10' GRID FOR HIGH AND MEDIUM VELOCITY TYPE "B" CAPS.
3. THICKNESS OF CAP IS LISTED ON A 5'x5' GRID FOR LOW VELOCITY TYPE "B" CAP.



PARSONS <small>COMMERCIAL TRADING GROUP</small>		DRAWING TITLE	
GE COMPANY - PARSONS PROJECT OFFICE BUILDING 40-1, 381 BROADWAY FORT EDWARD, N.Y. 12828 (518) 746-5311		CU4 TYPE "B" CAP ISOLATION LAYER ACCEPTANCE SURVEY	
DRAWN BY JHC	CHECKED BY MG	DRAWING NO. CU4-1	SCALE AS SHOWN
DATE 11/23/09	APPROVED BY MG	JOB 442209.01401	

LEGEND


- 1.8 5'x5' GRID WITHIN DESIGN GUIDELINES
- 0.1 5'x5' GRID LESS THAN DESIGN GUIDELINES
- 2.2 5'x5' GRID ABOVE DESIGN GUIDELINES
- NEARSHORE BOUNDARY
- CU BOUNDARY
- CU SUBUNIT BOUNDARY
- MUD - RIP RAP INTERFACE
- 5' INTERFACE OFFSET
- 1 FOOT CONTOURS, POST DREDGE SURFACE

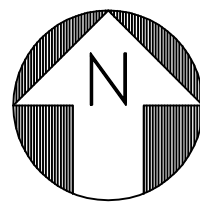

NOTES:

1. OSI MULTIBEAM SURVEY ON NOVEMBER 18, 2009.
2. CAP THICKNESS IS LISTED IN 5'x5' GRIDS.

**CU4 TYPE "A" CAP THICKNESS (FT.)
NORTH END**

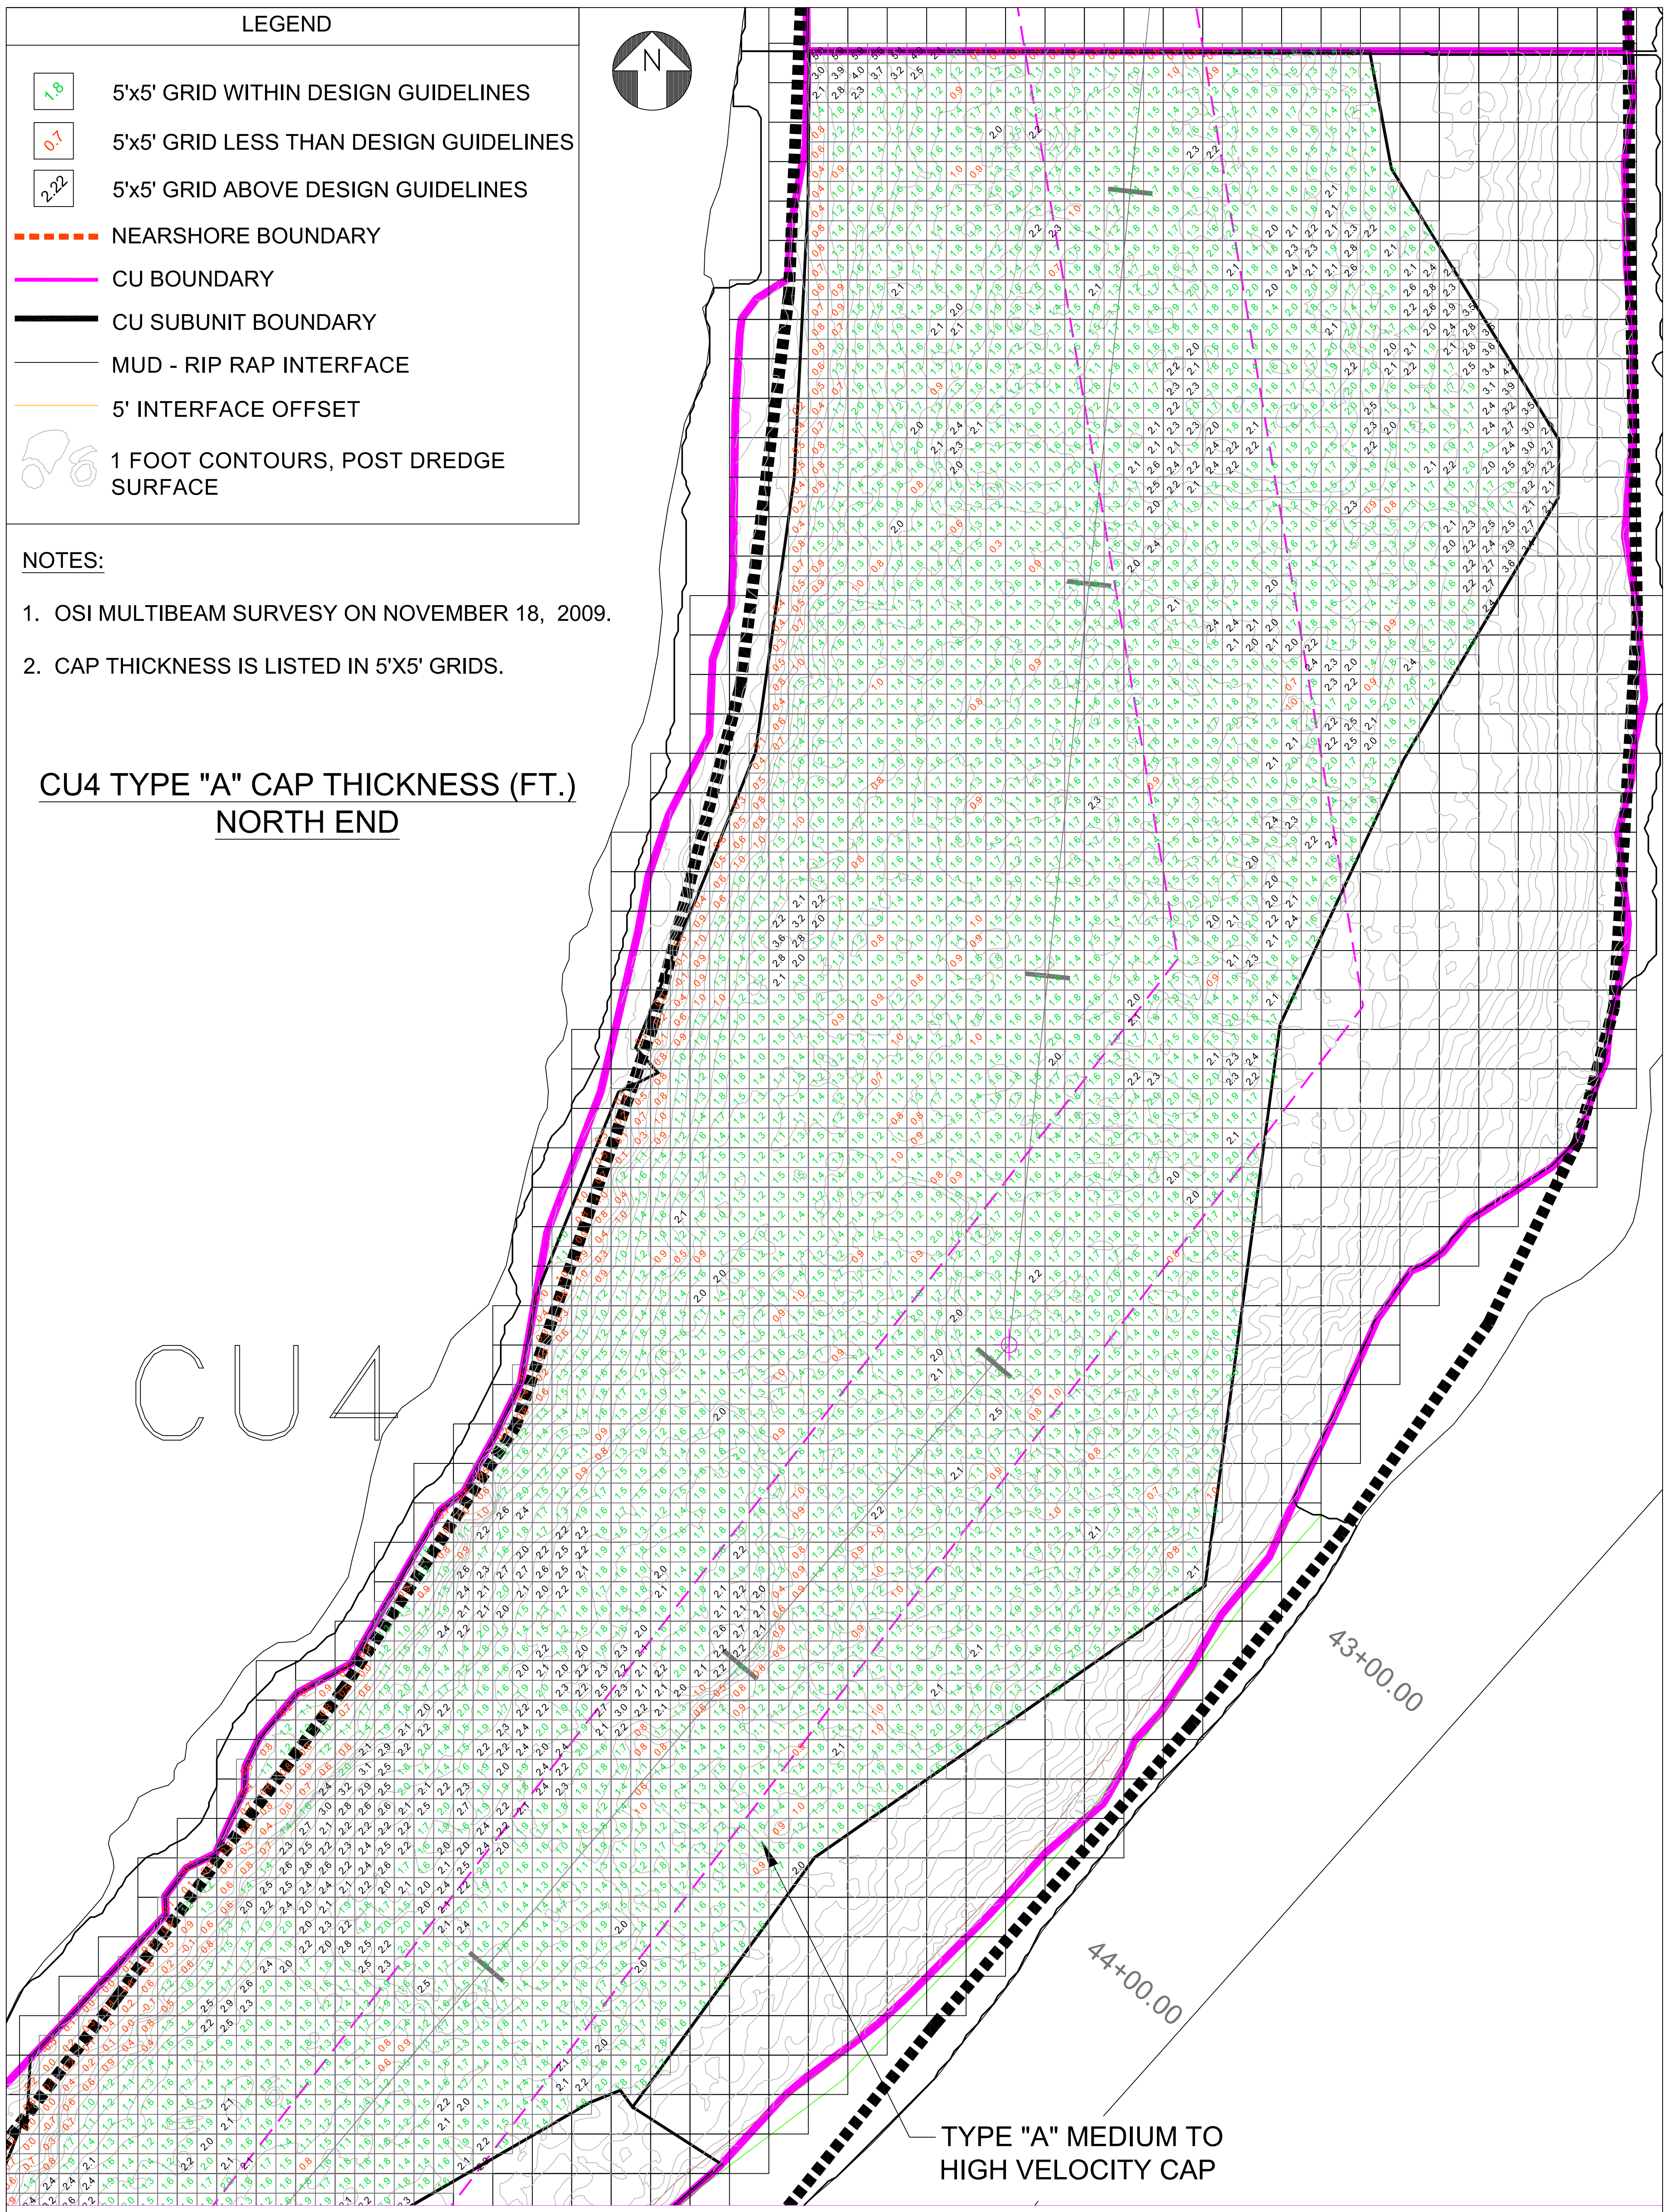


TYPE "A" MEDIUM TO HIGH VELOCITY CAP

DRAWING 1 OF 2



PARSONS <small>CONSTRUCTION SERVICES</small>		DRAWING TITLE	
GE COMPANY - PARSONS PROJECT OFFICE BUILDING 40-1, 381 BROADWAY FORT EDWARD, N.Y. 12828 (518) 746-5311		CU4 TYPE "A" CAP ACCEPTANCE SURVEY	
DRAWN BY JHC	CHECKED BY MG	DRAWING NO. CU4-3-1	SCALE AS SHOWN
DATE 11/23/09	APPROVED BY MG	JOB# 442209.01401	

LEGEND

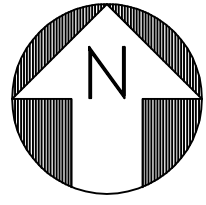

- 1.8 5'x5' GRID WITHIN DESIGN GUIDELINES
- 0.1 5'x5' GRID LESS THAN DESIGN GUIDELINES
- 2.2 5'x5' GRID ABOVE DESIGN GUIDELINES
- NEARSHORE BOUNDARY
- CU BOUNDARY
- CU SUBUNIT BOUNDARY
- MUD - RIP RAP INTERFACE
- 5' INTERFACE OFFSET
- 1 FOOT CONTOURS, POST DREDGE SURFACE

NOTES:

1. OSI MULTIBEAM SURVEYS ON NOVEMBER 18, 2009.
2. CAP THICKNESS IS LISTED IN 5'x5' GRIDS.

CU4 TYPE "A" CAP THICKNESS (FT.)
SOUTH END

TYPE "A" LOW VELOCITY CAP

TYPE "A" LOW VELOCITY CAP

INFRASTRUCTURE OFFSET LINE


TYPE "A" MEDIUM TO HIGH VELOCITY CAP

46+00.00
47+00.00
48+00.00
49+00.00

DRAWING 2 OF 2



PARSONS GE COMPANY - PARSONS PROJECT OFFICE BUILDING 40-1, 381 BROADWAY FORT EDWARD, N.Y. 12828 (518) 746-5311		DRAWING TITLE CU4 TYPE "A" CAP ACCEPTANCE SURVEY	
DRAWN BY JHC	CHECKED BY MG	DRAWING NO. CU4-3-2	SCALE AS SHOWN
DATE 11/23/09	APPROVED BY MG	JOB 442209.01401	



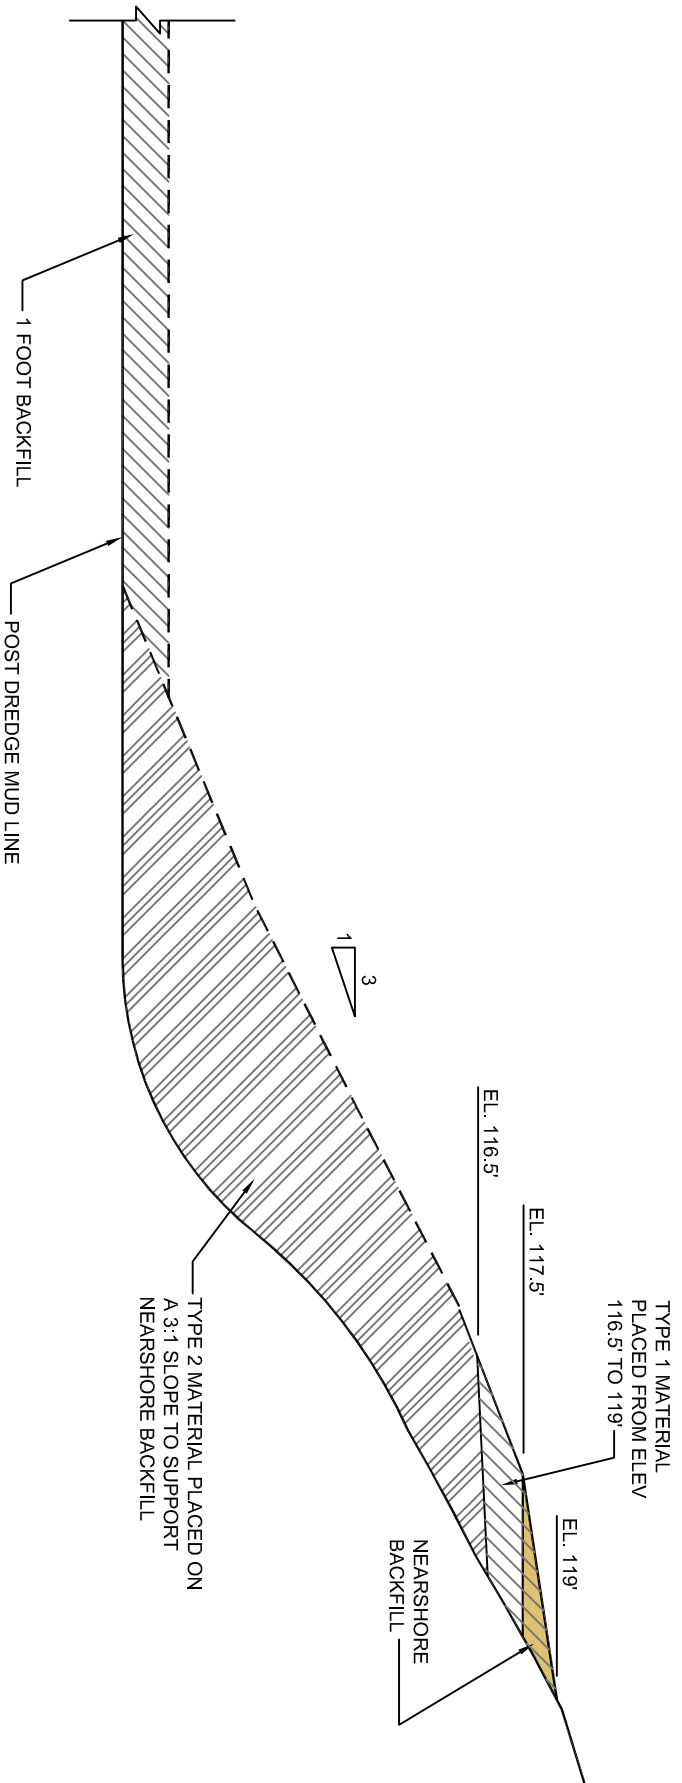


NEAR SHORE BACKFILL PLACEMENT DETAIL

TYPICAL SECTION NOT TO SCALE

RECORD
DRAWING

PARSONS <small>COMMERCIAL TECHNOLOGY GROUP</small>		DRAWING TITLE CU4 NEAR SHORE BACKFILL PLACEMENT DETAIL	
GE COMPANY - PARSONS PROJECT OFFICE BUILDING 40-1, 381 BROADWAY FORT EDWARD, N.Y. 12828 (518) 746-5311		CHECKED BY MG	
DRAIN BY JHG		APPROVED BY MG	
DATE 11/03/09		DRAWING NO. CO4-BF-CO1	
		SCALE NOT TO SCALE JOB 442209	

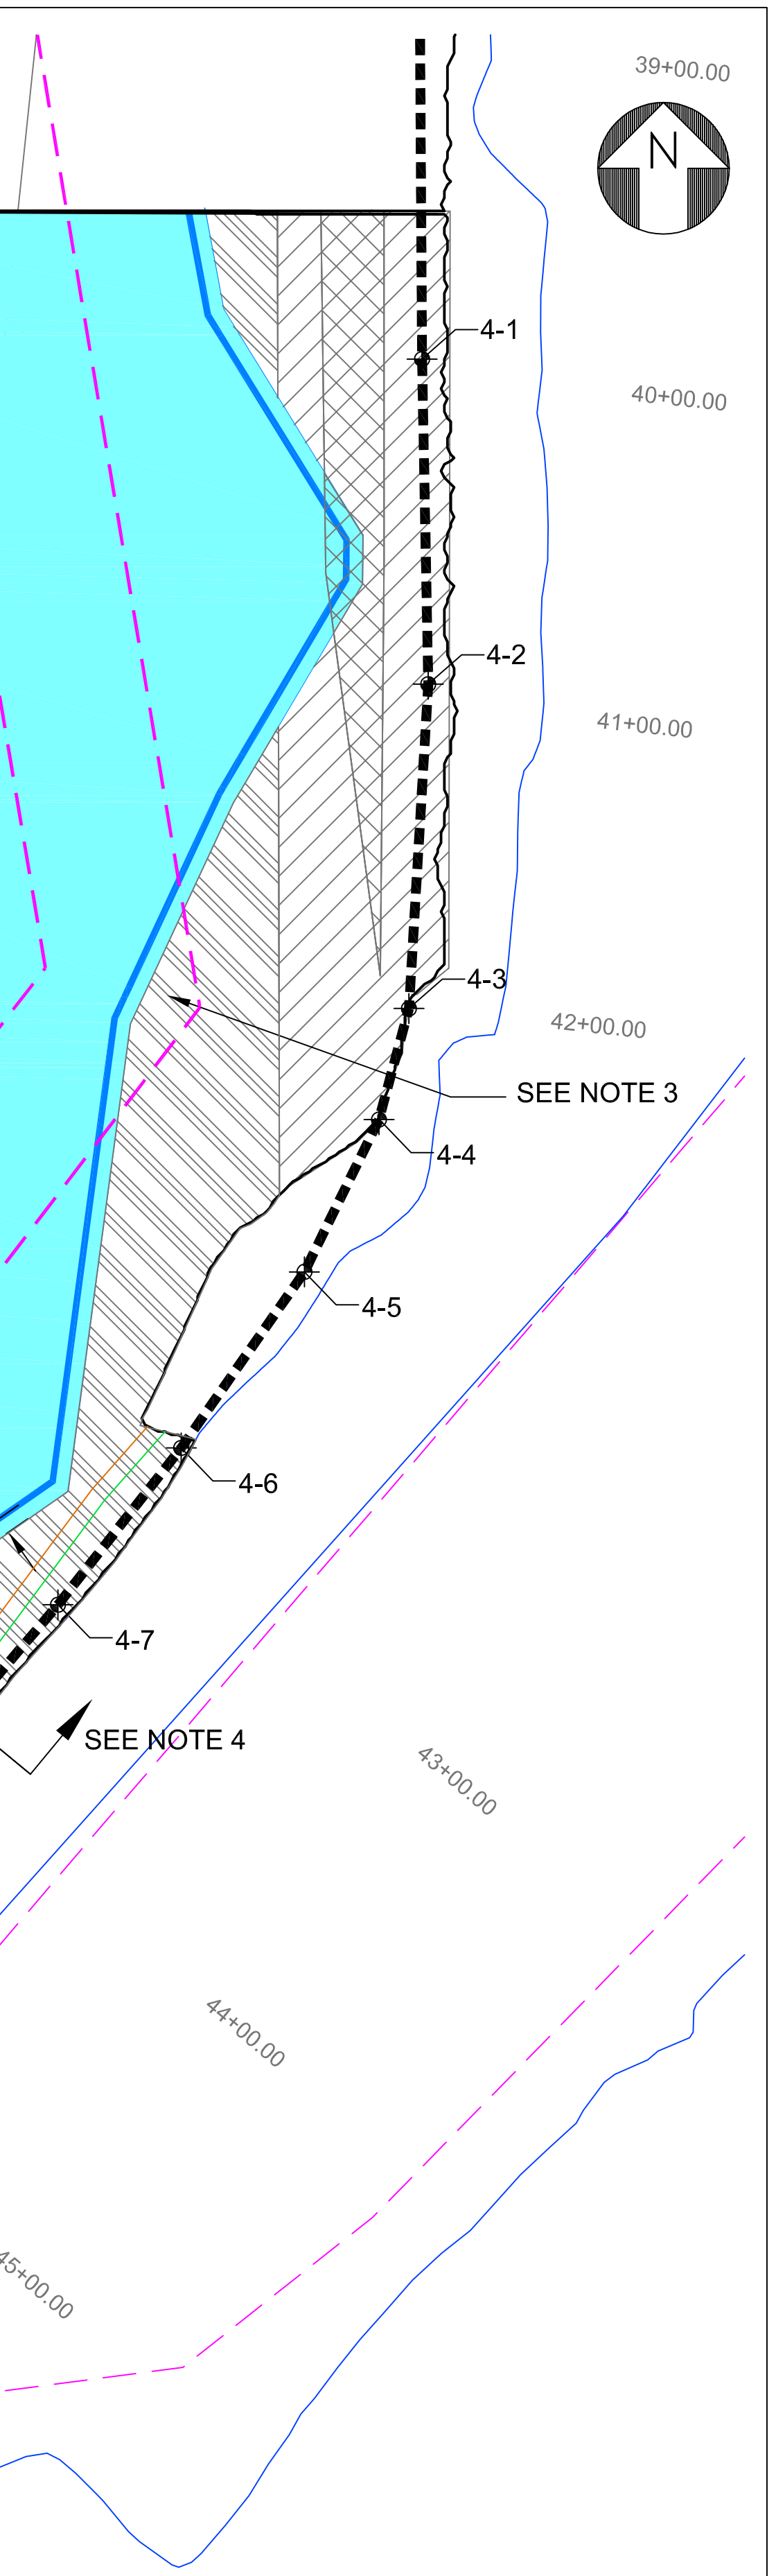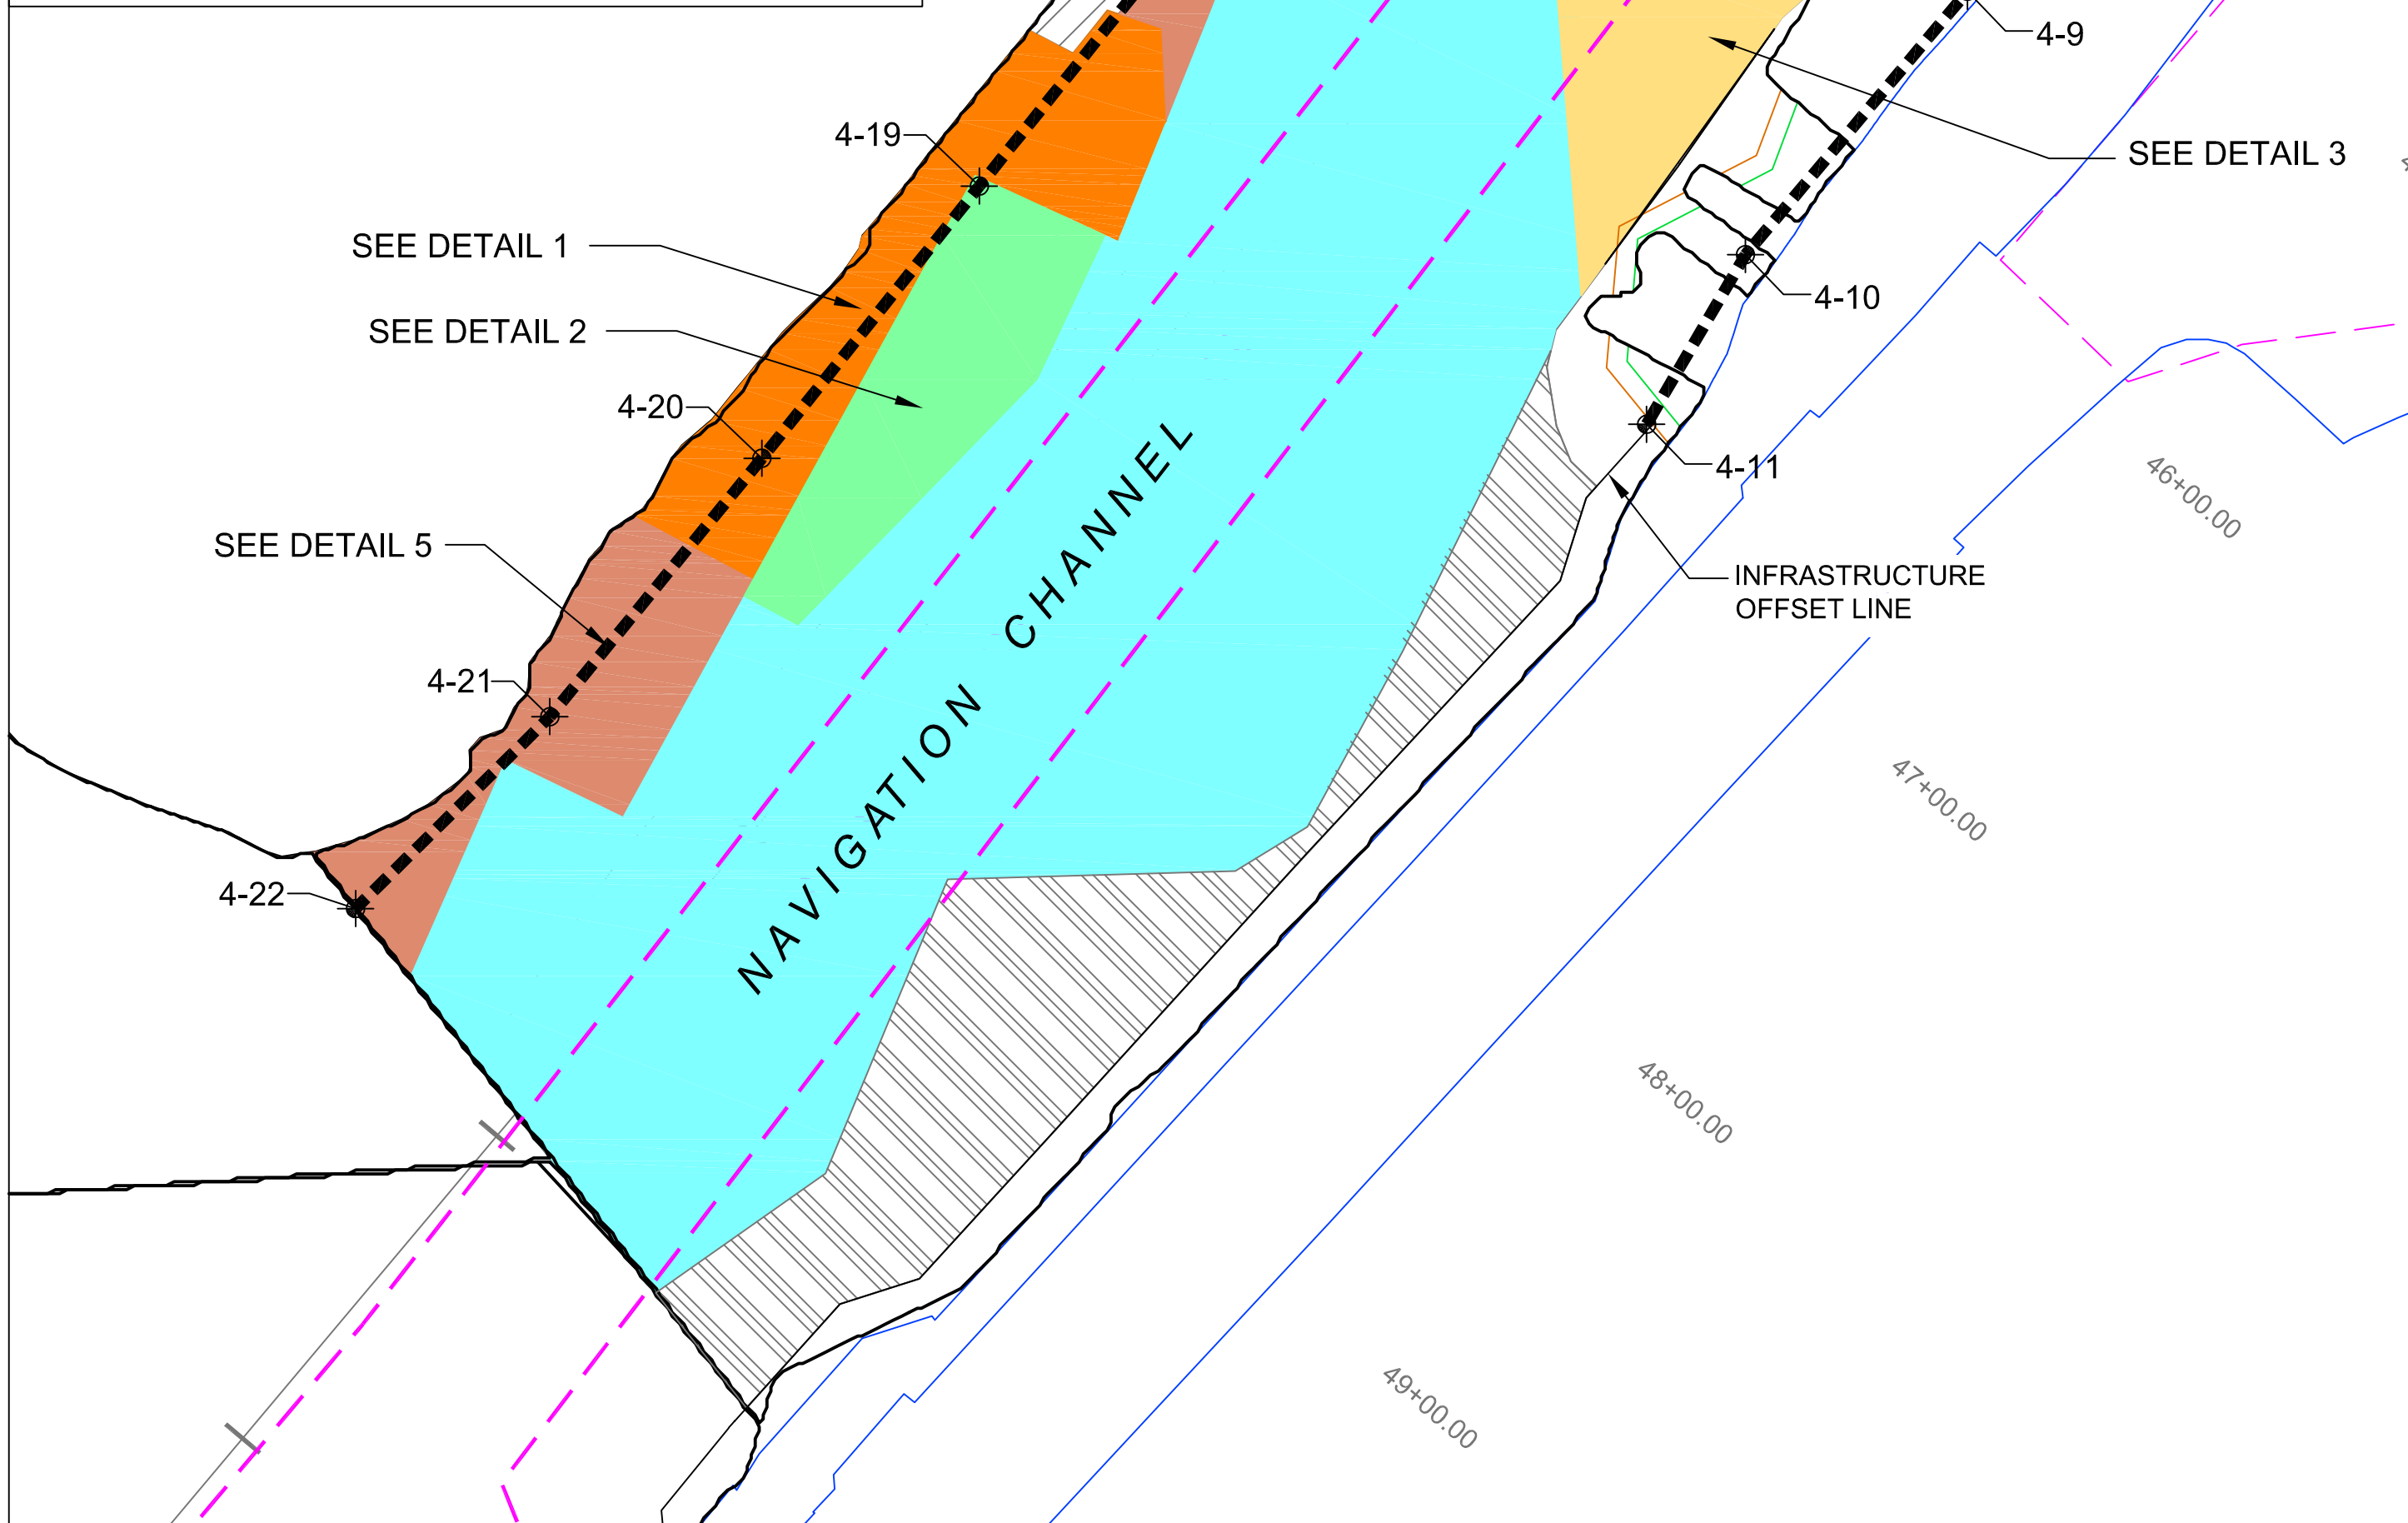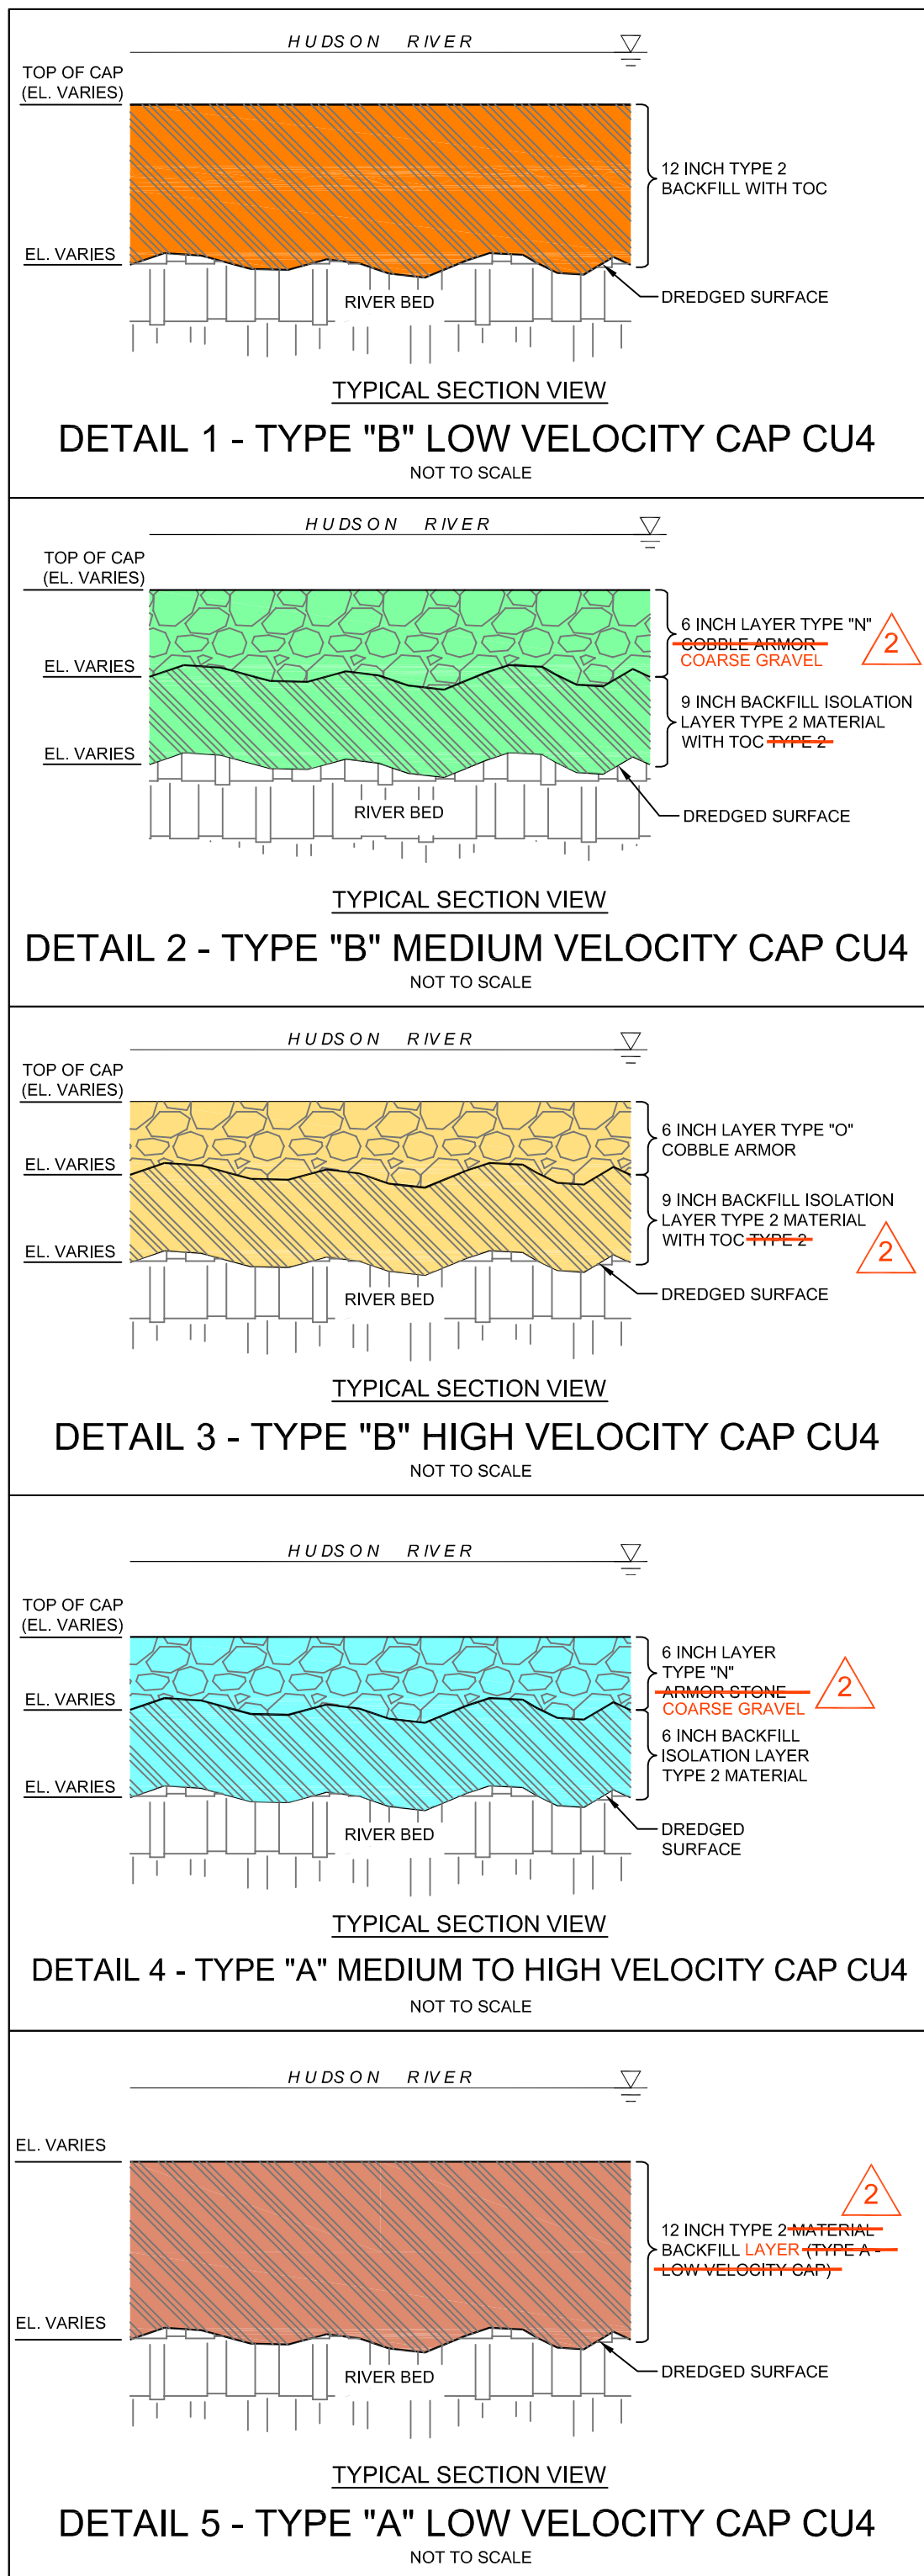


NOTES:

- BACKFILL TO BE PLACED IN ACCORDANCE WITH SECTION 13720 AND DESIGN DRAWINGS B-0021-SK1 AND B-0020-SK1.
- CAP MATERIALS TO BE PLACED IN ACCORDANCE WITH SECTION 13720 AND DESIGN DRAWING C-0038.
- ~~BACKFILL WILL NOT BE PLACED IN NAVIGATION CHANNEL WHERE EXISTING BATHYMETRY IS 103' OR GREATER.~~
- ~~NO BACKFILL WILL BE PLACED IN THE NAVIGATION CHANNEL UNLESS THE BOTTOM SURFACE OF THE NAVIGATION CHANNEL IS 102.0' OR DEEPER AFTER DREDGING.~~
- PLACEMENT OF NEARSHORE BACKFILL IN TYPE 1 AREAS TO CONSIST OF TYPE 2 BACKFILL TO EL 116.5', THEN TYPE 1 BACKFILL FROM EL 116.5' TO 119'. (SEE SKETCH CU4-BF-CO1)
- TOTAL CAP AREA INCLUDES 5' HORIZONTAL OFFSET INTO COMPLIANT AREA, AS PER CONTRACT DRAWING C-0038.
- ~~THE TOP OF CAP CAN NOT BE ABOVE ELEVATION 105' IN THE NAVIGABLE CHANNEL.~~
- ~~CAP MATERIALS WILL NOT BE PLACED IN THE NAVIGATION CHANNEL ABOVE 105.0'.~~


LEGEND	
	CU BOUNDARY
	MUD - RIP RAP INTERFACE
	DREDGING OFFSET
	15% BACKFILL PLACEMENT TO AN ELEV. OF 114.0 FEET TYPE 1 MATERIAL
	1 FOOT BACKFILL AND NEARSHORE PLACEMENT TYPE 1 MATERIAL
	1 FOOT BACKFILL AND NEARSHORE PLACEMENT TYPE 2 MATERIAL
	TYPE "B" - LOW VELOCITY CAP (12 INCH LAYER OF TYPE 2 BACKFILL WITH TOC)
	TYPE "B" - MEDIUM VELOCITY CAP (9 INCH ISOLATION LAYER OF TYPE 2 BACKFILL WITH TOC, 6 INCH LAYER TYPE "N" ARMOR STONE COARSE GRAVEL)
	TYPE "B" - HIGH VELOCITY CAP (9 INCH ISOLATION LAYER OF TYPE 2 BACKFILL WITH TOC, 6 INCH LAYER TYPE "O" COBBLE ARMOR)
	TYPE "A" - MEDIUM TO HIGH VELOCITY CAP (6" LAYER OF TYPE 2 BACKFILL & 6" LAYER OF TYPE "N" ARMOR STONE COARSE GRAVEL)
	TYPE "A" - LOW VELOCITY CAP (12" TYPE 2 BACKFILL)
	NEARSHORE BORDER SET POINT
	NEARSHORE BORDER (117.5 FEET)
	LIMIT OF NON-COMPLIANT NODE POLYGONS
	SHORELINE BOUNDARY ELEV. 119'

RECORD
DRAWING

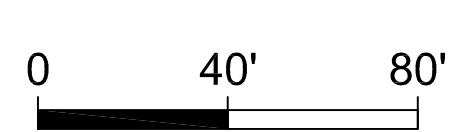

REV	DATE	DRN BY	DRAWING DESCRIPTION	PM
2	11/23/09	JHG	RECORD DRAWING	MG
1	11/03/09	JHG	ADDRESS EPA COMMENTS; ISSUE FOR USE	MG
0	11/02/09	JHG	ISSUED FOR EPA REVIEW	MG


PARSONS CONSULTING ENGINEERS		DRAWING TITLE	
GE COMPANY - PARSONS PROJECT OFFICE BUILDING 40-1, 381 BROADWAY FORT EDWARD, N.Y. 12828 (518) 746-5311		CU4 BACKFILL AND CAP PLAN	
DRAWN BY JHG	CHECKED BY MG	DRAWING NO. CU4-BC-1 D	VERSION/SCALE AS SHOWN
DATE 11/23/09	APPROVED BY MG	JOB 442209.01401	

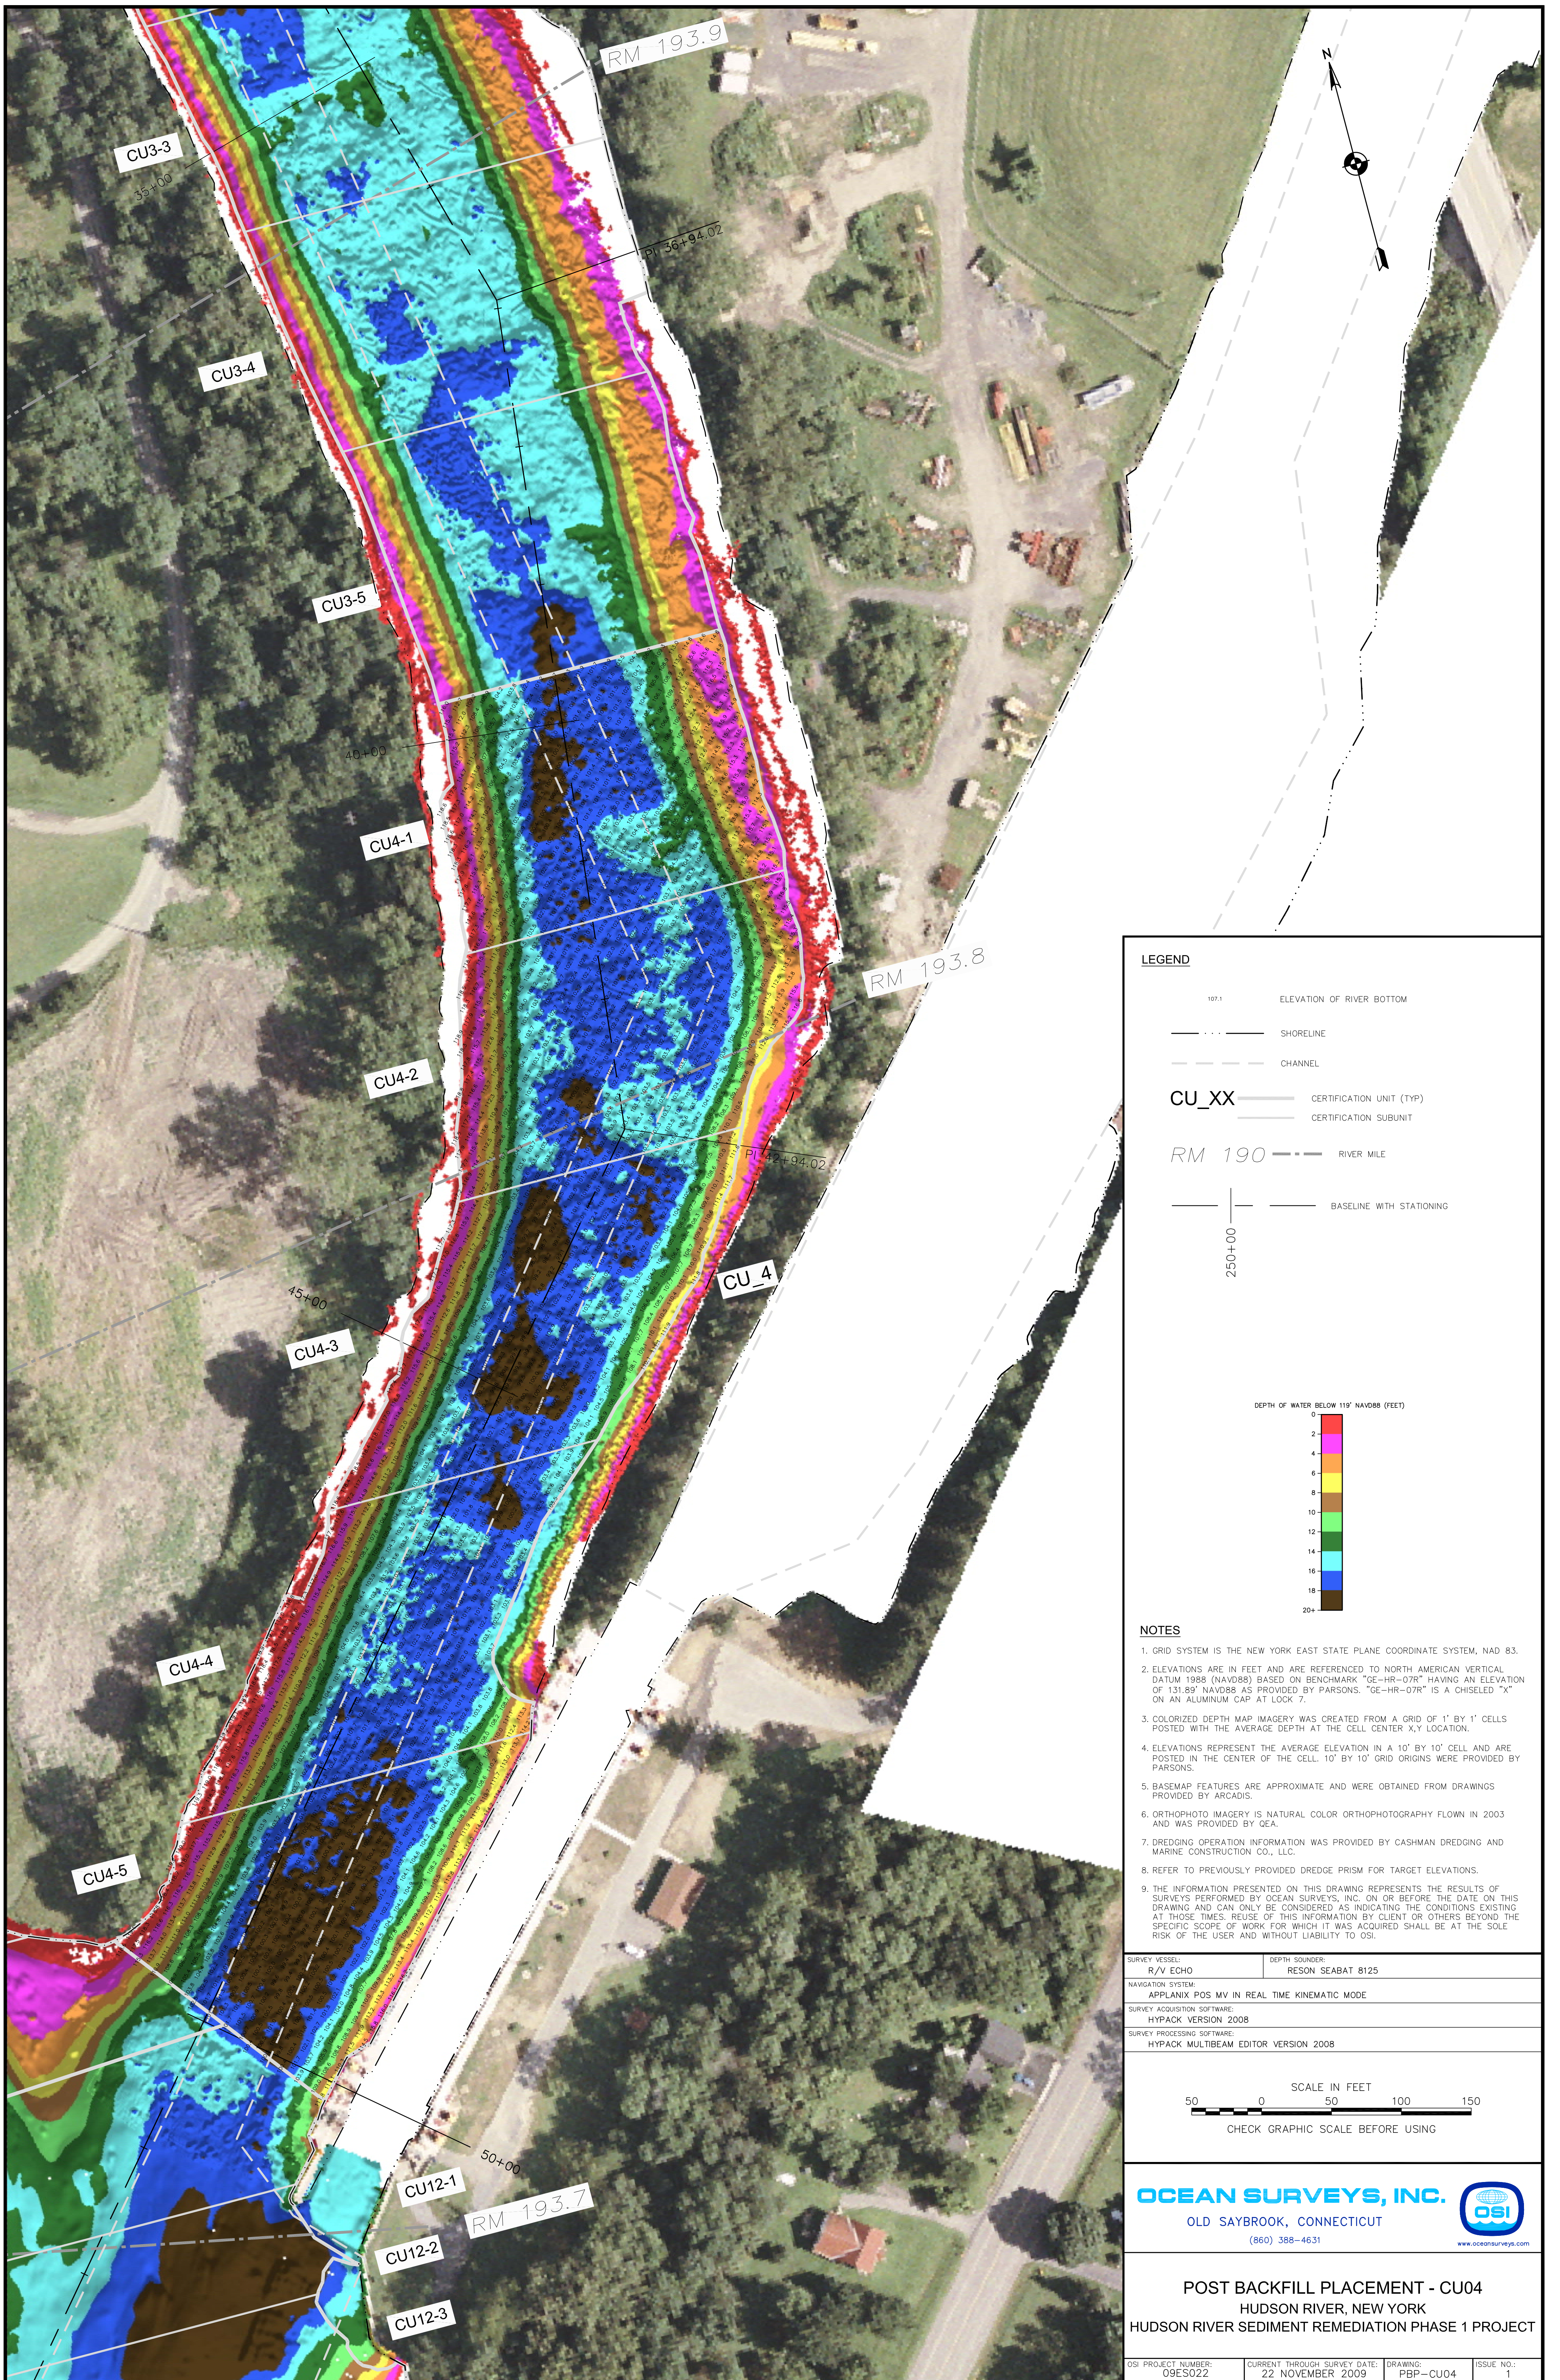

LEGEND

- 107.1 ELEVATION OF RIVER BOTTOM
- SHORELINE
- CHANNEL
- CU_XX CERTIFICATION UNIT (TYP)
- CERTIFICATION SUBUNIT
- RM 190 RIVER MILE
- BASELINE WITH STATIONING


DEPTH OF WATER BELOW 119' NAVD88 (FEET)

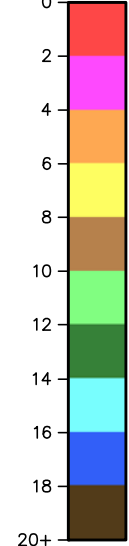

NOTES

1. GRID SYSTEM IS THE NEW YORK EAST STATE PLANE COORDINATE SYSTEM, NAD 83.
2. ELEVATIONS ARE IN FEET AND ARE REFERENCED TO NORTH AMERICAN VERTICAL DATUM 1988 (NAVD88) BASED ON BENCHMARK "GE-HR-07R" HAVING AN ELEVATION OF 131.89' NAVD88 AS PROVIDED BY PARSONS. "GE-HR-07R" IS A CHISELED "X" ON AN ALUMINUM CAP AT LOCK 7.
3. COLORIZED DEPTH MAP IMAGERY WAS CREATED FROM A GRID OF 1' BY 1' CELLS POSTED WITH THE AVERAGE DEPTH AT THE CELL CENTER X,Y LOCATION.
4. ELEVATIONS REPRESENT THE AVERAGE ELEVATION IN A 10' BY 10' CELL AND ARE POSTED IN THE CENTER OF THE CELL. 10' BY 10' GRID ORIGINS WERE PROVIDED BY PARSONS.
5. BASEMAP FEATURES ARE APPROXIMATE AND WERE OBTAINED FROM DRAWINGS PROVIDED BY ARCADIS.
6. ORTHOPHOTO IMAGERY IS NATURAL COLOR ORTHOPHOTOGRAPHY FLOWN IN 2003 AND WAS PROVIDED BY OEA.
7. DREDGING OPERATION INFORMATION WAS PROVIDED BY CASHMAN DREDGING AND MARINE CONSTRUCTION CO., LLC.
8. REFER TO PREVIOUSLY PROVIDED DREDGE PRISM FOR TARGET ELEVATIONS.
9. THE INFORMATION PRESENTED ON THIS DRAWING REPRESENTS THE RESULTS OF SURVEYS PERFORMED BY OCEAN SURVEYS, INC. ON OR BEFORE THE DATE ON THIS DRAWING AND CAN ONLY BE CONSIDERED AS INDICATING THE CONDITIONS EXISTING AT THOSE TIMES. REUSE OF THIS INFORMATION BY CLIENT OR OTHERS BEYOND THE SPECIFIC SCOPE OF WORK FOR WHICH IT WAS ACQUIRED SHALL BE AT THE SOLE RISK OF THE USER AND WITHOUT LIABILITY TO OSI.

SURVEY VESSEL: R/V ECHO	DEPTH SOUNDER: RESON SEABAT 8125
NAVIGATION SYSTEM: APPLANIX POS MV IN REAL TIME KINEMATIC MODE	
SURVEY ACQUISITION SOFTWARE: HYPACK VERSION 2008	
SURVEY PROCESSING SOFTWARE: HYPACK MULTIBEAM EDITOR VERSION 2008	

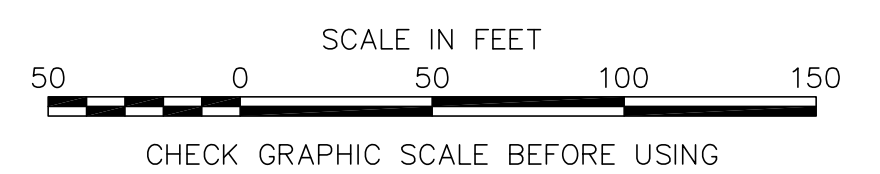

OCEAN SURVEYS, INC. 
 OLD SAYBROOK, CONNECTICUT
 (860) 388-4631
www.oceansurveys.com

POST BACKFILL PLACEMENT - CU04
 HUDSON RIVER, NEW YORK
 HUDSON RIVER SEDIMENT REMEDIATION PHASE 1 PROJECT

OSI PROJECT NUMBER: 09ES022	CURRENT THROUGH SURVEY DATE: 22 NOVEMBER 2009	DRAWING: PBP-CU04	ISSUE NO.: 1
--------------------------------	--	----------------------	-----------------

Correspondence
(Letters and Emails)

Inglis, Andrew A (GE, Corporate)

From: King.David@epamail.epa.gov
Sent: Saturday, November 14, 2009 9:36 AM
To: Inglis, Andrew A (GE, Corporate)
Cc: Michael J. Johnson; Kruppenbacher, Timothy A (GE, Corporate); michael galbraith; Bryan Minor; Gary Klawinski; Joseph Moloughney
Subject: Re: Discussions regarding CU Backfill and Cap placement

Andrew, I agree with summary.
Dave
Sent by EPA Wireless E-Mail Services

From: "Inglis, Andrew A (GE, Corporate)" [andrew.inglis@ge.com]
Sent: 11/13/2009 05:13 PM EST
To: David King
Cc: <MJohnson@louisberger.com>; "Kruppenbacher, Timothy A (GE, Corporate)" <timothy.kruppenbacher@ge.com>; <michael.galbraith@parsons.com>; <USACE_HRFO@roadrunner.com>; <GKlawinski@ene.com>; "Joseph Moloughney" <Joseph_Moloughney@canals.state.ny.us>
Subject: Discussions regarding CU Backfill and Cap placement

Dave,
Today and yesterday we met and reviewed progress surveys of cap and backfill placement in CUs 1, 2, 3, 4, 7 and 18. This email confirms decisions made during the meeting based on reviews of the maps presented during the meeting.

CU1.

In CU1 it was agreed that sufficient thickness of isolation layer material has been placed while providing enough room to place armor stone below the 105.2' elevation in the navigation channel. It was agreed that placement of armor stone can begin.

CU2.

In CU2 it was agreed that the top of cap and backfill elevations were acceptable. GE will prepare a Form 2 package for EPA review.

CU3 .

In CU3 it was agreed that the top of cap and backfill elevations were acceptable, it was discussed that GE was in the process of placing backfill in an area of the navigation channel where the post dredge elevations were below 102' elevation. Once GE has surveyed that additional backfill location GE will prepare a Form 2 package for EPA review.

CU4.

In CU4 it was agreed that the top of cap elevations in the north east quarter of the CU was acceptable and that backfill placment in that area may begin.

CU7.

In CU7 it was agreed that the top of cap and backfill elevations were acceptable. GE will prepare a Form 2 package for EPA review.

CU18

In CU18 it was agreed that the top of cap elevations were acceptable in both of the cap locations in that CU.

Please let me know if I missed anything.

Thanks,

Andrew A. Inglis
Dredging Task Leader
GE

T +1 518-746-5256

381 Broadway
Building 40-2
Fort Edward, NY 12828
GE Corporate Environmental Programs

GE Imagination at Work

Inglis, Andrew A (GE, Corporate)

From: King.David@epamail.epa.gov
Sent: Saturday, November 21, 2009 8:58 AM
To: Inglis, Andrew A (GE, Corporate)
Cc: Mirarchi, Jeff (GE, Corporate, non-ge); Joseph Moloughney; MJohnson@louisberger.com; Kruppenbacher, Timothy A (GE, Corporate); USACE_HRFO@roadrunner.com
Subject: RE: CU4 Type A Cap Acceptance Map

Andrew,
The depth in the channel looks good. given the slope stability issue the caps are acceptable. Have the shoreline materials been placed yet?
There has been a change of plans so I will be in the office on Tuesday until 4 PM if you want to sign off on form 2.

Dave

CU-05

Form 2

CU Certification of Completion

CU BACKFILL/ENGINEERED CAP COMPLETION APPROVAL - FORM 2						
Reporting Date	10/17/2009	Placement Start Date	9/13/2009			
CU Number	5	Placement End Date	10/14/2009			
Approximate CU Centroid	Northing	1616391	Easting	733771.6	NY State NAD 83	
CU Size	4.77	Acres				
Backfill Area	4.77	Acres				
Cap Area	0.88	Acres				
Backfill Surface Mean Tri+ PCBs Concentration (when required)		NA	mg/kg			
Number of nodes sampled		NA	mg/kg			
Backfill x	Type of Backfill Type 2, 15%	Reference to appropriate drawings attached to Approval Form 1 CU 5 Backfill & Capping Plan, 9/25/09				
Cap x	Type of Cap Medium to High Velocity - Type A	Reference to appropriate drawings attached to Approval Form 1 CU 5 Backfill & Capping Plan, 9/25/09				
CU Checklist		Indicate one of the following			Reviewer Initial Acceptance	
Item	Attached	Not Applicable	GE	EPA		
Drawing of Installed Backfill/Cap (with record drawing details, thickness and sample locations [when backfill/cap are placed])	x					
Where applicable in backfill areas provide the following: Sample locations (coordinates), depths, Aroclor and Tri+ PCB concentrations collected including analytical data, field observations, (hard copy and electronic copies [in database format or equivalent])		x				
Comments						
Refer to attached Narrative Backfill Summary and CU 5 Backfill Placement Drawing.						
Upon signing this document, GE certifies that the backfill/cap has been installed satisfactorily and that no further backfill placement or capping is required for this CU. These remedial activities exclude long term operation, monitoring, maintenance and adaptive management at the CU. EPA accepts this certification.						
Signature of GE Representative			Signature of EPA Representative			
Signature			Signature			
Name			Name			
Date			Date			

Narrative

CU 5

Narrative Summary of Backfill and Capping and EPA Backfill and Capping Agreements

1.0 Backfill Placement

Backfill was placed in accordance with the CU 5 Backfill and Capping Plan Drawing, dated September 25, 2009, which was provided to EPA as part of the Form 1 package. A multi-beam bathymetric survey for CU 5 was performed after final backfill placement on October 15, 2009, as shown on the attached CU 5 Post Backfill Placement Acceptance Drawing, dated October 18, 2009. The difference to dredge prism on a 10' x 10' grid is shown for all backfill areas, however it should be noted that the 6" backfill placed in the bucket refusal areas is not subject to any acceptance tolerance and is provided for information only.

2.0 Cap Placement

A Type A medium to high velocity cap was placed in accordance with the CU 5 Backfill and Cap Acceptance Record Drawing, dated September 25, 2009. A multi-beam bathymetric survey of the CU 5 cap was performed after final cap placement on October 4, 2009. The surveyed cap thickness is shown on a 5' x 5' grid for all cap areas, shown on the attached CU5 Type A Cap Acceptance Survey, dated October 19, 2009.


3.0 EPA Field Agreements Specific to CU 5 Backfill and Capping

1. The plan used to place backfill and cap in CU5 was approved by EPA on September 28, 2009 as part of the CU5 Acceptance Form 1 package. No changes were made to this plan during placement of backfill or cap in CU5.
2. During the 4:00 PM meeting on October 5, 2009, GE presented acceptance surveys of the top of cap elevations in CU5. Based on the information presented by GE, EPA accepted that the top of cap elevations were within the required design tolerances. The Cap Acceptance Survey Drawing, dated October 19, 2009 is included in this package.
3. During the 4:00PM meeting on October 12, 2009, EPA agreed that acceptance surveys of partial areas of a CU may be performed and used for acceptance once placement of backfill or cap in those areas is complete.
4. During the 4:00 PM meeting on October 17, 2009, GE presented acceptance surveys of the top of backfill elevations in CU5. Based on the information presented by GE, EPA accepted

that the top of backfill elevations were within the required design tolerances. The Backfill Acceptance Survey Drawing, dated October 19, 2009 is included in this package.


5. During the 4:00 PM meeting on October 17, 2009, EPA requested Actual 15% volumes placed be included on the Backfill Acceptance Drawings, to which GE agreed (see Note 3 on the Backfill Acceptance Survey Drawing, dated October 19, 2009). EPA also requested the 15% backfill borders be depicted on the Backfill Acceptance Drawing, to which GE agreed.

Figures

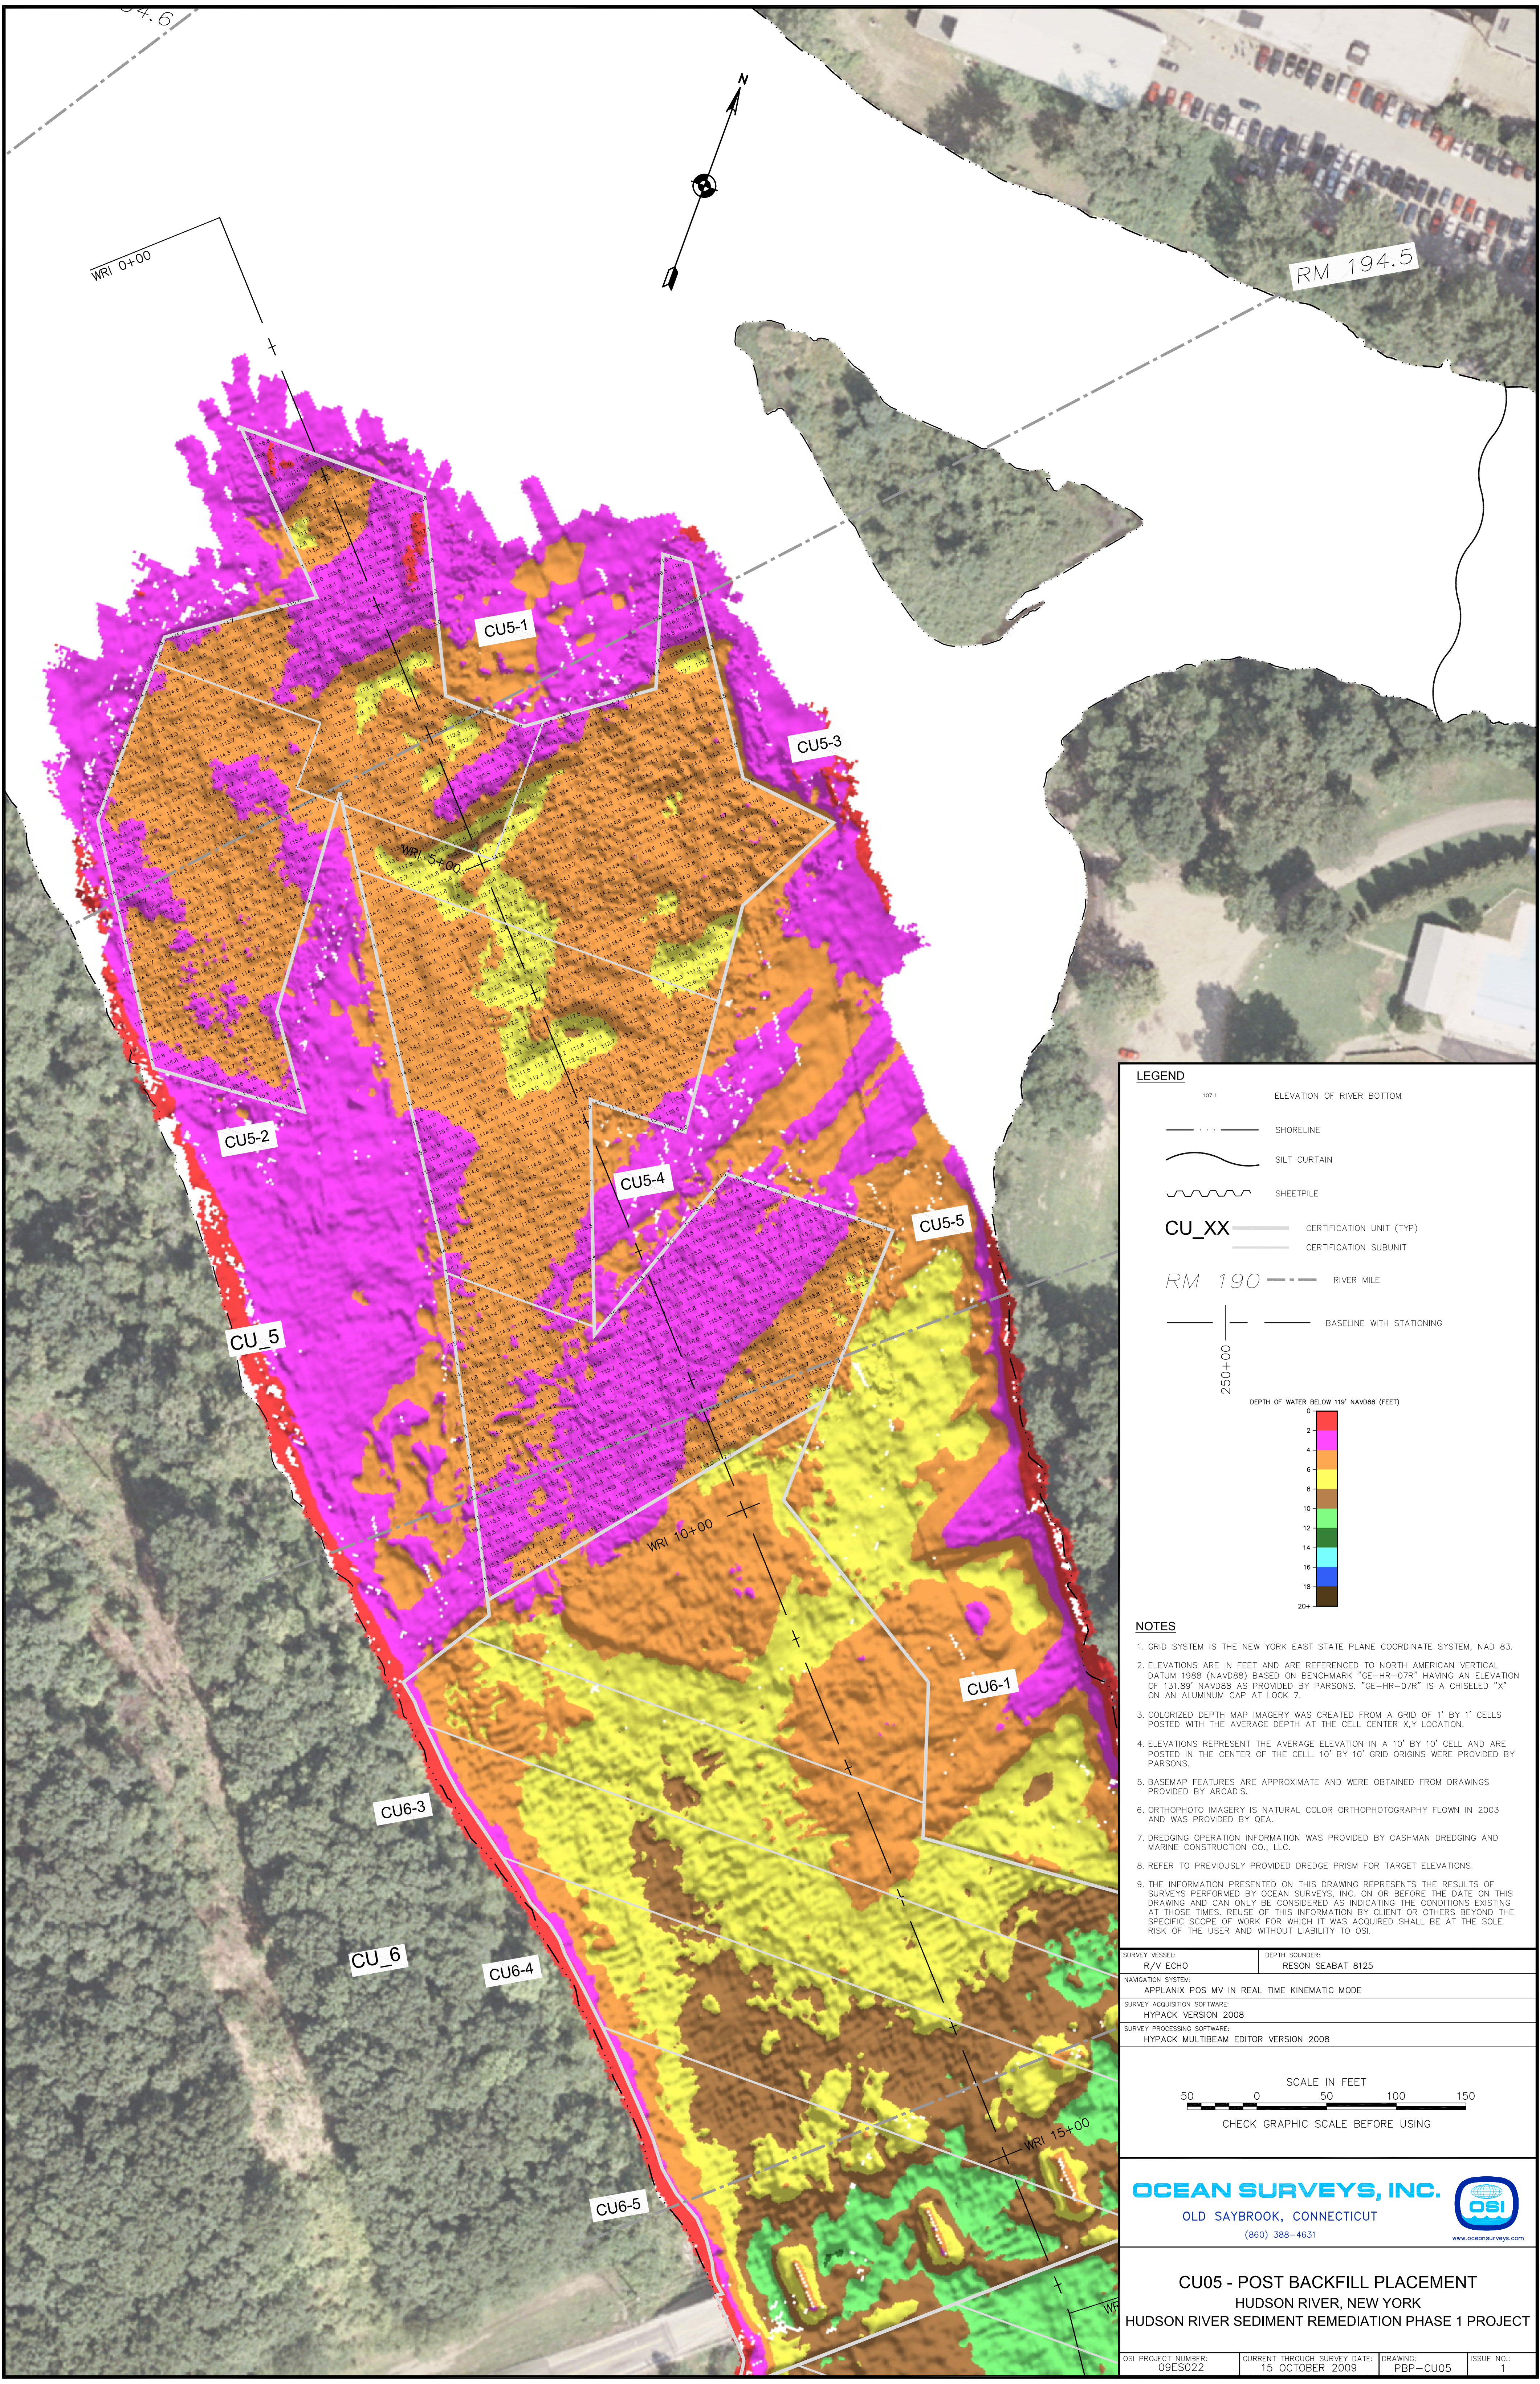


LEGEND

- 107.1 ELEVATION OF RIVER BOTTOM
- SHORELINE
- SILT CURTAIN
- SHEETPILE
- CU_XX CERTIFICATION UNIT (TYP)
- CERTIFICATION SUBUNIT
- RM 190 RIVER MILE
- BASELINE WITH STATIONING

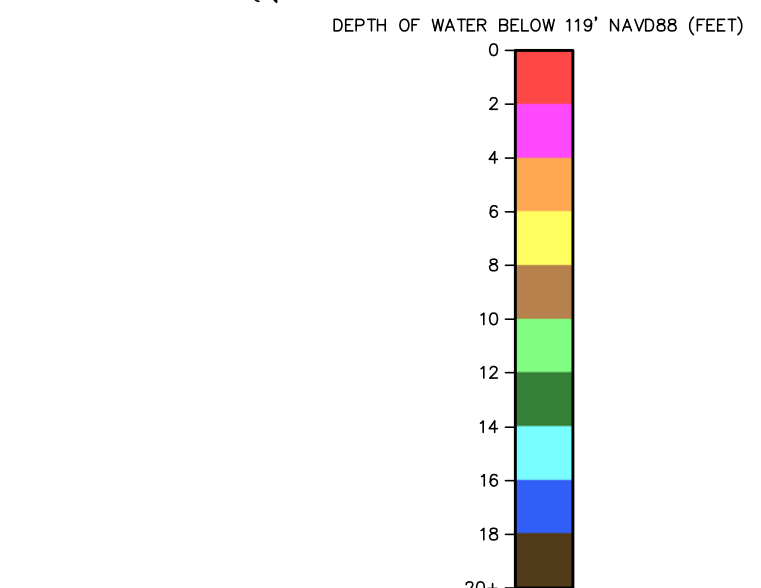

- NOTES**
- GRID SYSTEM IS THE NEW YORK EAST STATE PLANE COORDINATE SYSTEM, NAD 83.
 - ELEVATIONS ARE IN FEET AND ARE REFERENCED TO NORTH AMERICAN VERTICAL DATUM 1988 (NAVD88) BASED ON BENCHMARK "GE-HR-07R" HAVING AN ELEVATION OF 131.89' NAVD88 AS PROVIDED BY PARSONS. "GE-HR-07R" IS A CHISELED "X" ON AN ALUMINUM CAP AT LOCK 7.
 - COLORIZED DEPTH MAP IMAGERY WAS CREATED FROM A GRID OF 1' BY 1' CELLS POSTED WITH THE AVERAGE DEPTH AT THE CELL CENTER X,Y LOCATION.
 - ELEVATIONS REPRESENT THE AVERAGE ELEVATION IN A 10' BY 10' CELL AND ARE POSTED IN THE CENTER OF THE CELL. 10' BY 10' GRID ORIGINS WERE PROVIDED BY PARSONS.
 - BASEMAP FEATURES ARE APPROXIMATE AND WERE OBTAINED FROM DRAWINGS PROVIDED BY ARCADIS.
 - ORTHO PHOTO IMAGERY IS NATURAL COLOR ORTHOPHOTOGRAPHY FLOWN IN 2003 AND WAS PROVIDED BY QEA.
 - DREDGING OPERATION INFORMATION WAS PROVIDED BY CASHMAN DREDGING AND MARINE CONSTRUCTION CO., LLC.
 - REFER TO PREVIOUSLY PROVIDED DREDGE PRISM FOR TARGET ELEVATIONS.
 - THE INFORMATION PRESENTED ON THIS DRAWING REPRESENTS THE RESULTS OF SURVEYS PERFORMED BY OCEAN SURVEYS, INC. ON OR BEFORE THE DATE ON THIS DRAWING AND CAN ONLY BE CONSIDERED AS INDICATING THE CONDITIONS EXISTING AT THOSE TIMES. REUSE OF THIS INFORMATION BY CLIENT OR OTHERS BEYOND THE SPECIFIC SCOPE OF WORK FOR WHICH IT WAS ACQUIRED SHALL BE AT THE SOLE RISK OF THE USER AND WITHOUT LIABILITY TO OSI.

SURVEY VESSEL: R/V ECHO	DEPTH SOUNDER: RESON SEABAT 8125
NAVIGATION SYSTEM: APPLANIX POS MV IN REAL TIME KINEMATIC MODE	
SURVEY ACQUISITION SOFTWARE: HYPACK VERSION 2008	
SURVEY PROCESSING SOFTWARE: HYPACK MULTIBEAM EDITOR VERSION 2008	

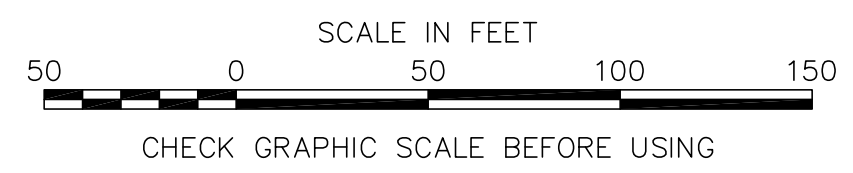








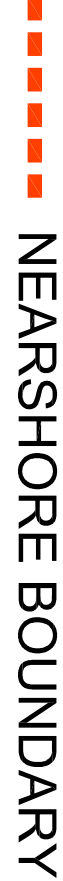




OCEAN SURVEYS, INC.

OLD SAYBROOK, CONNECTICUT
(860) 388-4631
www.oceansurveys.com

CU05 - POST BACKFILL PLACEMENT
HUDSON RIVER, NEW YORK
HUDSON RIVER SEDIMENT REMEDIATION PHASE 1 PROJECT

OSI PROJECT NUMBER: 09ES022	CURRENT THROUGH SURVEY DATE: 15 OCTOBER 2009	DRAWING: BFP-CU05	ISSUE NO.:
--------------------------------	---	----------------------	------------

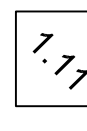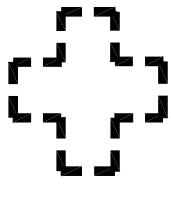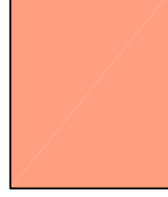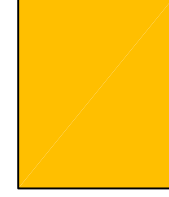LEGEND

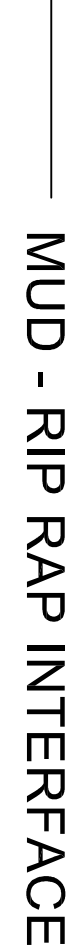-  10x10' GRID WITHIN DESIGN GUIDELINES
-  10x10' GRID LESS THAN DESIGN GUIDELINES
-  10x10' GRID ABOVE DESIGN GUIDELINES
-  ROCK/REFUSAL ENCOUNTERED VIA INVENTORY 1 DREDGING AS OF (JULY 2009)
-  1 FOOT BACKFILL AND NEARSHORE PLACEMENT TYPE 2 MATERIAL
-  15% BACKFILL PLACEMENT TO AN ELEV. OF 114.0 FEET TYPE 2 MATERIAL
-  15% BACKFILL PLACEMENT TO ORIGINAL BATHYMETRY TYPE 2 MATERIAL
-  NEARSHORE BOUNDARY
-  CU BOUNDARY
-  CU SUBUNIT BOUNDARY
-  MUD - RIP RAP INTERFACE
-  5' INTERFACE OFFSET

NOTES:

1. BUCKET REFUSAL AREAS NOT INCLUDED IN CU APPEPTANCE PROCESS.
2. 15% BACKFILL AREA BORDERS SHOWN FOR REFERENCE. 15% PLANNED AND ACTUAL VOLUMES INCLUDES ENGINEERED SIDE SLOPES, WHICH ARE NOT DEPICTED ON DRAWING.
3. 4,704 CY OF 15% BACKFILL MATERIAL PLACED DURING BACKFILLING. BACKUP CALCULATIONS AVAILABLE UPON REQUEST.



BATHYMETRY BASED ON
OSI MULTIBEAM SURVEY
OCTOBER 15, 2009

CU 5
TYPE 2 BACKFILL PLACEMENT
ACCEPTANCE SURVEY
(FT)

Area	Average Thickness (ft)	Approx. Area (acre)	Intended Vol. Placed (CY)	Actual Vol. Placed (CY)	Variation from Planned (CY)
CU5-1 & CU5-2	1.25	0.95	1522.2	1897.7	375.5

Notes:
Average thickness and volumes were computed using 10' x 10' cell center average datasets.

Area comprises 1 foot backfill in CU5-1 and CU5-2.

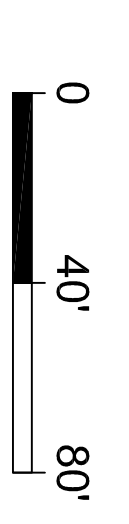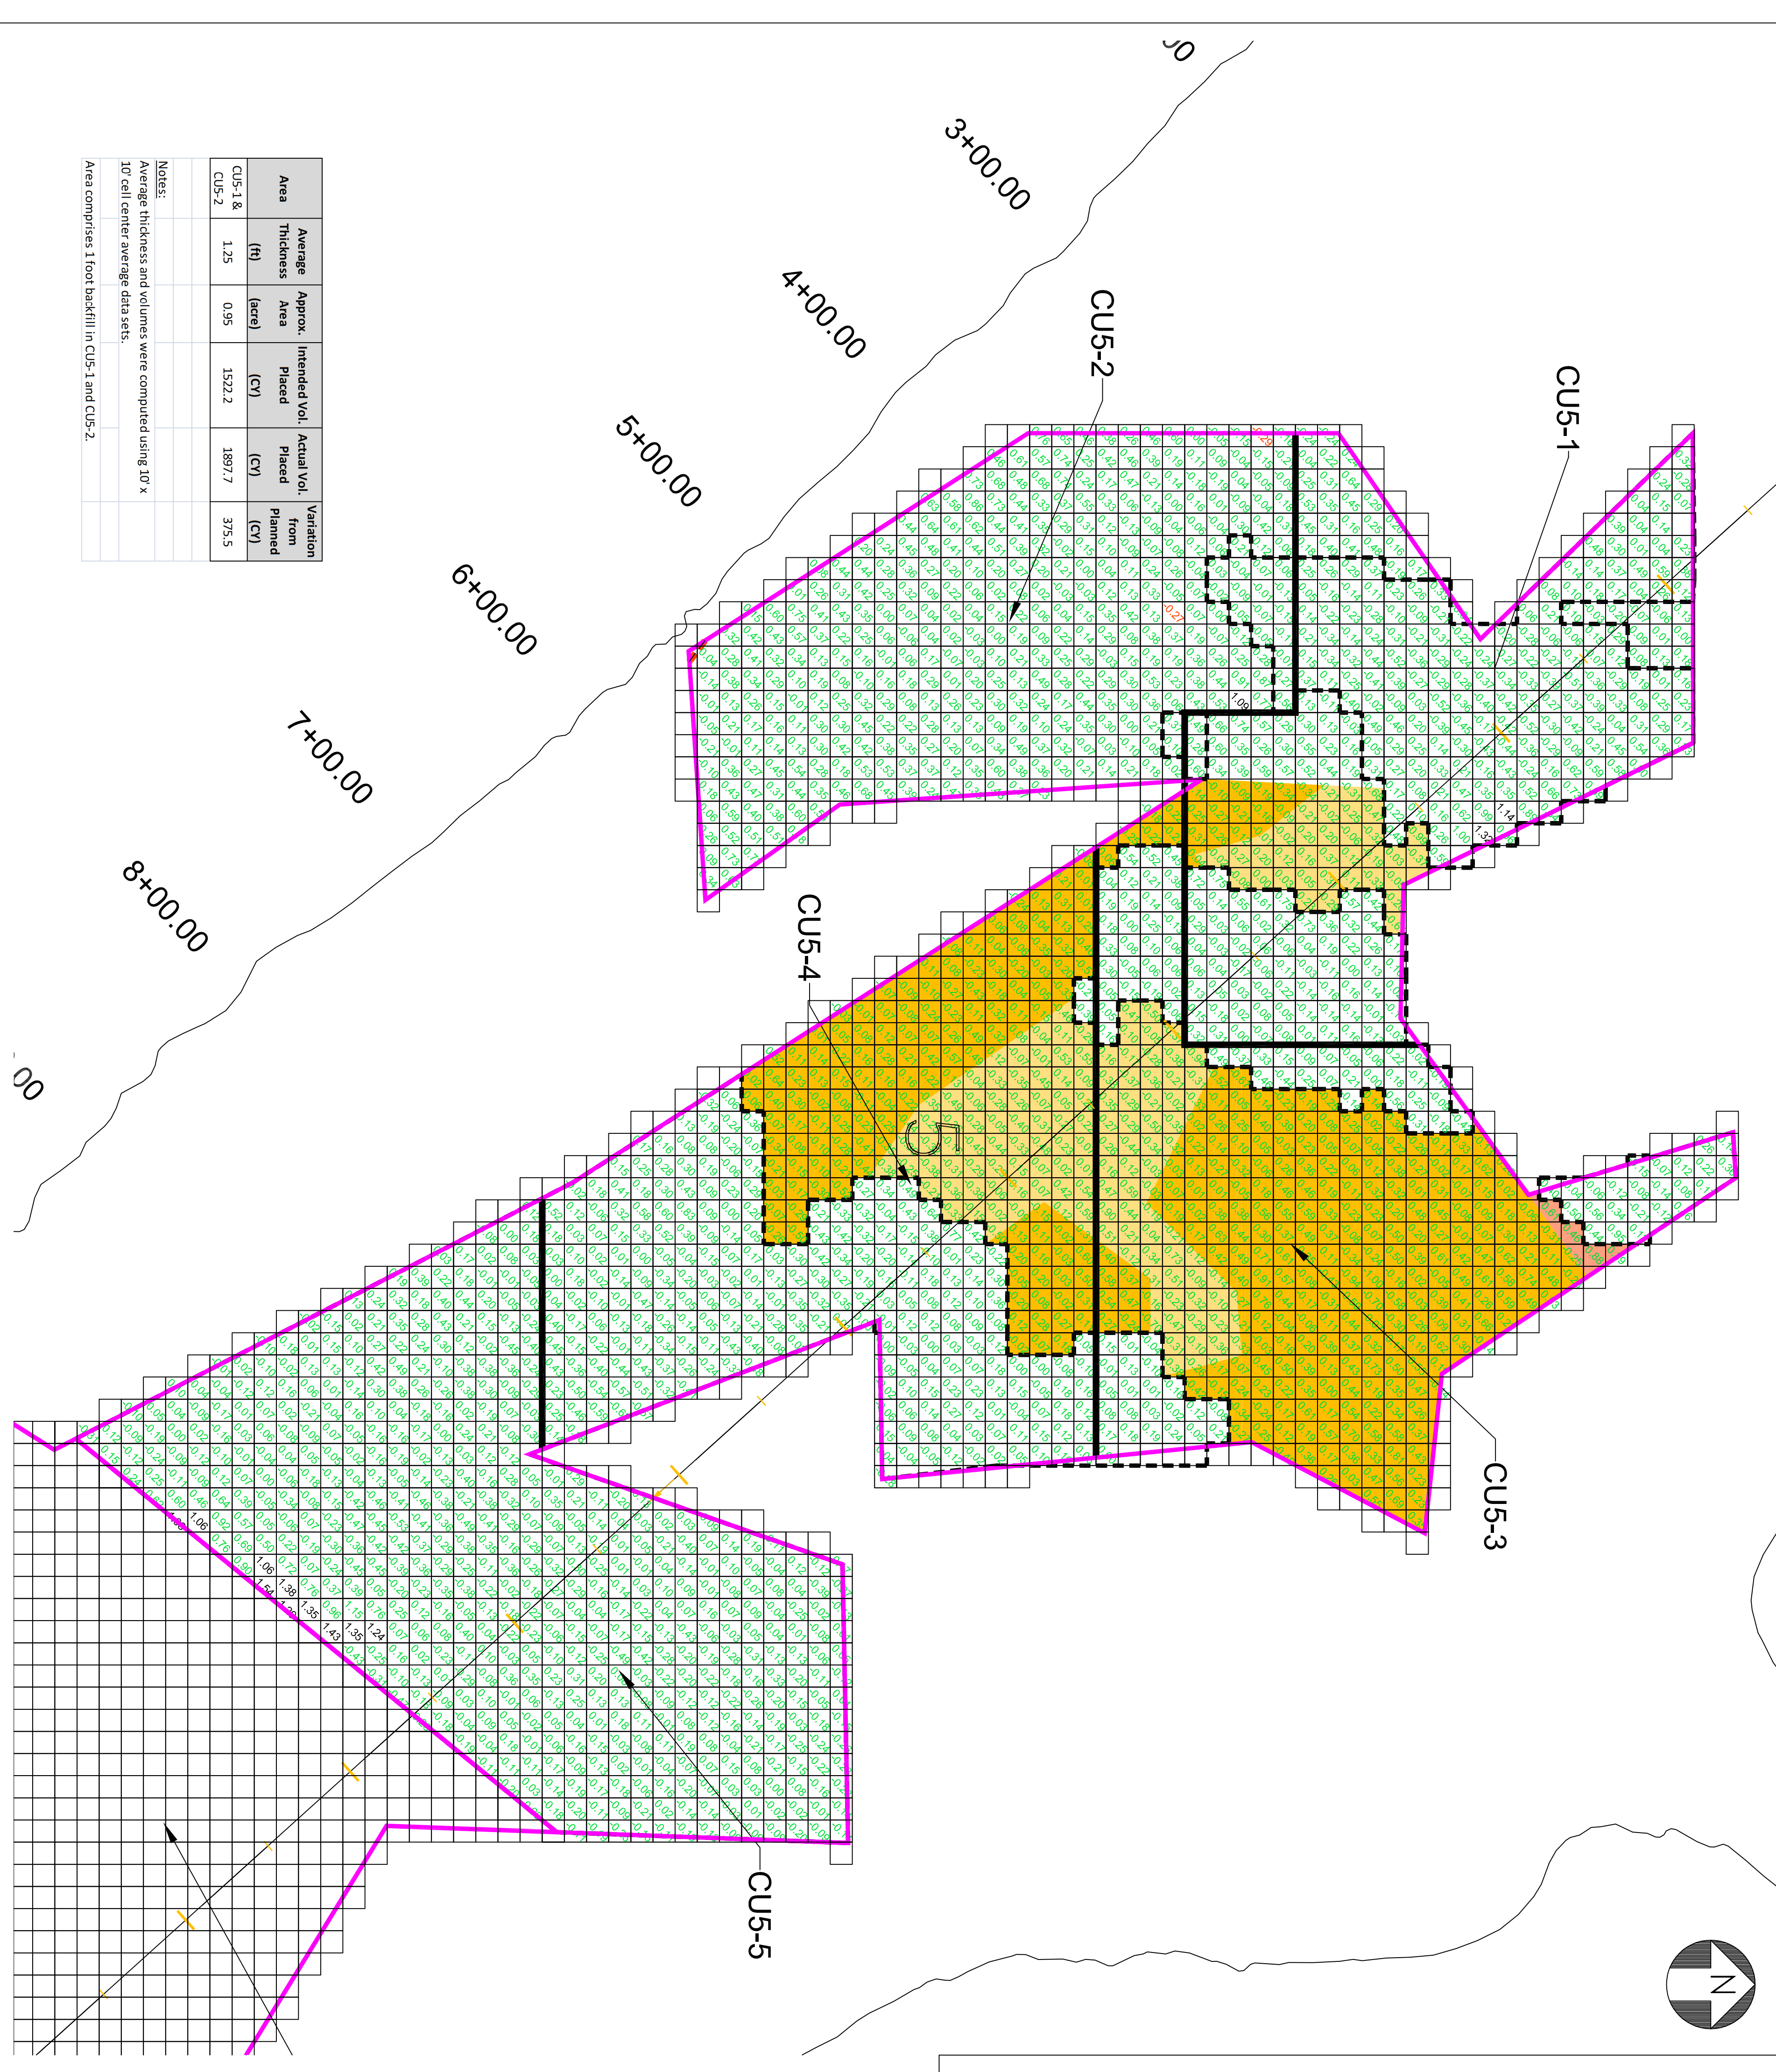

REV	DATE	DRN BY	ISSUED FOR	DESCRIPTION	SCALE
1	10/19/09	JHG	REVISED PER EPA COMMENTS	MG	AS SHOWN
0	10/18/09	JHG	ISSUED FOR EPA REVIEW	MG	
			DRAWING DESCRIPTION	PM	


DATE: 10/19/09 APPROVED BY: JHG

DRAWING TITLE: CU-5 TYPE 2 BACKFILL PLACEMENT ACCEPTANCE SURVEY


DRAWING NO: BKFL CU5

SCALE: AS SHOWN

JOB: 442209.01-01

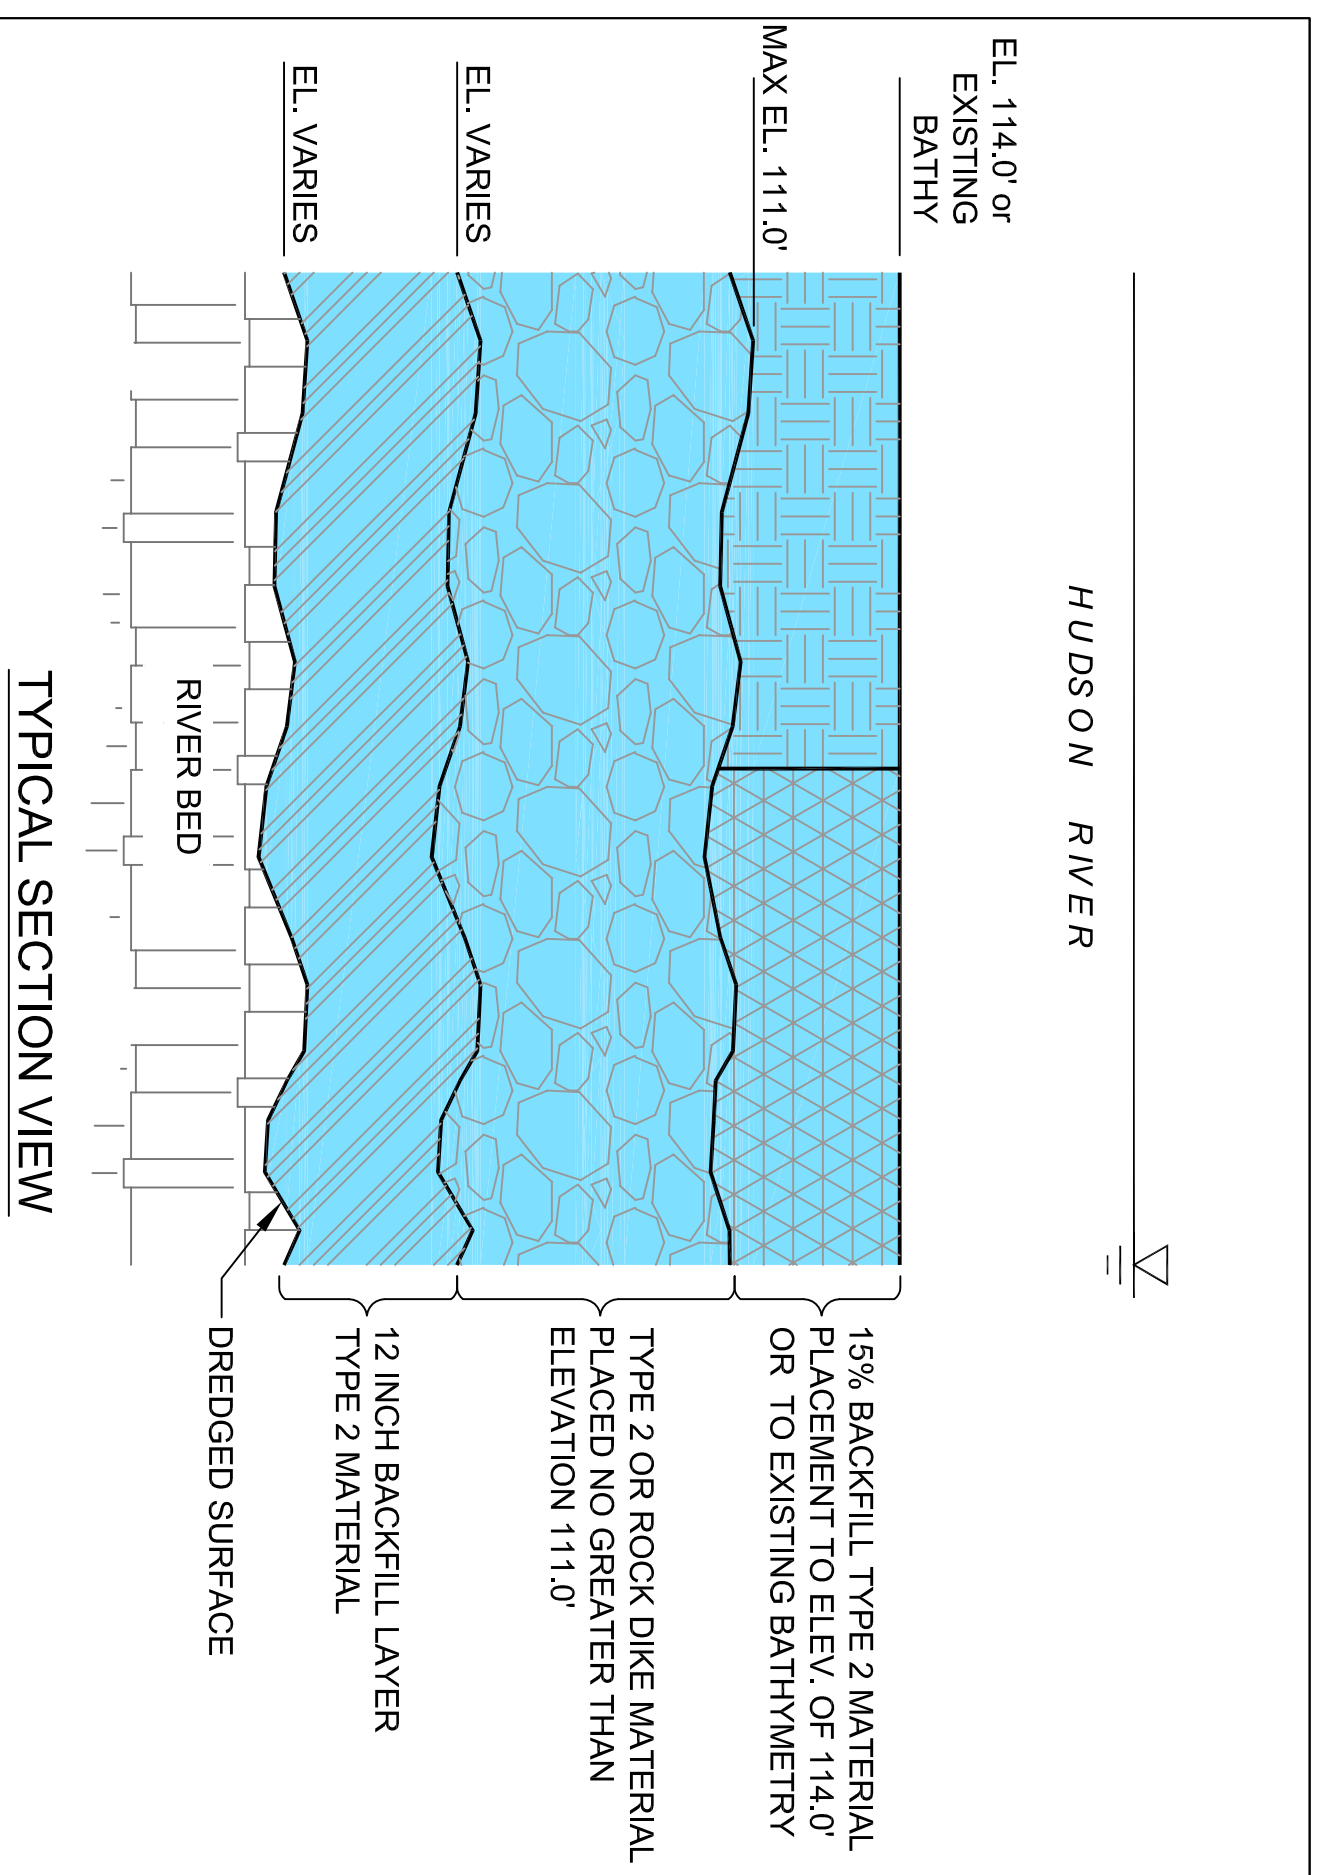

DETAIL 2
15% BACKFILL
CU5-1, CU5-3 & CU5-4
NOT TO SCALE



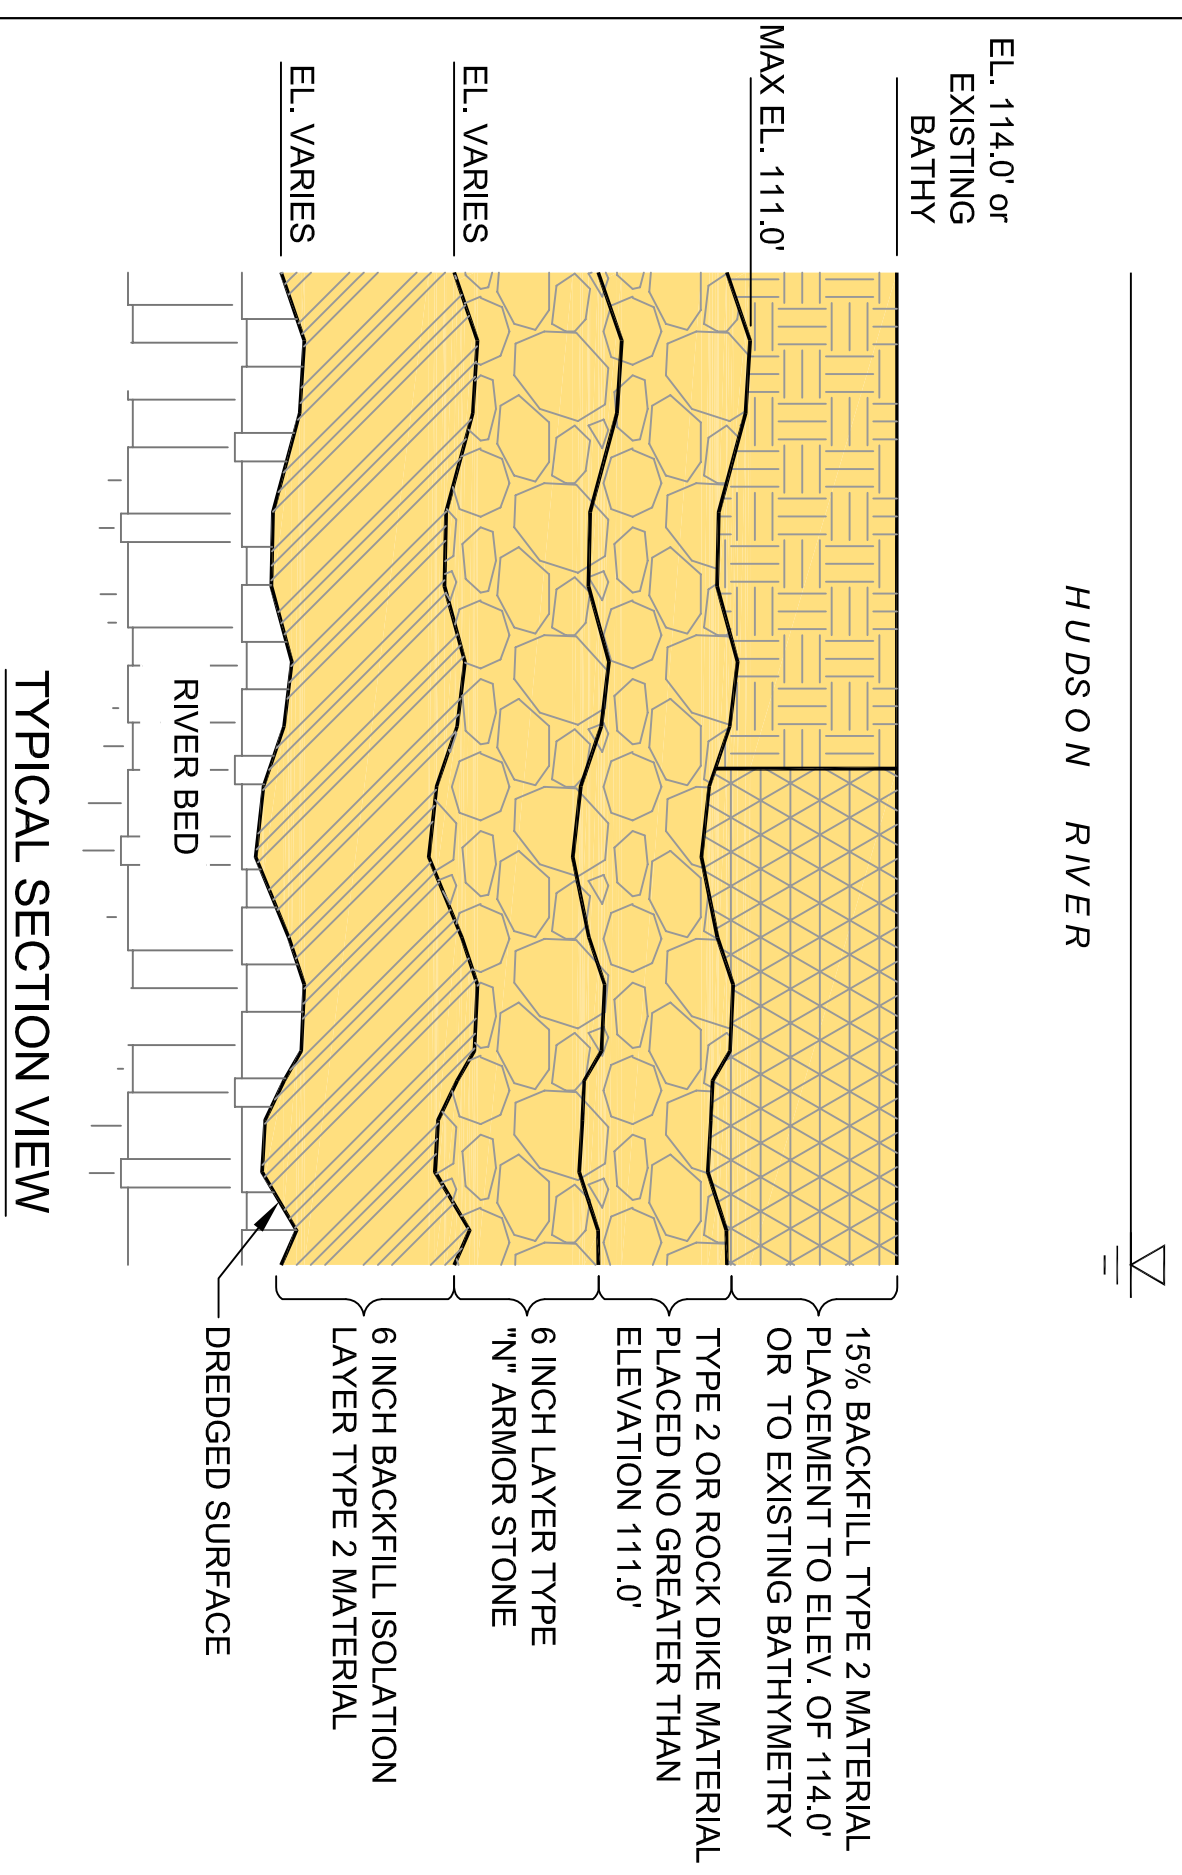


DETAIL 1
15% BACKFILL & CAP
CU5-3 & CU5-4
NOT TO SCALE

NOTES:

- BACKFILL TO BE PLACED IN ACCORDANCE WITH SECTION 13720 AND DESIGN DRAWINGS B-0021 AND B-0020-SK1.
- CAP MATERIALS TO BE PLACED IN ACCORDANCE WITH SECTION 13720 AND DESIGN DRAWING C-0038.
- REVISED PER EPA DISCUSSIONS REGARDING 15% BACKFILL PLACEMENT.

RECORD DRAWING

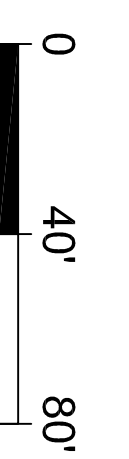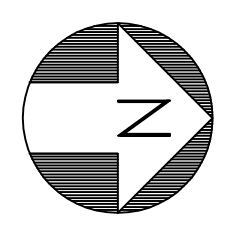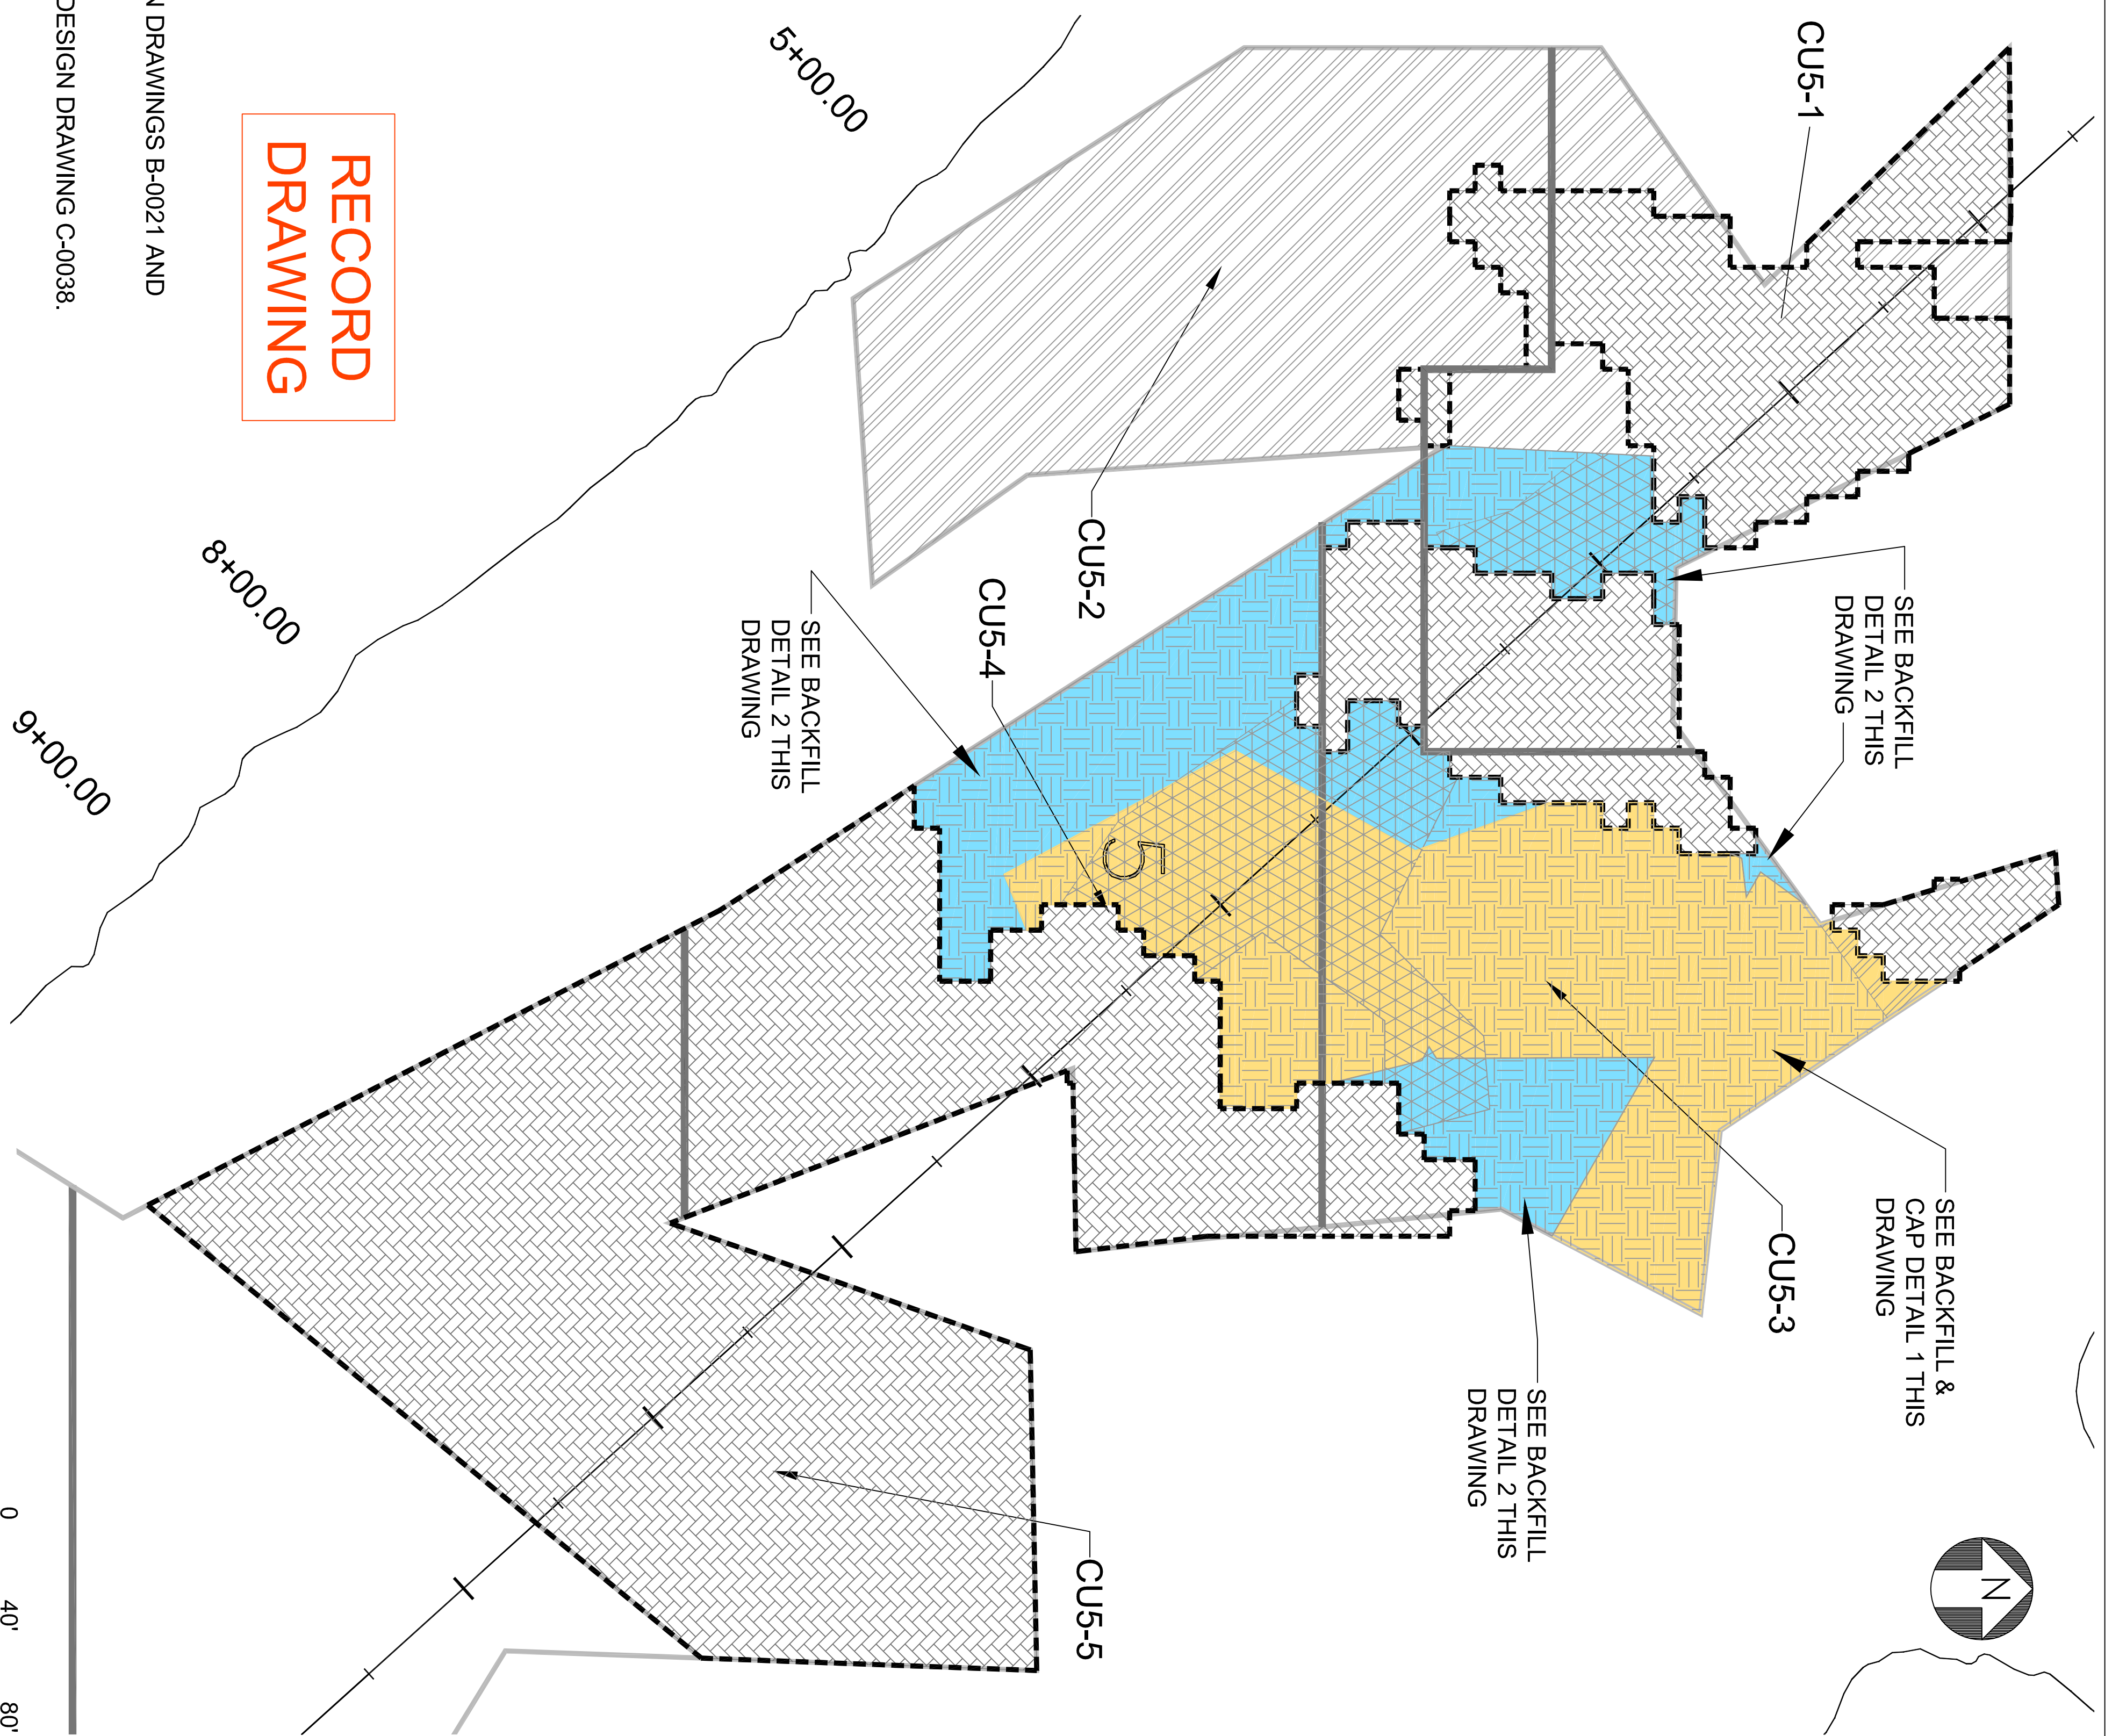



LEGEND

- ROCK/REFUSAL ENCOUNTERED VIA DREDGING
- CLAY ENCOUNTERED VIA DREDGING (NOT SHOWN FOR CLARITY)
- CU BOUNDARY
- CU SUBUNIT BOUNDARY
- MUD - RIP RAP INTERFACE
- 5' INTERFACE OFFSET
- 1 FOOT BACKFILL AND NEARSHORE PLACEMENT TYPE 1 MATERIAL
- 1 FOOT BACKFILL AND NEARSHORE PLACEMENT TYPE 2 MATERIAL
- 15% BACKFILL PLACEMENT TO AN ELEV. OF 114.0 FEET TYPE 1 MATERIAL
- 15% BACKFILL PLACEMENT TO AN ELEV. OF 114.0 FEET TYPE 2 MATERIAL
- 15% BACKFILL PLACEMENT TO ORIGINAL BATHYMETRY TYPE 1 MATERIAL
- 15% BACKFILL PLACEMENT TO ORIGINAL BATHYMETRY TYPE 2 MATERIAL
- 6 INCH TYPE 2 MATERIAL OVER BUCKET REFUSAL DELINEATED AREAS
- POTENTIAL LOCATION FOR RIVERLINE FRINGING WETLAND CONSTRUCTION (PLANTING BY OTHERS)
- NEARSHORE BORDER (117.5 FEET)
- NATURAL SHORELINE, MODERATE ENERGY (SEE DETAILS SHEET B-0023)
- NATURAL SHORELINE, LOW ENERGY (SEE DETAILS SHEET B-0023)
- NEARSHORE BORDER SET POINT
- 15% BACKFILL AREA
- CAP AREA (MEDIUM TO HIGH VELOCITY - TYPE A)

DATE	9/25/09	APPROVED BY	JHG	RECORD DRAWING	MG
REV	1	DATE	9/25/09	ISSUED FOR USE (SEE NOTE 3)	MG
REV	0	DATE	9/27/09	ISSUED FOR EPA REVIEW	MG
REV		DATE		DRAWING DESCRIPTION	PMI

PARSONS
GEOTECHNICAL ENGINEERING
1000 BOULEVARD OF THE SEAS
FLOOR 10
FORT EDWARD, N.Y. 12828 (518) 746-5311

PROJECT: CU-5 BACKFILL & CAPPING PLAN
DRAWING NO: CU5-BC-6 A
VERSION SCALE: AS SHOWN
JOB NO: 442209.01-001

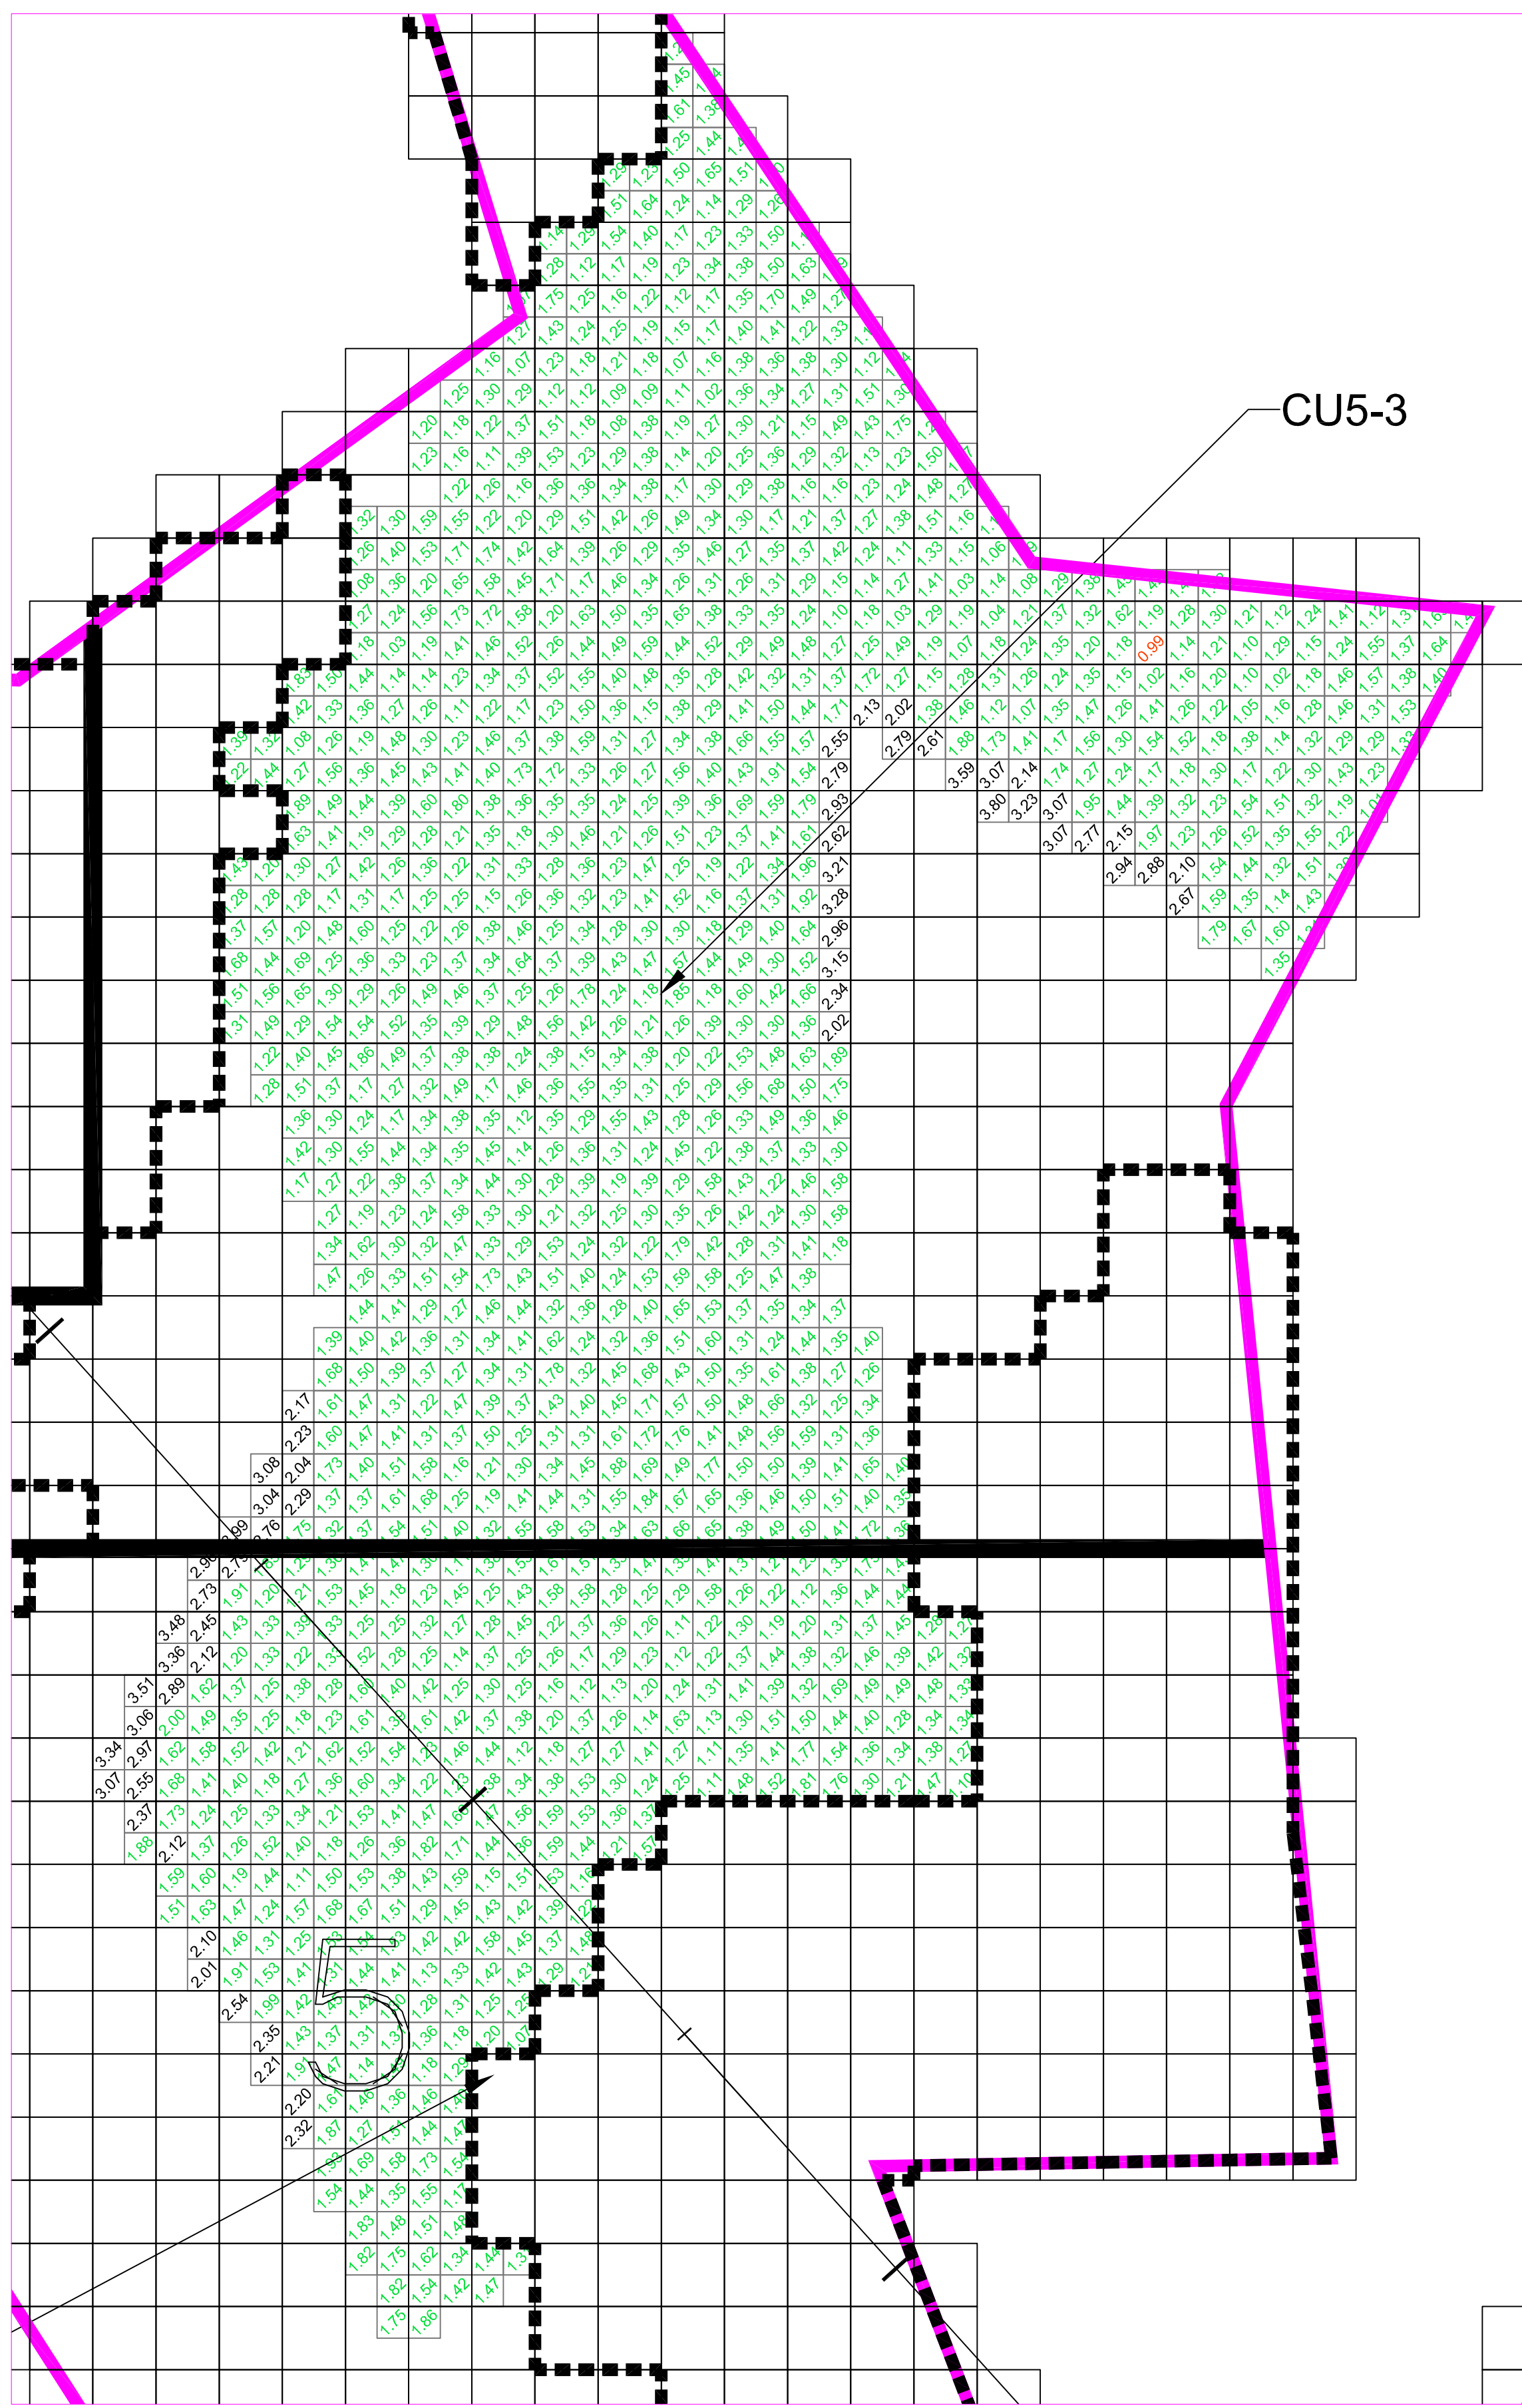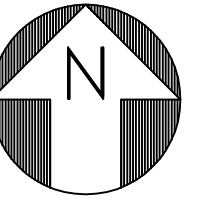

CU5 TYPE A CAP PLACEMENT


LEGEND	
	5'x5' GRID WITHIN DESIGN GUIDELINES
	5'x5' GRID LESS THAN DESIGN GUIDELINES
	5'x5' GRID ABOVE DESIGN GUIDELINES
	ROCK/REFUSAL ENCOUNTERED VIA INVENTORY 1 DREDGING AS OF (JULY 2009)
	NEARSHORE BOUNDARY
	CU BOUNDARY
	CU SUBUNIT BOUNDARY
	MUD - RIP RAP INTERFACE
	5' INTERFACE OFFSET

NOTES:

1. OSI MULTIBEAM SURVEY ON 10/04/09.
2. CAP THICKNESS IS LISTED IN 5'x5' GRIDS.

BATHYMETRY BASED ON
OSI MULTIBEAM SURVEY
OCTOBER 15, 2009

CU 5
CAP A TYPE
ACCEPTANCE SURVEY

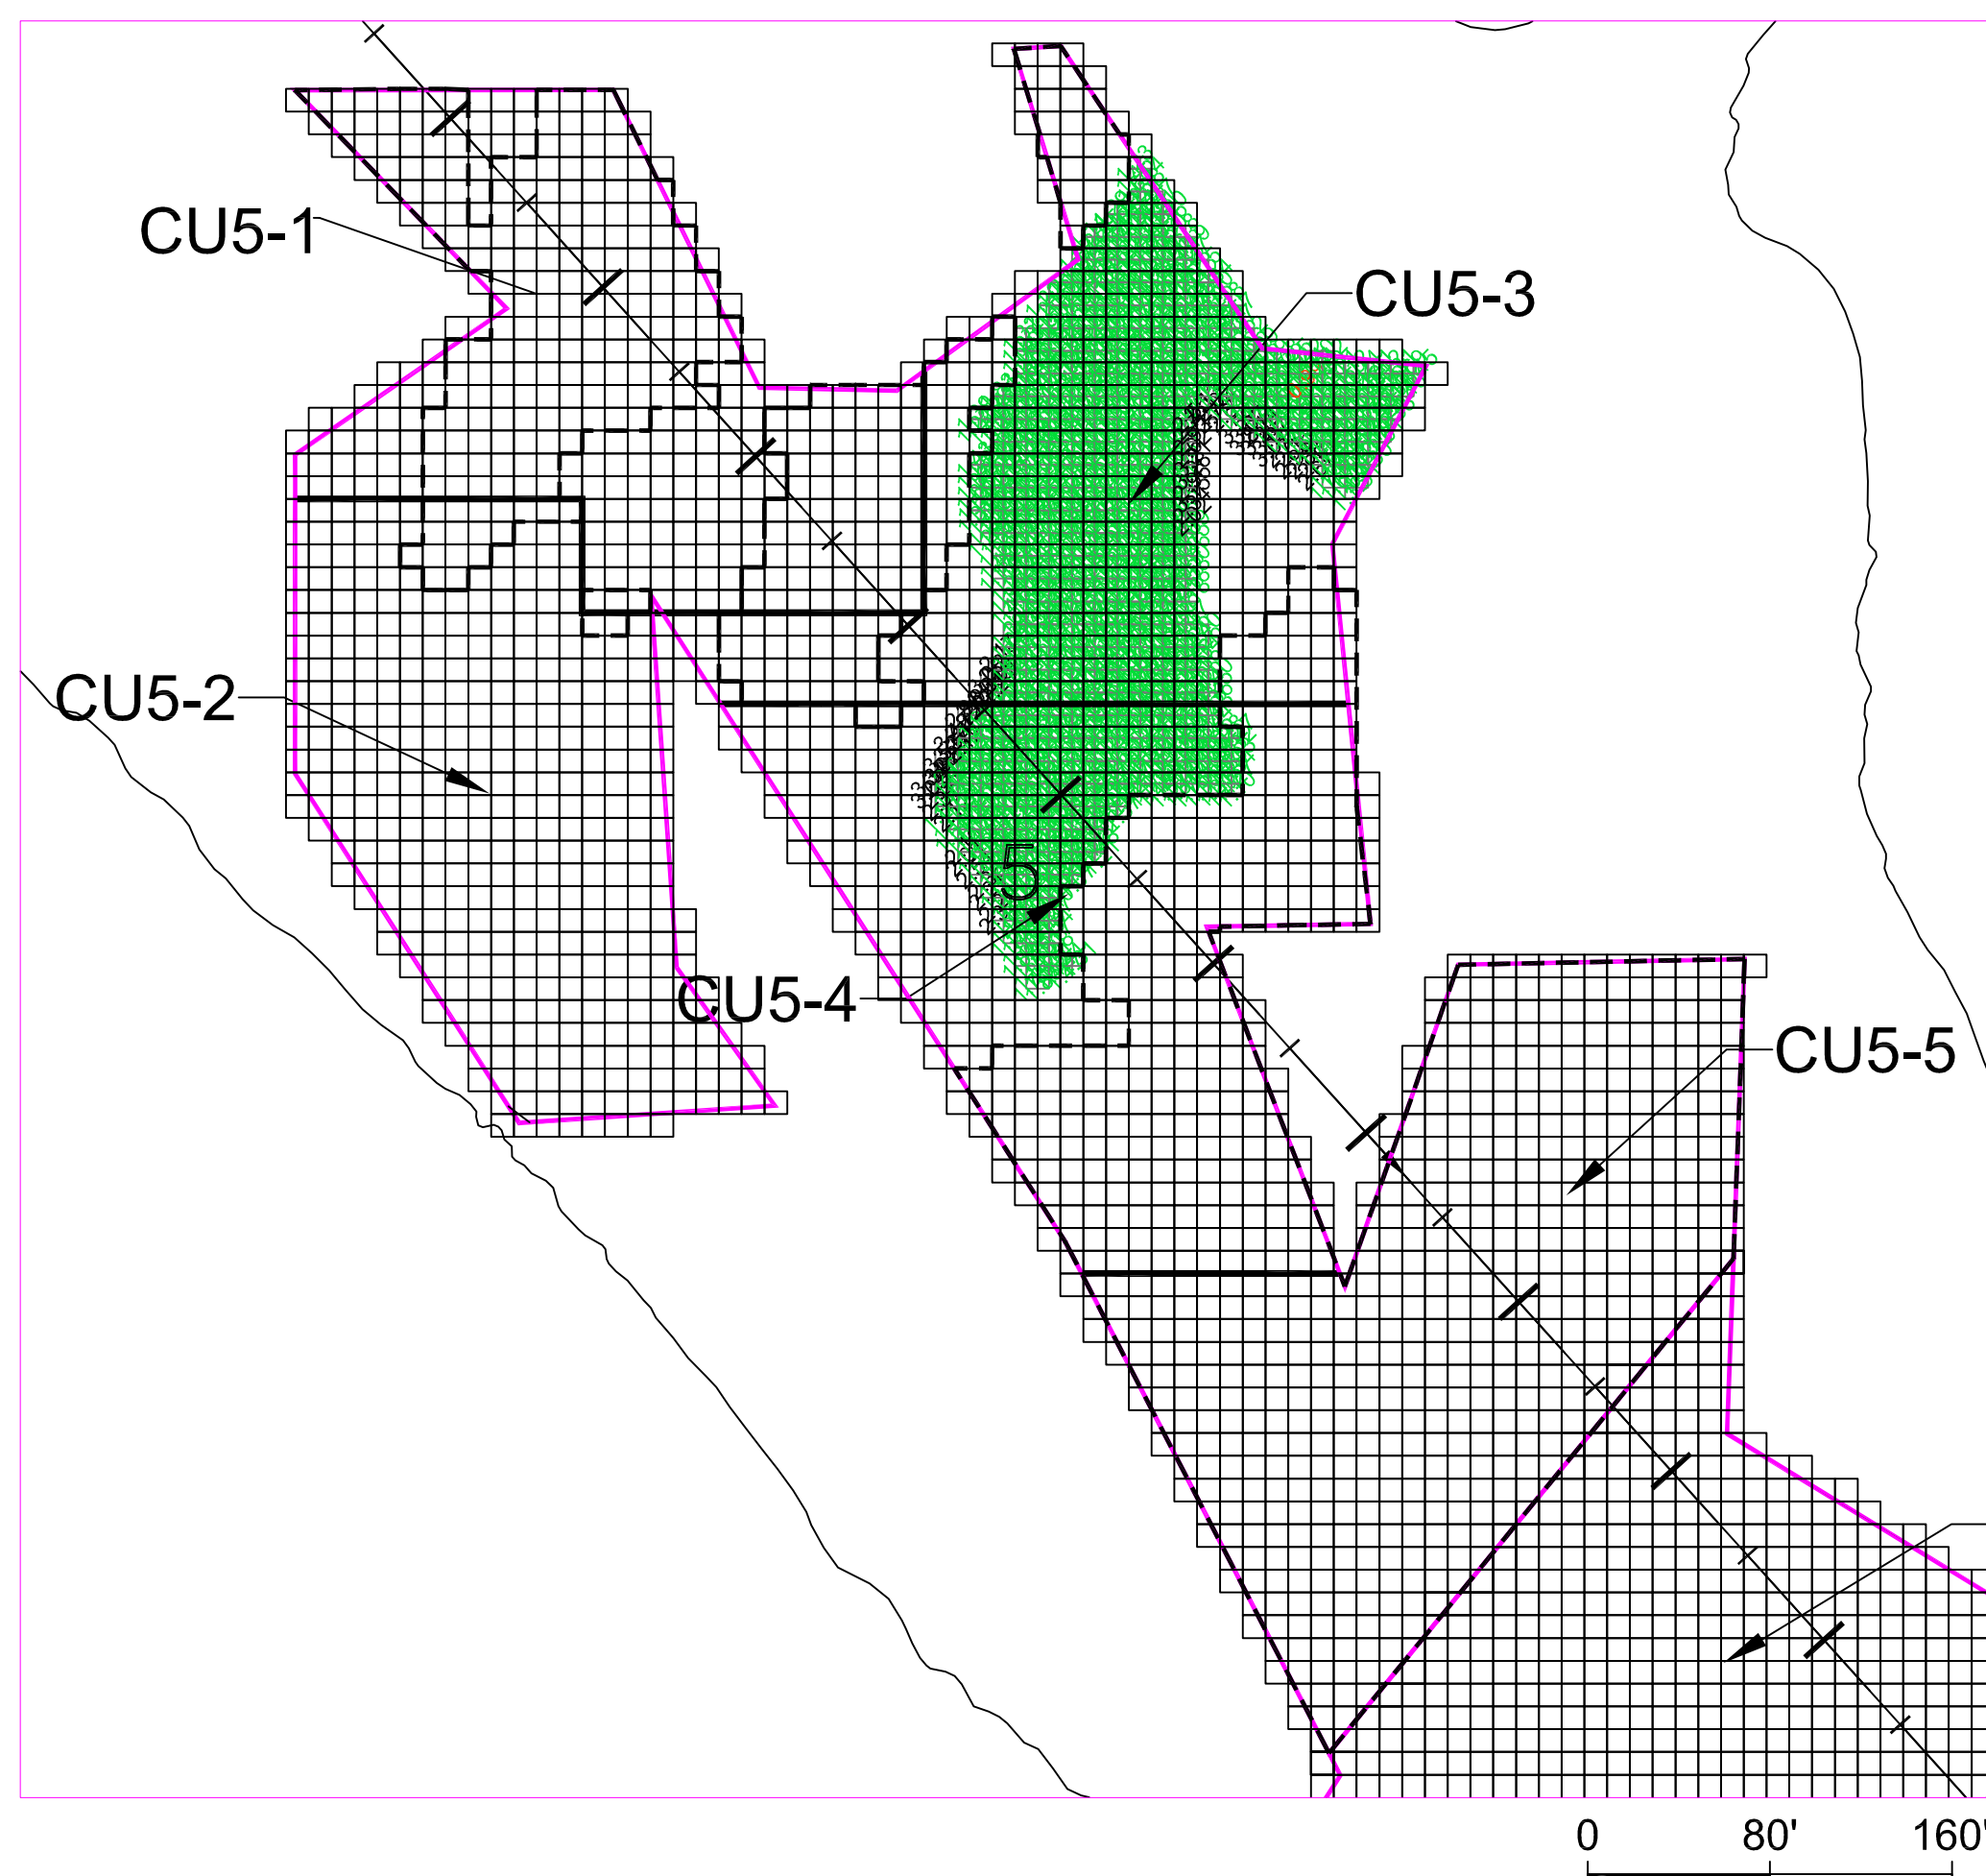

CU5 TYPE A CAP LOCATION

PARSONS COMMERCIAL TECHNOLOGY GROUP		DRAWING TITLE	
GE COMPANY - PARSONS PROJECT OFFICE BUILDING 40-1, 381 BROADWAY FORT EDWARD, N.Y. 12828 (518) 746-5311		CU5 CAP A TYPE ACCEPTANCE SURVEY	
DRAWN BY JHC	CHECKED BY MG	DRAWING NO. CU5-1	VERSION SCALE AS SHOWN
DATE 10/19/09	APPROVED BY MG		JCB 442209.01401

CU-06

Form 2

CU Certification of Completion

CU BACKFILL / ENGINEERED CAP COMPLETION APPROVAL - FORM 2						
Reporting Date	10/27/2009				Placement Start Date	10/4/2009
CU Number	6				Placement End Date	10/24/2009
Approximate CU Centroid	Northing	1615839	Easting	734231	NY State NAD 83	
CU Size	4.94	Acres				
Backfill Area	3.61	Acres*				
Cap Area	1.33	Acres				
Backfill Surface Mean Tri+ PCBs Concentration (when required)		NA		mg/kg		
Number of nodes sampled		NA		mg/kg		
Backfill	Type of Backfill	Reference to appropriate drawings attached to Approval Form 1				
x	Type 1, Type 2, Nearshore, 15%	CU6 Backfill and Cap Plan, 10/02/09				
Cap	Type of Cap	Reference to appropriate drawings attached to Approval Form 1				
x	Type "A" Medium to High Velocity	CU6 Backfill and Cap Plan, 10/02/09				
CU Checklist		Indicate one of the following			Reviewer Initial Acceptance	
Item	Attached	Not Applicable	GE	EPA		
Drawing of Installed Backfill/Cap (with record details, thickness and sample locations [when backfill/cap are placed])	x					
Where applicable in backfill areas provide the following: Sample locations (coordinates), depths, Aroclor and Tri+ PCB concentrations collected including analytical data, field observations, (hard copy and electronic copies [in database format or equivalent])		x				
Comments						
Refer to attached Narrative Backfill Summary and CU 6 Backfill and Cap Drawings. *Backfill Area does not include 15% backfill material placed over Cap Area.						
Upon signing this document, GE certifies that the backfill/cap has been installed satisfactorily and that no further backfill placement or capping is required for this CU. These remedial activities exclude long term operation, monitoring, maintenance and adaptive management at the CU. EPA accepts this certification.						
Signature of GE Representative				Signature of EPA Representative		
_____ Signature				_____ Signature		
_____ Name				_____ Name		
_____ Date				_____ Date		

Narrative

CU 6

Narrative Summary of Backfill and Capping and EPA Backfill and Capping Agreements

1.0 Cap Placement

A Type "A" medium to high velocity cap was placed in accordance with the CU 6 Backfill and Capping Plan Drawing, dated October 2, 2009, which was provided to EPA as part of the Form 1 package. A multi-beam bathymetric survey of the CU 6 cap was performed after final cap placement on October 14, 2009, as shown on the attached CU 6 Type "A" Cap Acceptance Survey, dated October 15, 2009. The surveyed cap thickness on a 5' x 5' grid is shown for all cap areas.

2.0 Backfill Placement

Backfill materials were placed in accordance with the CU 6 Backfill and Capping Plan Drawing, dated October 2, 2009, which was provided to EPA as part of the Form 1 package. Multi-beam bathymetric surveys for CU6 were performed after backfill placement on October 22 and October 24, 2009, as shown on the attached CU6 Post Backfill Placement Acceptance Drawing, dated October 25, 2009. The difference to dredge prism on a 10' x 10' grid is shown for all backfill areas, however it should be noted that the 6" backfill placed in the bucket refusal areas is not subject to any acceptance tolerance and is provided for information only.



3.0 EPA Field Agreements Specific to CU 6 Backfill and Capping

1. The plan used to place backfill and cap in CU6 was approved by EPA on October 2, 2009 as part of the CU 6 Acceptance Form 1 package. Changes were made to the CU6 Backfill and Cap Plan on October 7, 2009 to show no placement of 1' backfill over the north area Type "A" medium to high velocity cap (Revision 2 to CU6 Backfill and Cap Plan). The drawing was changed on October 14, 2009 to show no placement of 1' backfill over the southern Type "A" medium to high velocity cap (Revision 3 to CU6 Backfill and Cap Plan).
2. During the 4:00 PM meeting on October 12, 2009, EPA agreed that acceptance surveys of partial areas of a CU may be performed and used for acceptance once placement of backfill or cap in those areas is complete.
3. During the 4:00 PM meeting on October 15, 2009, GE presented acceptance surveys of the top of cap elevations in CU6. It was agreed that the placement of cap materials on top of the former road bridge pier foundations was impractical and that cap placement tolerances would not apply in those locations. Based on the information presented by GE, EPA


accepted that the top of cap elevations were within the required design tolerances. The Cap Acceptance Survey Drawing, dated October 25, 2009 is included in this package.

4. During the 4:00 PM meeting on October 23, 2009, GE presented acceptance surveys of the top of backfill elevations in CU6. Based on the information presented by GE, EPA indicated additional backfill placement is required in the southern portion of CU6 near the NYS Route 197 bridge piers. On October 23, 2009, GE directed the Dredging Contractor to place additional backfill in this area, and a third party multi-beam survey of this area was completed on October 24, 2009. The Backfill Acceptance Survey Drawing, dated October 25, 2009, included in this package, reflects the new survey data.

Figures

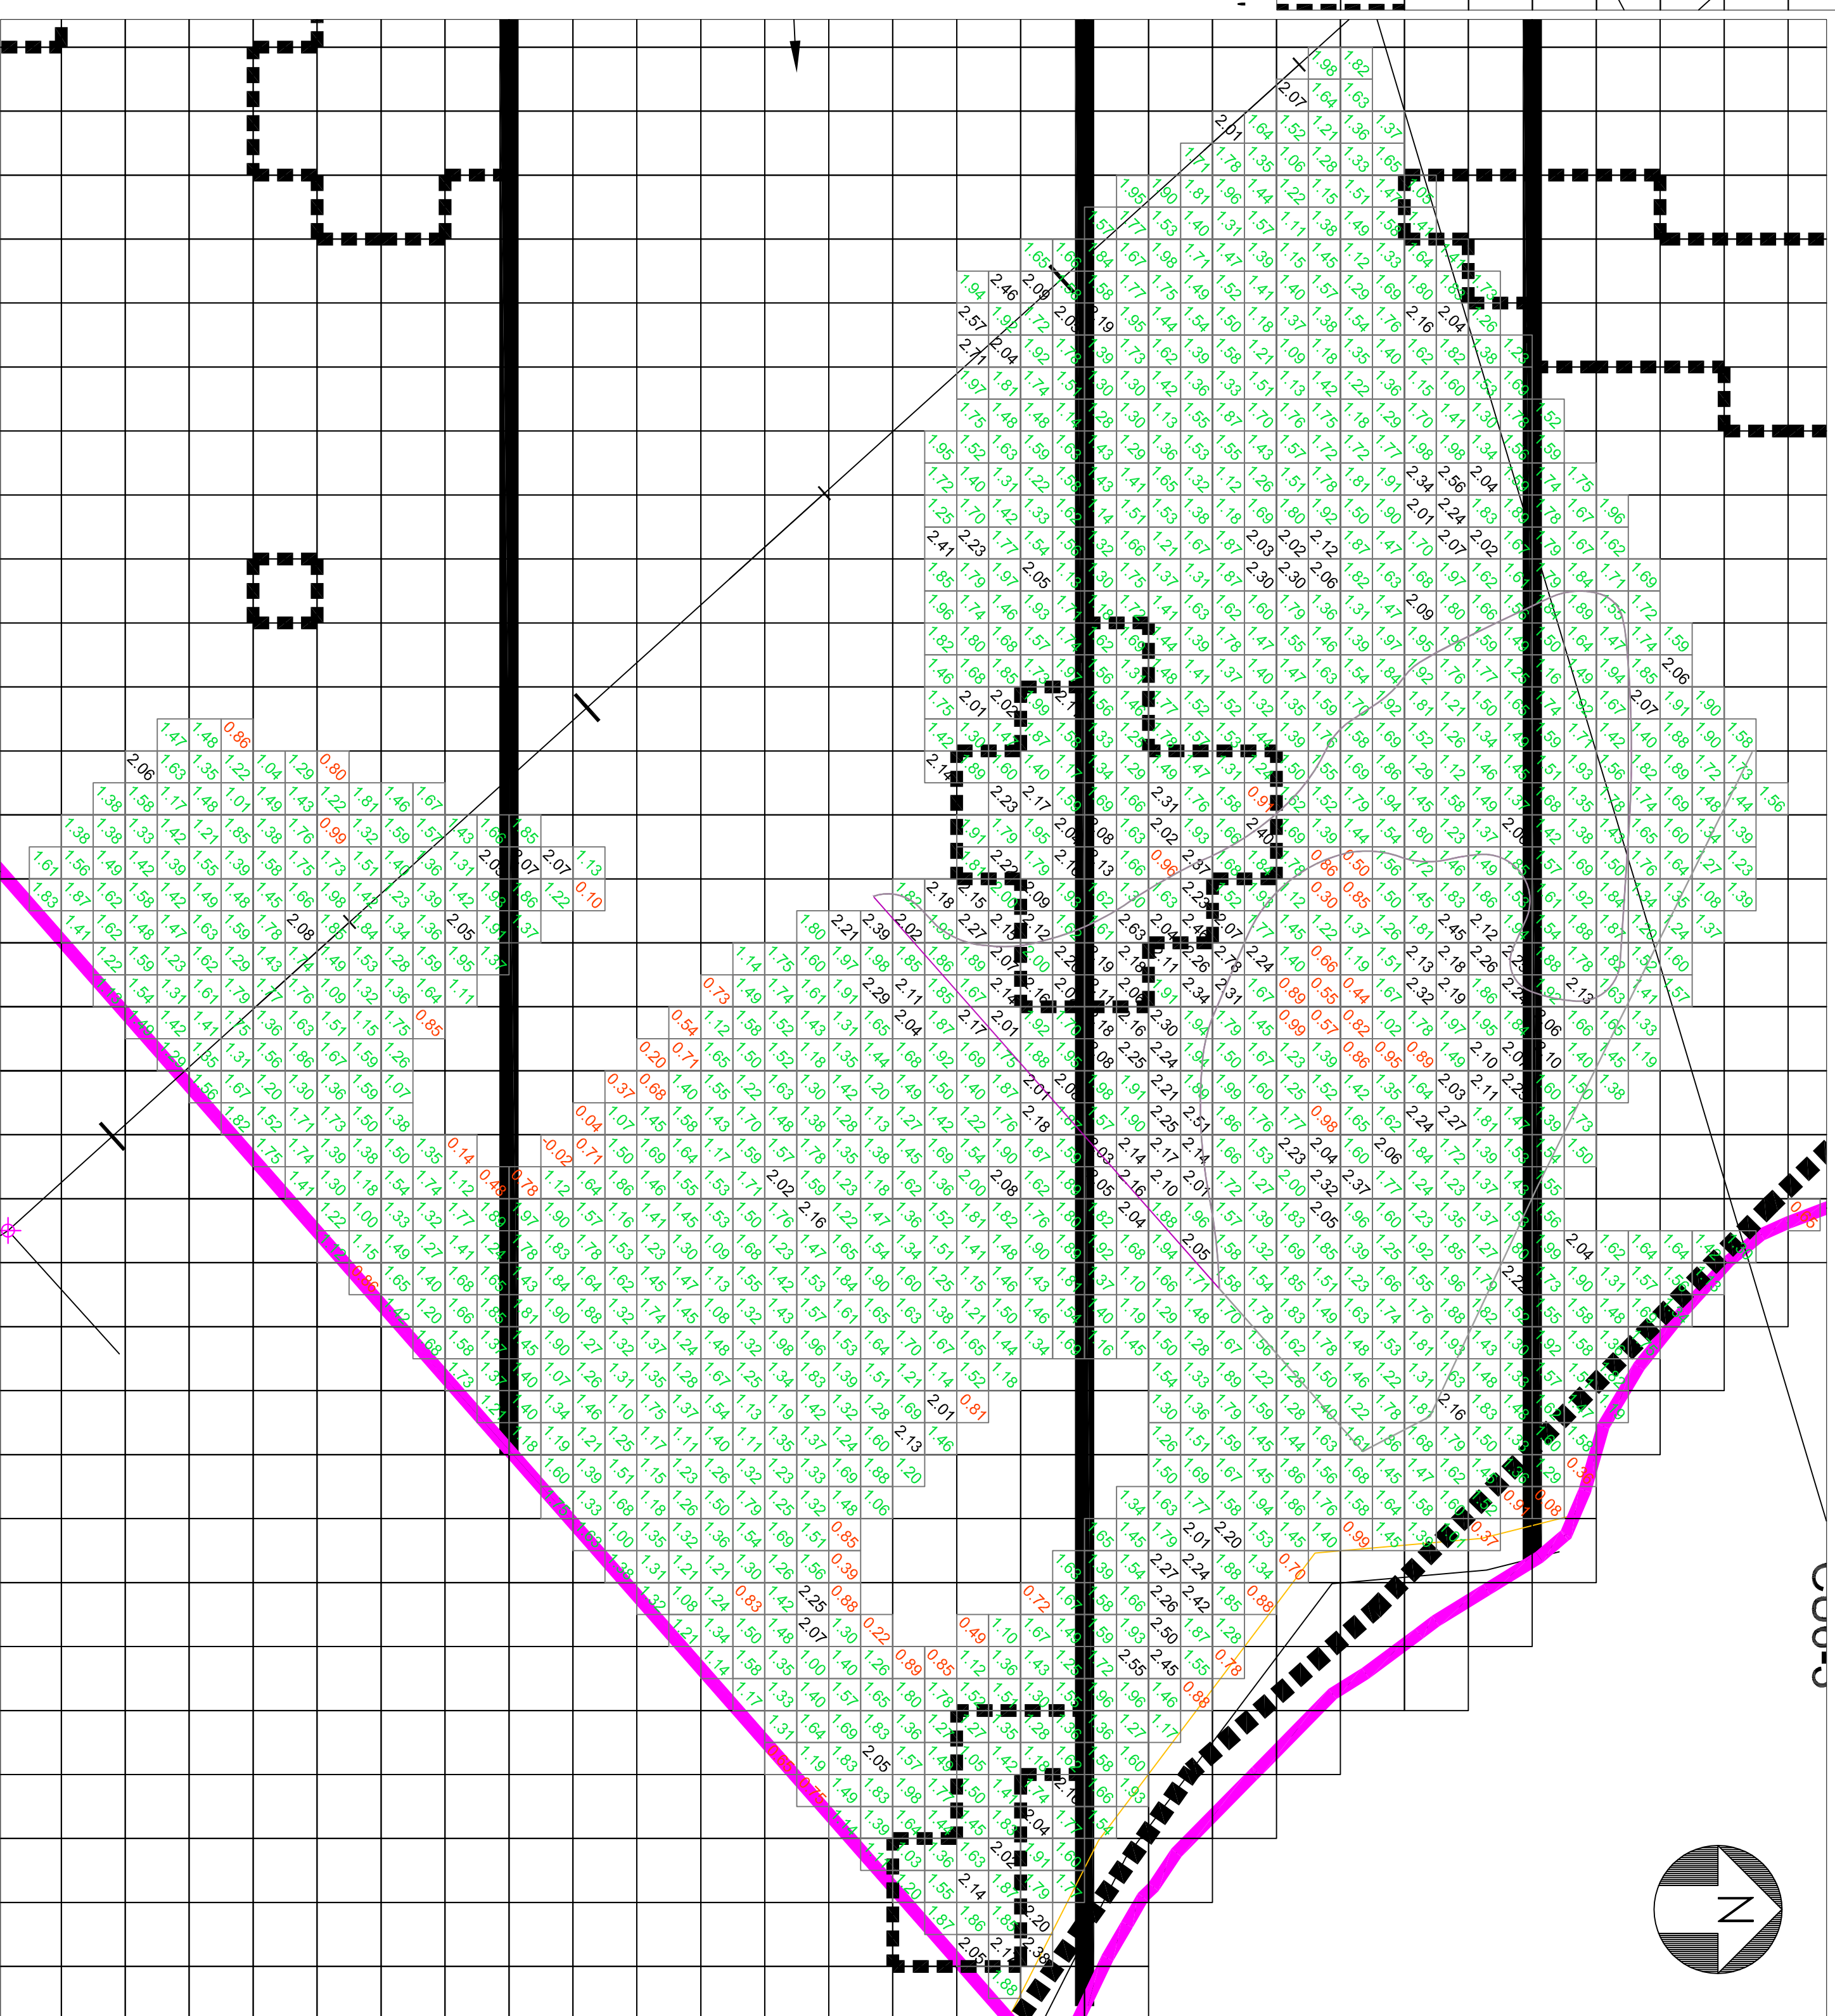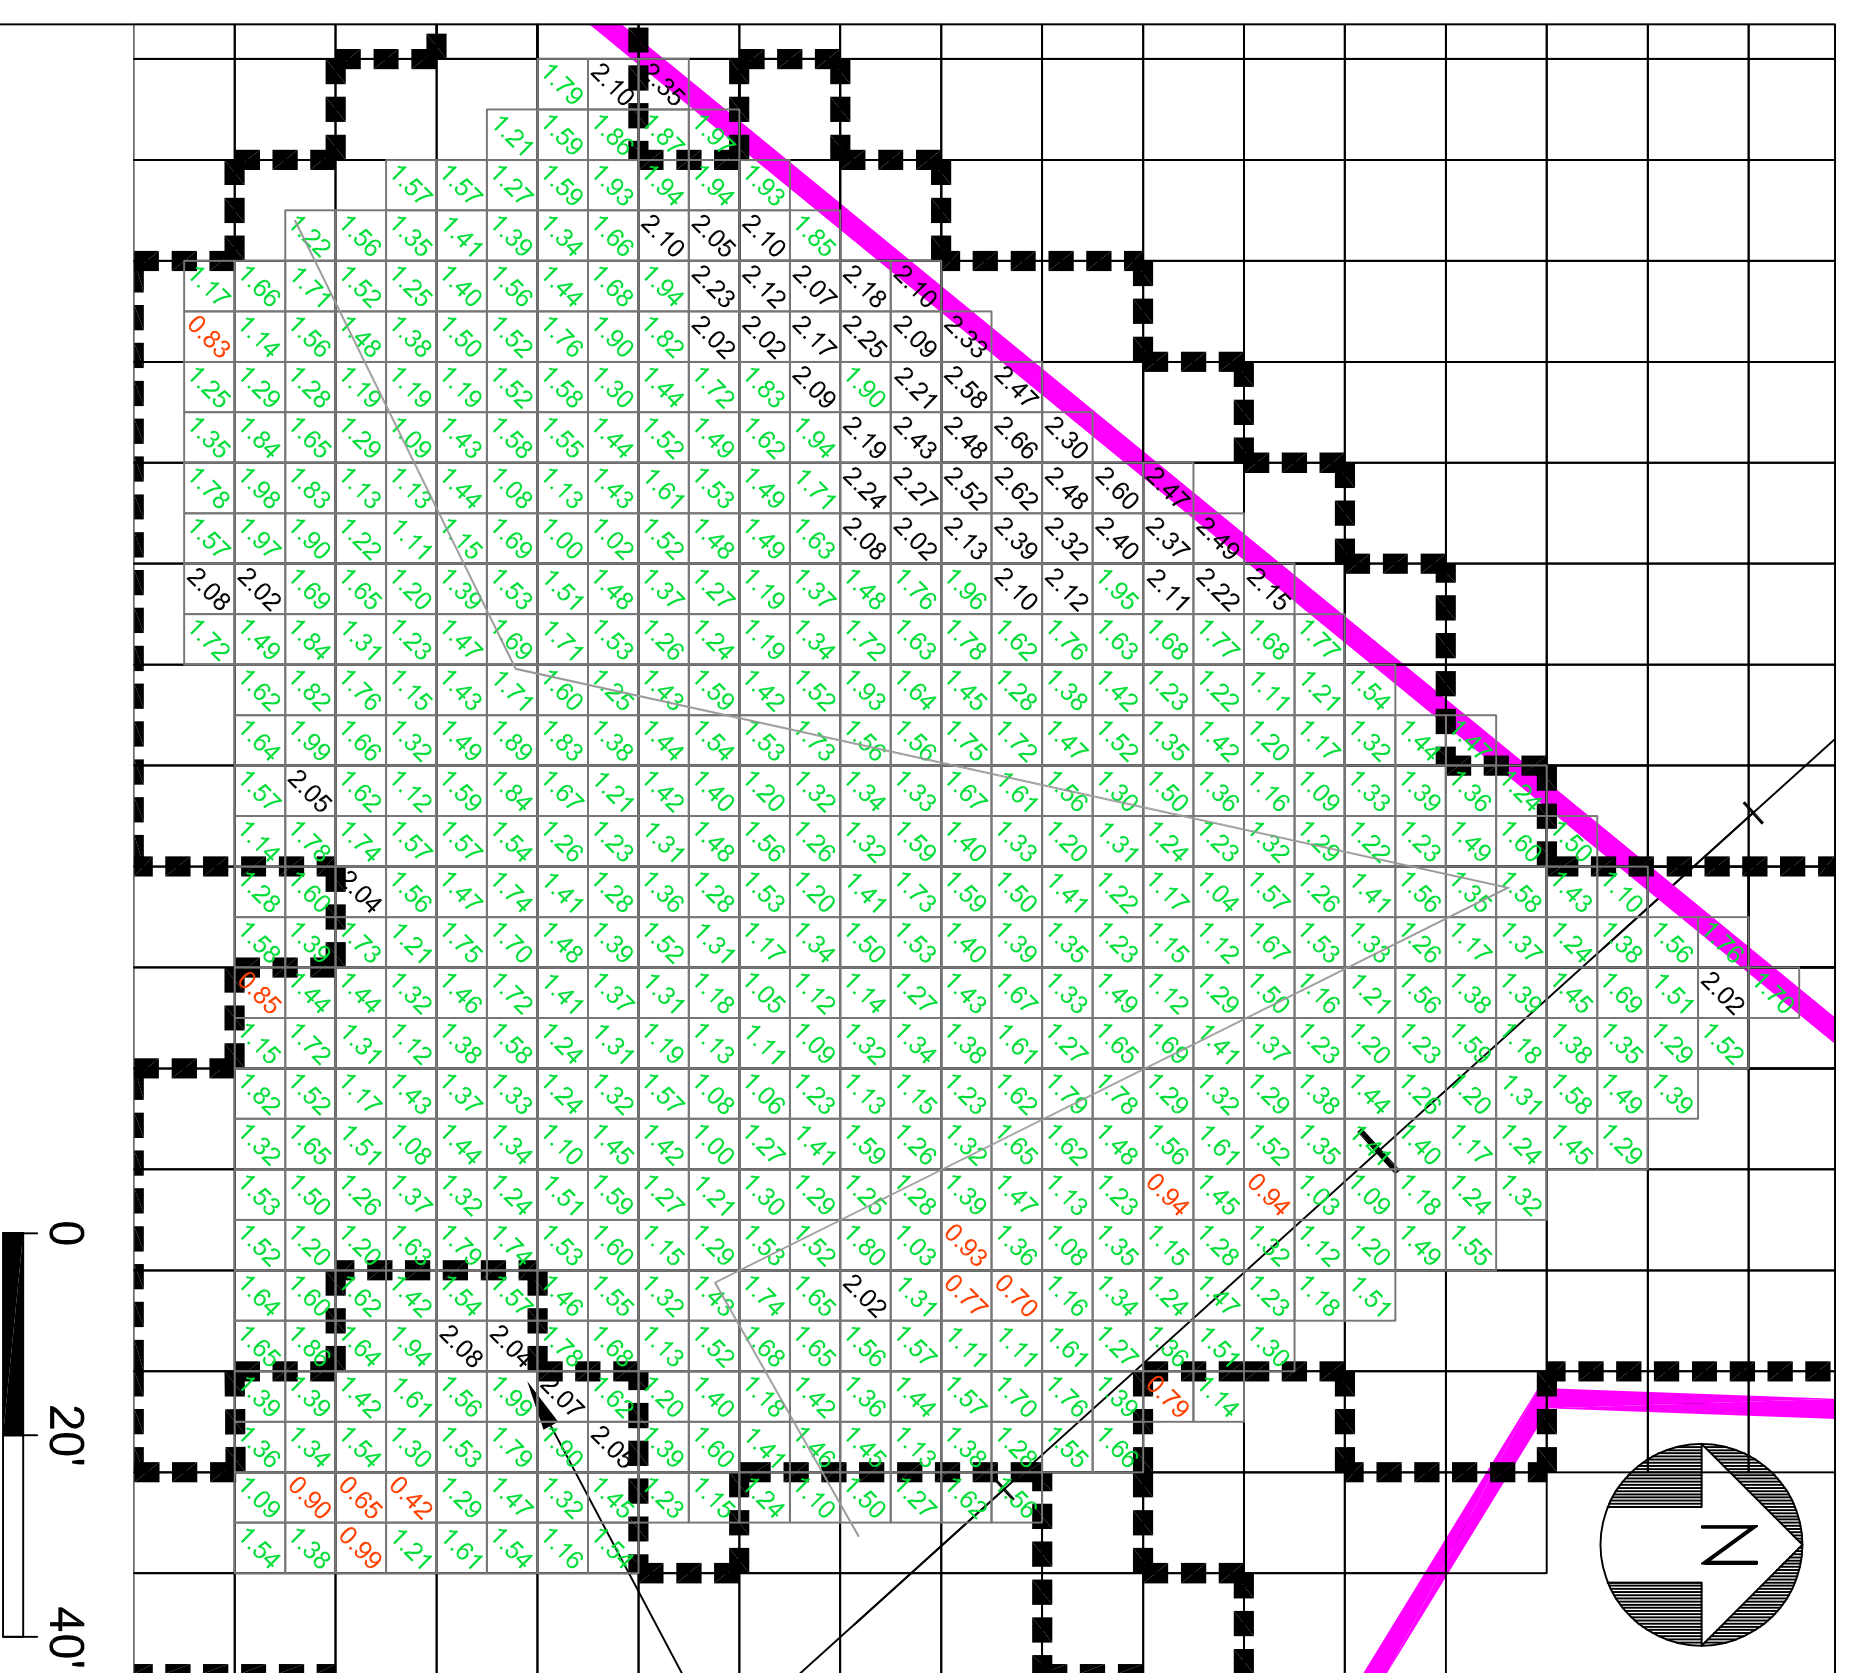

- NOTES:**
1. OSI MULTIBEAM SURVEY ON 10/14/09.
 2. CAP THICKNESS IS LISTED IN 5'x5' GRIDS.

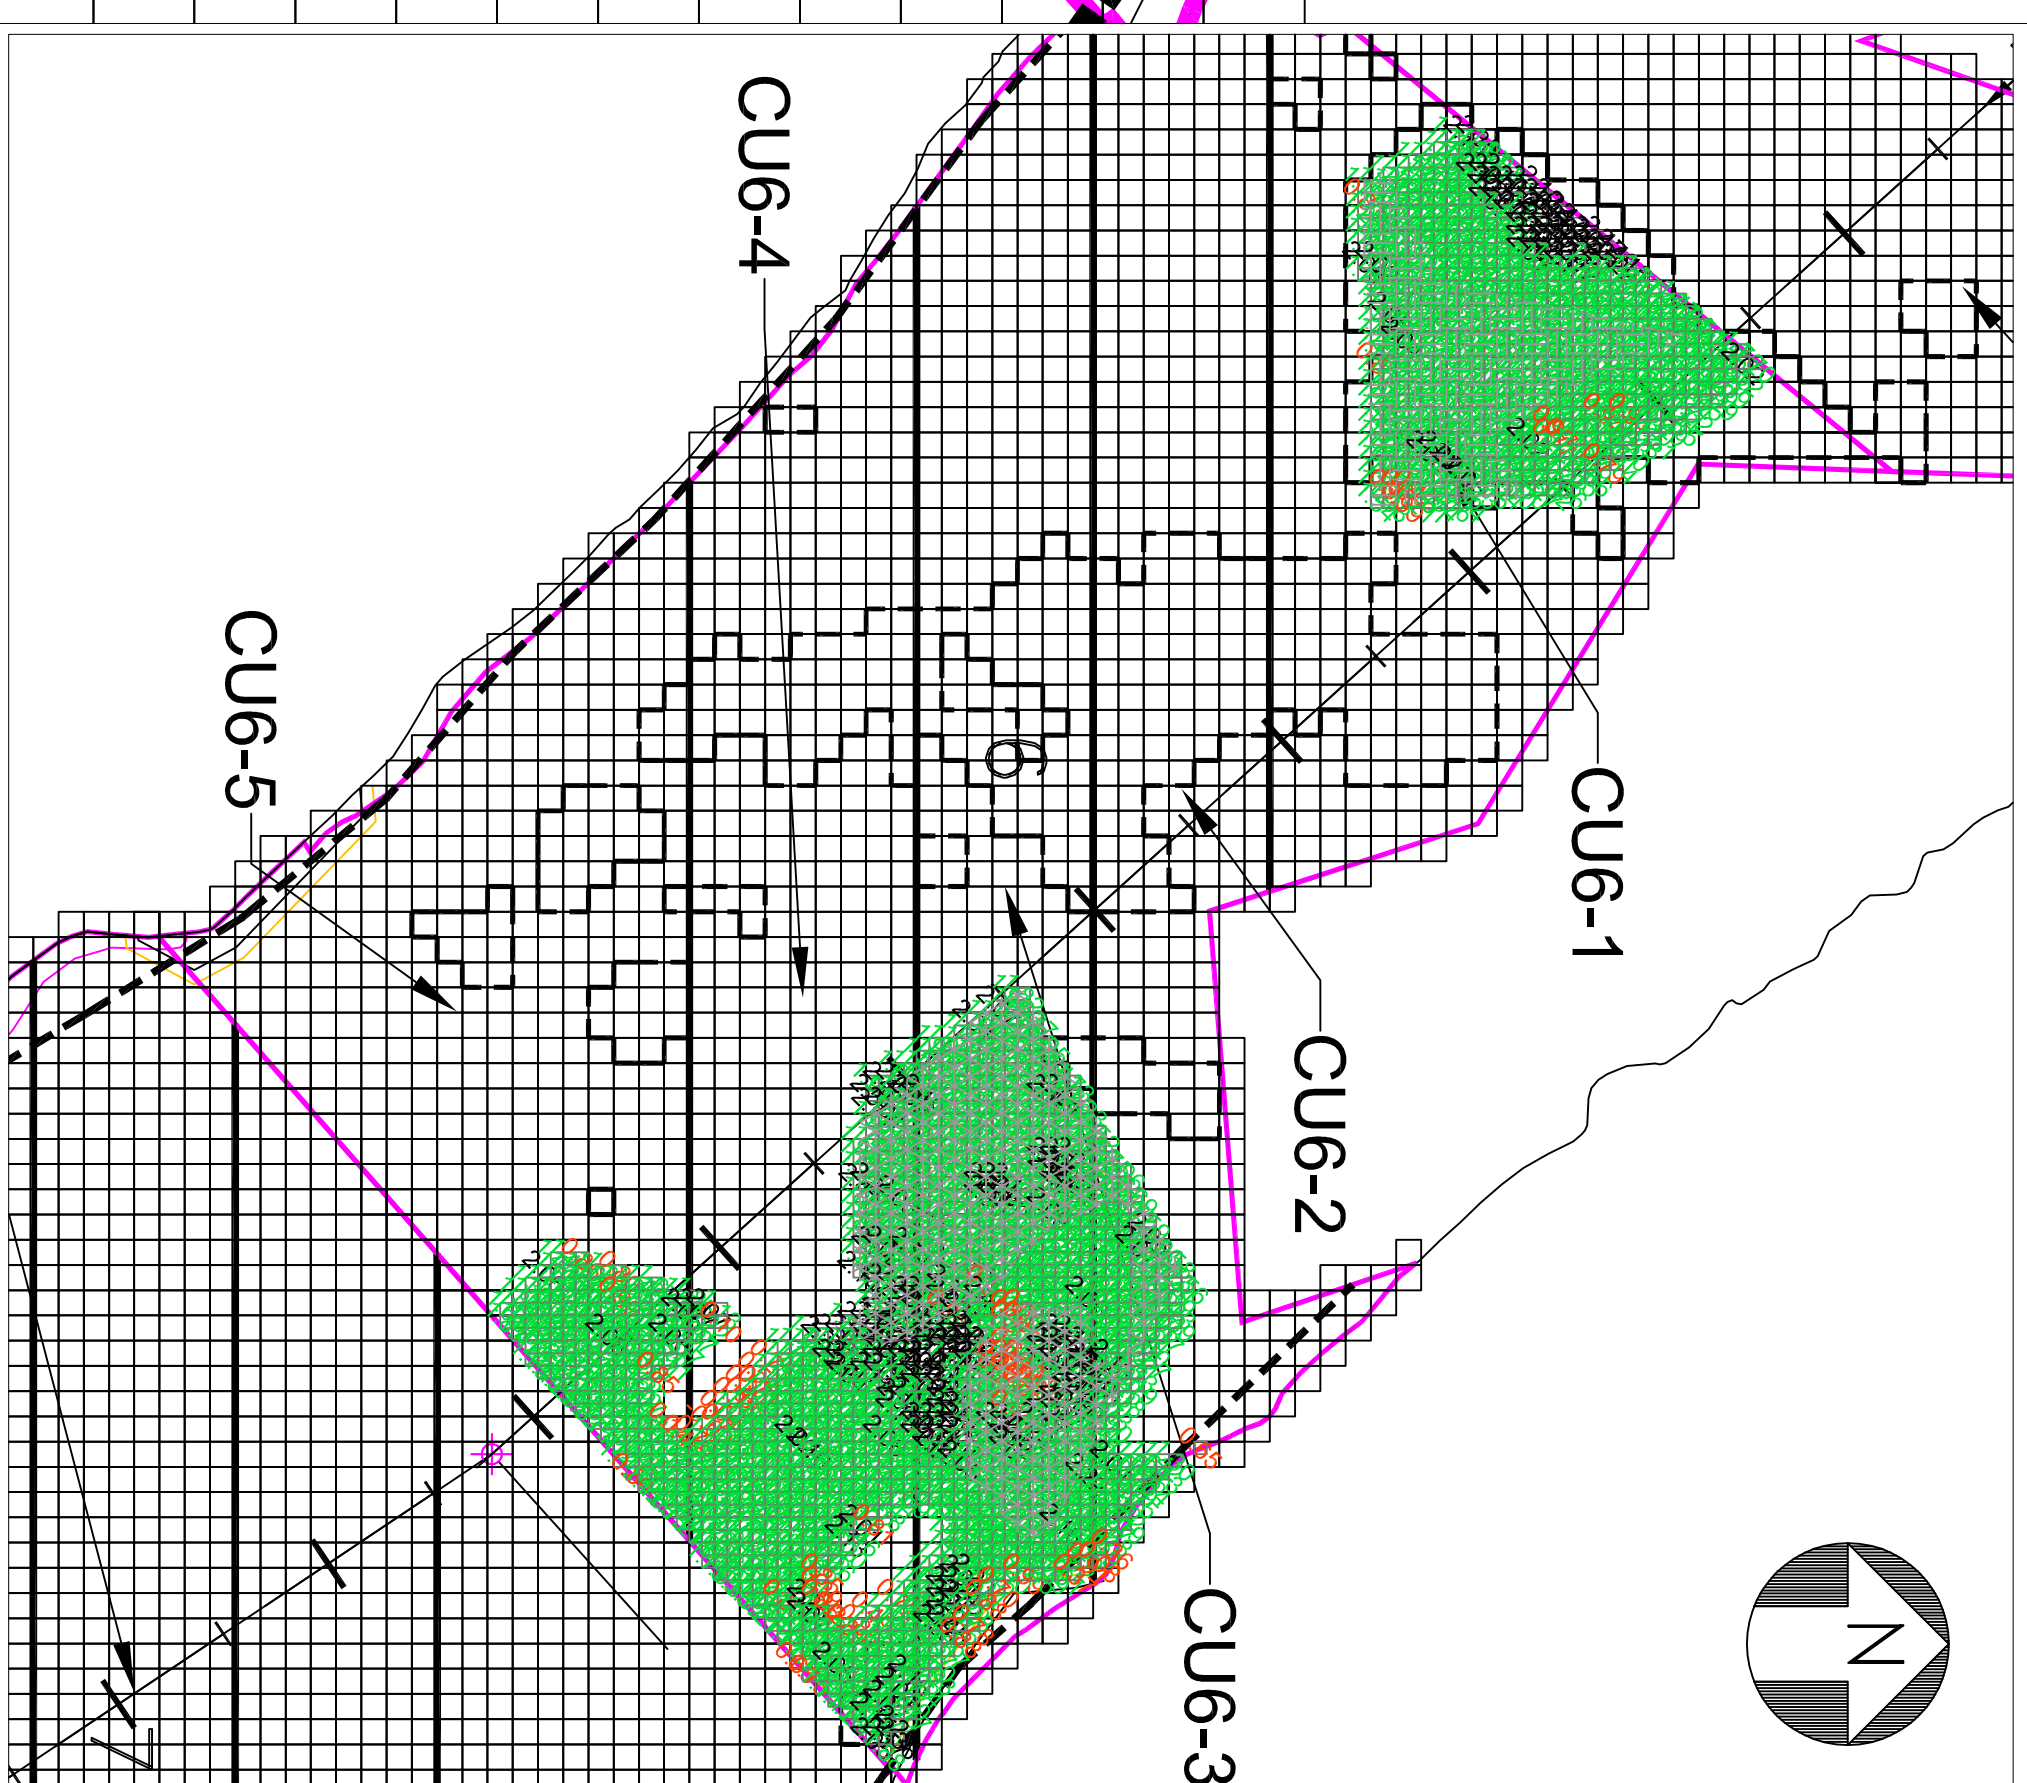

LEGEND	
	5'x5' GRID CELL DEPTH OF CAP PLACEMENT WITHIN DESIGN SPECIFICATIONS.
	5'x5' GRID CELL DEPTH OF CAP PLACEMENT LESS THAN 1 FT BELOW DESIGN SPECIFICATIONS.
	5'x5' GRID CELL DEPTH OF CAP PLACEMENT GREATER THAN 1 FT (NOT ACCEPTABLE)
	BUCKET REFUSAL ENCOUNTERED DURING INVENTORY DREDGING
	CU BOUNDARY
	CU SUBUNIT BOUNDARY
	MUD - RIP RAP INTERFACE
	5' INTERFACE OFFSET

CU-6
TYPE A CAP
ACCEPTANCE SURVEY

CU6 TYPE A CAP PLACEMENT

CU6 TYPE A CAP LOCATION


REV	DATE	DRN BY	DRAWING DESCRIPTION	MG
0	10/15/09	JHG	ACCEPTANCE SURVEY	MG
PARSONS GE COMPANY - PARSONS PROJECT OFFICE BUILDING 40-1, 381 BROADWAY FORT EDWARD, N.Y. 12828 (518) 746-5311				PM
DRAWING TITLE CU6 TYPE A CAP ACCEPTANCE SURVEY				
DRAWN BY JHG		CHECKED BY JHG		DRAWING NO. CU6-1
DATE 10/15/09		APPROVED BY JHG		SCALE AS SHOWN 442209.01401

CU-06 Near-Shore Topographic Soundings Summary Table
Collected 2009-10-22

Published Near-Shore Locations		Near-Shore Confirmation		Check	Horz.	Vert.
Name	Easting	Northing	Elevation	Elevation	Dist	Diff.
6-1	734,417.77	1,615,982.87	117.50	117.99	0.32	0.49
6-2*	734,480.87	1,615,917.34	117.50	116.26	0.28	-1.24
6-3	734,544.34	1,615,855.23	117.50	117.19	0.01	-0.31
6-4	734,569.42	1,615,826.72	117.50	117.90	1.10	0.40
6-5	733,881.15	1,615,903.39	117.50	117.68	0.20	0.18
6-6	733,956.97	1,615,835.27	117.50	117.38	0.28	-0.12
6-7	734,034.74	1,615,778.22	117.50	117.95	0.39	0.45
6-8	734,114.40	1,615,706.40	117.50	117.30	0.19	-0.20
6-9	734,167.30	1,615,650.46	117.50	117.34	0.17	-0.16
6-10	734,225.04	1,615,600.00	117.50	117.26	0.18	-0.24
6-11	734,272.39	1,615,542.65	117.50	117.98	0.68	0.48

*Land surveyors noted Rip-Rap near location.

LEGEND

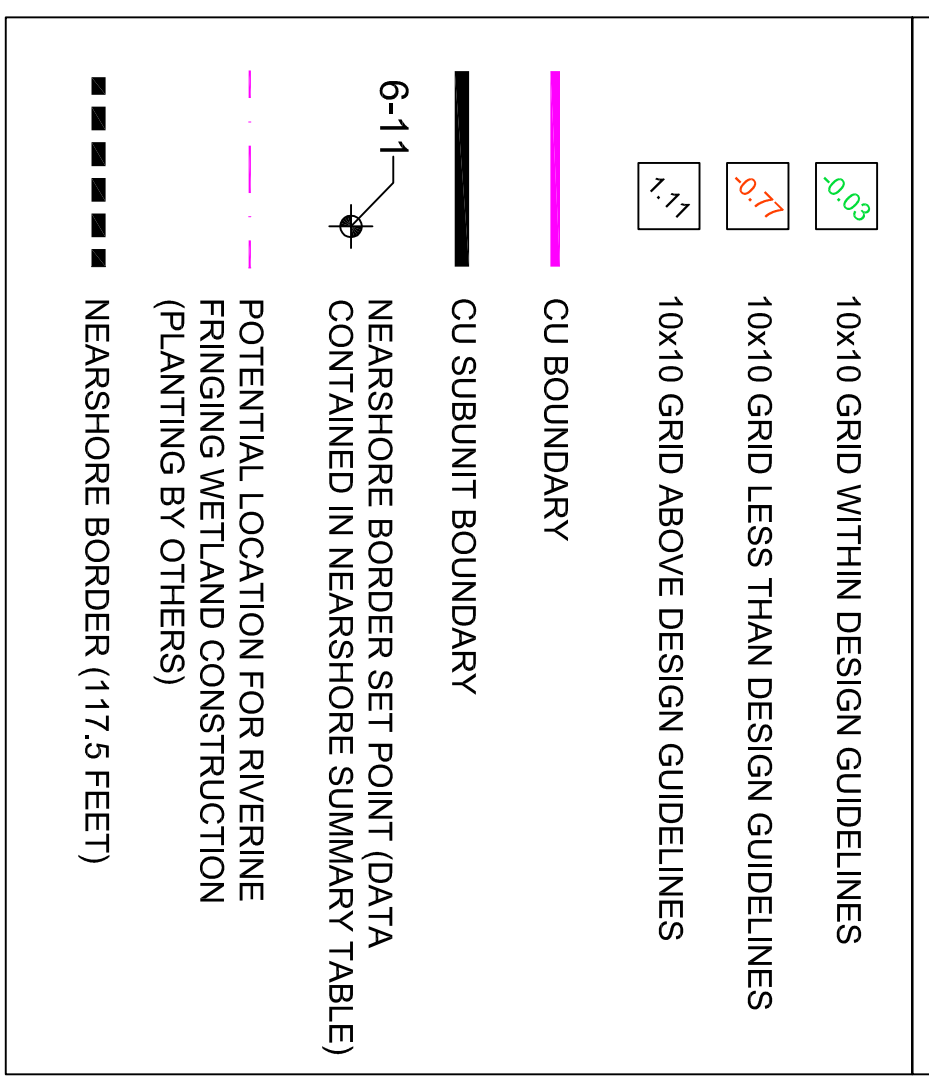

- NOTES:
- OSI MULTIBEAM SURVEY DATE #1 OCTOBER 22, 2009.
 - BASED ON RESULTS OF MULTIBEAM #1, DREDGING CONTRACTOR PLACED ADDITIONAL BACKFILL ON OCTOBER 23 & OCTOBER 24, 2009. DATA IN CLOUDED AREA BASED ON OSI MULTIBEAM SURVEY DATE #2 OCTOBER 24, 2009.
 - BUCKET REFUSAL AREAS NOT INCLUDED AS PART OF CU ACCEPTANCE PROCESS.
 - 4,211 CY OF 15% BACKFILL MATERIAL PLACED DURING BACKFILLING. BACKUP CALCULATIONS AVAILABLE UPON REQUEST.



Area	Average Thickness (ft)	Approx. Area (acre)	Intended Vol. Placed (CY)	Actual Vol. Placed (CY)	Variation from Planned (CY)
CU06	1.53	0.61	981.5	1501.0	519.5

Notes:
Average thickness and volumes were computed using 10x10 cell center average data sets.

CU-6
1 FOOT BACKFILL PLACEMENT
ACCEPTANCE SURVEY

REV/	DATE	DRN BY	DRAWING DESCRIPTION	DRAWING TITLE
2	10/26/09	JHG	REVISED PER EPA COMMENTS	MG
1	10/25/09	JHG	OSI MULTIBEAM SURVEY #2 - ISSUED FOR EPA REVIEW	MG
0	10/23/09	JHG	OSI MULTIBEAM SURVEY #1	MG
			DRAWING DESCRIPTION	PM

PARSONS
CONSULTANTS
PROJECT OFFICE
BUILDING 40-1, 381 BROADWAY
FORT EDWARD, N.Y. 12828 (518) 746-5311


DATE: 10/26/09
DRAWN BY: JHG
CHECKED BY: JHG
APPROVED BY: JHG

SCALE: AS SHOWN


DRAWING NO: CU6-2
JOB: 442209.01-01

LEGEND

	NO DREDGE BORDER BASED ON RESULTS OF BUCKET REFUSAL AREA AND AID 1 PROBING INVESTIGATION RESULTS.
	CU SUBUNIT BOUNDARY
	CU SUBUNIT BOUNDARY
	MUD - RIP RAP INTERFACE
	5' INTERFACE OFFSET
	1 FOOT BACKFILL AND NEARSHORE PLACEMENT TYPE 1 MATERIAL
	1 FOOT BACKFILL AND NEARSHORE PLACEMENT TYPE 2 MATERIAL
	15% BACKFILL PLACEMENT TO AN ELEV. OF 114.0 FEET TYPE 1 MATERIAL
	15% BACKFILL PLACEMENT TO AN ELEV. OF 114.0 FEET TYPE 2 MATERIAL
	15% BACKFILL PLACEMENT TO ORIGINAL BATHYMETRY TYPE 1 MATERIAL
	15% BACKFILL PLACEMENT TO ORIGINAL BATHYMETRY TYPE 2 MATERIAL
	6 INCH BACKFILL TYPE 2 MATERIAL OVER BUCKET REFUSAL DELINEATED AREAS
	POTENTIAL LOCATION FOR RIVERINE FRINGING WETLAND CONSTRUCTION (PLANTING BY OTHERS)
	NEARSHORE BORDER (117.5 FEET)
	CAP AREA (MEDIUM TO HIGH VELOCITY - TYPE A)
	TYPE 2 MATERIAL BACKFILL PLACEMENT TO ELEVATION OF 111.0 FEET.
	NEARSHORE BORDER SET POINT (DATA CONTAINED IN NEARSHORE SUMMARY TABLE SHOWN ON DRAWING CU6-2, CU6 BACKFILL PLACEMENT ACCEPTANCE SURVEY, DATED OCTOBER 26, 2009)
	LIMIT OF NON-COMPLIANT NODE POLYGONS.

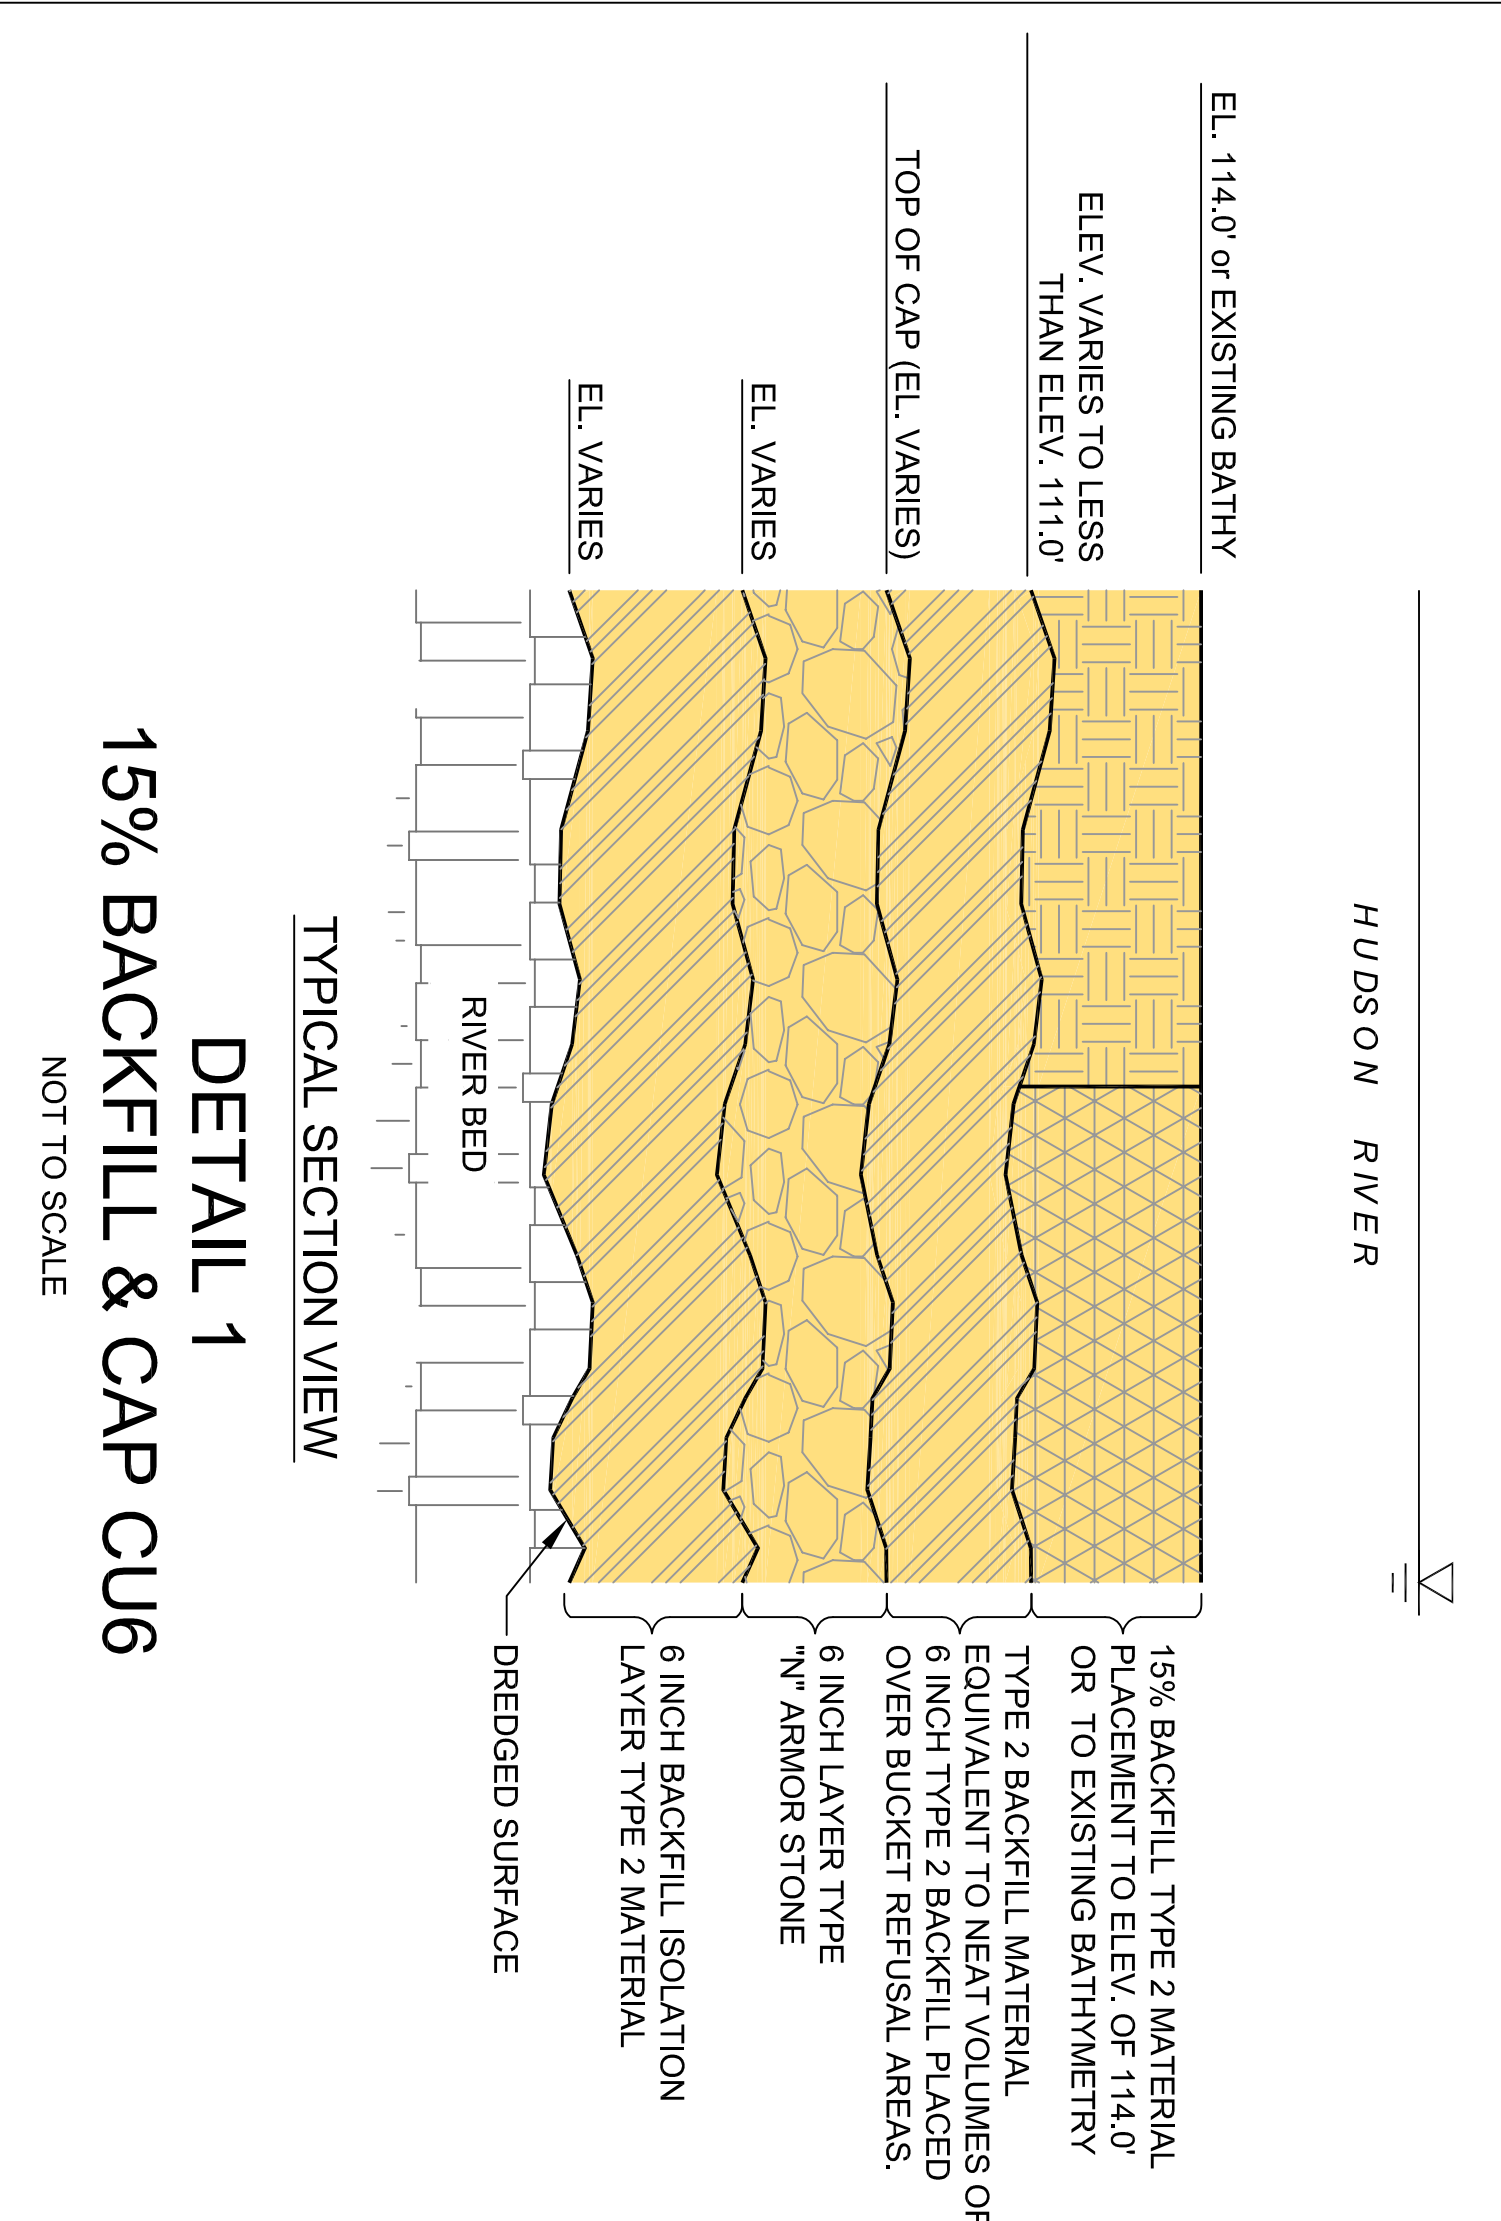


**TYPICAL SECTION VIEW
DETAIL 1
15% BACKFILL & CAP CU6
NOT TO SCALE**

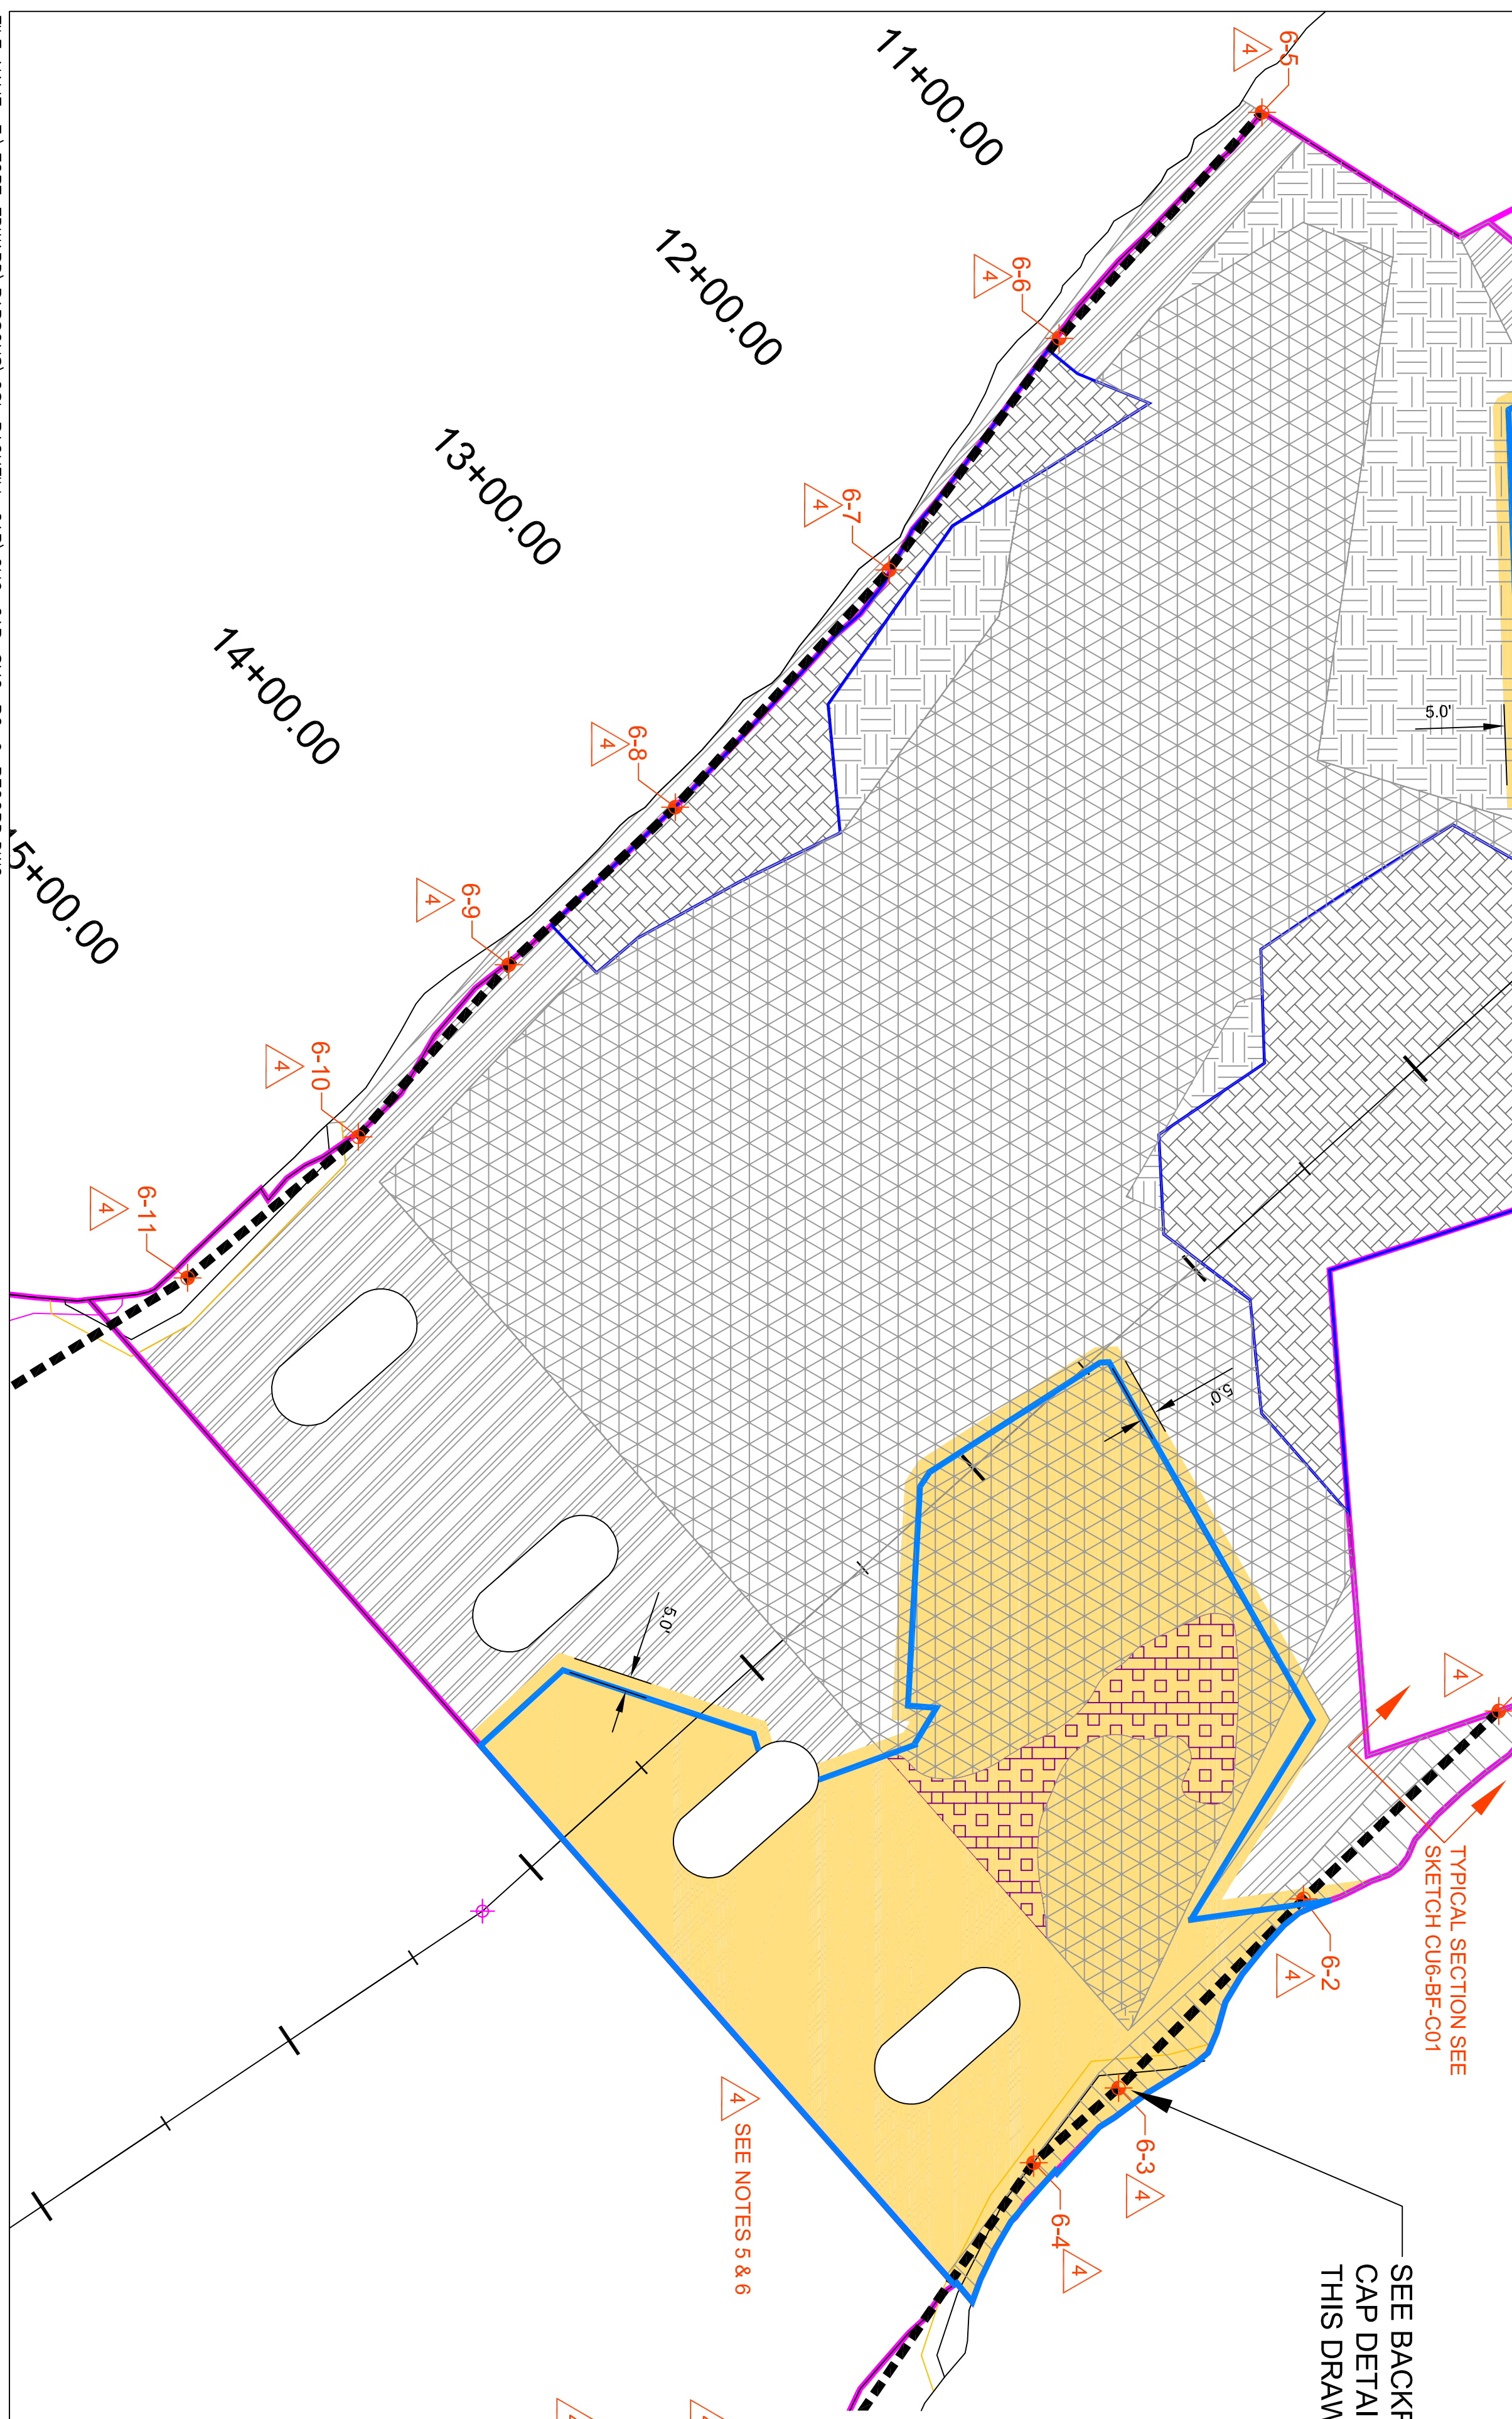


- NOTES:**
1. BACKFILL TO BE PLACED IN ACCORDANCE WITH SECTION 13720 AND DESIGN DRAWINGS B-0021 AND B-0020-SK1.
 2. CAP MATERIALS TO BE PLACED IN ACCORDANCE WITH SECTION 13720 AND DESIGN DRAWING C-0038.
 3. LIMITS OF BACKFILL WITHIN 111' CONTOUR AREA ADJUSTED FOR CONSTRUCTABILITY.
 4. FIELD CHANGES TO FINAL DESIGN SURFACE ELEVATIONS.
 5. TOTAL CAP AREA INCLUDES 5' HORIZONTAL OFFSET INTO COMPLIANT AREA, AS PER DRAWING C-0038.
 6. LIMIT OF CAP AT 5 FT. HORIZONTAL OFFSET FROM LIMIT OF NON-COMPLIANT NODE POLYGON.

**RECORD
DRAWING**

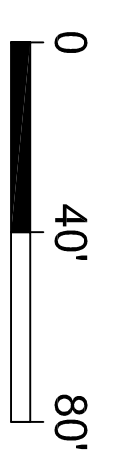


DATE	10/26/09	APPROVED BY	JHG	DRAWING NO.	CU6-BC-9REC	SCALE	AS SHOWN
DATE	10/26/09	CHECKED BY	JHG	DRAWING NO.	CU6-BC-9REC	SCALE	AS SHOWN
DATE	10/26/09	ISSUED FOR USE (FIELD CHANGE)	JHG	DRAWING NO.	CU6-BC-9REC	SCALE	AS SHOWN
DATE	10/07/09	ISSUED FOR USE (FIELD CHANGE)	JHG	DRAWING NO.	CU6-BC-9REC	SCALE	AS SHOWN
DATE	10/02/09	ISSUED FOR USE	JHG	DRAWING NO.	CU6-BC-9REC	SCALE	AS SHOWN
DATE	10/01/09	ISSUED FOR EPA REVIEW	JHG	DRAWING NO.	CU6-BC-9REC	SCALE	AS SHOWN
DATE	10/01/09	DRAWING DESCRIPTION	JHG	DRAWING NO.	CU6-BC-9REC	SCALE	AS SHOWN

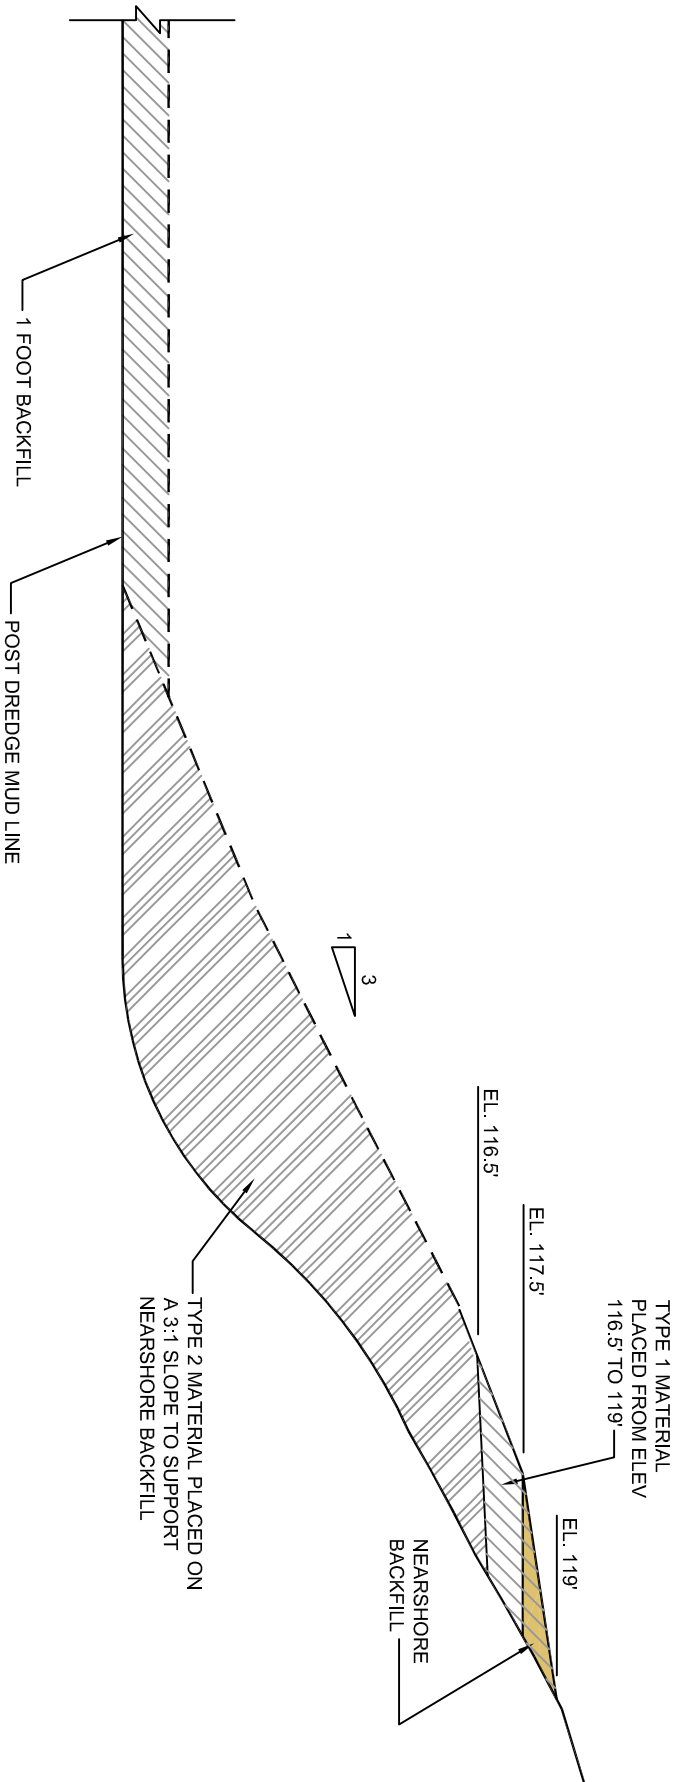

NEAR SHORE BACKFILL PLACEMENT DETAIL

TYPICAL SECTION NOT TO SCALE

COMMERCIAL TECHNOLOGY GROUP GE COMPANY - PARSONS PROJECT OFFICE BUILDING 40-1, 381 BROADWAY FORT EDWARD, N.Y. 12828 (518) 746-5311		DRAWING TITLE CU6 NEAR SHORE BACKFILL PLACEMENT DETAIL	
DRAWN BY	JHG	CHECKED BY	MG
DATE	10/25/09	APPROVED BY	MG
DRAWING NO.		SCALE	
CU6-BF-C01		NOT TO SCALE	
		JOB	
		442209	

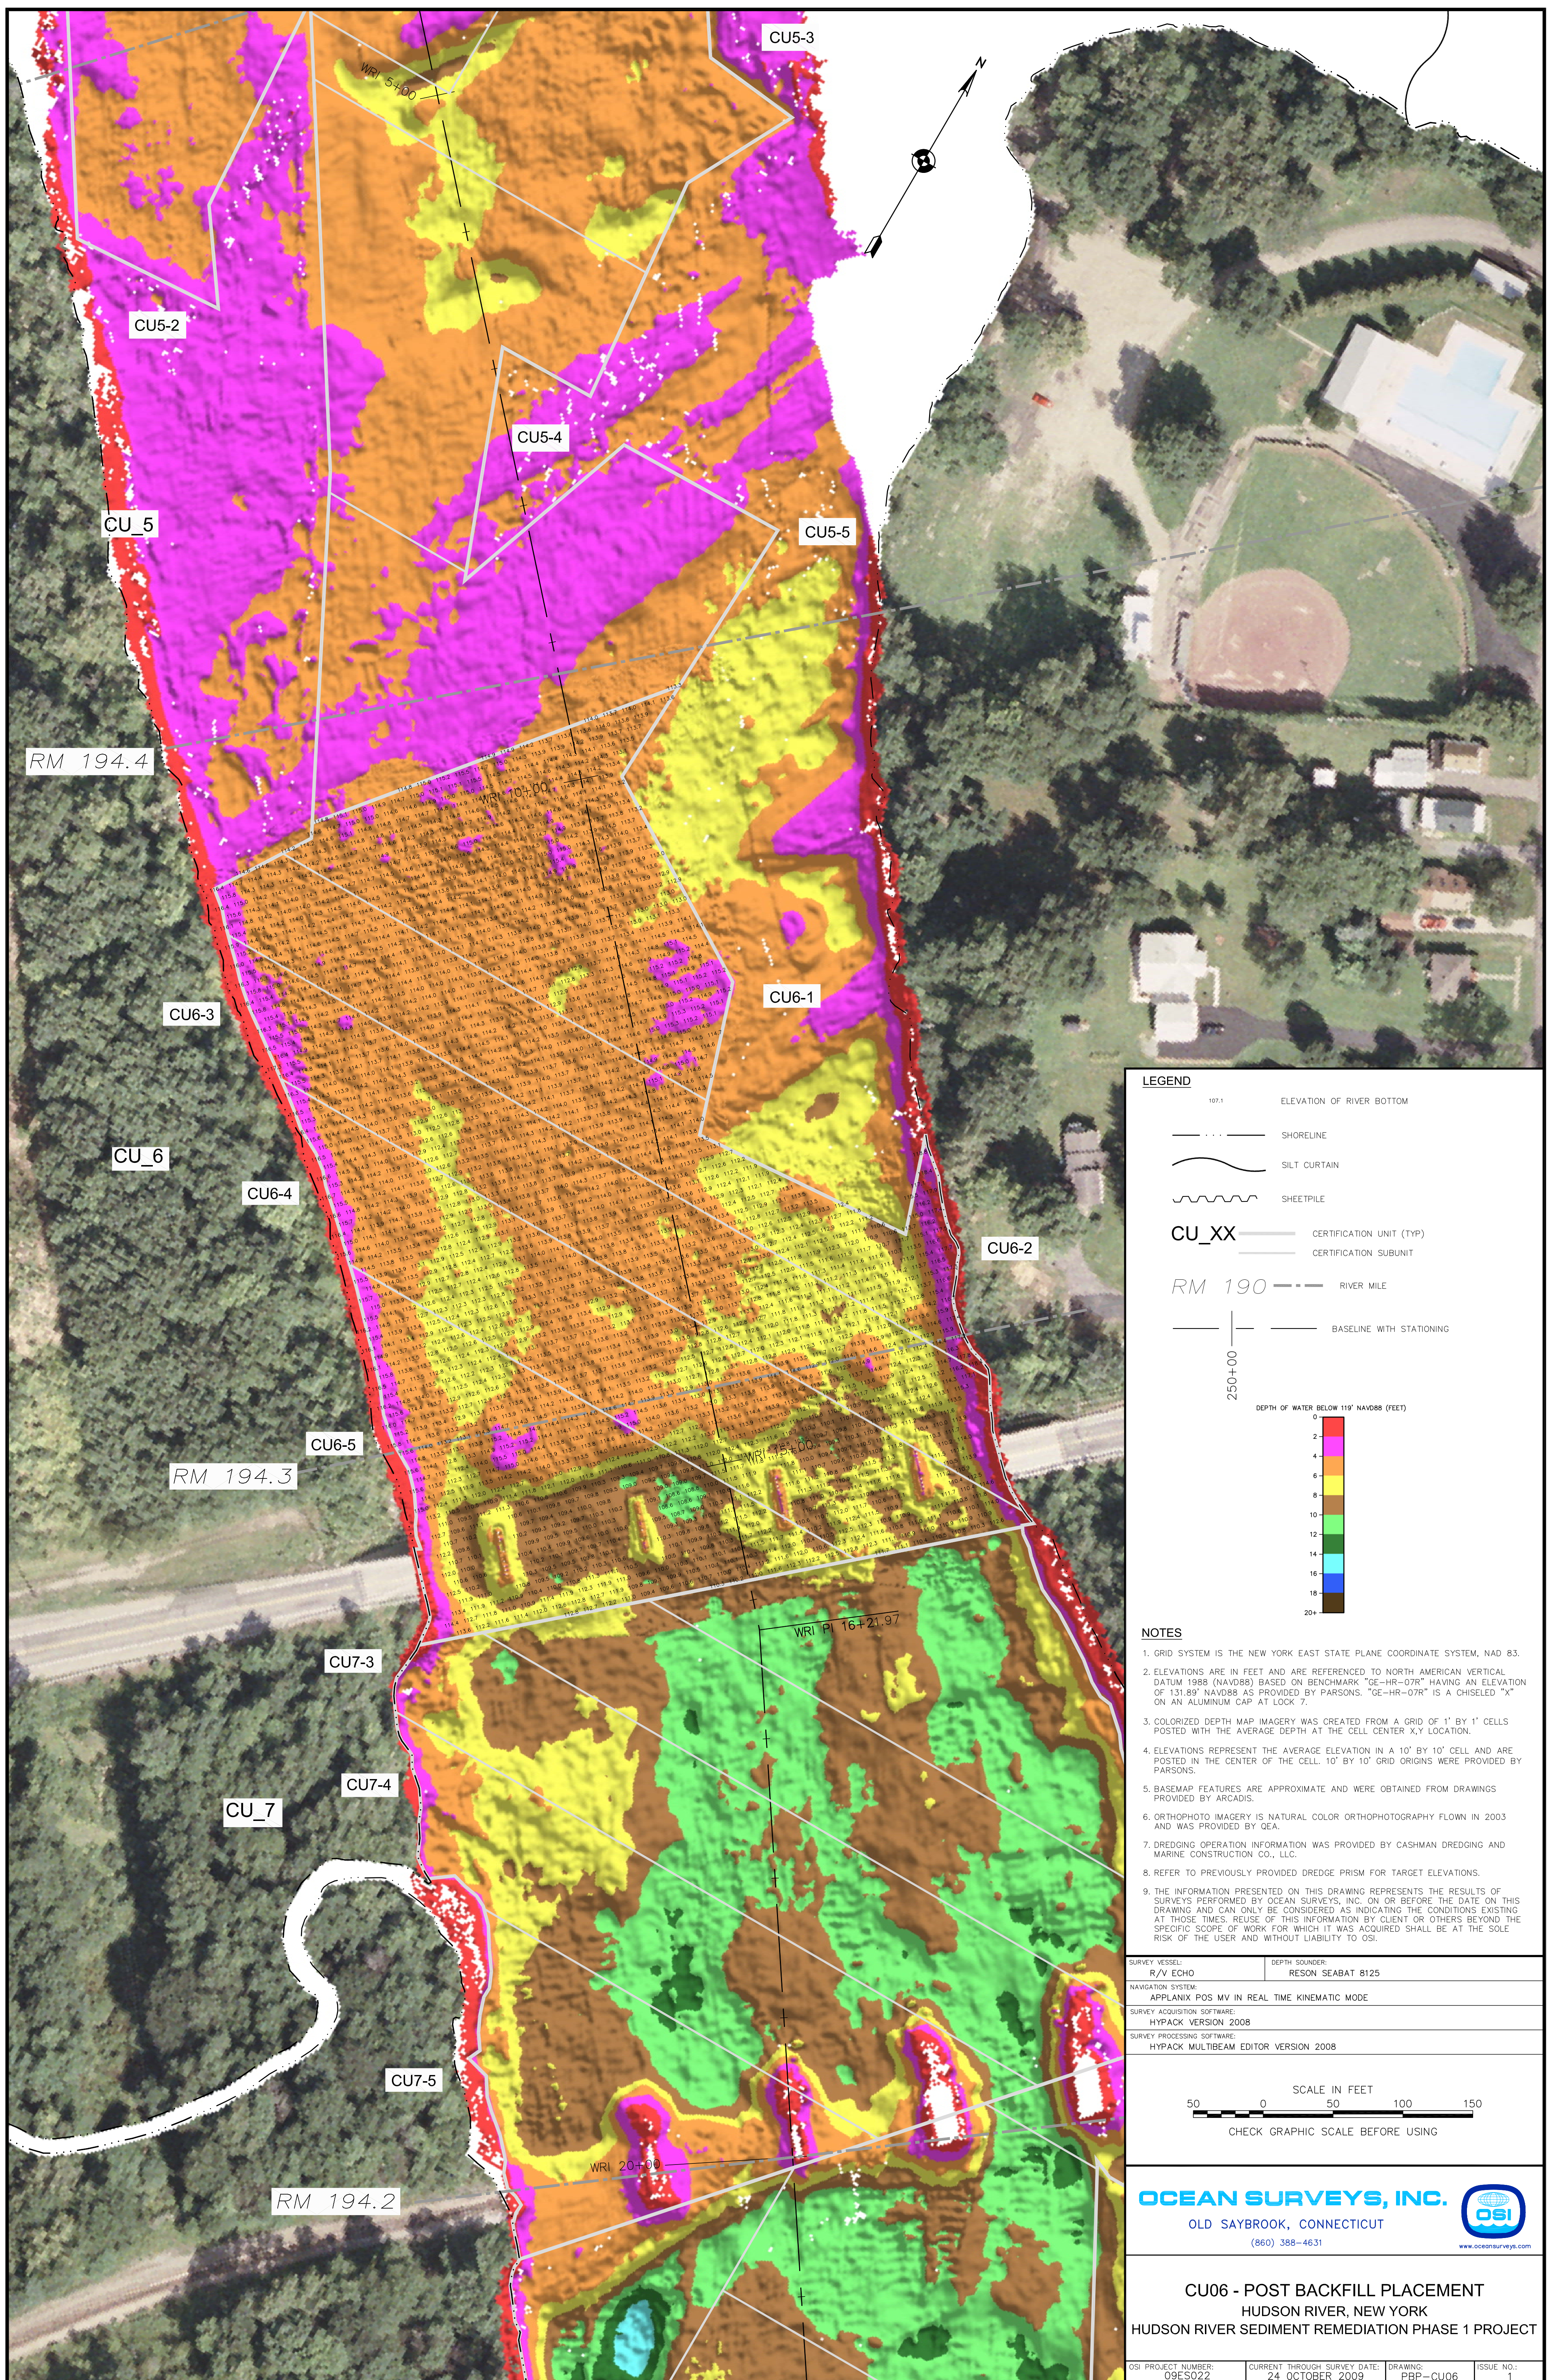

LEGEND

- 107.1 ELEVATION OF RIVER BOTTOM
- · · · — SHORELINE
- — — — SILT CURTAIN
- — — — SHEETPILE
- CU_XX — — — — CERTIFICATION UNIT (TYP)
- — — — CERTIFICATION SUBUNIT
- RM 190 — — — — RIVER MILE
- — — — BASELINE WITH STATIONING


250+00

DEPTH OF WATER BELOW 119' NAVD88 (FEET)

0
2
4
6
8
10
12
14
16
18
20+

- NOTES**
1. GRID SYSTEM IS THE NEW YORK EAST STATE PLANE COORDINATE SYSTEM, NAD 83.
 2. ELEVATIONS ARE IN FEET AND ARE REFERENCED TO NORTH AMERICAN VERTICAL DATUM 1988 (NAVD88) BASED ON BENCHMARK "GE-HR-07R" HAVING AN ELEVATION OF 131.89' NAVD88 AS PROVIDED BY PARSONS. "GE-HR-07R" IS A CHISELED "X" ON AN ALUMINUM CAP AT LOCK 7.
 3. COLORIZED DEPTH MAP IMAGERY WAS CREATED FROM A GRID OF 1' BY 1' CELLS POSTED WITH THE AVERAGE DEPTH AT THE CELL CENTER X,Y LOCATION.
 4. ELEVATIONS REPRESENT THE AVERAGE ELEVATION IN A 10' BY 10' CELL AND ARE POSTED IN THE CENTER OF THE CELL. 10' BY 10' GRID ORIGINS WERE PROVIDED BY PARSONS.
 5. BASEMAP FEATURES ARE APPROXIMATE AND WERE OBTAINED FROM DRAWINGS PROVIDED BY ARCADIS.
 6. ORTHOPHOTO IMAGERY IS NATURAL COLOR ORTHOPHOTOGRAPHY FLOWN IN 2003 AND WAS PROVIDED BY OEA.
 7. DREDGING OPERATION INFORMATION WAS PROVIDED BY CASHMAN DREDGING AND MARINE CONSTRUCTION CO., LLC.
 8. REFER TO PREVIOUSLY PROVIDED DREDGE PRISM FOR TARGET ELEVATIONS.
 9. THE INFORMATION PRESENTED ON THIS DRAWING REPRESENTS THE RESULTS OF SURVEYS PERFORMED BY OCEAN SURVEYS, INC. ON OR BEFORE THE DATE ON THIS DRAWING AND CAN ONLY BE CONSIDERED AS INDICATING THE CONDITIONS EXISTING AT THOSE TIMES. REUSE OF THIS INFORMATION BY CLIENT OR OTHERS BEYOND THE SPECIFIC SCOPE OF WORK FOR WHICH IT WAS ACQUIRED SHALL BE AT THE SOLE RISK OF THE USER AND WITHOUT LIABILITY TO OSI.

SURVEY VESSEL: R/V ECHO	DEPTH SOUNDER: RESON SEABAT 8125
NAVIGATION SYSTEM: APPLANIX POS MV IN REAL TIME KINEMATIC MODE	
SURVEY ACQUISITION SOFTWARE: HYPACK VERSION 2008	
SURVEY PROCESSING SOFTWARE: HYPACK MULTIBEAM EDITOR VERSION 2008	

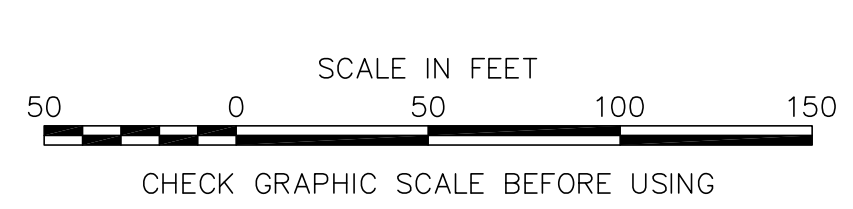

OCEAN SURVEYS, INC. 

OLD SAYBROOK, CONNECTICUT
(860) 388-4631
www.oceansurveys.com

**CU06 - POST BACKFILL PLACEMENT
HUDSON RIVER, NEW YORK
HUDSON RIVER SEDIMENT REMEDIATION PHASE 1 PROJECT**

OSI PROJECT NUMBER: 09ES022	CURRENT THROUGH SURVEY DATE: 24 OCTOBER 2009	DRAWING: BFP-CU06	ISSUE NO.: 1
--------------------------------	---	----------------------	-----------------