GOVERNMENT OF GUAM
SEWAGE COLLECTION AND DISPOSAL SYSTEM
CENTRAL SEWERAGE DISTRICT
GUAM, M.I.

NBY 64384

OFFICER IN CHARGE OF CONSTRUCTION
BUREAU OF YARDS AND DOCKS CONTRACTS MARIANAS

METCALF & EDDY
ENGINEERS
BOSTON - NEW YORK - PALO ALTO

DRAWING INDEX

SHEET NO.	Y&D NO.	DRAWING TITLE
1	1015740	GENERAL NOTES · SEWER DETAILS - 1
2	1015741	GENERAL LEGEND · SEWER DETAILS - 2
3	1015742	SEWER DETAILS - 3
		PLAN AND PROFILE
4	1015743	OUTFALL SEWER · MH 14+79 TO STA. 30+00
5	1015744	MARINE DRIVE · MH 14+79 TO STA. 8+00
6	1015745	" STA. 8+00 TO STA. 4+00
7	1015746	" STA. 4+00 TO STA. 17+00
8	1015747	" STA. 17+00 TO STA. 31+00
9	1015748	" STA. 31+00 TO STA. 45+00
10	1015749	" STA. 45+00 TO STA. 59+00
11	1015750	" STA. 59+00 TO STA. 73+00
12	1015751	" STA. 73+00 TO STA. 87+00
13	1015752	" STA. 87+00 TO STA. 99+00
14	1015753	" STA. 99+00 TO STA. 113+00
15	1015754	" STA. 113+00 TO STA. 126+00
16	1015755	" STA. 126+00 TO STA. 140+50
17	1015756	" STA. 140+50 TO STA. 154+00
18	1015757	" STA. 154+00 TO STA. 168+00
19	1015758	" STA. 168+00 TO MH 170+65
20	1015759	ROUTE 4 · MH 0+00 TO STA. 11+00
21	1015760	" STA. 11+00 TO STA. 22+00
22	1015761	" STA. 22+00 TO STA. 36+00
23	1015762	" STA. 36+00 TO STA. 50+50
24	1015763	" STA. 50+50 TO STA. 65+00
25	1015764	" STA. 65+00 TO STA. 79+00
26	1015765	" STA. 79+00 TO CHAOT RIVER P.S.
27	1015766	P.O.L. LINE · CHAOT RIVER P.S. TO STA. 14+00
28	1015767	" STA. 14+00 TO STA. 28+00
29	1015768	" STA. 28+00 TO STA. 41+00
30	1015769	EASEMENT · STA. 41+00 TO STA. 54+00
31	1015770	HAYAN GUBETNO EASEMENT · STA. 54+00 TO STA. 67+00
32	1015771	" STA. 67+00 TO STA. 85+00
33	1015772	HALUM AGANA HEIGHTS ROAD · MH 85+26 TO MH 99+11
34	1015773	P.O.L. LINE · CHAOT RIVER P.S. TO STA. 15+00
35	1015774	HAYAN AFAME · STA. 15+00 TO MH 21+04
36	1015775	CHALAN AFAME · MH 21+04 TO MH 23+95
~~N.I.C. 37~~	~~1015776~~	~~SENATOR GIBSON HIGHWAY · MH 6+25 TO STA. 12+00~~
~~N.I.C. 38~~	~~1015777~~	~~" STA. 12+00 TO MH 24+98~~
~~N.I.C. 39~~	~~1015778~~	~~ENIWETOK AVENUE · MH 19+57 TO MH 14+00~~
~~N.I.C. 40~~	~~1015779~~	~~" MH 6+20 TO MH 4+34~~
~~N.I.C. 41~~	~~1015780~~	~~KWAJALEIN AVENUE · MH 32+52 TO STA. 10+00~~
~~N.I.C. 42~~	~~1015781~~	~~" STA. 10+00 TO MH 20+85~~
~~N.I.C. 43~~	~~1015782~~	~~CHALAN ALUTUM EASEMENT · MH 53+89 TO MH 12+35~~
~~N.I.C. 44~~	~~1015783~~	~~CHALAN ALUTUM · MH 3+33 TO STA. 19+52~~
~~N.I.C. 45~~	~~1015784~~	~~CANTON TUTUJAN · MH 65+46 TO MH 9+14~~
~~N.I.C. 46~~	~~1015785~~	~~ORIYAN EASEMENT · MH 7+85 TO MH 14+24~~
~~N.I.C. 47~~	~~1015786~~	~~ORIYAN AGANA HEIGHTS · MH 77+49 TO MH 14+90~~
~~N.I.C. 48~~	~~1015787~~	~~HAYAN GUBETNO · MH 77+49 TO MH 13+99~~
~~N.I.C. 49~~	~~1015788~~	~~HALUM AGANA HEIGHTS · MH 85+26 TO MH 12+50~~
~~N.I.C. 50~~	~~1015789~~	~~CANTON TUTUJAN · APUGAN P.S. TO STA. 10+50~~
~~N.I.C. 51~~	~~1015790~~	~~NAVAL HOSPITAL · STITT ROAD · STA. 19+50 TO EXIST. MH~~
~~N.I.C. 52~~	~~1015791~~	~~APUGAN DRIVE · MH 3+16 TO MH 15+30~~
53	1015792	CAMP WATKINS ROAD · MH 99+58 TO STA. 9+00
54	1015793	" STA. 9+00 TO STA. 20+00
55	1015794	" STA. 20+00 TO STA. 34+00
56	1015795	" STA. 34+00 TO STA. 48+00
57	1015796	DECATUR STREET · STA. 48+00 TO STA. 61+00
58	1015797	FR. PALOMA ST. - ADMIRAL LITCH ST. · STA. 61+00 TO STA. 75+00
59	1015798	ADMIRAL LITCH ST. · STA. 75+00 TO STA. 86+00
60	1015799	FR. ROMAN STREET - FR. DUENAS DRIVE · STA. 86+00 TO EXIST. MH
61	1015300	TAMUNING BAYSIDE · MH 0+80 TO STA. 11+00
62	1015801	" STA. 11+00 TO STA. 21+00
63	1015802	" STA. 21+00 TO STA. 24+30
64	1015803	" TAMUNING BAYSIDE P.S. TO STA. 13+00
65	1015804	" STA. 13+00 TO STA. 22+00
66	1015805	DEL ROSARIO LANE · STA. 22+00 TO STA. 31+00
67	1015806	" STA. 31+00 TO MH 43+46
68	1015807	THEATER LANE · MH 22+30 TO MH 7+79
69	1015808	FARENHOLT AVENUE · MH 48+12 TO MH 11+60
70	1015809	CENTER DRIVE · MH 53+66 TO MH 12+98
71	1015810	FR. SAN VITORES ST. · MH 75+13 TO MH 12+57
72	1015811	FARENHOLT AVENUE · MH 48+12 TO STA. 11+00
73	1015812	" STA. 11+00 TO STA. 23+00
74	1015813	HOSPITAL ROAD · STA. 23+00 TO STA. 34+00
75	1015814	HOSPITAL RD. - "D" LANE · STA. 34+00 TO STA. 46+00
76	1015815	"E" LANE - OLIVE LANE · STA. 46+00 TO STA. 58+00
77	1015816	"E" LANE - IPAO ROAD · STA. 58+00 TO IPAO ROAD P.S.
78	1015817	LETICIA ROAD · SONN STREET TO OLIVE LANE
79	1015818	ESTRELLITA RD - SONN ST. · MH 4+35 TO MH 7+00
80	1015819	IPAO ROAD · MH 5+87 TO MH 6+00
81	1015820	SOUTH GOLD COAST LANE · MH 6+00 TO MH 18+12
82	1015821	NORTH GOLD COAST LANE · MH 3+57 TO MH 12+86
83	1015822	"G" LANE · MH 40+21 TO MH 6+39
84	1015823	HOSPITAL ROAD · MH 125+12 TO STA. 12+50
85	1015824	" STA. 12+50 TO MH 21+32
86	1015825	"L" LANE - EYE LANE · MH 5+86 TO MH 10+91
~~N.I.C. 87~~	~~1015826~~	~~DEDEDO TRUNK SEWER · EXIST. MH TO STA. 13+00~~
~~N.I.C. 88~~	~~1015827~~	~~" STA. 13+00 TO STA. 24+00~~
~~N.I.C. 89~~	~~1015828~~	~~" STA. 24+00 TO MH 31+71~~
		PUMPING STATIONS - ARCHITECTURAL
90	1015829	AGANA MAIN PUMPING STATION - PLOT & VICINITY PLANS
91	1015830	" FIRST FLOOR & ROOF PLANS
92	1015831	" PLANS & SECTIONS
93	1015832	" ELEVATIONS
94	1015833	" SECTIONS
95	1015834	CHAOT RIVER PUMPING STATION - PLOT & VICINITY PLANS
96	1015835	" PLANS, SECTIONS & DETAILS
97	1015836	" ELEVATIONS
~~N.I.C. 98~~	~~1015837~~	~~APUGAN PUMPING STATION · PLOT, VICINITY & ACCESS RD. PLANS~~
~~N.I.C. 99~~	~~1015838~~	~~" " PLANS & SECTIONS~~
~~N.I.C. 100~~	~~1015839~~	~~" " ELEVATIONS & DETAILS~~
101	1015840	TAMUNING EJECTOR STATIONS — VICINITY, PLOT & FLOOR PLANS & ELEV.
102	1015841	" PLOT & ACCESS RD. PLANS & SECTIONS
		PUMPING STATIONS - STRUCTURAL
103	1015842	TYPICAL DETAILS, DESIGN DATA & GENERAL NOTES
104	1015843	AGANA MAIN PUMPING STATION - ROOF & FIRST FLOOR PLANS
105	1015844	" FDN. & INTERMEDIATE PLANS & SECTS.
106	1015845	" BEAM SCHEDULE, SECTIONS & DETAILS
107	1015846	CHAOT RIVER PUMPING STATION - FLOOR PLANS & SECTIONS
108	1015847	" BEAM SCHEDULE, SECTIONS & DETAILS
~~N.I.C. 109~~	~~1015848~~	~~APUGAN PUMPING STATION · PLANS, SECTIONS, SCHEDULE & DETAILS~~
110	1015849	TAMUNING EJECTOR STATIONS - PLANS, SECTIONS, SCHEDULE & DETAILS
		PUMPING STATIONS - MECHANICAL
111	1015850	AGANA MAIN PUMPING STATION - PLANS & SECTIONS
112	1015851	CHAOT RIVER PUMPING STATION - PLANS & SECTIONS
		PUMPING STATIONS - MECHANICAL & ELECTRICAL
~~N.I.C. 113~~	~~1015852~~	~~APUGAN PUMPING STATION · PLANS, SECTIONS & DETAILS~~
114	1015853	TAMUNING EJECTOR STATIONS - PLANS, SECTIONS & DETAILS
		PUMPING STATIONS - MECHANICAL
115	1015854	MISCELLANEOUS DETAILS
		PUMPING STATIONS - ELECTRICAL
116	1015855	AGANA MAIN PUMPING STATION - PLANS, SECTIONS & DETAILS
117	1015856	CHAOT RIVER PUMPING STATION - PLANS & DETAILS
		MISCELLANEOUS
118	1015857	STANDARD SECURITY FENCE

N.I.C. - NOT IN CONTRACT

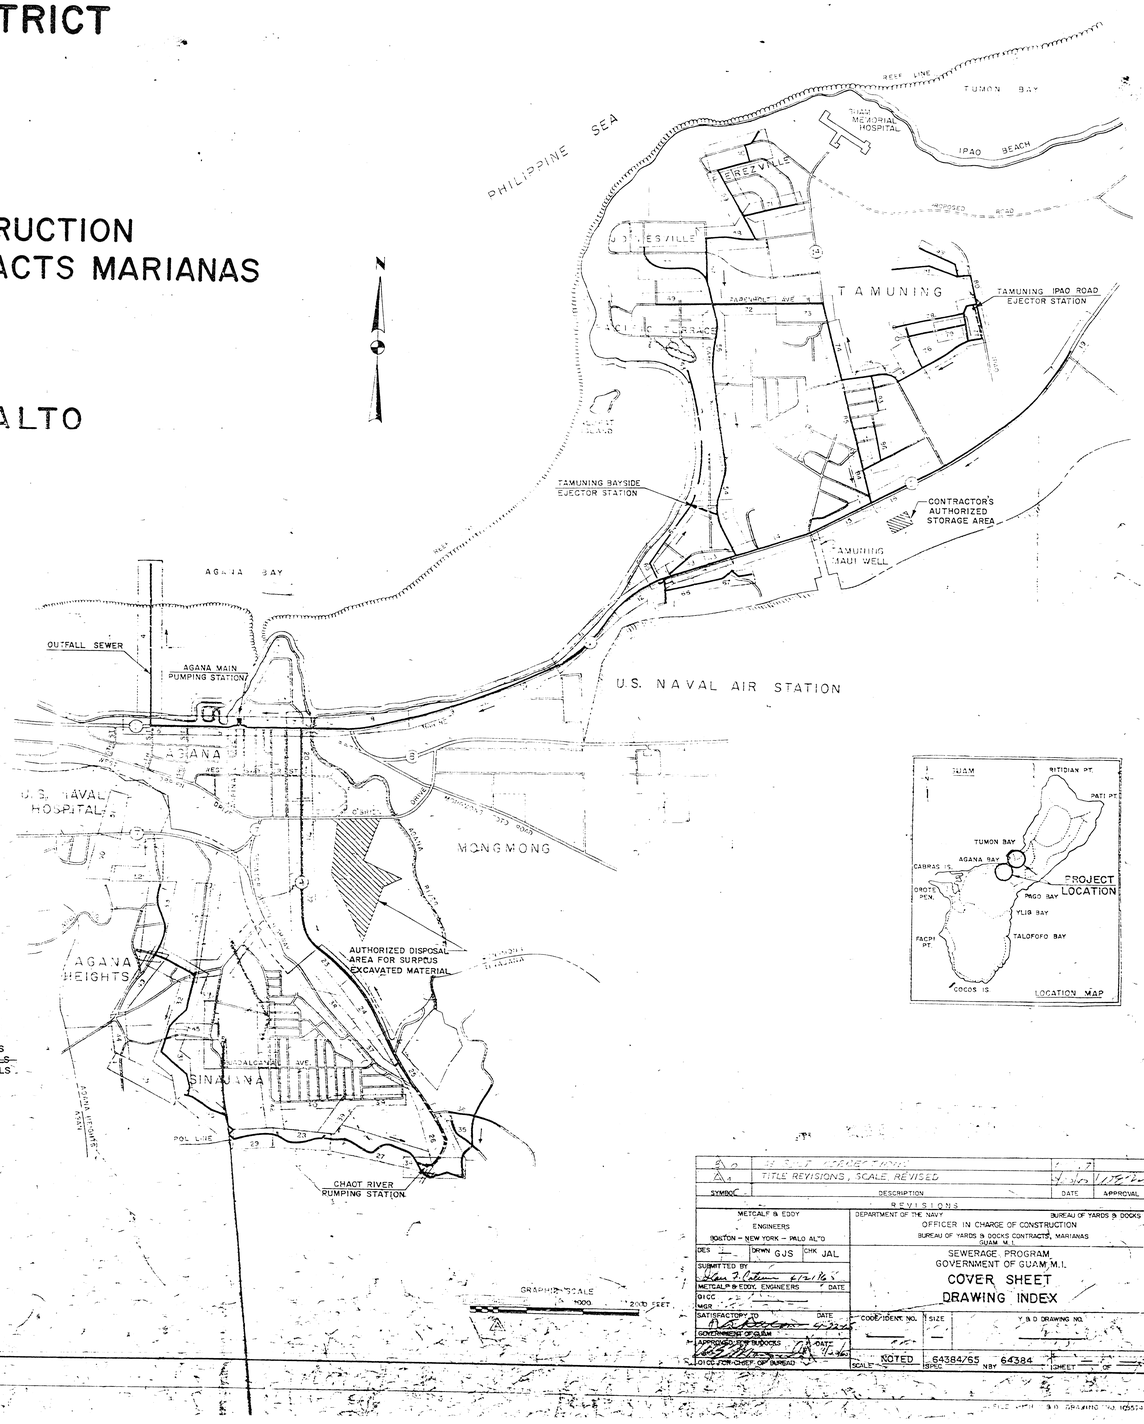

SYMBOL	DESCRIPTION	DATE	APPROVAL
3	[illegible]		
2	[illegible]		
1	TITLE REVISIONS, SCALE, REVISED	1/3/62	[illegible]

REVISIONS

METCALF & EDDY ENGINEERS
BOSTON - NEW YORK - PALO ALTO

DEPARTMENT OF THE NAVY
BUREAU OF YARDS & DOCKS
OFFICER IN CHARGE OF CONSTRUCTION
BUREAU OF YARDS & DOCKS CONTRACTS, MARIANAS
GUAM, M.I.

DES — DRWN GJS CHK JAL

SUBMITTED BY [illegible]
METCALF & EDDY, ENGINEERS — DATE
OIC — MGR
SATISFACTORY TO — DATE
GOVERNMENT OF GUAM
APPROVED FOR BUREAU OF YARDS & DOCKS — DATE
OIC CDR CHIEF OF BUREAU

SEWERAGE PROGRAM
GOVERNMENT OF GUAM, M.I.

COVER SHEET
DRAWING INDEX

CODE IDENT. NO. — SIZE — Y & D DRAWING NO.

SCALE NOTED — SPEC 64384/65 — NBY 64384 — SHEET — OF