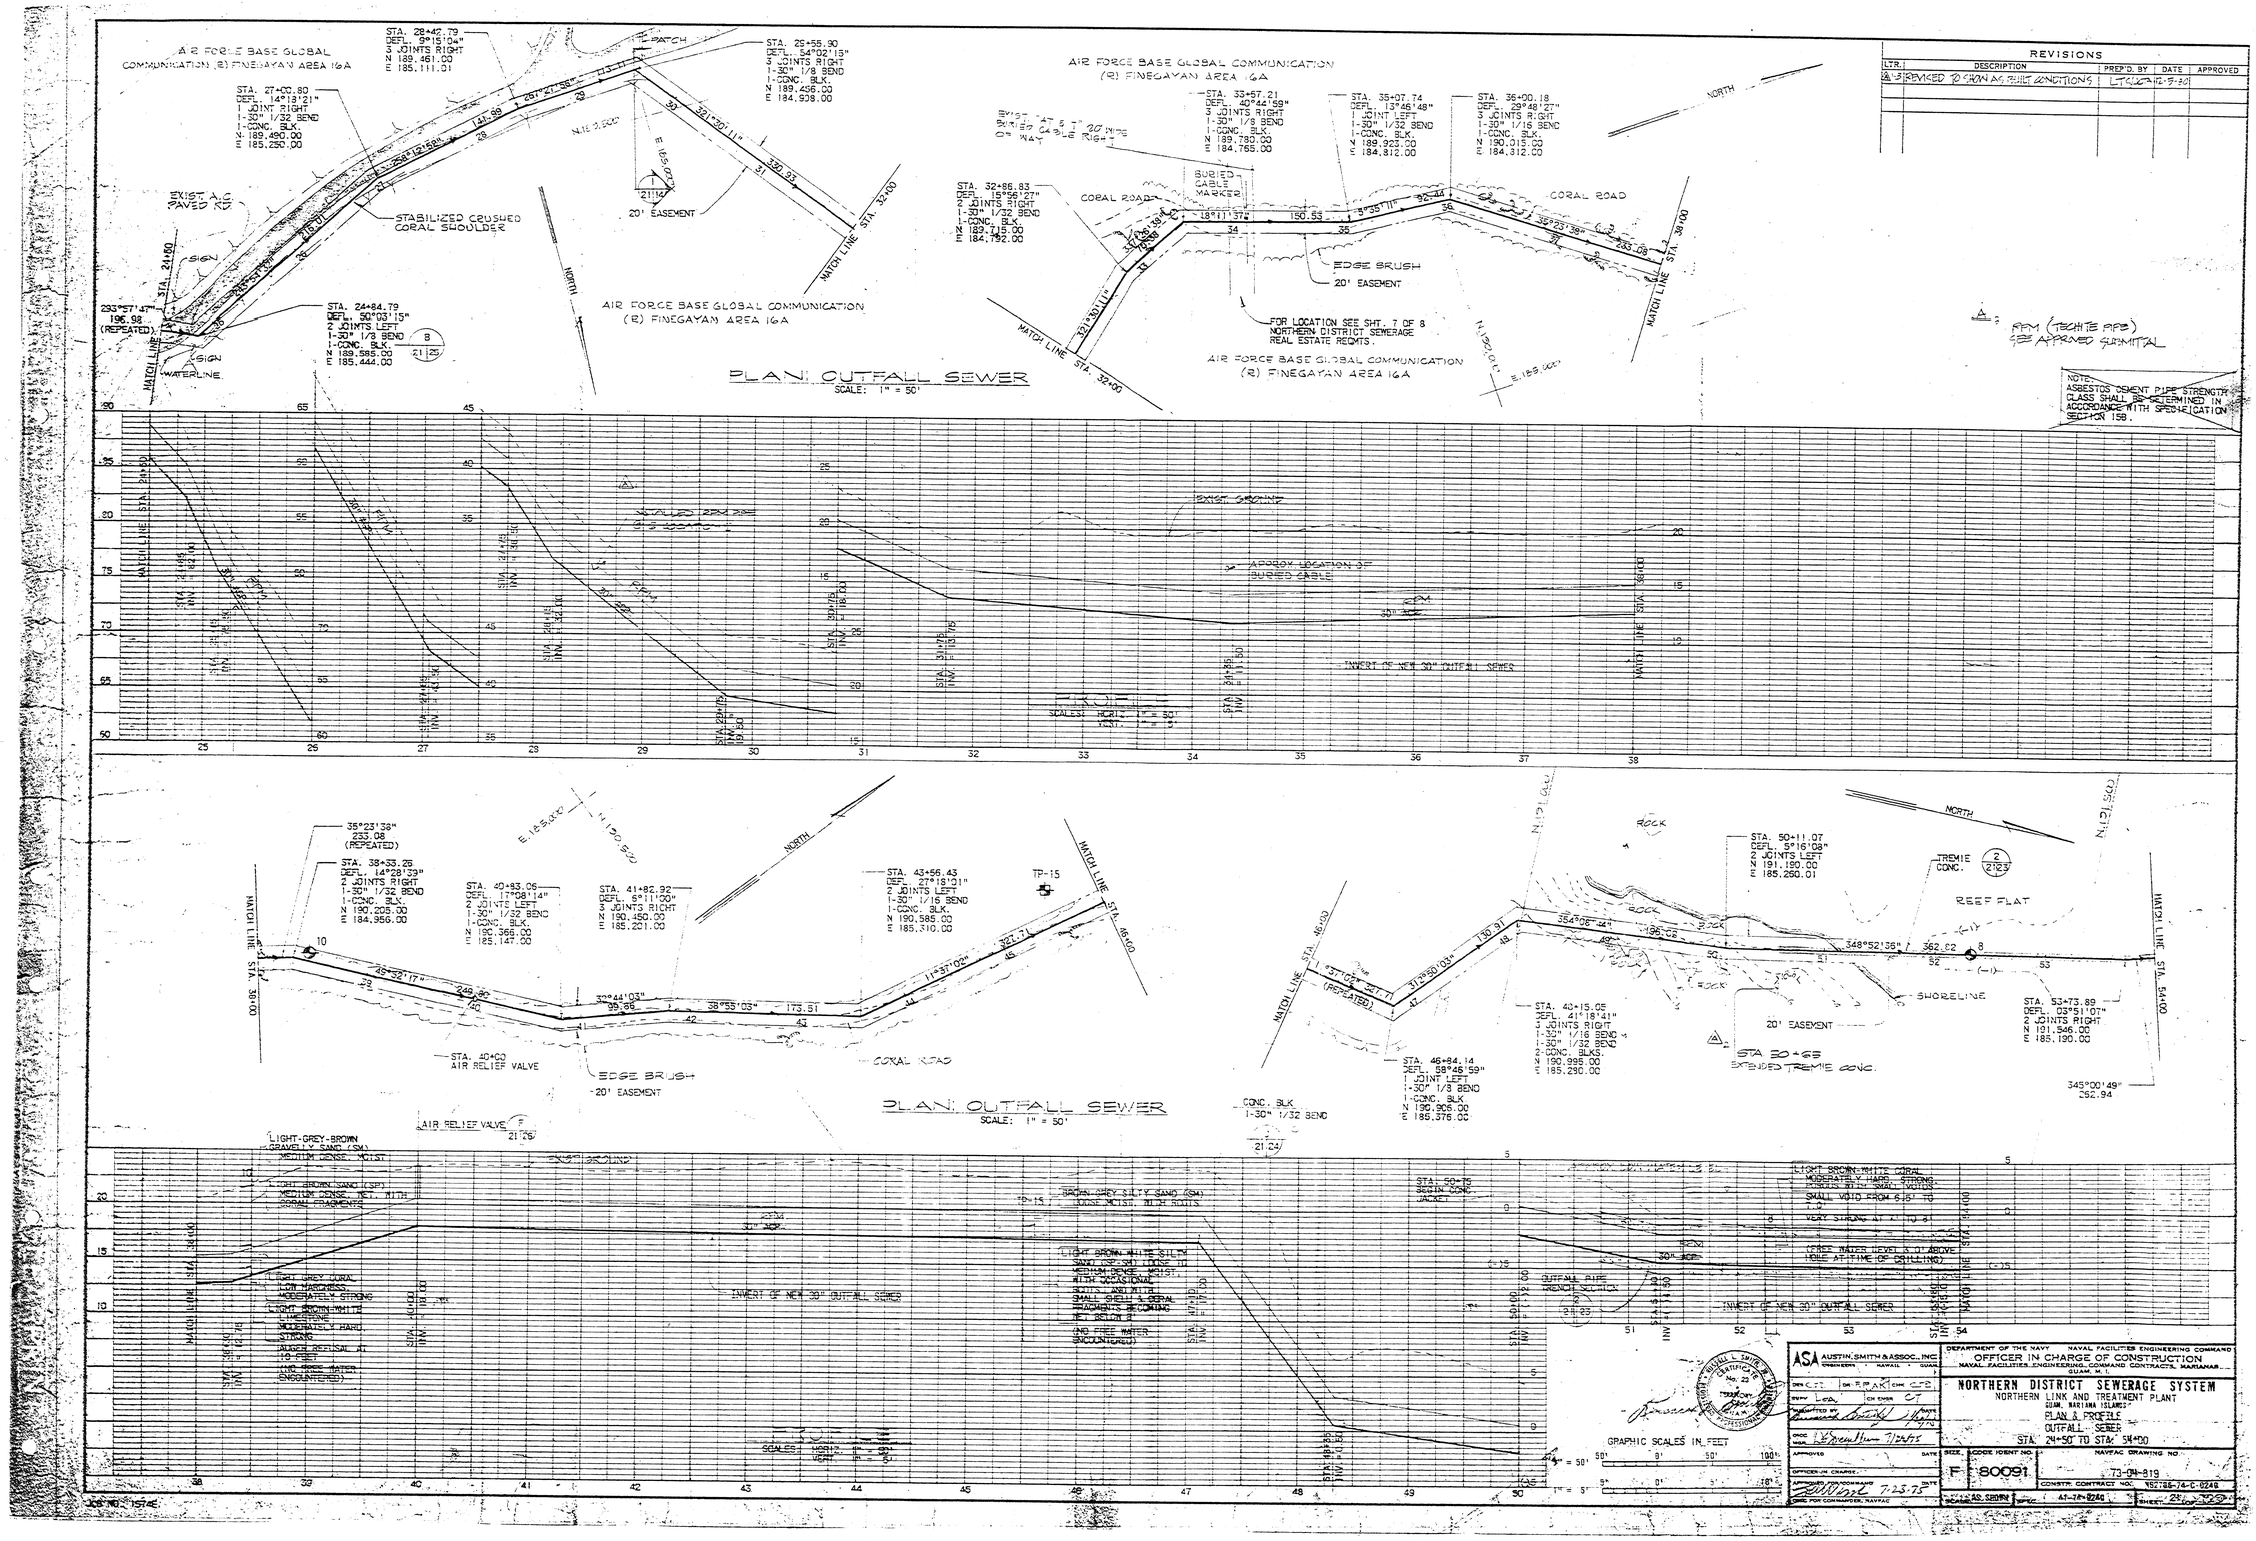

REVISIONS				
LTR.	DESCRIPTION	PREP'D. BY	DATE	APPROVED
A-3	REVISED TO SHOW AS BUILT CONDITIONS	LT	12-5-80	

ASA AUSTIN, SMITH & ASSOC., INC. ENGINEERS · HAWAII · GUAM

DEPARTMENT OF THE NAVY NAVAL FACILITIES ENGINEERING COMMAND
OFFICER IN CHARGE OF CONSTRUCTION
NAVAL FACILITIES ENGINEERING COMMAND CONTRACTS, MARIANAS
GUAM, M.I.

NORTHERN DISTRICT SEWERAGE SYSTEM

NORTHERN LINK AND TREATMENT PLANT
GUAM, MARIANA ISLANDS

PLAN & PROFILE
OUTFALL SEWER
STA. 24+50 TO STA. 54+00

DRN. L.T. CH. R.P.M. CHK. A.K.T. CHK. C.F.B.
DSGN. J. STAL CH. CHEM. C.T.
SUBMITTED BY: Francis Brady 7/24/75
CHGD. W.A. L.T. Greenlum 7/24/75
APPROVED: DATE
OFFICER-IN-CHARGE
APPROVED FOR COMMANDER: 7-23-75 DATE
FOR COMMANDER, NAVFAC

SIZE: F CODE IDENT NO. 80091
NAVFAC DRAWING NO. 73-04-819
CONSTR. CONTRACT NO. N62786-74-C-0248
SCALE: AS SHOWN SPEC. 41-128-0248 SHEET 24 OF 54

JOB NO. 1574E