REVISIONS				
LTR.	DESCRIPTION	PREP'D. BY	DATE	APPROVED
A	REVISED TO SHOW AS-BUILT CONDITIONS	[illegible]	12-5-80	

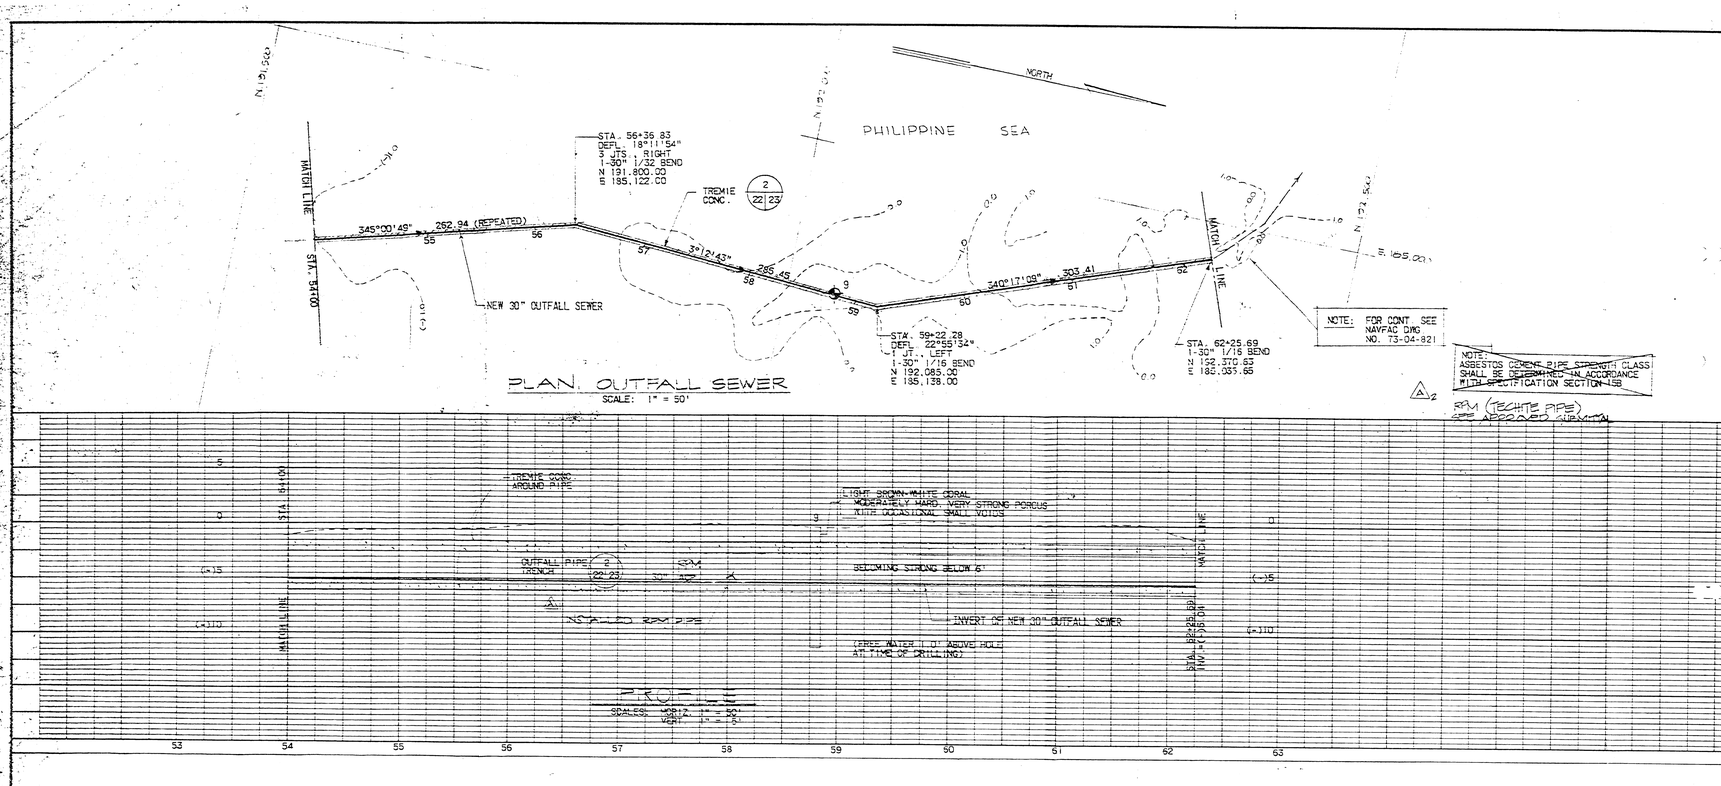

PLAN, OUTFALL SEWER

SCALE: 1" = 50'

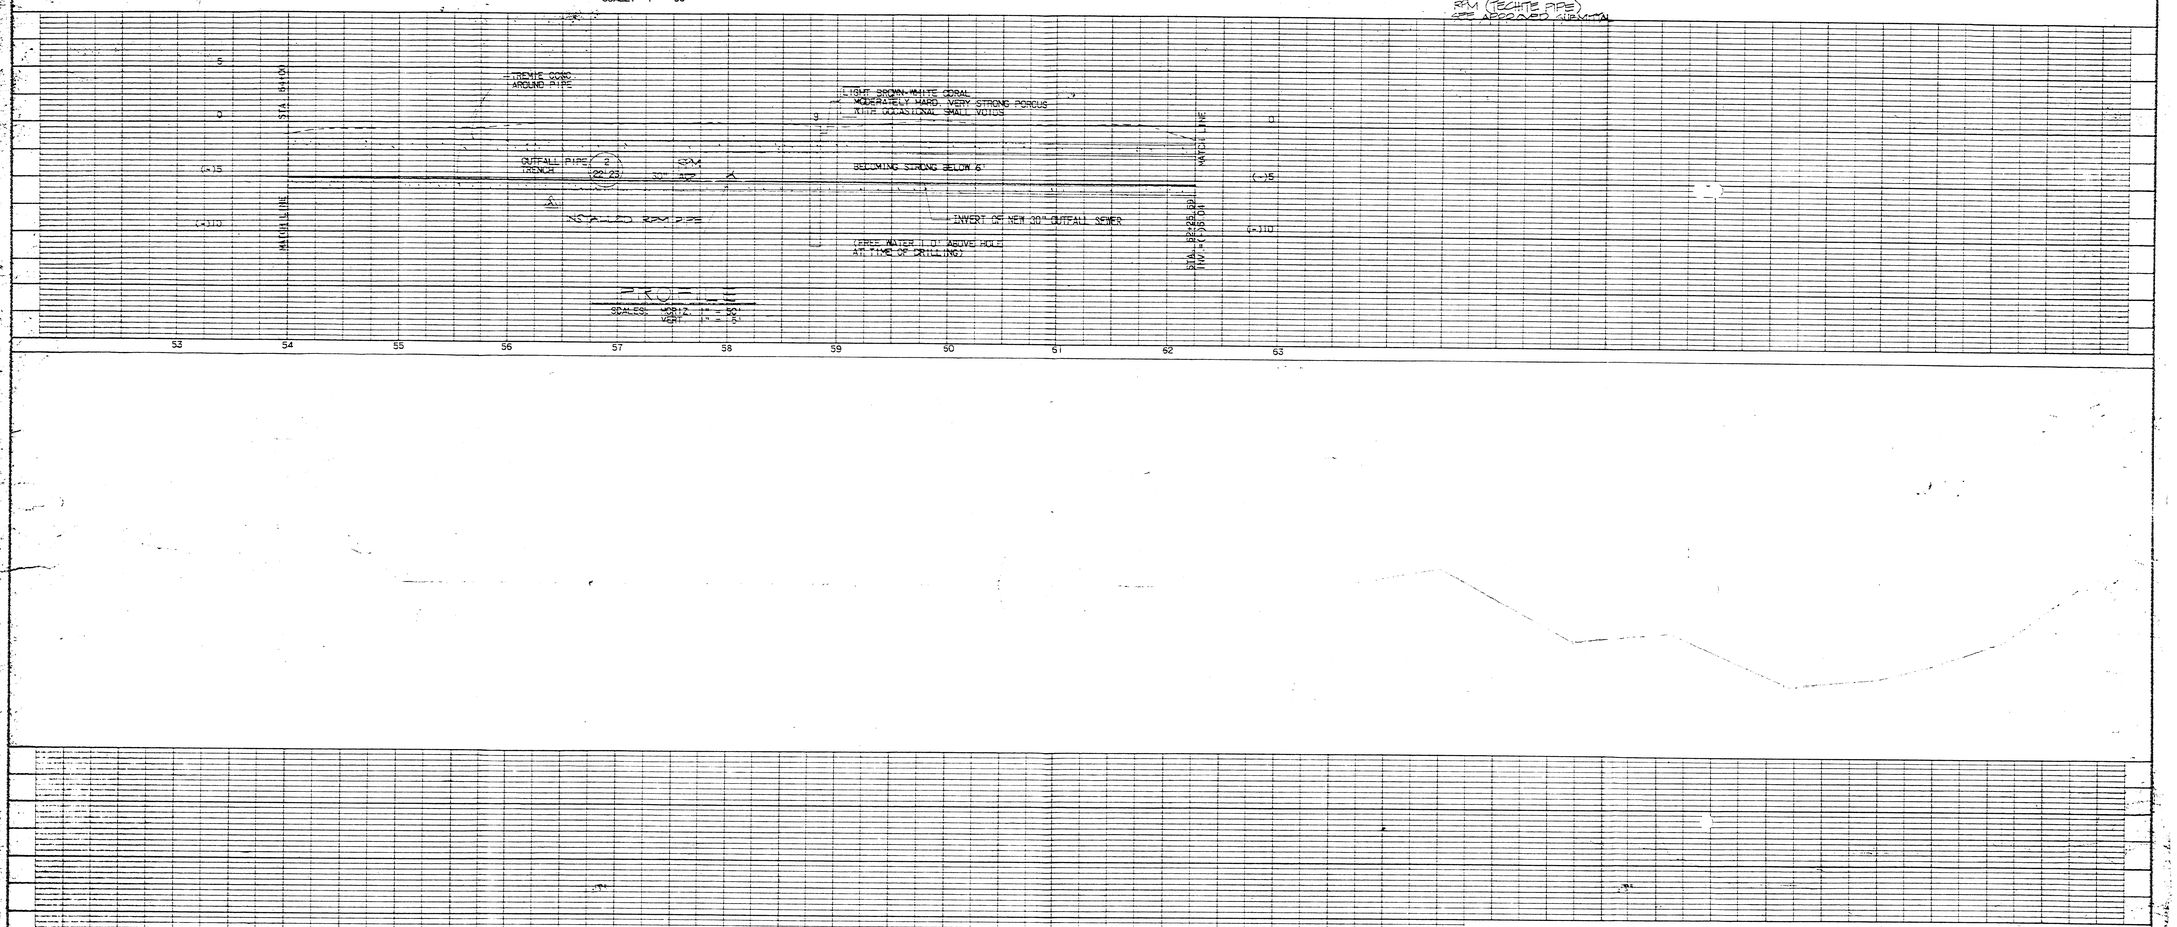

PROFILE

SCALES: HORIZ. 1" = 50'
VERT. 1" = 5'

GRAPHIC SCALES IN FEET

1" = 50' 50' 0' 50' 100'

1" = 5' 5' 0' 5' 10'

RUSSELL L. SMITH CERTIFICATE NO. 22 TERRITORY OF GUAM PROFESSIONAL ENGINEER

ASA AUSTIN, SMITH & ASSOC., INC. ENGINEERS • HAWAII • GUAM

DR'N GS CH'KED CF

SUPV. JA

SUBMITTED BY [illegible] 7/24/75

DESIGN MGR. [illegible] 7/24/75

APPROVED DATE

OFFICER IN CHARGE

APPROVED FOR COMMANDER DATE 7-23-75

OIC FOR COMMANDER, NAVFAC

DEPARTMENT OF THE NAVY NAVAL FACILITIES ENGINEERING COMMAND
OFFICER IN CHARGE OF CONSTRUCTION
NAVAL FACILITIES ENGINEERING COMMAND CONTRACTS MARIANAS
GUAM, M.I.

NORTHERN DISTRICT SEWERAGE SYSTEM
NORTHERN LINK AND TREATMENT PLANT
GUAM, MARIANA ISLANDS
PLAN & PROFILE
OUTFALL SEWER
STA. 54+00.TO STA. 62+25.69

SIZE F | CODE IDENT NO 80091 | NAVFAC DRAWING NO. 73-04-820

CONSTR. CONTRACT NO. N62709-74-C-0240

SCALE AS SHOWN | SPEC. 41-74-0240 | SHEET 22 OF 125