NORTHERN DISTRICT SEWERAGE SYSTEM
EFFLUENT FORCE MAIN REPLACEMENT

PROJECT NO. S97 - 001 - LOC

GUAM WATERWORKS AUTHORITY
GOVERNMENT OF GUAM

LOCATION MAP

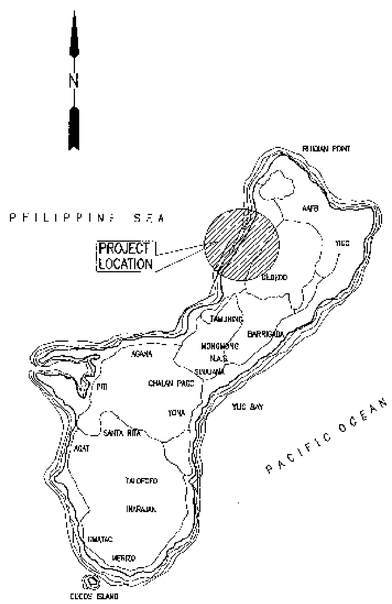

VICINITY MAP

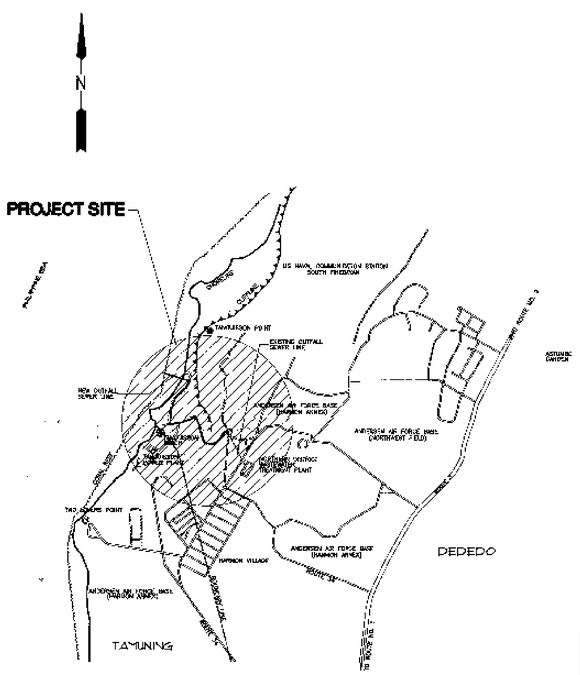

INDEX OF DRAWINGS

DRAWING NO.	DESCRIPTION	SHEET NO.
TS - 1	TITLE SHEET, LOCATION MAP, VICINITY MAP AND INDEX OF DRAWINGS	1 OF 11
LS 1	GENERAL NOTES, ABBREVIATIONS & SYMBOLS	2 OF 11
MP - 1	KEY MAP	3 OF 11
C - 1	TREATMENT PLANT SITE AS-BUILT & EFFLUENT LINE LAYOUT PLAN	4 OF 11
C - 2	PLAN AND PROFILE	5 OF 11
C - 3	PLAN AND PROFILE	6 OF 11
C - 4	PLAN AND PROFILE	7 OF 11
C - 5	PLAN AND PROFILE	8 OF 11
C - 6	BORING LOGS	9 OF 11
D - 1	DETAILS	10 OF 11
D - 2	DETAILS	11 OF 11

SUMITOMO CONSTRUCTION CO. LTD
AS-BUILT DRAWING
This certifies that the dimensions and details shown on this sheet reflect the dimensions and details as constructed in the field
Signature Date

I HEREBY CERTIFY THAT THIS PLAN WAS PREPARED BY ME OR UNDER MY DIRECT SUPERVISION

THOMAS A. CARBONELL
CERTIFIED PROFESSIONAL ENGINEER
No. 9831
GUAM

APPROVALS

RICHARD A. QUINTANILLA
GENERAL MANAGER
GUAM WATERWORKS AUTHORITY
DATE

JESUS T. SALAS
ADMINISTRATOR
GUAM ENVIRONMENTAL PROTECTION AGENCY
1/20/98
DATE

ANTHONY T. QUINATA, P.E.
DIRECTOR
DEPARTMENT OF PUBLIC WORKS
1/27/98
DATE

REV.	DATE	BY	DESCRIPTION	APPROVED

PACIFIC ISLAND ENGINEERS
ENGINEERS • PLANNERS • C.E.M.
CONSULTANTS
P.O. BOX 6085 TAMUNING, GUAM 96931
TEL NO. 646-7431/2 FAX NO. 646-1982

GOVERNMENT OF GUAM
GUAM WATERWORKS AUTHORITY

NORTHERN DISTRICT SEWERAGE SYSTEM
EFFLUENT FORCE MAIN REPLACEMENT

TITLE SHEET, LOCATION MAP, VICINITY MAP & INDEX OF DRAWINGS

DES. PIE | DRN. CEC | CHK. JAC/FEY
SUPV. JAC | DATE APRIL 97
SUBMITTED BY:

VIRGILIO NICOLAS
PROJECT ENGINEER

RENATO AIZ-AZAREN
PROJECT MANAGER

RECOMMENDED BY: DATE
QUIRINO H. BARRAS, P.E.
CHIEF ENGINEER

JOB ORDER NO.

DRAWING NO. TS - 1

SCALE: | PWAG DWG. NO.:

SHT. 1 OF 11