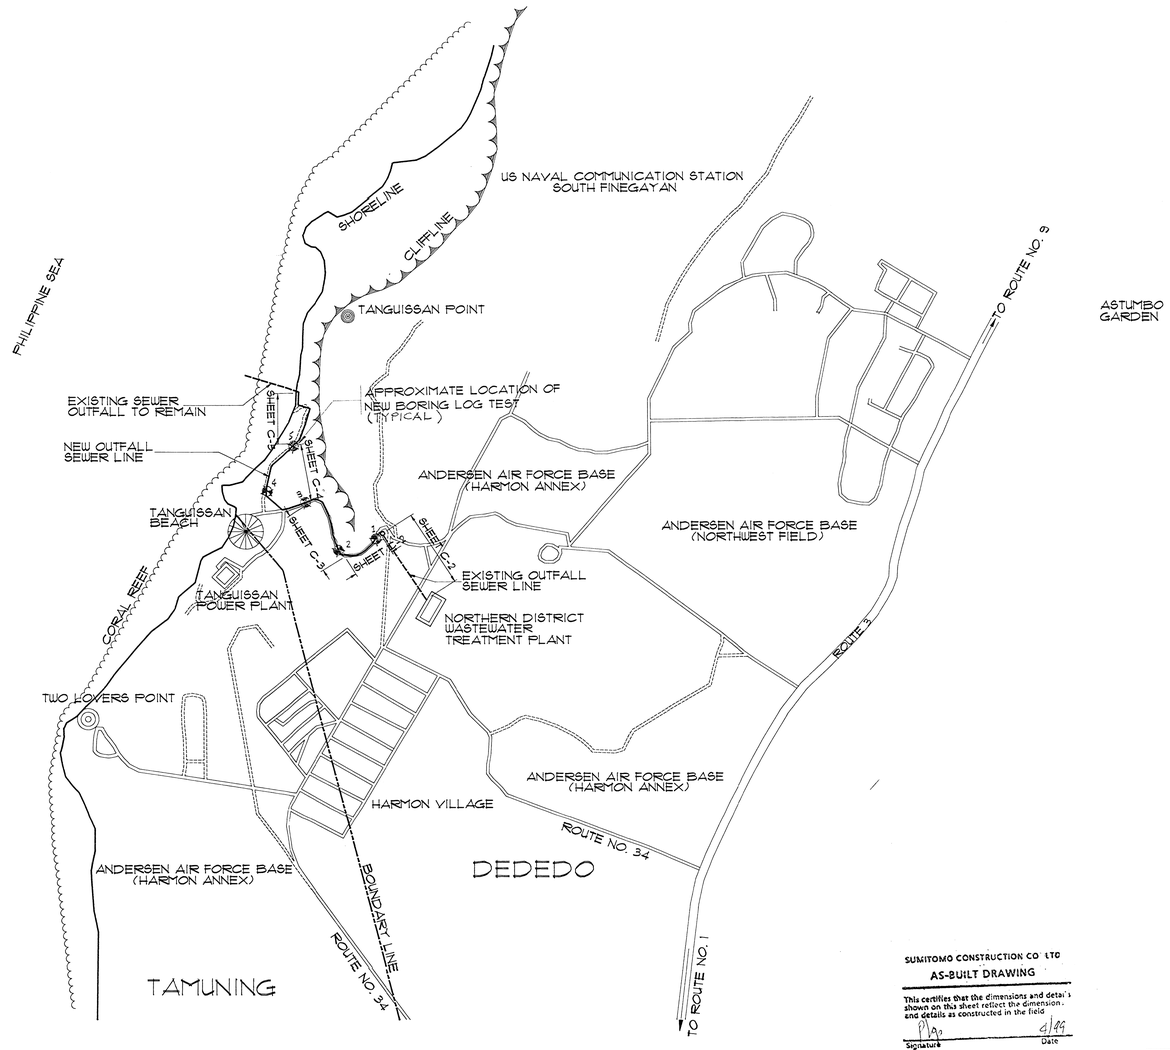

SUMITOMO CONSTRUCTION CO. LTD
AS-BUILT DRAWING
This certifies that the dimensions and details shown on this sheet reflect the dimension and details as constructed in the field
Signature Date 4/99

1 MP KEY MAP

0 1/2 MILE 1 MILE

I HEREBY CERTIFY THAT THIS PLAN WAS PREPARED BY ME OR UNDER MY DIRECT SUPERVISION

REV.	DATE	BY	DESCRIPTION	APPROVED

PACIFIC ISLAND ENGINEERS
ENGINEERS • PLANNERS • C.M. CONSULTANTS
P.O. BOX 6085 TAMUNING, GUAM 96931
TEL. NO. 646-7431/2 FAX NO. 646-1982

GOVERNMENT OF GUAM
GUAM WATERWORKS AUTHORITY

DES. PIE DRN. CEC CHK. JAC/FEY
SUPV. JAC DATE APRIL 97
SUBMITTED BY:

NORTHERN DISTRICT SEWERAGE SYSTEM
EFFLUENT FORCE MAIN REPLACEMENT

KEY MAP

VIRGILIO NICOLAS
PROJECT ENGINEER

RENATO ALCAZAREN
PROJECT MANAGER

RECOMMENDED BY: DATE
QUIRINO H. BASBAS, P.E.
CHIEF ENGINEER

JOB ORDER NO.
DRAWING NO. MP - 1
SCALE: FUAG DWG. NO.
SHT. 3 OF 11