REVISIONS				
LTR.	DESCRIPTION	PREP'D. BY	DATE	APPROVED

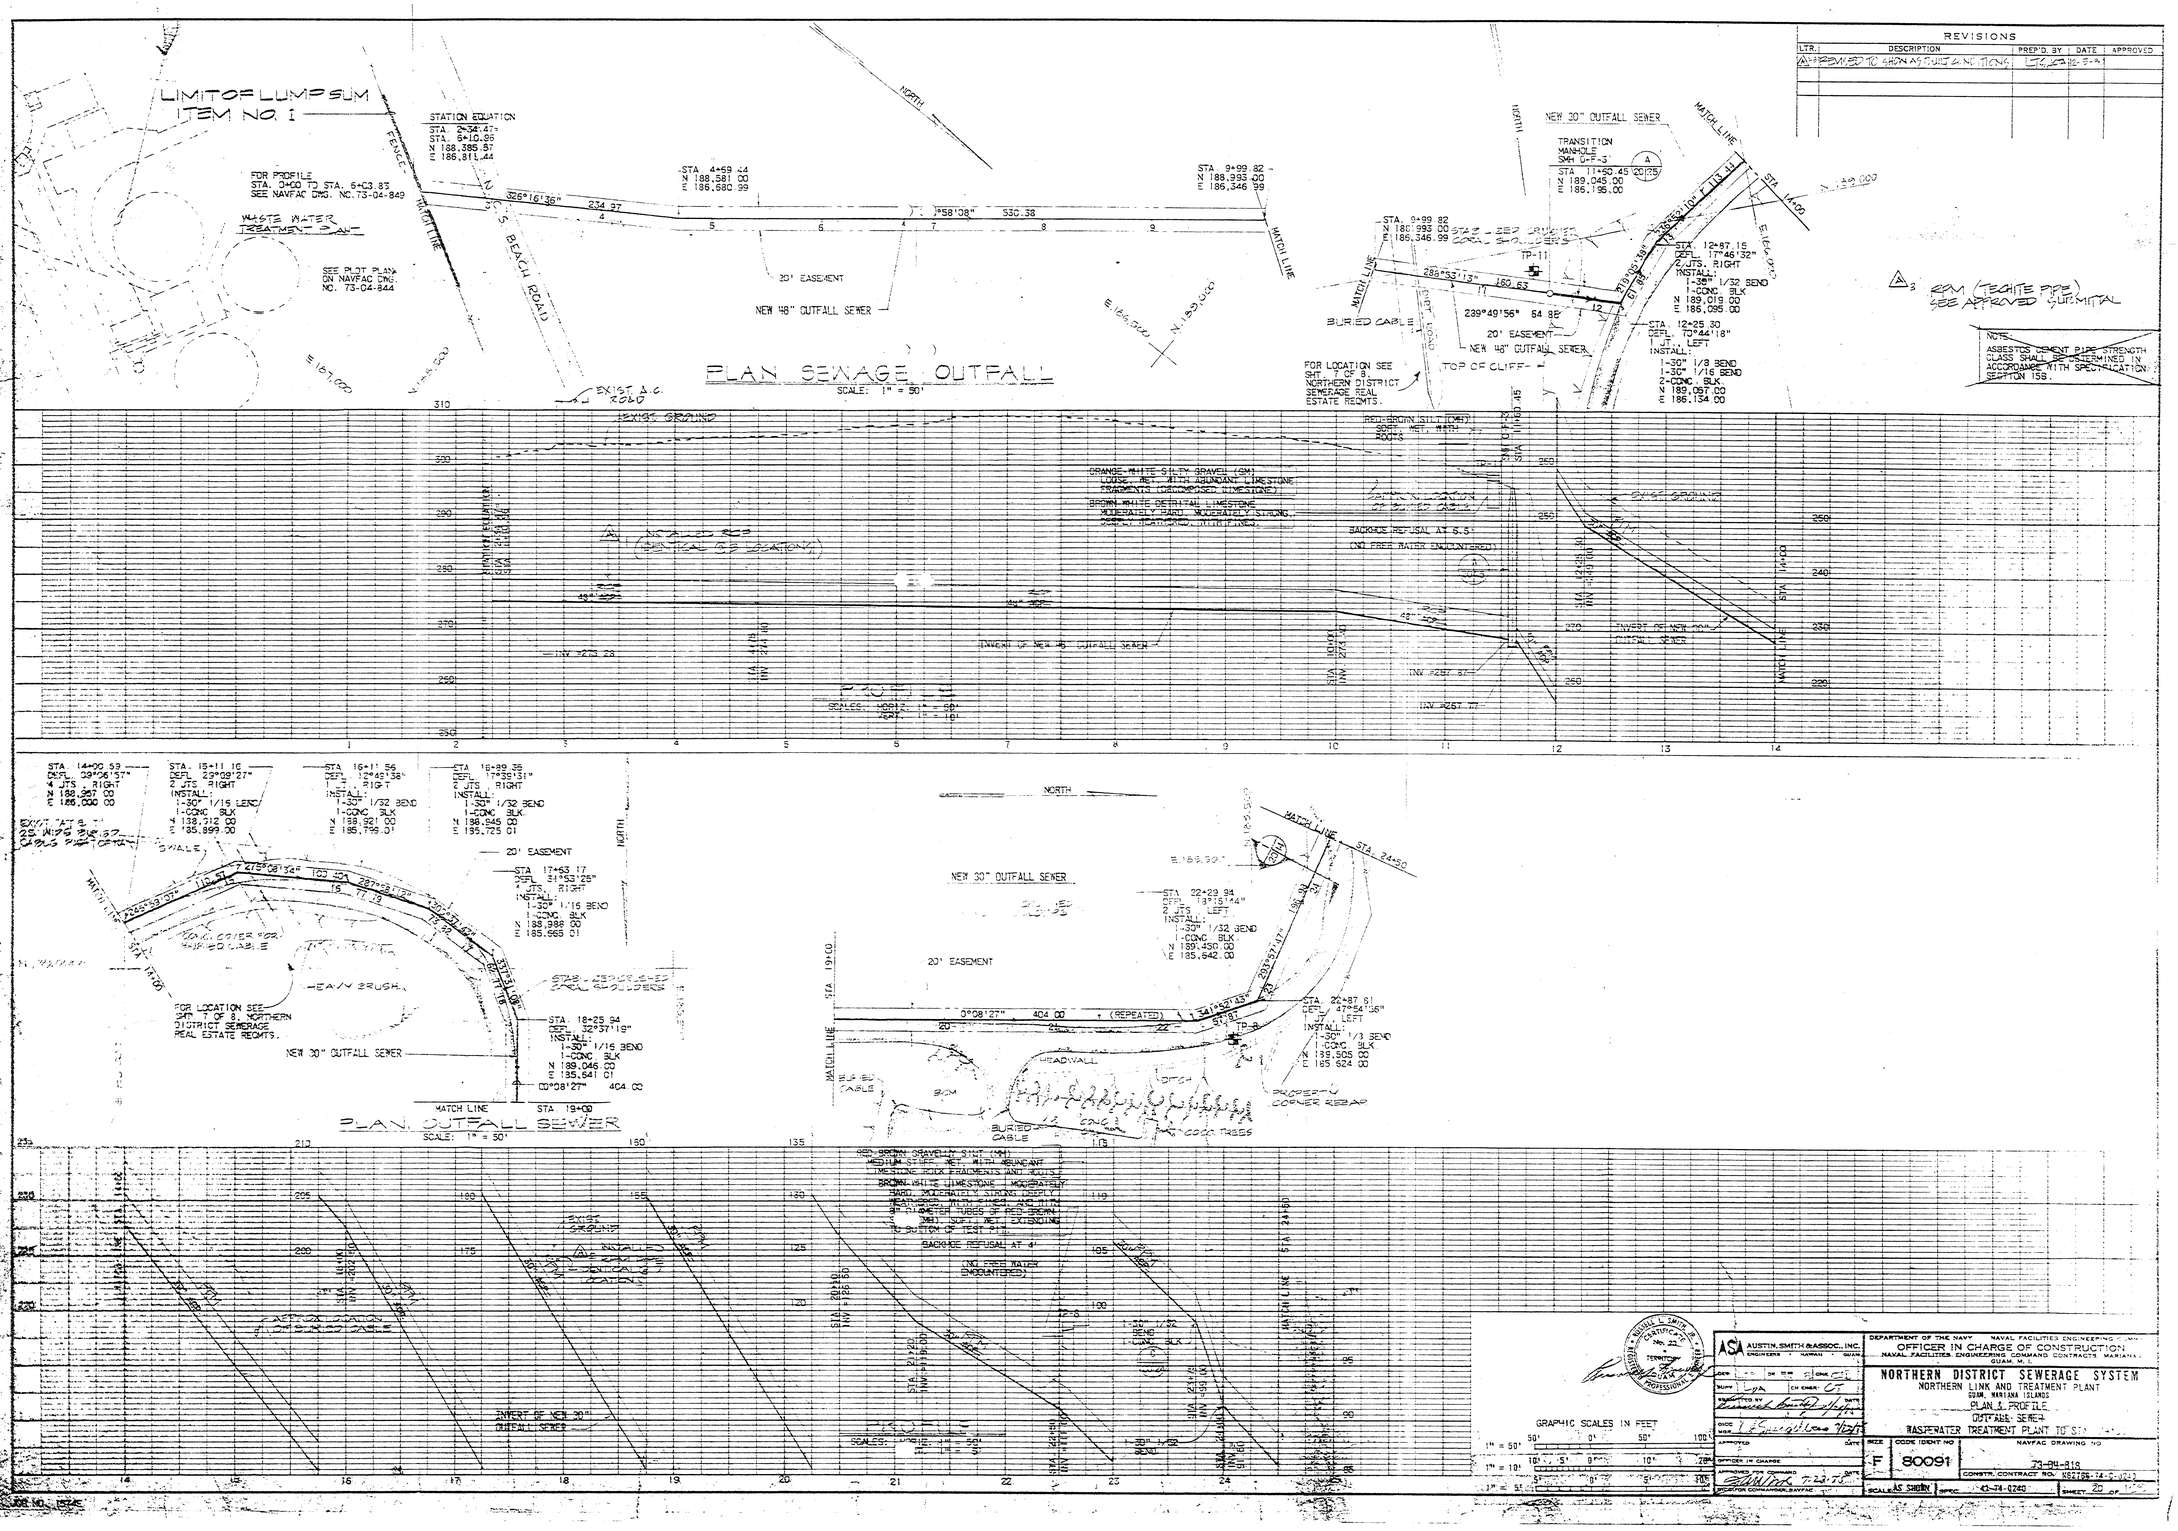

AUSTIN, SMITH & ASSOC., INC. ENGINEERS · HONOLULU · GUAM	DEPARTMENT OF THE NAVY NAVAL FACILITIES ENGINEERING COMMAND OFFICER IN CHARGE OF CONSTRUCTION NAVAL FACILITIES ENGINEERING COMMAND CONTRACTS MARIANAS GUAM, M.I.	NORTHERN DISTRICT SEWERAGE SYSTEM NORTHERN LINK AND TREATMENT PLANT GUAM, MARIANA ISLANDS PLAN & PROFILE OUTFALL SEWER WASTEWATER TREATMENT PLANT TO STA.	
DES: JA DR: RM CH DRN: CT			
SUPT: JA CH ENGR: CT			
MANAGING PARTNER DATE			
CHIEF NSR:	APPROVED DATE	SIZE F	CODE IDENT NO 80091
	OFFICER IN CHARGE		NAVFAC DRAWING NO 73-04-818
	APPROVED FOR COMMANDER DATE 7-23-86		CONSTR. CONTRACT NO. N62769-84-C-0243
	DIRECTOR COMMANDER, NAVFAC	SCALE: AS SHOWN SPEC: 43-74-0240	SHEET 20 OF

JOB NO. 15246